

FKP Architects

ARCHITECT OF RECORD
Paul C. Gloriot



INVENTURE
DESIGN

REVISIONS

7/18/11 ASI 85 Delta
253

General Notes

- REFER TO ENLARGED PLANS, ELEVATIONS, AND SECTIONS FOR ADDITIONAL FINISH INFORMATION THAT MAY NOT BE NOTED ON PLAN.
- ALL FINISHES AND MATERIALS TO BE NEW AND SHALL NOT CONTAIN ASBESTOS.
- ENSURE THAT ALL SURFACES TO RECEIVE FINISHES ARE CLEAN, TRUE AND FREE OF IRREGULARITIES. DO NOT PROCEED WITH WORK UNTIL UNSATISFACTORY CONDITIONS HAVE BEEN CORRECTED.
- ALL FINISH CONTRACTORS SHALL LEAVE REMNANTS AND REMAINING MATERIALS SAFELY STORED ON SITE FOR THE OWNER'S FUTURE USE.
- ALL FINISHES SHALL BE SUBMITTED TO INTERIOR ARCHITECT FOR APPROVAL PRIOR TO ORDERING OR INSTALLING.
- CONTINUOUS GYP BOARD WITH SURFACES OVER 30' IN LENGTH ARE TO HAVE CONTROL JOINT PER MANUFACTURER'S RECOMMENDATIONS **except at stair shaft**.
- REFER TO BASE BUILDING CORE AND SHELL GENERAL CONDITIONS AND SPECIFICATIONS FOR ADDITIONAL INFORMATION.
- ALL FINISHES AND THEIR INSTALLATION ARE TO MEET LOCAL FIRE CODE REGULATIONS. CONTRACTOR TO INCLUDE ANY NECESSARY FLAME PROOFING TREATMENT IN THEIR INITIAL PRICING.

Sheet Notes


- DOOR AND FRAME TO BE PAINTED TO MATCH ADJACENT SURFACE.
- RE: IAT.3 FOR ENLARGED PLAN OF CURVED FEATURE WALL.
- PATTERN MAY CHANGE PER NEW INFORMATION FROM THE VENDOR.

NOTE: PROVIDE SHOP DRAWINGS OF ALL SHEET VINYL, CARPET, AND TERRAZZO FLOOR PATTERNS PRIOR TO ORDERING / FABRICATION AND INSTALLATION. PATTERNS ARE INTENDED TO BE "FREE-FORM" IN NATURE, AND HENCE CANNOT BE DIMENSIONED. CAD FILES WILL BE PROVIDED AS NECESSARY TO APPROPRIATELY MEET THE ABOVE REQUIREMENT.

Legend

- PT-1 TOP: WALL FINISH
BOTTOM: BASE FINISH
- PT-1 WALL FINISH
- CP-1 FLOOR FINISH
- FLOOR FINISH TRANSITION (RE: D71A7.2)
- DENOTES FINISH EXTENTS
- AVAIL. KEY
- DETAIL TAG
- DENOTES SHEET NOTE
- DENOTES EXTENTS OF DRYWALL REVEALS RE: ELEV.

A1 KEY PLAN
SCALE: 1" = 1'-0"

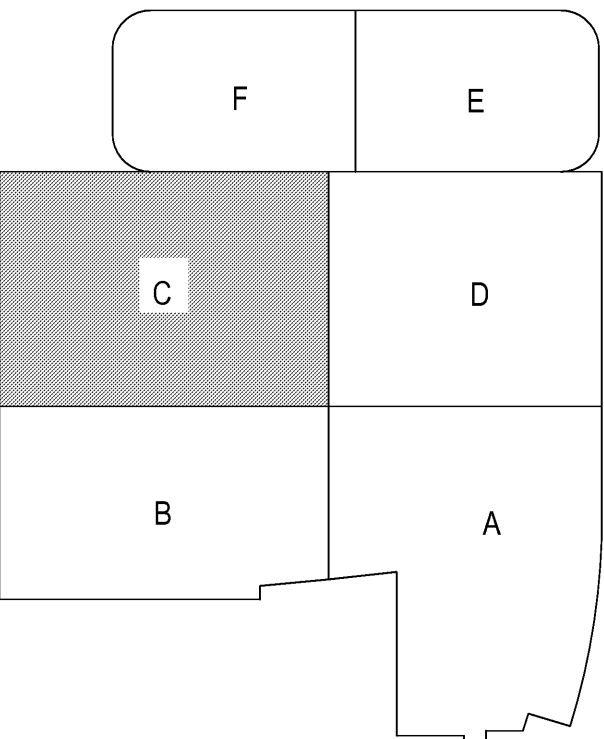

NOT ISSUED

MATCHLINE AREA C

MATCHLINE AREA C

MATCHLINE AREA B

Finishes Plan

SCALE: 1/8" = 1'-0"

RFI 1619 Primary
backard VT.1

Pattern Confetti
VT.10

RFI 4872
PT 7-E is to be used

RFI 4353
PT5P is to
be used

RFI 4009 Track
lighting along art wall
not required. Ref to
Electrical drawings.

RFI 4124
See detail for reveals

RFI 1048.1

RFI 1611
PT-AE-PT-7E

RFI 1619 Primary
backard VT.1

Pattern confetti
VT.10

PROJECT NAME
CHILDREN'S
HOSPITAL OF
ORANGE COUNTY
455 S. Main St.
Orange, CA 92868-3874

TOWER II
RECEIVED
JULY 18, 2011
McCARTHY

CHOC
HOSPITAL

PROJECT NUMBER

12011.00
Increment # 7

OSHPD - PROJECT NUMBER

IL 072072-30

ISSUE

ASI 85 DELTA 253

DATE

07/18/2011

SCALE

As Noted

DRAWING TITLE

FINISH PLAN
LEVEL 1 AREA C

DRAWING NUMBER

IA5.1C