




FKP Architects

ARCHITECT OF RECORD  
Paul C. Gloriot

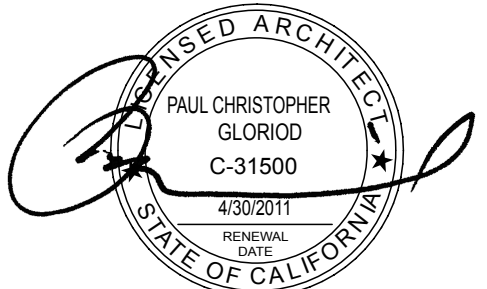

REVISIONS

- |                           |
|---------------------------|
| 7/18/11 ASI 85 Delta 253  |
| 1/24/12 ASI 148 Delta 406 |

PROJECT NAME  
**CHILDREN'S HOSPITAL OF ORANGE COUNTY**  
455 S. Main St.  
Orange, CA 92668-3874

TOWER II



PROJECT NUMBER

12011.00  
Increment # 7

OSHPD - PROJECT NUMBER

IL 072072-30

ISSUE

ASI 159 Delta 142

DATE

1/31/2012

SCALE

As Noted

DRAWING TITLE

FINISH PLAN  
LEVEL 1 AREA D

DRAWING NUMBER

IA5.1D

## General Notes

- REFER TO ENLARGED PLANS, ELEVATIONS, AND SECTIONS FOR ADDITIONAL FINISH INFORMATION THAT MAY NOT BE NOTED ON PLAN.
- ALL FINISHES AND MATERIALS TO BE NEW AND SHALL NOT CONTAIN ASBESTOS.
- ENSURE THAT ALL SURFACES TO RECEIVE FINISHES ARE CLEAN, TRUE AND FREE OF IRREGULARITIES. DO NOT PROCEED WITH WORK UNTIL UNSATISFACTORY CONDITIONS HAVE BEEN CORRECTED.
- ALL FINISH CONTRACTORS SHALL LEAVE REMNANTS AND REMAINING MATERIALS SAFELY STORED ON SITE FOR THE OWNER'S FUTURE USE.
- ALL FINISHES SHALL BE SUBMITTED TO INTERIOR ARCHITECT FOR APPROVAL PRIOR TO ORDERING OR INSTALLING.
- CONTINUOUS GYP BOARD WITH SURFACES OVER 30' IN LENGTH ARE TO HAVE CONTROL JOINT PER MANUFACTURERS RECOMMENDATIONS.
- REFER TO BASE BUILDING CORE AND SHELL GENERAL CONDITIONS AND SPECIFICATIONS FOR ADDITIONAL INFORMATION.
- ALL FINISHES AND THEIR INSTALLATION ARE TO MEET LOCAL FIRE CODE REGULATIONS. CONTRACTOR TO INCLUDE ANY NECESSARY FLAME PROOFING TREATMENT IN THEIR INITIAL PRICING.

## Sheet Notes


- LOCATION FOR HOSPITAL DIRECTORY. COORDINATE WITH GRAPHICS SUBCONTRACTOR.
- SHEET VINYL AT THIS LOCATION TO BE SV-10. SOFFIT AT THIS LOCATION TO BE GC-5. PAINT AT THIS LOCATION TO BE PT-14E. ARCHITECTURAL WOODWORK AT THIS LOCATION TO BE PL-6. (RE: RCP FOR INFORMATION ON CEILING PATTERN ABOVE. FLOORING PATTERN TO MATCH CEILING LINE ABOVE.)
- FLOOR PATTERN TO MATCH CEILING ABOVE. (RE: RCP)
- SHEET VINYL AT THIS LOCATION TO BE SV-12. SOFFIT AT THIS LOCATION TO BE GC-6. PAINT AT THIS LOCATION TO BE PT-14E. ARCHITECTURAL WOODWORK AT THIS LOCATION TO BE PL-7. (RE: RCP FOR INFORMATION ON CEILING PATTERN ABOVE. FLOORING PATTERN TO MATCH CEILING LINE ABOVE.)
- NOT USED.
- NOT USED.
- SHEET VINYL AT THIS LOCATION TO BE SV-20. SOFFIT AT THIS LOCATION TO BE GC-10. PAINT AT THIS LOCATION TO BE PT-24E. ARCHITECTURAL WOODWORK AT THIS LOCATION TO BE PL-11. (RE: RCP FOR INFORMATION ON CEILING PATTERN ABOVE. FLOORING PATTERN TO MATCH CEILING LINE ABOVE.)
- DOOR AND FRAME TO BE PAINTED TO MATCH ADJACENT SURFACE

**NOTE: PROVIDE SHOP DRAWINGS OF ALL SHEET VINYL, CARPET, AND TERRAZZO FLOOR PATTERNS PRIOR TO ORDERING / FABRICATION AND INSTALLATION. PATTERNS ARE INTENDED TO BE "FREE-FORM" IN NATURE, AND HENCE CANNOT BE DIMENSIONED. CAD FILES WILL BE PROVIDED AS NECESSARY TO APPROPRIATELY MEET THE ABOVE REQUIREMENT.**

## Legend

- PT-10 TOP: WALL FINISH  
BS BOTTOM: BASE FINISH
- PT-11 WALL FINISH
- CP-1 FLOOR FINISH
- ..... FLOOR FINISH TRANSITION (RE: D7/IA7.2)
- DENOTES FINISH EXTENTS
- A1/IA1.0 DETAIL KEY
- DETAIL ENLARGED DETAIL TAG
- # DENOTES SHEET NOTE
- DENOTES EXTENTS OF DRYWALL REVEALS RE: ELEV.

A1 KEY PLAN  
SCALE: 1" = 1'-0"

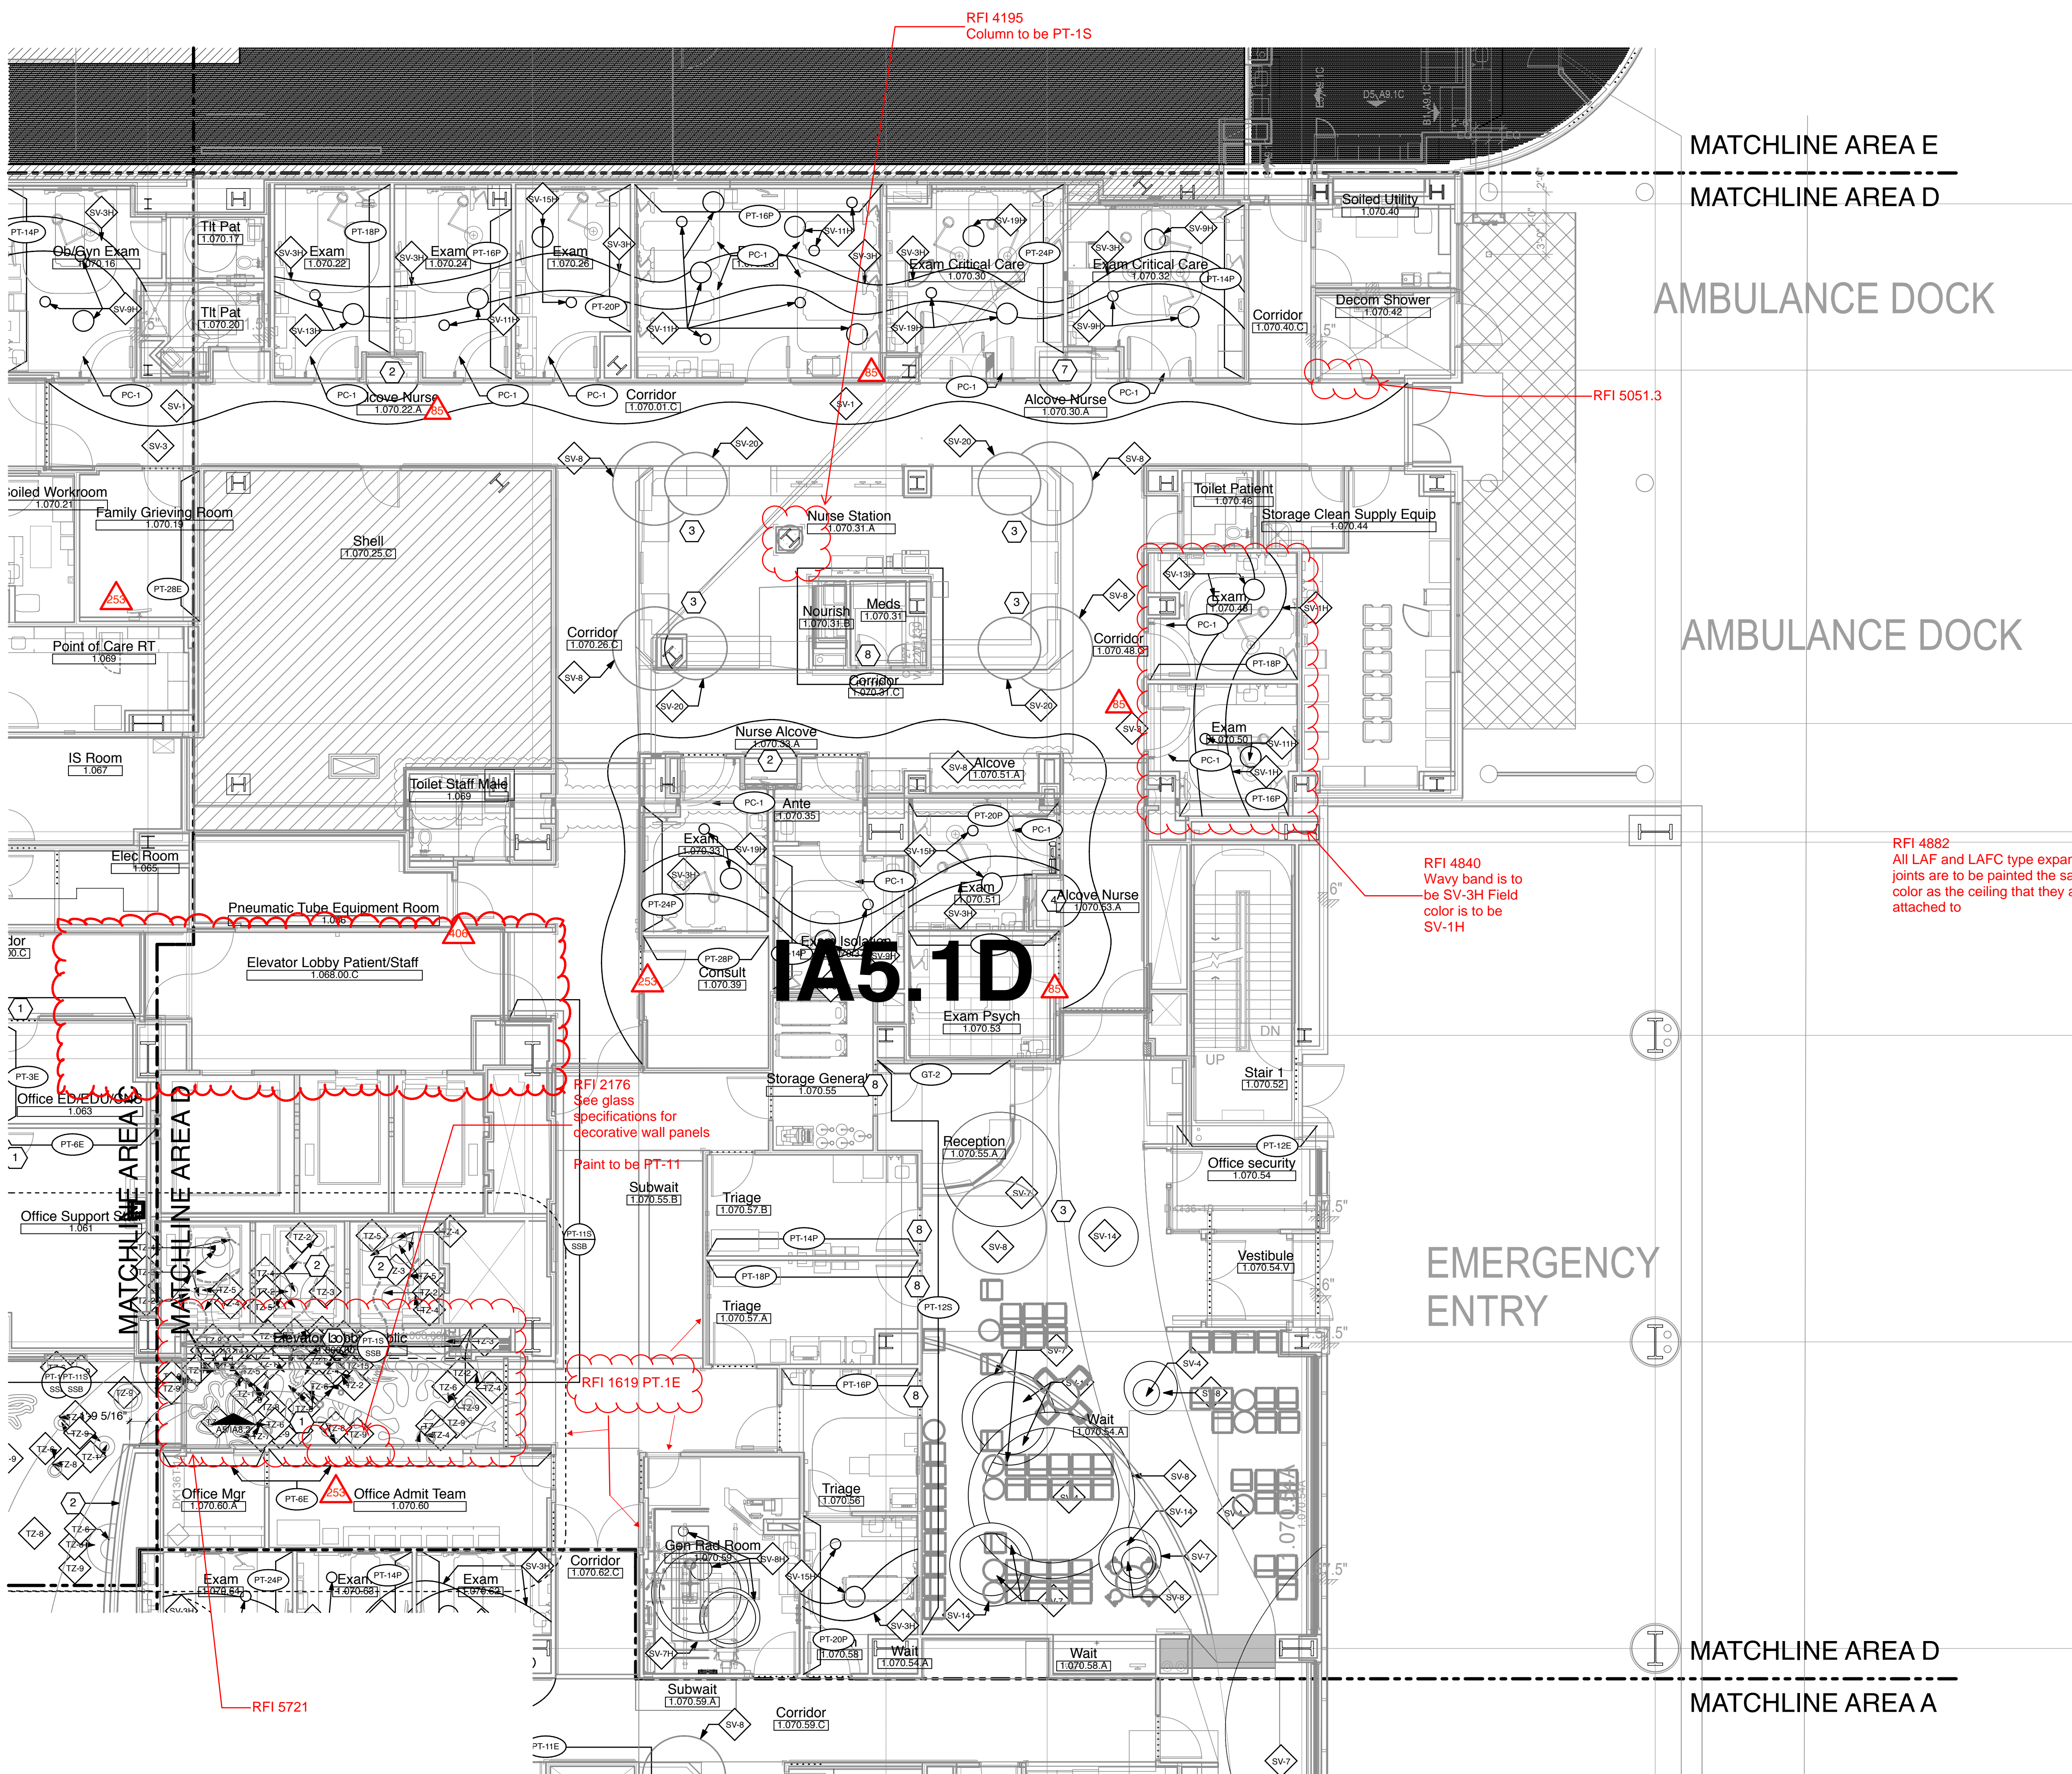

B6 Finishes Plan  
SCALE: 1/8" = 1'-0"