


FKP Architects

ARCHITECT OF RECORD
Paul C. Gloriod

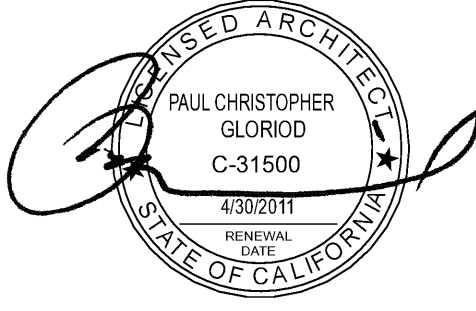

REVISIONS

SA	09/27/2010 - ASI 14
PA	02/24/2011 - ASI 58 / CO - 97
BA	03/01/2011 - CO 134
DA	07/18/2011- ASI 85/Delta 253
	2/17/2012 - RFI #5281-0
SA	5/29/2012- ASI 218/Delta 533

General Notes

- REFER TO ENLARGED PLANS, ELEVATIONS, AND SECTIONS FOR ADDITIONAL FINISH INFORMATION THAT MAY NOT BE NOTED ON PLAN.
- ALL FINISHES AND MATERIALS TO BE NEW AND SHALL NOT CONTAIN ASBESTOS.
- ENSURE THAT ALL SURFACES TO RECEIVE FINISHES ARE CLEAN, TRUE AND FREE OF IRREGULARITIES. DO NOT PROCEED WITH WORK UNTIL UNSATISFACTORY CONDITIONS HAVE BEEN CORRECTED.
- ALL FINISH CONTRACTORS SHALL LEAVE REMNANTS AND REMAINING MATERIALS SAFELY STORED ON SITE FOR THE OWNER'S FUTURE USE.
- ALL FINISHES SHALL BE SUBMITTED TO INTERIOR ARCHITECT FOR APPROVAL PRIOR TO ORDERING OR INSTALLING.
- CONTINUOUS GYP BOARD WITH SURFACES OVER 30' IN LENGTH ARE TO HAVE CONTROL JOINT PER MANUFACTURERS RECOMMENDATIONS.
- REFER TO BASE BUILDING CORE AND SHELL GENERAL CONDITIONS AND SPECIFICATIONS FOR ADDITIONAL INFORMATION.
- ALL FINISHES AND THEIR INSTALLATION ARE TO MEET LOCAL FIRE CODE REGULATIONS. CONTRACTOR TO INCLUDE ANY NECESSARY FLAME PROOFING TREATMENT IN THEIR INITIAL PRICING.

Sheet Notes

- COORDINATE EXACT LOCATIONS OF SCHEDULED QUARRY TILE WITH EQUIPMENT LOCATION PRIOR TO CONSTRUCTION AND INSTALLATION.


RFI 4242
Install QT-1 4'0" from wall
where equipment is called out.

RFI 3168 Finish type of single/double settees

NOTE: PROVIDE SHOP DRAWINGS OF ALL SHEET VINYL, CARPET, AND TERRAZZO FLOOR PATTERNS PRIOR TO ORDERING / FABRICATION AND INSTALLATION. PATTERNS ARE INTENDED TO BE "FREE-FORM" IN NATURE, AND HENCE CANNOT BE DIMENSIONED. CAD FILES WILL BE PROVIDED AS NECESSARY TO APPROPRIATELY MEET THE ABOVE REQUIREMENT.

Legend

- PT-1 BS-1 TOP: WALL FINISH
BOTTOM: BASE FINISH
- PT-1 WALL FINISH
- CP-1 FLOOR FINISH
- FLOOR FINISH TRANSITION (RE: D7/A7.2)
- DENOTES FINISH EXTENTS
- A1/A1.0 ELEVATION KEY
- DETAIL TEMPLATE ENLARGED DETAIL TAG
- Z DENOTES SHEET NOTE
- DENOTES EXTENTS OF DRYWALL REVEALS RE: ELEV.

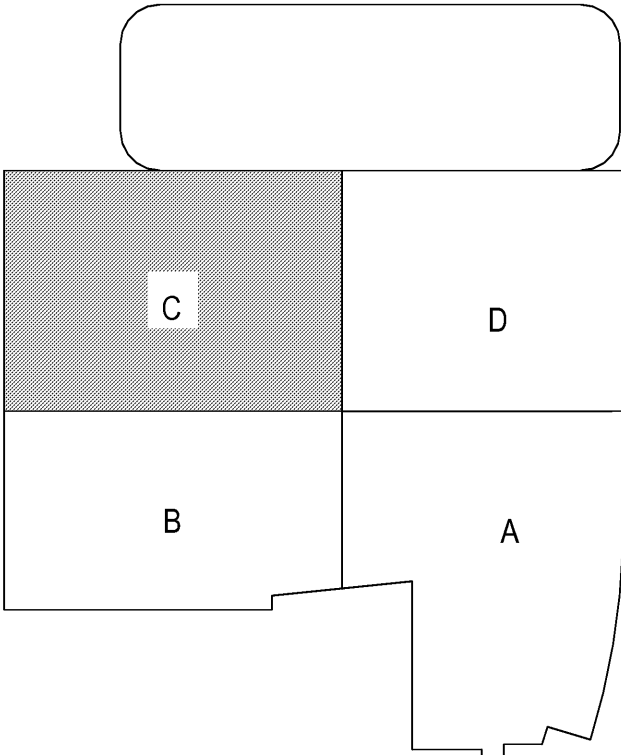

A1 KEY PLAN
SCALE: 1" = 1'-0"

NOT ISSUED

MATCHLINE AREA C

MATCHLINE AREA C

MATCHLINE AREA B

A6 Finishes Plan
SCALE: 1/8" = 1'-0"

PROJECT NAME

CHILDREN'S
HOSPITAL OF
ORANGE COUNTY
455 S. Main St.
Orange, CA 92668-3874

RECEIVED
May 31 2012
TOWER II
McCARTHY



PROJECT NUMBER

12011.00
Increment # 7

OSHPD - PROJECT NUMBER
IL 072072-30

ISSUE

RFI 5281-0

DATE

2/17/2012

SCALE

As Noted

DRAWING TITLE

FINISH PLAN LEVEL
2 AREA C

DRAWING NUMBER

IA5.2C