



FKP Architects

ARCHITECT OF RECORD

Paul C. Gloriod



REVISIONS

- 16. 03/01/2011 - CO 134
- 25. 07/18/2011-ASI 85 Delta 253
- 16. 08/08/2011 - CO 135
- 3. 09/19/2011 - ASI 110 Delta 330
- 10. 1/24/12 ASI 148 Delta 406

PROJECT NAME
CHILDREN'S
HOSPITAL OF
ORANGE COUNTY
455 S. Main St.
Orange, CA 92668-3874

TOWER II



PROJECT NUMBER

12011.00
Increment # 7

OSHPD - PROJECT NUMBER

IL 072072-30

ISSUE

ASI 148 Delta 406

DATE

1/24/2012

SCALE

As Noted

DRAWING TITLE

FINISH PLAN LEVEL
2 AREA D

DRAWING NUMBER

IA5.2D

General Notes


- REFER TO ENLARGED PLANS, ELEVATIONS, AND SECTIONS FOR ADDITIONAL FINISH INFORMATION THAT MAY NOT BE NOTED ON PLAN.
- ALL FINISHES AND MATERIALS TO BE NEW AND SHALL NOT CONTAIN ASBESTOS.
- ENSURE THAT ALL SURFACES TO RECEIVE FINISHES ARE CLEAN, TRUE AND FREE OF IRREGULARITIES. DO NOT PROCEED WITH WORK UNTIL UNSATISFACTORY CONDITIONS HAVE BEEN CORRECTED.
- ALL FINISH CONTRACTORS SHALL LEAVE REMNANTS AND REMAINING MATERIALS SAFELY STORED ON SITE FOR THE OWNER'S FUTURE USE.
- ALL FINISHES SHALL BE SUBMITTED TO INTERIOR ARCHITECT FOR APPROVAL PRIOR TO ORDERING OR INSTALLING.
- CONTINUOUS GYP BOARD WITH SURFACES OVER 30' IN LENGTH ARE TO HAVE CONTROL JOINT PER MANUFACTURER'S RECOMMENDATIONS.
- REFER TO BASE BUILDING CORE AND SHELL GENERAL CONDITIONS AND SPECIFICATIONS FOR ADDITIONAL INFORMATION.
- ALL FINISHES AND THEIR INSTALLATION ARE TO MEET LOCAL FIRE CODE REGULATIONS. CONTRACTOR TO INCLUDE ANY NECESSARY FLAME PROOFING TREATMENT IN THEIR INITIAL PRICING.

Sheet Notes

NOTE: PROVIDE SHOP DRAWINGS OF ALL SHEET VINYL, CARPET, AND TERRAZZO FLOOR PATTERNS PRIOR TO ORDERING / FABRICATION AND INSTALLATION. PATTERNS ARE INTENDED TO BE "FREE-FORM" IN NATURE, AND HENCE CANNOT BE DIMENSIONED. CAD FILES WILL BE PROVIDED AS NECESSARY TO APPROPRIATELY MEET THE ABOVE REQUIREMENT.

Legend


- PT-1 (SS-1) TOP: WALL FINISH
BOTTOM: BASE FINISH
- PT-1 WALL FINISH
- CP-1 FLOOR FINISH
- FLOOR FINISH TRANSITION (RE: D7/IA7.2)
- DENOTES FINISH EXTENTS
- A1/IA1.0 ELEVATION KEY
- RETAL ENLARGED DETAIL TAG
- 8 DENOTES SHEET NOTE
- DENOTES EXTENTS OF DRYWALL REVEALS RE: ELEV.

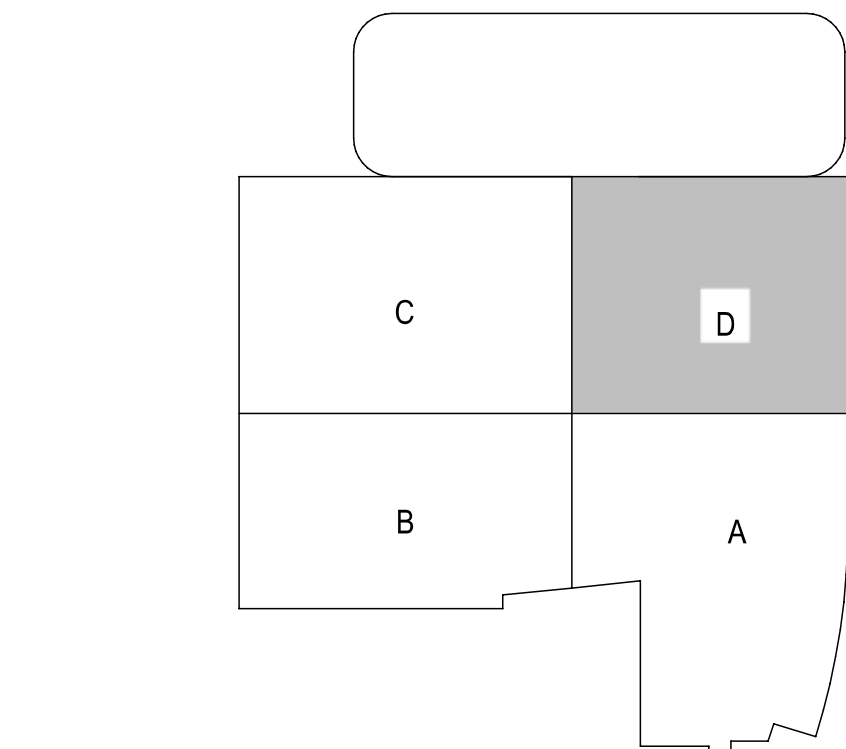

A1 KEY PLAN
SCALE: 1" = 1'-0"

NOT ISSUED
MATCHLINE AREA D

MATCHLINE AREA D
MATCHLINE AREA A

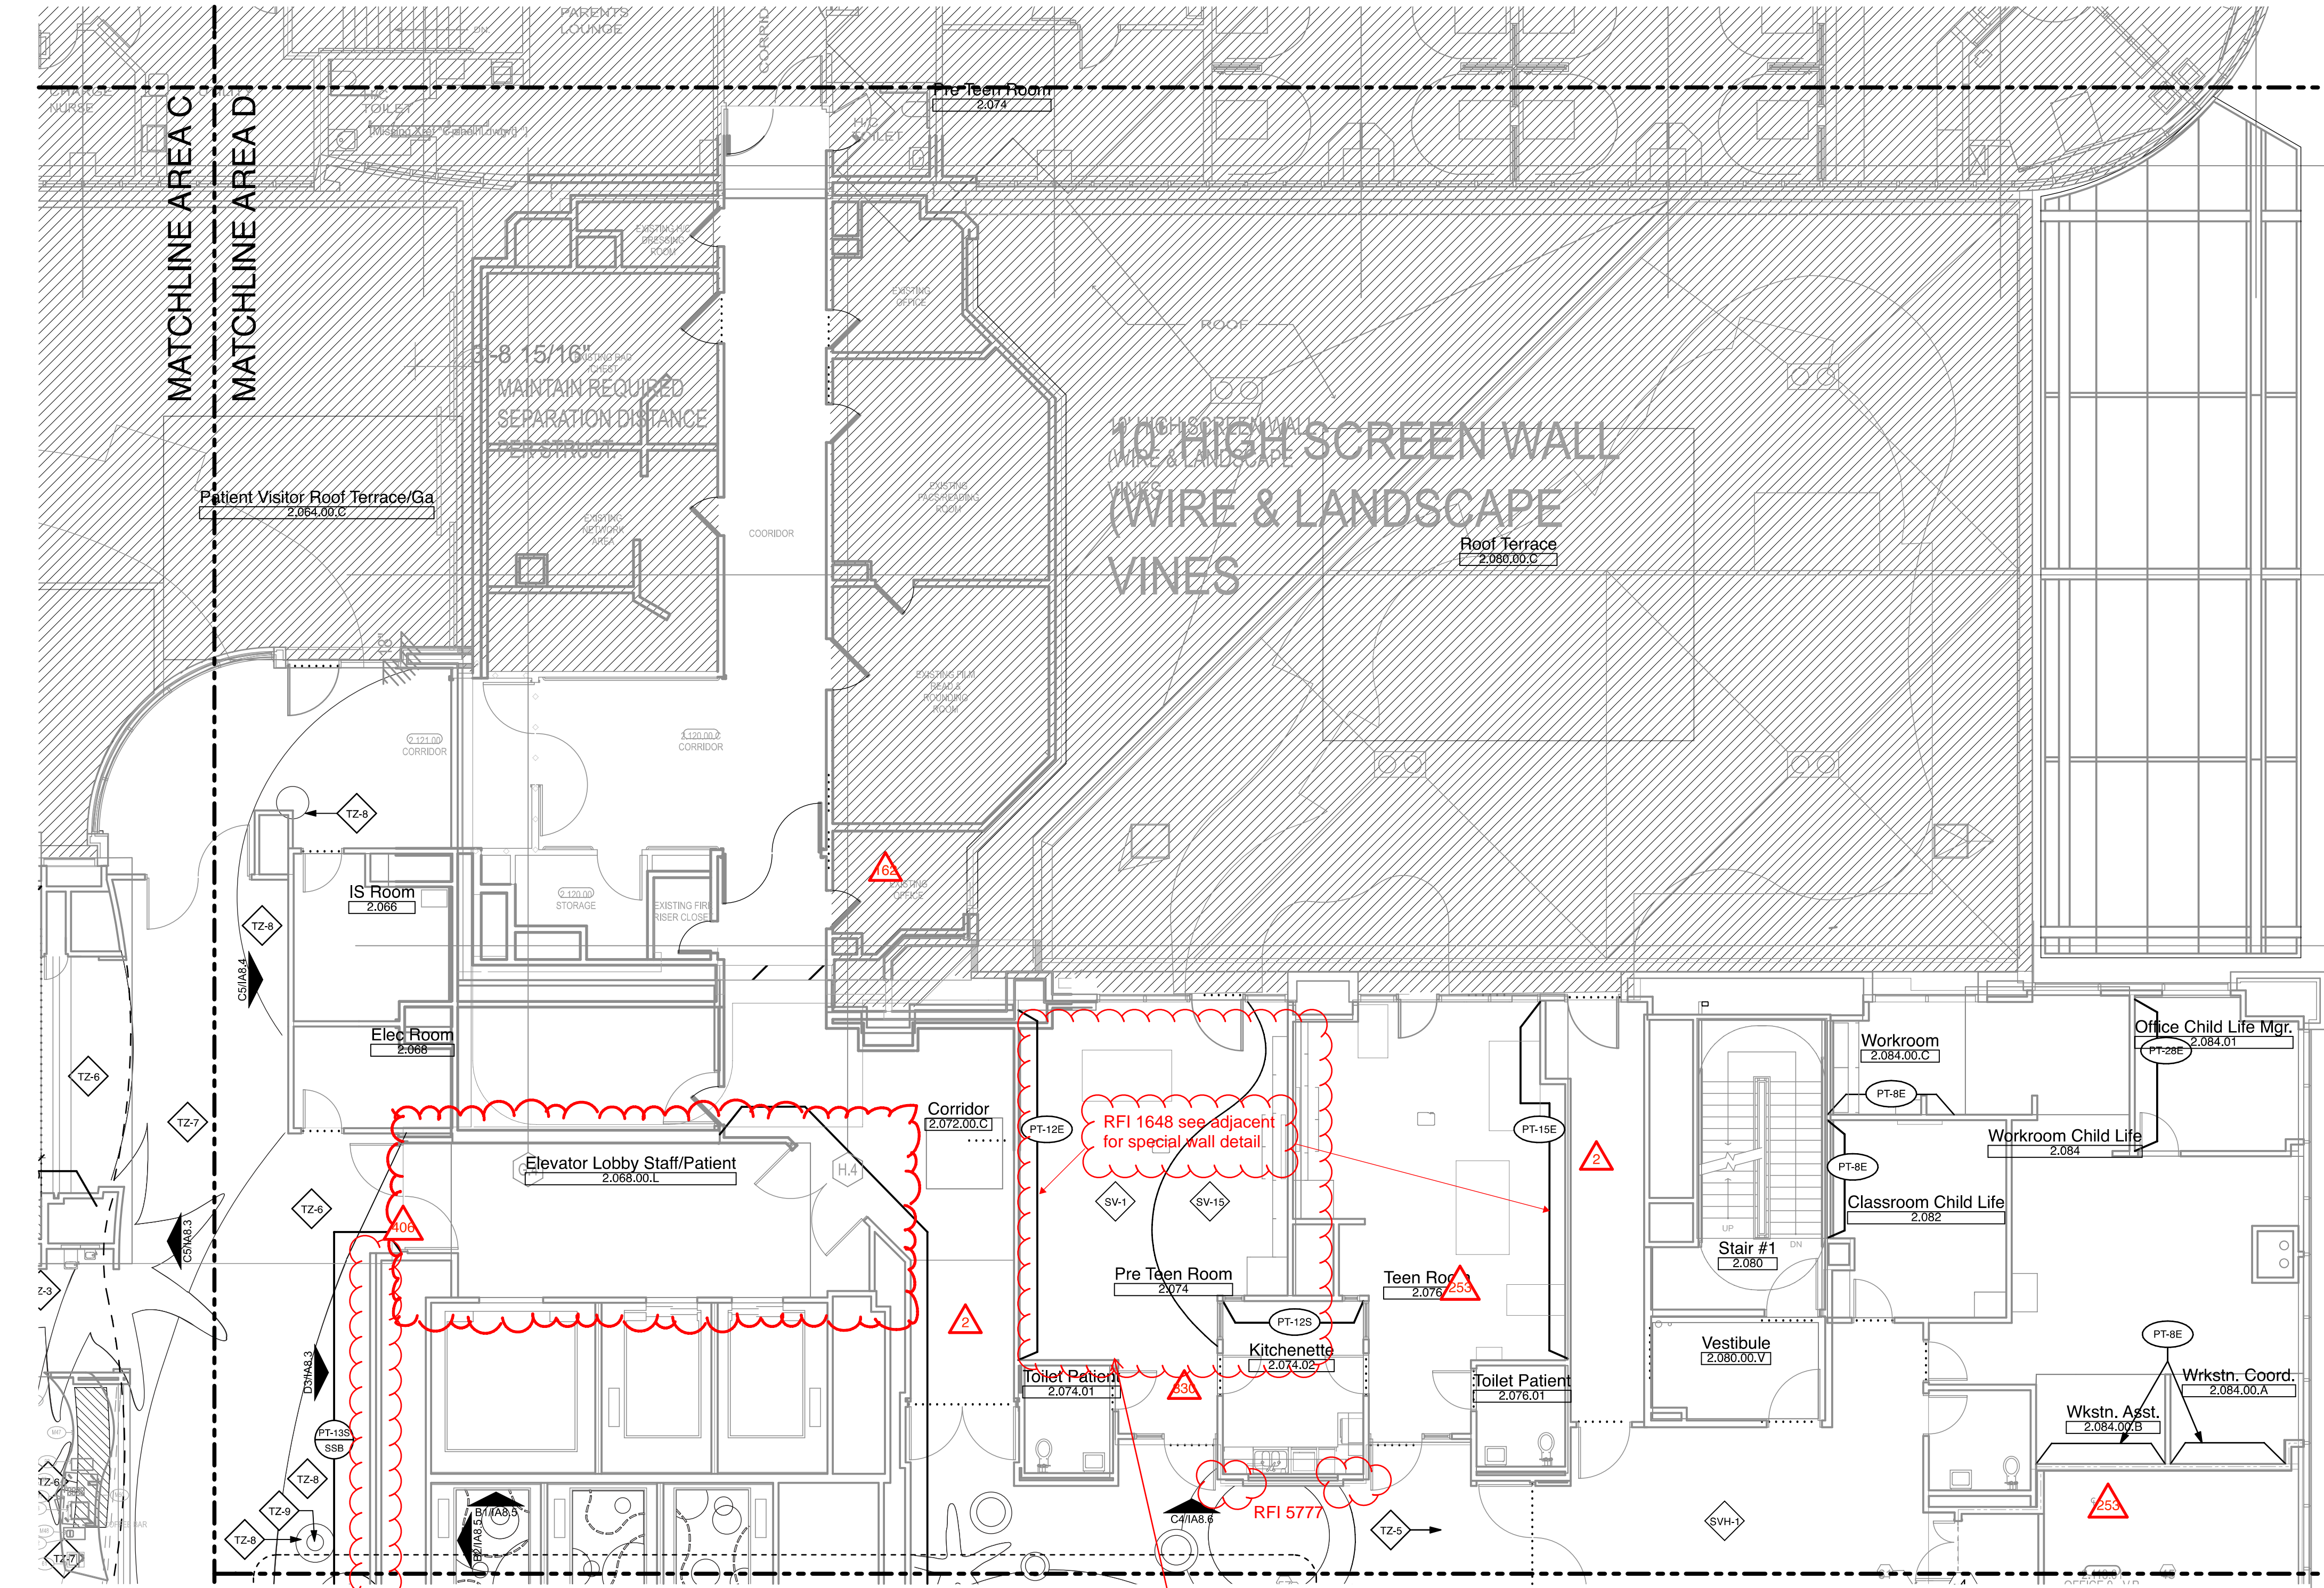

B6 Finishes Plan
SCALE: 1/8" = 1'-0"