

FKP Architects

ARCHITECT OF RECORD

Paul C. Gloriod



REVISIONS

02/12/10 Information Bulletin #05

9/14/11

7/18/11 ASI 85 Delta 253

09/19/2011 - ASI 110 Delta 330

Changes on these drawings do not consist of materially altered changes to approved drawings and don't require a change order.  
OSHPD review ACO  
OSHPD review FLSO  
OSHPD review DSE

### General Notes

- REFER TO ENLARGED PLANS, ELEVATIONS, AND SECTIONS FOR ADDITIONAL FINISH INFORMATION THAT MAY NOT BE NOTED ON PLAN.
- ALL FINISHES AND MATERIALS TO BE NEW AND SHALL NOT CONTAIN ASBESTOS.
- ENSURE THAT ALL SURFACES TO RECEIVE FINISHES ARE CLEAN, TRUE AND FREE OF IRREGULARITIES. DO NOT PROCEED WITH WORK UNTIL UNSATISFACTORY CONDITIONS HAVE BEEN CORRECTED.
- ALL FINISH CONTRACTORS SHALL LEAVE REMNANTS AND REMAINING MATERIALS SAFELY STORED ON SITE FOR THE OWNER'S FUTURE USE.
- ALL FINISHES SHALL BE SUBMITTED TO INTERIOR ARCHITECT FOR APPROVAL PRIOR TO ORDERING OR INSTALLING.
- CONTINUOUS GYP BOARD WITH SURFACES OVER 30' IN LENGTH ARE TO HAVE CONTROL JOINT PER MANUFACTURERS RECOMMENDATIONS.
- REFER TO BASE BUILDING CORE AND SHELL GENERAL CONDITIONS AND SPECIFICATIONS FOR ADDITIONAL INFORMATION.
- ALL FINISHES AND THEIR INSTALLATION ARE TO MEET LOCAL FIRE CODE REGULATIONS. CONTRACTOR TO INCLUDE ANY NECESSARY FLAME PROOFING TREATMENT IN THEIR INITIAL PRICING.
- INSTALL BUILDING STANDARD SHOWER CURTAINS AND RODS AT ALL SHOWER LOCATIONS, UNLESS NOTED OTHERWISE.


### Sheet Notes

- DOOR AND FRAME TO BE PAINTED TO MATCH ADJACENT SURFACE.
- FLOOR PATTERN TO MATCH OUTER LIGHTS IN CEILING ABOVE WITH INNER 2'-0" BORDER. (RE: RCP)
- FLOOR PATTERN TO MATCH CEILING ABOVE. (RE: RCP)

NOTE: PROVIDE SHOP DRAWINGS OF ALL SHEET VINYL, CARPET, AND TERRAZZO FLOOR PATTERNS PRIOR TO ORDERING / FABRICATION AND INSTALLATION. PATTERNS ARE INTENDED TO BE "FREE-FORM" IN NATURE, AND HENCE CANNOT BE DIMENSIONED. CAD FILES WILL BE PROVIDED AS NECESSARY TO APPROPRIATELY MEET THE ABOVE REQUIREMENT.

### Legend

- PT-20P: WALL FINISH
- PT-20B: BASE FINISH
- PT-1: WALL FINISH
- CP-1: FLOOR FINISH
- FLOOR FINISH TRANSITION
- DENOTES FINISH EXTENTS
- A1/A1.0: KEY PLAN
- DETAIL: ENLARGED DETAIL TAG
- NOTES SHEET NOTE

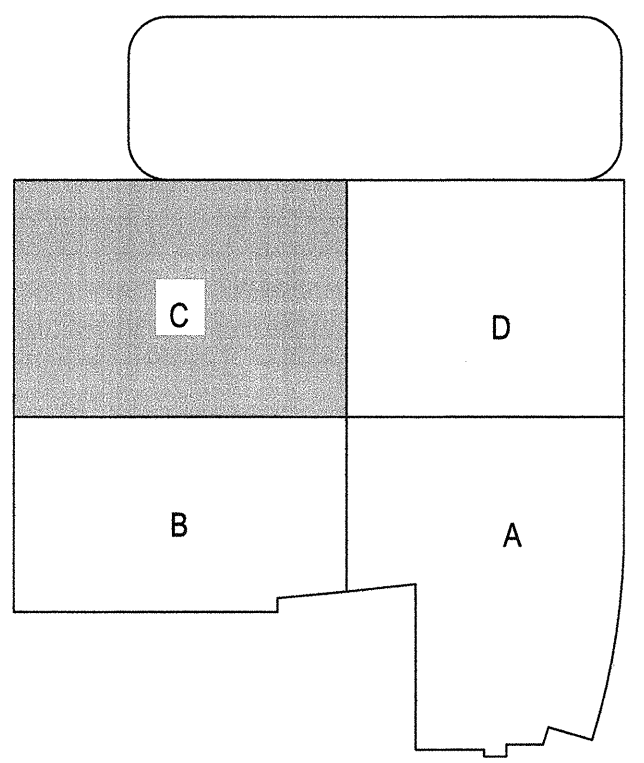

A1 KEY PLAN

SCALE: 1" = 1'-0"

NOT ISSUED  
MATCHLINE AREA C

MATCHLINE AREA C  
MATCHLINE AREA B

A6 FINISH PLAN

SCALE: 1/8" = 1'-0"

PROJECT NAME  
CHILDREN'S  
HOSPITAL OF  
ORANGE COUNTY  
455 S. Main St.  
Orange, CA 92668-3874

TOWER II



PROJECT NUMBER

12011.00  
Increment # 7

OSHPD - PROJECT NUMBER  
IL 072072-30

ISSUE

ASI 110

DATE

09/19/2011

SCALE

As Noted

DRAWING TITLE

FINISH PLAN LEVEL  
3 AREA C

DRAWING NUMBER

IA5.3C