

FKP Architects

ARCHITECT OF RECORD
Paul C. Gloriod



REVISIONS
02/12/10 Information Bulletin #05

- 09/27/2010 - ASI 14
- 10/18/2010 - ASI 23
- 01/05/2011 - ASI 47
- 02/24/2011 - ASI 58 / CO - 97
- 07/18/2011 - ASI 85 Delta 253
- 08/08/2011 - CO 135
- 1/24/12 ASI 148 Delta 406
- 05/15/2012 - ASI 208 Delta 516

PROJECT NAME
CHILDREN'S
HOSPITAL OF
ORANGE COUNTY
455 S. Main St.
Orange, CA 92668-3874

TOWER II

HOSPITAL

PROJECT NUMBER
12011.00
Increment # 7
OSHPD - PROJECT NUMBER
IL 072072-30
ISSUE

DATE
1/31/2012
SCALE
As Noted
DRAWING TITLE
FINISH PLAN LEVEL
3 AREA D

DRAWING NUMBER
IA5.3D

General Notes

- A. REFER TO ENLARGED PLANS, ELEVATIONS, AND SECTIONS FOR ADDITIONAL FINISH INFORMATION THAT MAY NOT BE NOTED ON PLAN.
- B. ALL FINISHES AND MATERIALS TO BE NEW AND SHALL NOT CONTAIN ASBESTOS.
- C. ENSURE THAT ALL SURFACES TO RECEIVE FINISHES ARE CLEAN, TRUE AND FREE OF IRREGULARITIES. DO NOT PROCEED WITH WORK UNTIL UNSATISFACTORY CONDITIONS HAVE BEEN CORRECTED.
- D. ALL FINISH CONTRACTORS SHALL LEAVE REMNANTS AND REMAINING MATERIALS SAFELY STORED ON SITE FOR THE OWNER'S FUTURE USE.
- E. ALL FINISHES SHALL BE SUBMITTED TO INTERIOR ARCHITECT FOR APPROVAL PRIOR TO ORDERING OR INSTALLING.
- F. CONTINUOUS GYP BOARD WITH SURFACES OVER 30' IN LENGTH ARE TO HAVE CONTROL JOINT PER MANUFACTURERS RECOMMENDATIONS. **Except at stair shaft**
- G. REFER TO BASE BUILDING CORE AND SHELL GENERAL CONDITIONS AND SPECIFICATIONS FOR ADDITIONAL INFORMATION.
- H. ALL FINISHES AND THEIR INSTALLATION ARE TO MEET LOCAL FIRE CODE REGULATIONS. CONTRACTOR TO INCLUDE ANY NECESSARY FLAME PROOFING TREATMENT IN THEIR INITIAL PRICING.
- I. INSTALL BUILDING STANDARD SHOWER CURTAINS AND RODS AT ALL SHOWER LOCATIONS, UNLESS NOTED OTHERWISE.

RFI 1048.1


Sheet Notes

- 1. DOOR AND FRAME TO BE PAINTED TO MATCH ADJACENT SURFACE.
- 2. LOCATION FOR HOSPITAL DIRECTORY COORDINATE WITH GRAPHICS SUBCONTRACTOR.
- 3. FLOOR PATTERN TO MATCH CEILING ABOVE. (RE: RCP)
- 4. NOT USED
- 5. REFER TO 3.109.20 PREP 15 FOR TYPICAL PATTERN FINISH INFORMATION.

NOTE: PROVIDE SHOP DRAWINGS OF ALL SHEET VINYL, CARPET, AND TERRAZO FLOOR PATTERNS PRIOR TO ORDERING / FABRICATION AND INSTALLATION. PATTERNS ARE INTENDED TO BE "FREE-FORM" IN NATURE, AND HENCE CANNOT BE DIMENSIONED. CAD FILES WILL BE PROVIDED AS NECESSARY TO APPROPRIATELY MEET THE ABOVE REQUIREMENT.

Legend

- PT-1 (RS-1) TOP: WALL FINISH
BOTTOM: BASE FINISH
- PT-1 WALL FINISH
- CP-1 FLOOR FINISH
- FLOOR FINISH TRANSITION
- DENOTES FINISH EXTENTS
- A1/IA1.0 ELEVATION KEY
- ENLARGED DETAIL TAG
- DENOTES SHEET NOTE

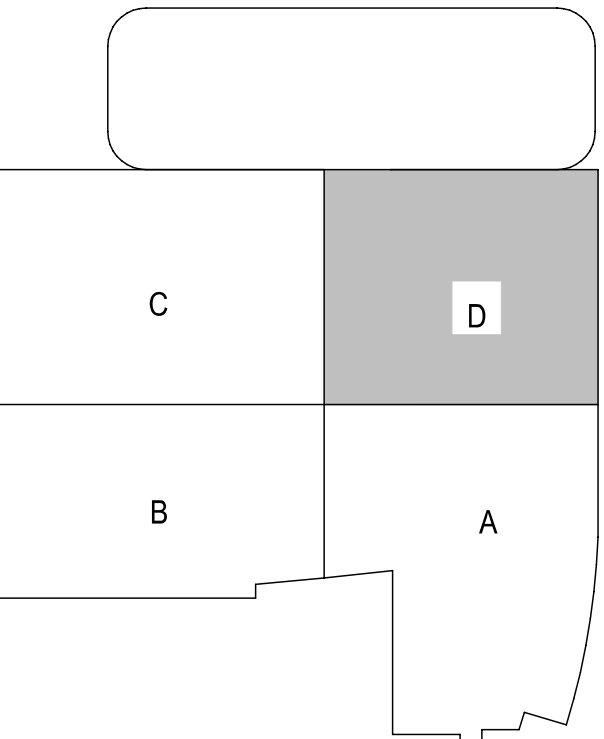

A1 KEY PLAN
SCALE: 1" = 1'-0"

NOT ISSUED

MATCHLINE AREA D

MATCHLINE AREA D

MATCHLINE AREA A

A6 FINISH PLAN
SCALE: 1/8" = 1'-0"