




FKP Architects

ARCHITECT OF RECORD

Paul C. Gloriod

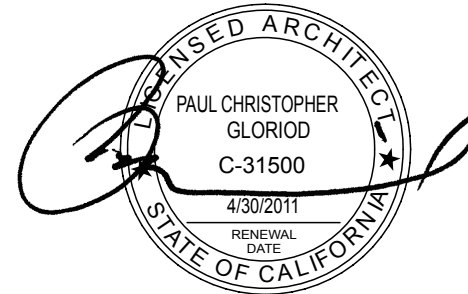

REVISIONS  
02/12/10 Information Bulletin #05

- 7/18/11 ASI 85 Delta 253
- 8/24/11 RFI 4318
- 09/19/2011 - ASI 110 Delta 330
- 5/29/2012 - ASI 218 Delta 533

PROJECT NAME  
CHILDREN'S  
HOSPITAL OF  
ORANGE COUNTY  
455 S. Main St.  
Orange, CA 92668-3874

TOWER II



PROJECT NUMBER

12011.00  
Increment # 7

OSHPD - PROJECT NUMBER  
IL 072072-30

ISSUE

DATE  
1/31/2012

SCALE

As Noted

DRAWING TITLE  
FINISH PLAN LEVEL  
5 AREA A

DRAWING NUMBER

IA5.5A

### General Notes

- REFER TO ENLARGED PLANS, ELEVATIONS, AND SECTIONS FOR ADDITIONAL FINISH INFORMATION THAT MAY NOT BE NOTED ON PLAN.
- ALL FINISHES AND MATERIALS TO BE NEW AND SHALL NOT CONTAIN ASBESTOS.
- ENSURE THAT ALL SURFACES TO RECEIVE FINISHES ARE CLEAN, TRUE AND FREE OF IRREGULARITIES. DO NOT PROCEED WITH WORK UNTIL UNSATISFACTORY CONDITIONS HAVE BEEN CORRECTED.
- ALL FINISH CONTRACTORS SHALL LEAVE REMNANTS AND REMAINING MATERIALS SAFELY STORED ON SITE FOR THE OWNER'S FUTURE USE.
- ALL FINISHES SHALL BE SUBMITTED TO INTERIOR ARCHITECT FOR APPROVAL PRIOR TO ORDERING OR INSTALLING.
- CONTINUOUS GYP BOARD WITH SURFACES OVER 30' IN LENGTH ARE TO HAVE CONTROL JOINT PER MANUFACTURERS RECOMMENDATIONS. **Except at stair shaft**
- REFER TO BASE BUILDING CORE AND SHELL GENERAL CONDITIONS AND SPECIFICATIONS FOR ADDITIONAL INFORMATION.
- ALL FINISHES AND THEIR INSTALLATION ARE TO MEET LOCAL FIRE CODE REGULATIONS. CONTRACTOR TO INCLUDE ANY NECESSARY FLAME PROOFING TREATMENT IN THEIR INITIAL PRICING.
- INSTALL BUILDING STANDARD SHOWER CURTAINS AND RODS AT ALL SHOWER LOCATIONS, UNLESS NOTED OTHERWISE.

### Sheet Notes

- SHEET VINYL AT THIS LOCATION TO BE SV-8. SOFFIT AT THIS LOCATION TO BE GC-4. PAINT AT THIS LOCATION TO BE PT-12E. ARCHITECTURAL WOODWORK AT THIS LOCATION TO BE PL-5. (RE: RCP FOR INFORMATION ON CEILING PATTERN ABOVE. FLOORING PATTERN TO MATCH CEILING LINE ABOVE.)
- SHEET VINYL AT THIS LOCATION TO BE SV-10. SOFFIT AT THIS LOCATION TO BE GC-5. PAINT AT THIS LOCATION TO BE PT-14E. ARCHITECTURAL WOODWORK AT THIS LOCATION TO BE PL-7. (RE: RCP FOR INFORMATION ON CEILING PATTERN ABOVE. FLOORING PATTERN TO MATCH CEILING LINE ABOVE.)
- SHEET VINYL AT THIS LOCATION TO BE SV-14. SOFFIT AT THIS LOCATION TO BE GC-7. PAINT AT THIS LOCATION TO BE PT-18E. ARCHITECTURAL WOODWORK AT THIS LOCATION TO BE PL-9. (RE: RCP FOR INFORMATION ON CEILING PATTERN ABOVE. FLOORING PATTERN TO MATCH CEILING LINE ABOVE.)
- SHEET VINYL AT THIS LOCATION TO BE SV-12. SOFFIT AT THIS LOCATION TO BE GC-8. PAINT AT THIS LOCATION TO BE PT-16E. ARCHITECTURAL WOODWORK AT THIS LOCATION TO BE PL-7. (RE: RCP FOR INFORMATION ON CEILING PATTERN ABOVE. FLOORING PATTERN TO MATCH CEILING LINE ABOVE.)
- DOOR AND FRAME TO BE PAINTED TO MATCH ADJACENT SURFACE.
- NOT USED.
- SHEET VINYL AT THIS LOCATION TO BE SV-20. SOFFIT AT THIS LOCATION TO BE GC-10. PAINT AT THIS LOCATION TO BE PT-24E. ARCHITECTURAL WOODWORK AT THIS LOCATION TO BE PL-11. (RE: RCP FOR INFORMATION ON CEILING PATTERN ABOVE. FLOORING PATTERN TO MATCH CEILING LINE ABOVE.)
- FLOOR PATTERN TO MATCH CEILING ABOVE. (RE: RCP)

NOTE: PROVIDE SHOP DRAWINGS OF ALL SHEET VINYL, CARPET, AND TERRAZZO FLOOR PATTERNS PRIOR TO ORDERING / FABRICATION AND INSTALLATION. PATTERNS ARE INTENDED TO BE "FREE-FORM" IN NATURE, AND HENCE CANNOT BE DIMENSIONED. CAD FILES WILL BE PROVIDED AS NECESSARY TO APPROPRIATELY MEET THE ABOVE REQUIREMENT.

### Legend

- PT-1 TOP: WALL FINISH  
PT-2 BOTTOM: BASE FINISH
- PT-4 WALL FINISH
- CP-1 FLOOR FINISH
- ..... FLOOR FINISH TRANSITION
- DENOTES FINISH EXTENTS
- 1/10 DETAIL KEY
- 1/10 ENLARGED DETAIL TAG

A1 KEY PLAN  
SCALE: 1" = 1'-0"

