

General Notes

- A. REFER TO ENLARGED PLANS, ELEVATIONS, AND SECTIONS FOR ADDITIONAL FINISH INFORMATION THAT MAY NOT BE NOTED ON PLAN.
- B. ALL FINISHES AND MATERIALS TO BE NEW AND SHALL NOT CONTAIN ASBESTOS.
- C. ENSURE THAT ALL SURFACES TO RECEIVE FINISHES ARE CLEAN, TRUE AND FREE OF IRREGULARITIES. DO NOT PROCEED WITH WORK UNTIL UNSATISFACTORY CONDITIONS HAVE BEEN CORRECTED.
- D. ALL FINISH CONTRACTORS SHALL LEAVE REMNANTS AND REMAINING MATERIALS SAFELY STORED ON SITE FOR THE OWNER'S FUTURE USE.
- E. ALL FINISHES SHALL BE SUBMITTED TO INTERIOR ARCHITECT FOR APPROVAL PRIOR TO ORDERING OR INSTALLING.
- F. CONTINUOUS GYP BOARD WITH SURFACES OVER 30' IN LENGTH ARE TO HAVE CONTROL JOINT PER MANUFACTURERS RECOMMENDATIONS. **Except at stair shaft**
- G. REFER TO BASE BUILDING CORE AND SHELL GENERAL CONDITIONS AND SPECIFICATIONS FOR ADDITIONAL INFORMATION.
- H. ALL FINISHES AND THEIR INSTALLATION ARE TO MEET LOCAL FIRE CODE REGULATIONS. CONTRACTOR TO INCLUDE ANY NECESSARY FLAME PROOFING TREATMENT IN THEIR INITIAL PRICING.
- I. INSTALL BUILDING STANDARD SHOWER CURTAINS AND RODS AT ALL SHOWER LOCATIONS, UNLESS NOTED OTHERWISE.


RFI 1048.1

Legend

- PT.1 TOP: WALL FINISH
PT.2 BOTTOM: BASE FINISH
- PT.1 WALL FINISH
- CP.1 FLOOR FINISH
- FLOOR FINISH TRANSITION
- / DENOTES FINISH EXTENTS
- A1/A1.0 SECTION KEY
- DETAIL ENLARGED DETAIL TAG
- # DENOTES SHEET NOTE

A1 KEY PLAN

SCALE: 1" = 1'-0"

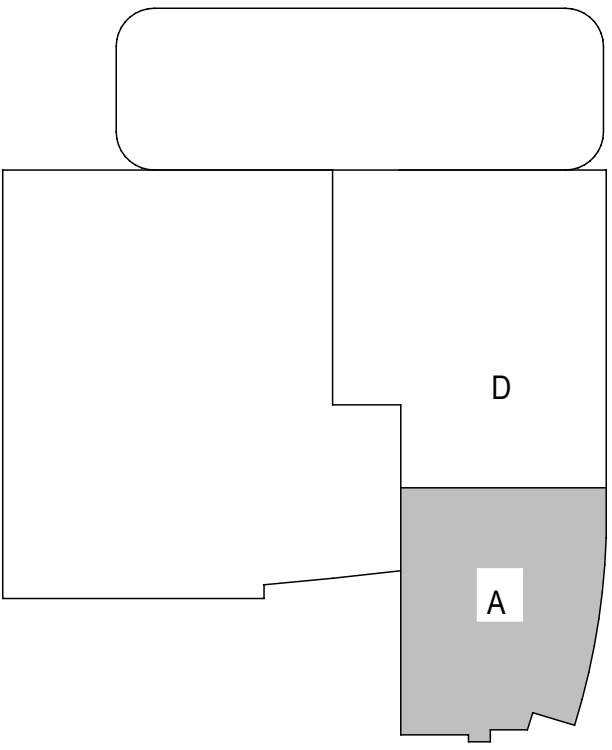

FKP Architects

ARCHITECT OF RECORD

Paul C. Gloriod



INVENTURE
DESIGN

REVISIONS

02/12/10 Information Bulletin #05



5/29/2012 - ASI 218
Delta 533

PROJECT NAME

CHILDREN'S
HOSPITAL OF
ORANGE COUNTY

455 S. Main St.
Orange, CA 92668-3874

TOWER II

CHOCSM
HOSPITAL

PROJECT NUMBER

12011.00
Increment # 7

OSHPO - PROJECT NUMBER

IL 072072-30

ISSUE

DATE

1/31/2012

SCALE

As Noted

DRAWING TITLE

FINISH PLAN LEVEL
6 AREA A

DRAWING NUMBER

IA5.6A