



FKP Architects

ARCHITECT OF RECORD

Paul C. Gloriod



REVISIONS

02/12/10

Information Bulletin #05



1/31/12 ASI 159 Delta  
142

### General Notes

- A. SMALL PIECES IN DESIGN NOT DESIGNATED WITH SPECIFIC FINISH CODE TO BE INSTALLED FROM A RANDOM ASSORTMENT OF ALL SCHEDULED ACCENT COLOR SHEET VINYL.
- B. ALL PIECES OF SHEET VINYL IN PATTERNED AREA TO BE WATER JET CUT AND SEAMS TO BE CHEMICALLY BONDED.

RFI 5832


### Sheet Notes

- SEE IA6.1/C6 FOR ELEVATOR CAB FLOOR FINISH INFORMATION. PATTERN SHOWN FOR RELATIONSHIP TO ADJACENT PATTERN ONLY.
- SHEET VINYL ACCENT COLOR LISTED PER ALCOVE NURSE STATION. FLOOR PATTERN TO MATCH PATTERN IN CEILING ABOVE. SEE RCP FOR DIMENSION. SOFFIT COLOR TO BE LISTED PER ALCOVE. (RE: FINISH PLANS FOR PAINT COLOR)
- PAINT COLOR LISTED PER ALCOVE. (RE: FINISH PLANS FOR PAINT COLOR)
- CURVE IN SHEET VINYL TO MATCH CURVE IN CEILING. SEE RCP FOR DIMENSION.
- HATCH INDICATES DIRECTION OF GRAIN ONLY.


**NOTE: PROVIDE SHOP DRAWINGS OF ALL SHEET VINYL, CARPET, AND TERRAZZO FLOOR PATTERNS PRIOR TO ORDERING / FABRICATION AND INSTALLATION. PATTERNS ARE INTENDED TO BE "FREE-FORM" IN NATURE, AND HENCE CANNOT BE DIMENSIONED. CAD FILES WILL BE PROVIDED AS NECESSARY TO APPROPRIATELY MEET THE ABOVE REQUIREMENT.**

### Legend


- PT-1 TOP: WALL FINISH  
BT-1 BOTTOM: BASE FINISH
- PT-1 WALL FINISH
- CP-1 FLOOR FINISH
- ..... FLOOR FINISH TRANSITION
- DENOTES FINISH EXTENTS

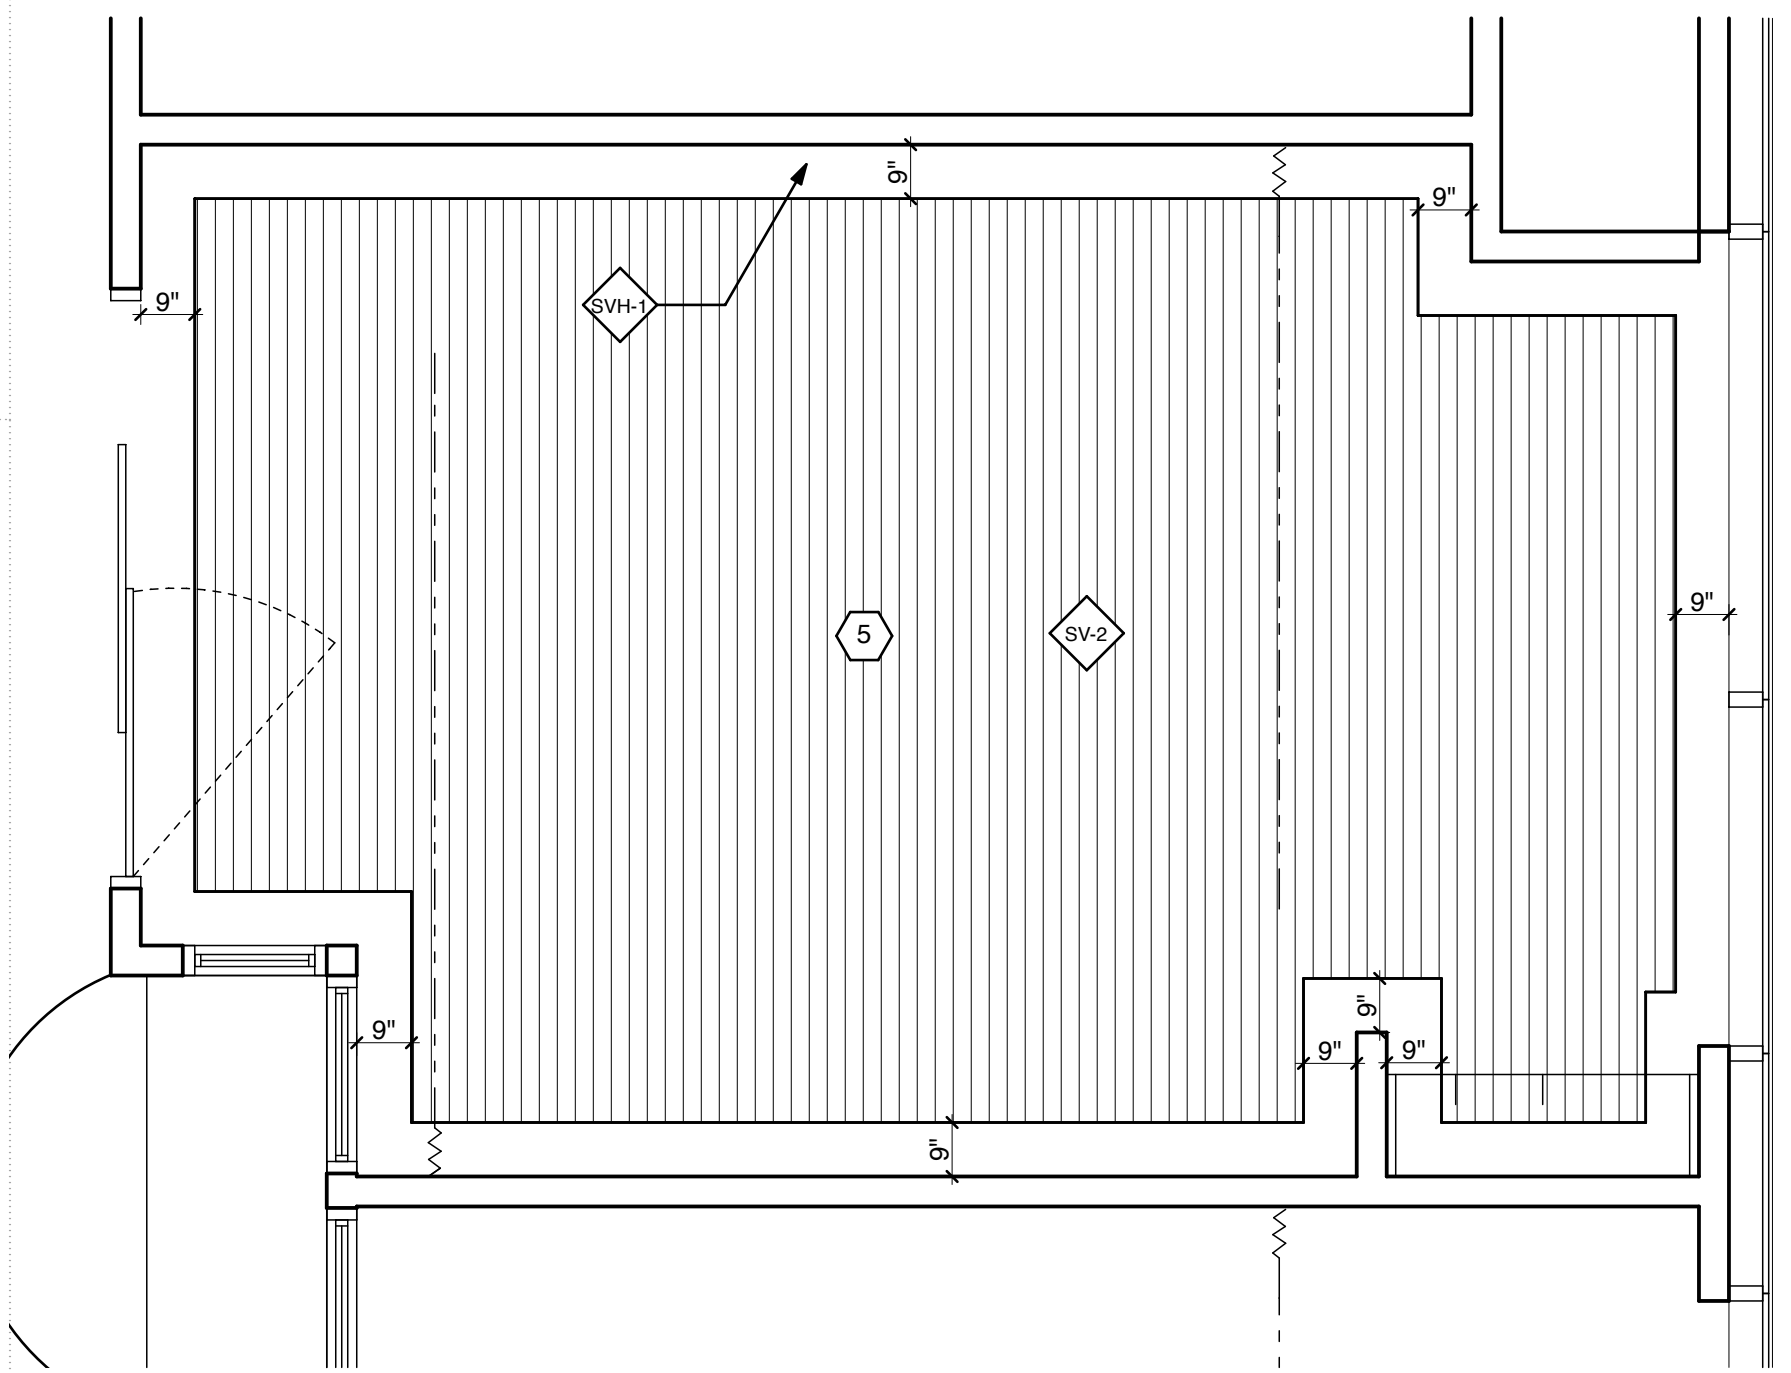

D5 Enlarged Floor Plan - Lv. 6  
SCALE: 3/8" = 1'-0"

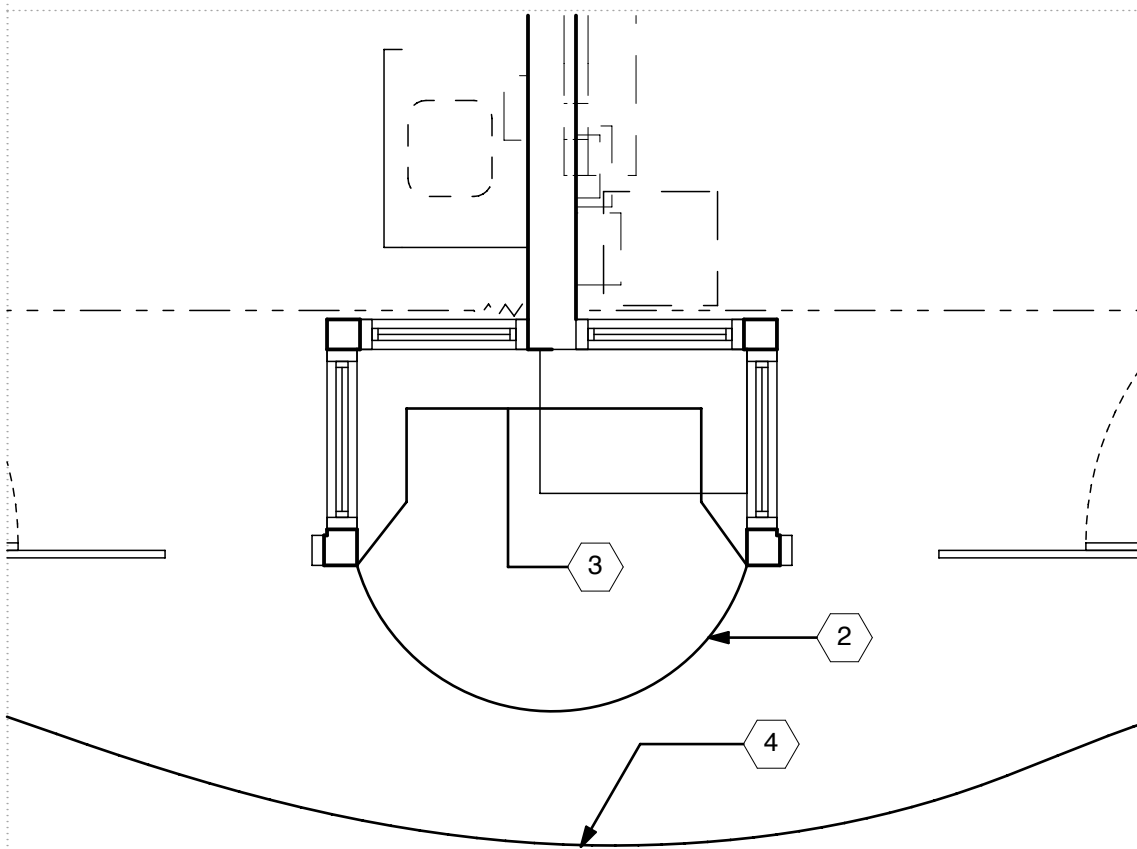

D3 TYPICAL ALCOVE NURSE STATION DETAIL  
SCALE: 3/8" = 1'-0"

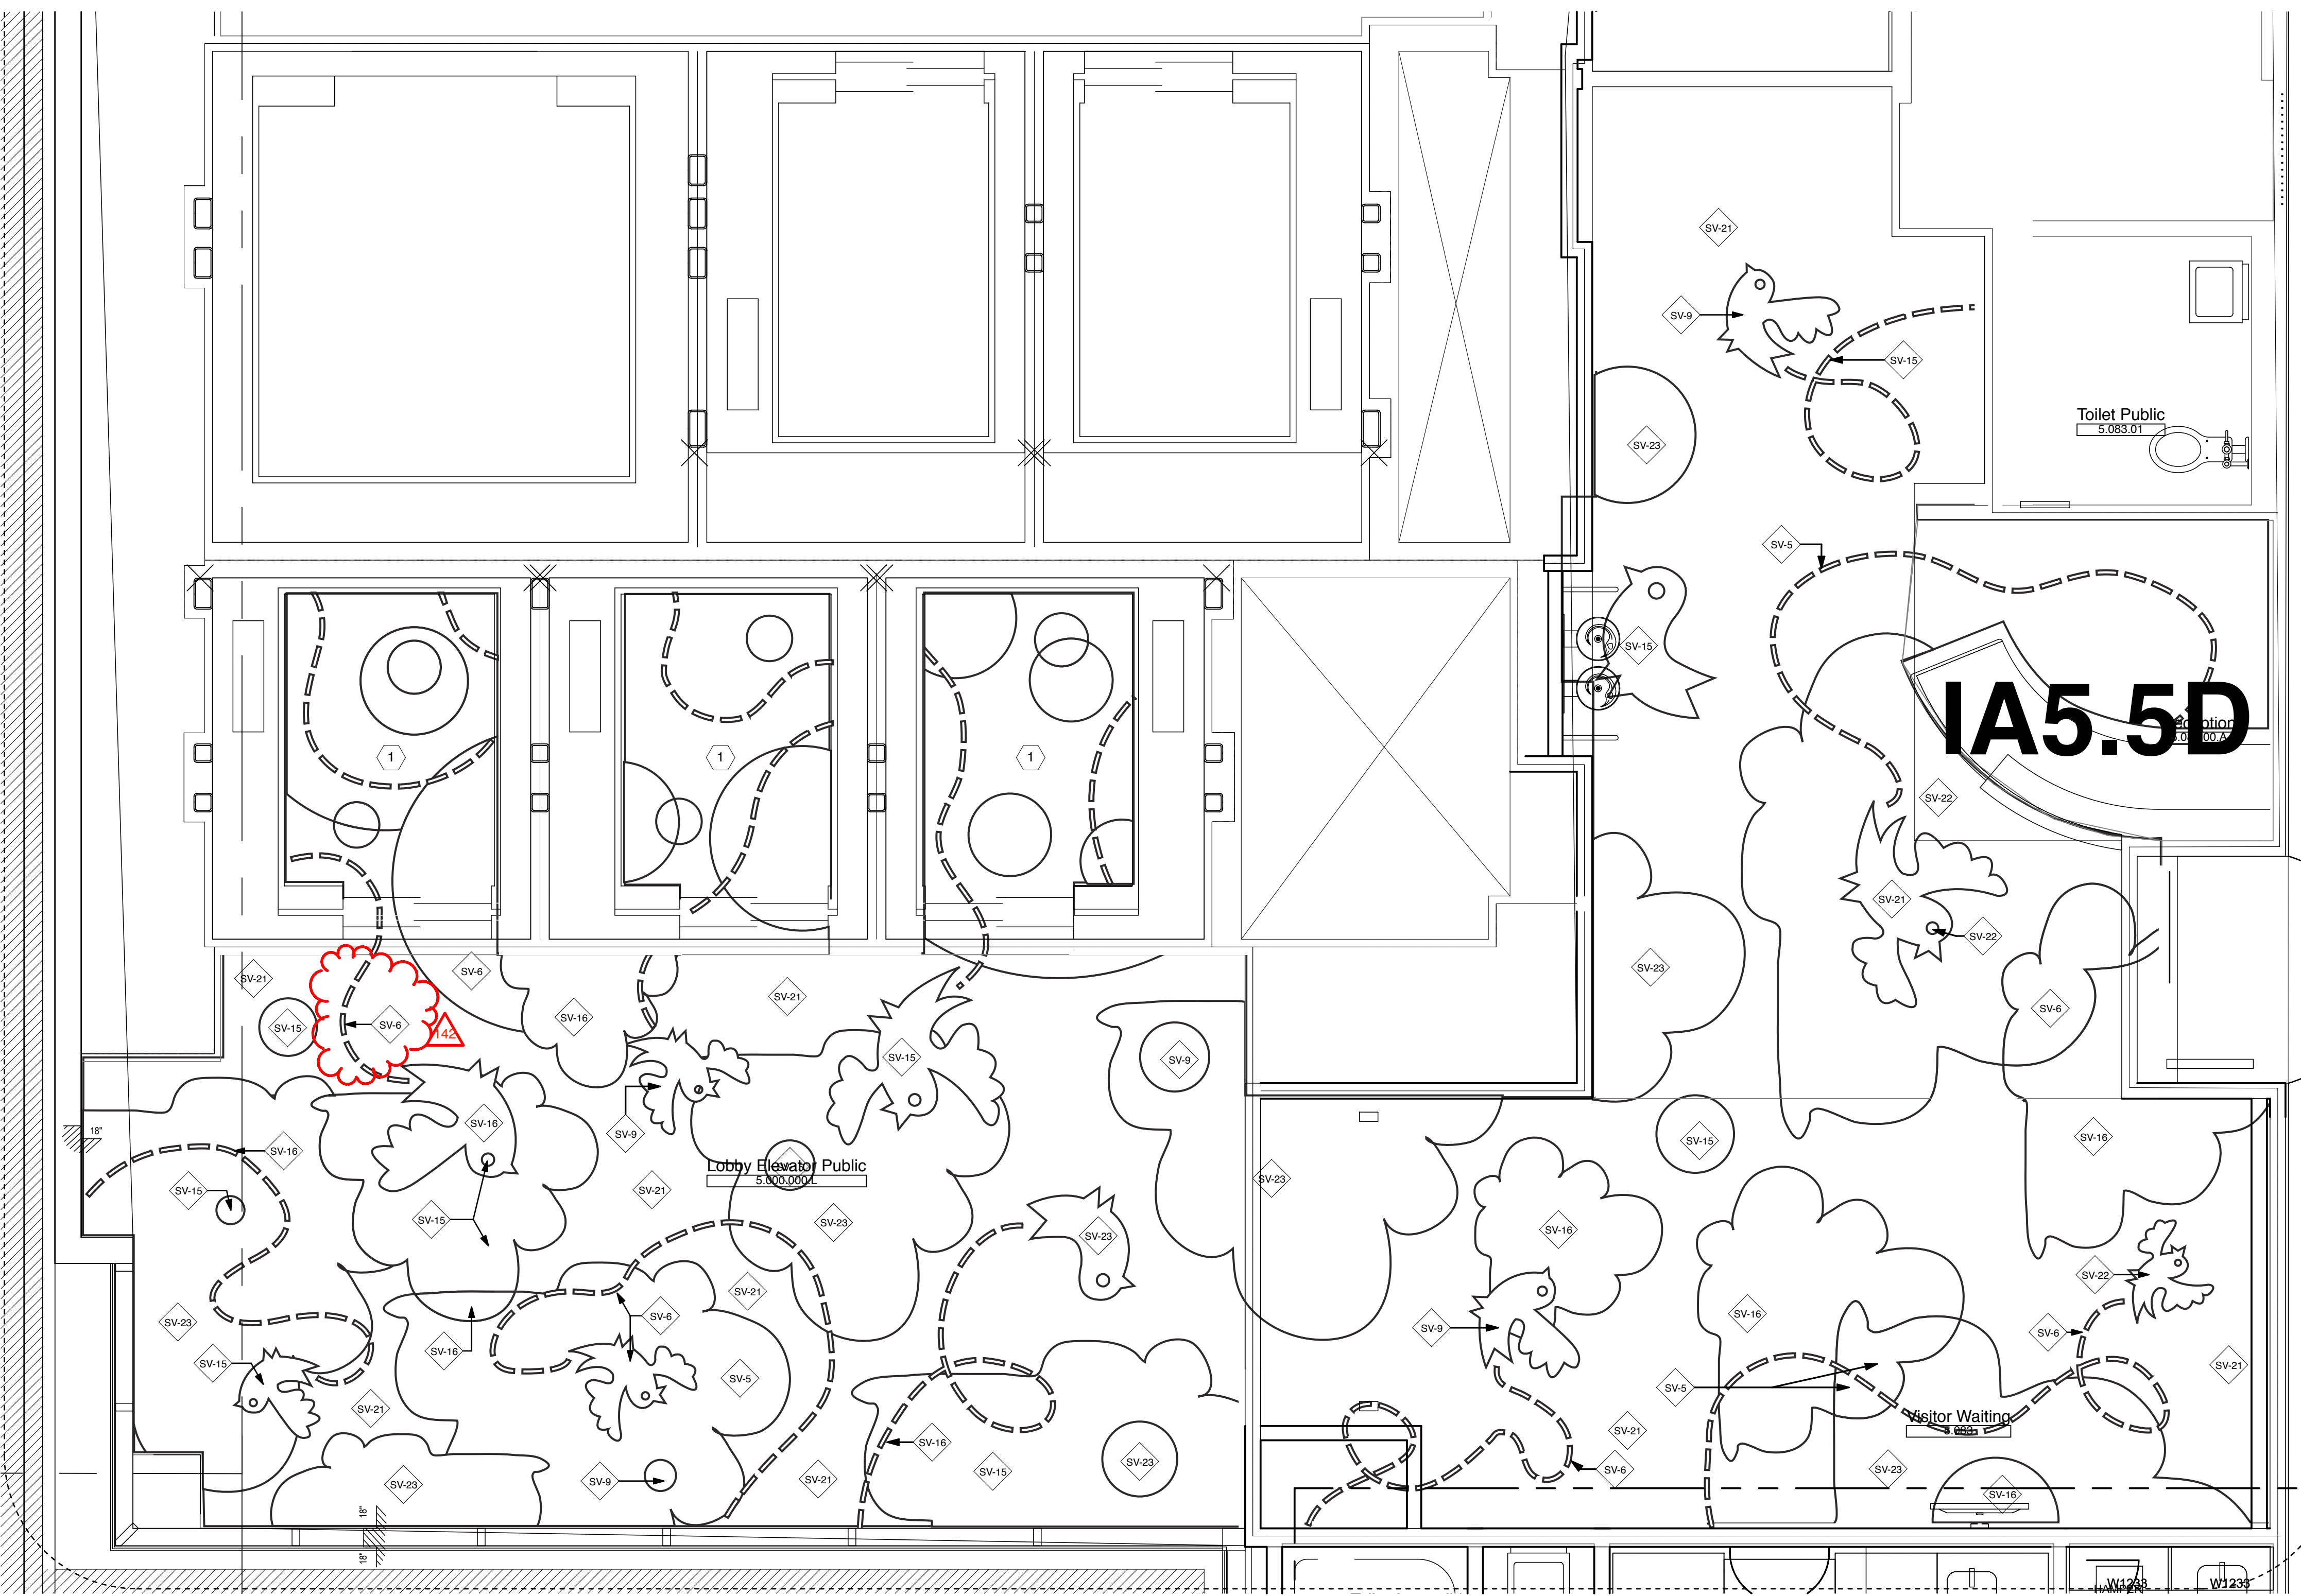

A6 Enlarged Floor Plan - Lv. 5  
SCALE: 3/8" = 1'-0"

PROJECT NAME

CHILDREN'S  
HOSPITAL OF  
ORANGE COUNTY

455 S. Main St.  
Orange, CA 92668-3874

TOWER II



PROJECT NUMBER

12011.00  
Increment # 7

OSHDP - PROJECT NUMBER

IL 072072-30

ISSUE

ASI 159 Delta 142

DATE

1/31/2012

SCALE

As Noted

DRAWING TITLE

ENLARGED PLANS

DRAWING NUMBER

IA6.5