




FKP Architects

ARCHITECT OF RECORD
Paul C. Gloriod

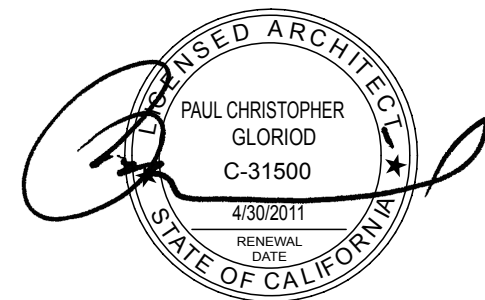

REVISIONS

02/12/10 Information Bulletin #05

1/31/12 ASI 159 Delta 142

PROJECT NAME
**CHILDREN'S
HOSPITAL OF
ORANGE COUNTY**
455 S. Main St.
Orange, CA 92668-3874

TOWER II



PROJECT NUMBER

12011.00
Increment # 7

OSHPO - PROJECT NUMBER

IL 072072-30

ISSUE

ASI 159 Delta 142

DATE

1/31/2012

SCALE

As Noted

DRAWING TITLE

ENLARGED PLANS

DRAWING NUMBER

IA6.6

General Notes

- A. SMALL PIECES IN DESIGN NOT DESIGNATED WITH SPECIFIC FINISH CODE TO BE INSTALLED FROM A RANDOM ASSORTMENT OF ALL SCHEDULED ACCENT COLOR SHEET VINYL.
- B. ALL PIECES OF SHEET VINYL IN PATTERNED AREA TO BE WATER JET CUT AND SEAMS TO BE CHEMICALLY BONDED.

RFI 5832

Sheet Notes

1. SEE IA6.1/C6 FOR ELEVATOR CAB FLOOR FINISH INFORMATION. PATTERN SHOWN FOR RELATIONSHIP TO ADJACENT PATTERN ONLY.

NOTE: PROVIDE SHOP DRAWINGS OF ALL SHEET VINYL, CARPET, AND TERRAZZO FLOOR PATTERNS PRIOR TO ORDERING / FABRICATION AND INSTALLATION. PATTERNS ARE INTENDED TO BE "FREE-FORM" IN NATURE, AND HENCE CANNOT BE DIMENSIONED. CAD FILES WILL BE PROVIDED AS NECESSARY TO APPROPRIATELY MEET THE ABOVE REQUIREMENT.

Legend

- PT-1 TOP: WALL FINISH
PT-2 BOTTOM: BASE FINISH
- PT-1 WALL FINISH
- CP-1 FLOOR FINISH
- FLOOR FINISH TRANSITION
- DENOTES FINISH EXTENTS

A6 Enlarged Floor Plan - Lv. 6

SCALE 3/8" = 1'-0"

RFI 5887

RFI 6004