


ARCHITECT OF RECORD
Paul C. Gloriod

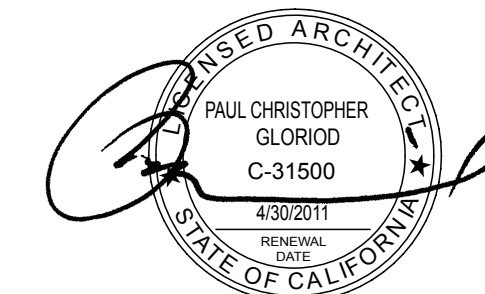

REVISIONS

02/12/10 Information Bulletin #05

1/31/12 ASI 159 Delta
142

PROJECT NAME
CHILDREN'S
HOSPITAL OF
ORANGE COUNTY
455 S. Main St.
Orange, CA 92868-3874

TOWER II



PROJECT NUMBER

12011.00
Increment # 7

OSHPD - PROJECT NUMBER
IL 072072-30

ISSUE

ASI 159 Delta 142

DATE _____

1/31/2012

SCAL

As Noted

DRAWING TITLE

ENLARGED PLANS

DRAWING NUMBER

IA6.7

A. SMALL PIECES IN DESIGN NOT DESIGNATED WITH SPECIFIC FINISH CODE TO BE INSTALLED FROM A RANDOM ASSORTMENT OF ALL SCHEDULED ACCENT COLOR SHEET VINYL.

B. ALL PIECES OF SHEET VINYL IN PATTERNED AREA TO BE WATER JET CUT AND SEAMS TO BE CHEMICALLY BONDED.

RFI 5832

1. SEE IA6.1/C8 FOR ELEVATOR CAB FLOOR FINISH INFORMATION. PATTERN SHOWN FOR RELATIONSHIP TO ADJACENT PATTERN ONLY.

2.

PT-1
BS-1
TOP: WALL FINISH
BOTTOM: BASE FINISH

PT-1
WALL FINISH

CP-1
FLOOR FINISH

.....FLOOR FINISH TRANSITION

DENOTES FINISH EXTENTS

A6 Enlarged Floor Plan - Lv. 7
SCALE: 3/8" = 1'-0"

6

5

4

3

2

1