


ARCHITECT OF RECORD  
Paul C. Gloriod

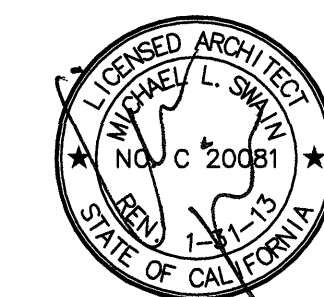

Changes on these drawings do not consist of materially altered changes to approved drawings and don't require a change order.

OSHPD review ACO \_\_\_\_\_

OSHPD review FLSO \_\_\_\_\_

OSHPD review DSF \_\_\_\_\_

## REVISIONS

224 07/18/11 CO #176

APPROVAL

TOWER II

PROJECT NUMBER

OSHPD - PROJECT NUMBER  
IL 072072-30

ISSUE  
OSHPD PERMIT

DATE 01/27/2010

SCALE

AS NOTED


## Level 1 Feature Wall Profiles

DRAWING NUMBER

IA7.10

FOR REFERENCE ONLY

CO #176

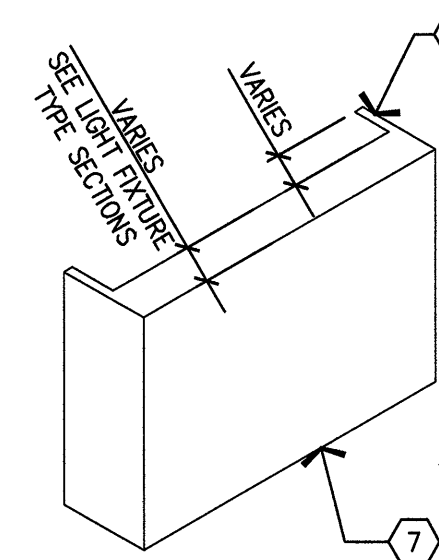

RFI 4424  
27 regular corner bead to be installed  
at 90 degree corners


1. STAINLESS STEEL SURFACE MOUNTED BASE
2. STANDARD SHEETROCK BOARD LIGHT FIXTURE
3. PROVIDE (4) 1/4" LAYER, 1/2" ON, OVER SCHED. LATE OYP.
4. PROVIDE (1) LAYER OF GP. BD.
5. PROVIDE (2) LAYERS OF GP. BD.
6. 1/4" REFLECTIVE PANEL FASTENS TO WALL BY OTHERS
7. 3 POINT LIGHT
8. 1/4" BARE METAL BACKING SHAPE
9. 2 1/2" MAX.  $\times$  1 1/2"  $\times$  1 3/4"
10. 2 1/2" MAX.  $\times$  1 1/2"  $\times$  3 3/4"
11. 2 1/2" MAX.  $\times$  1 1/2"  $\times$  1 3/4"
12. 2 1/2" MAX.  $\times$  1 1/2"  $\times$  1 3/4"
13. 16 GA CP AT 12" OC. - ONLY AT LIGHT BOX.
14. SCHED. WALL TILE
15. LONG SIDE PANEL TO BE SCRIBED TO WALL
16. HOT CHANNEL
17. SP LIGHT BOX (TYP.) - 4" MIN. DEPTH
18. BACKING PLATE 16 GA.  $\times$  6" CENT. BACKING APPLIED TO OYSPM BOARD TYPED
19. 250125S-4A SCINT. TRACK-TYP.
20. 400125S-3A SCINT. TRACK-TYP.
21. 250500S-4A METAL STUD @ 12" OC. - TYP.
22. 400500S-4A METAL STUDS @ 12" OC. W/ 2 LAYERS OF OYSPM BOARD
23. JENSEN'S-5A METAL STUDS @ 12" OC. - TYP.
24. PROVIDE 3" ANCHOR, 4  $\times$  4 X 6 EACH LIGHT BOX. CENTER CORNER
25. EXIST LIGHT BOX AND RUN OF 4" ON EACH FURRED WALL - TYPICAL

⑤ NOTES TO SHEET


TYPE  RFI 5583; TYP at various light boxes as noted

**E3 LIGHT BOX AT LEVEL1 CONVEX WALL**

**(F1) NOTES TO SHEET**

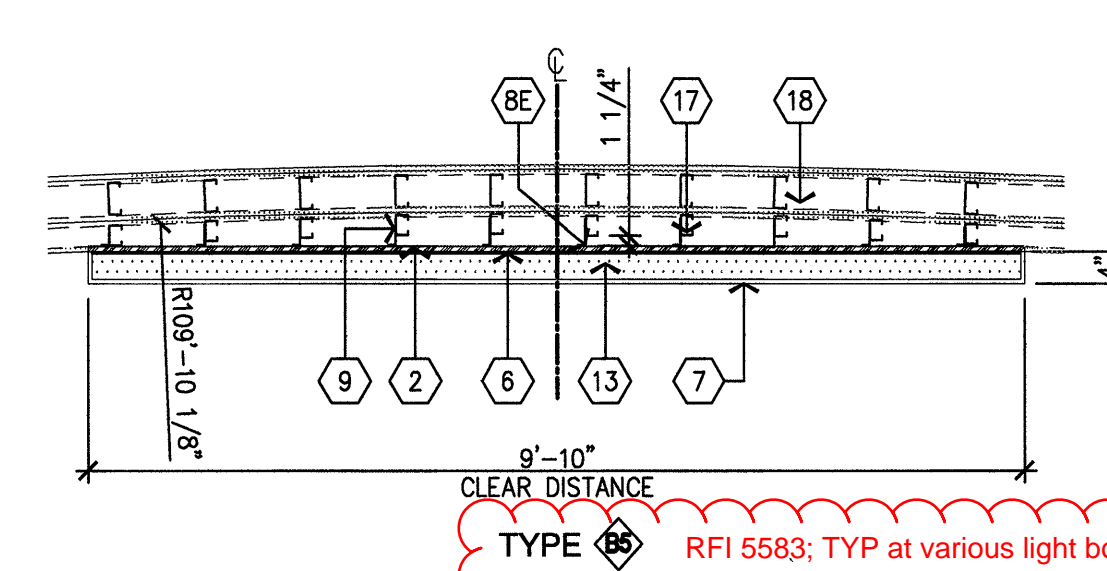

**SECTION AT LIGHT FIXT.**  
SCALE: 1/2"=1'-0"

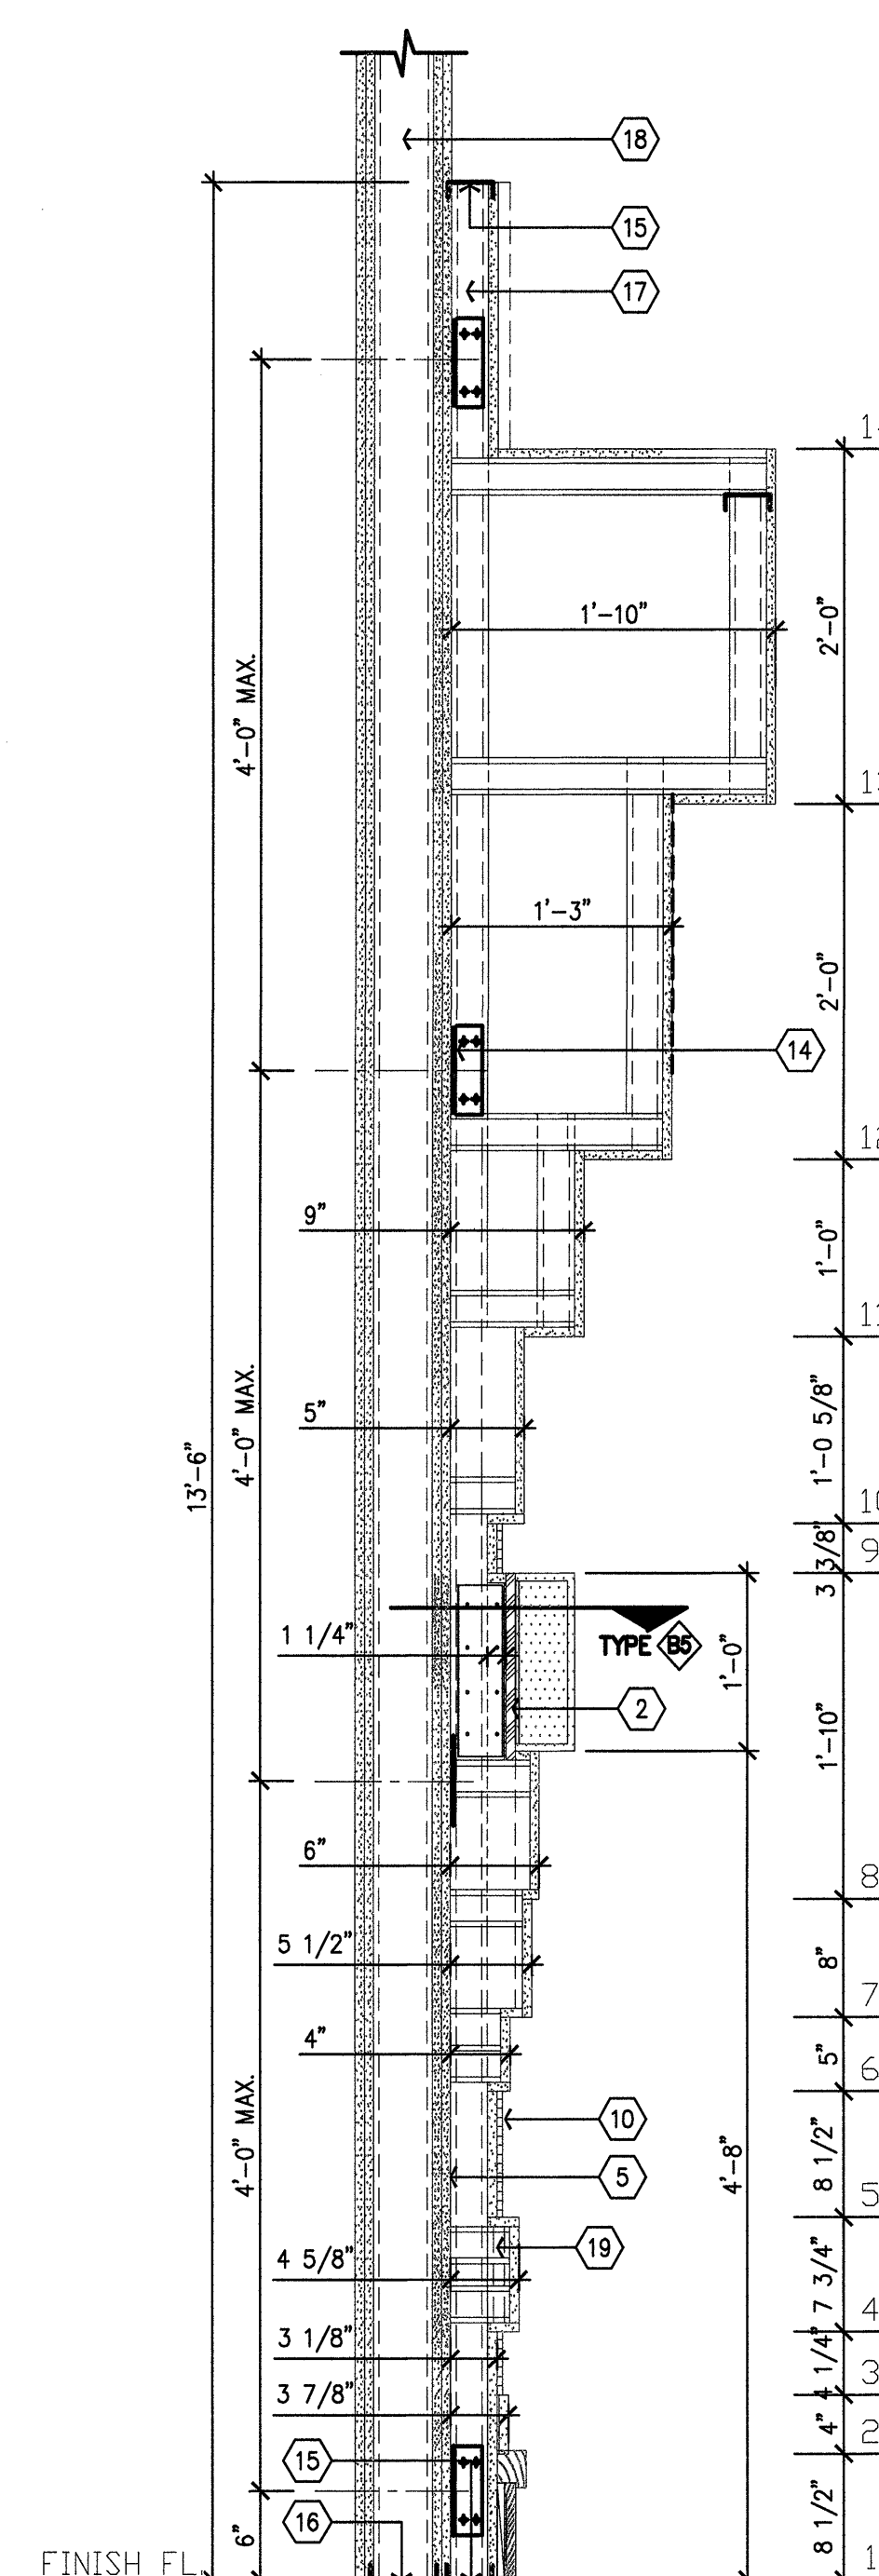

**A2** PROFILE @ LIGHT BOX