


FKP Architects

ARCHITECT OF RECORD

Paul C. Gloriot

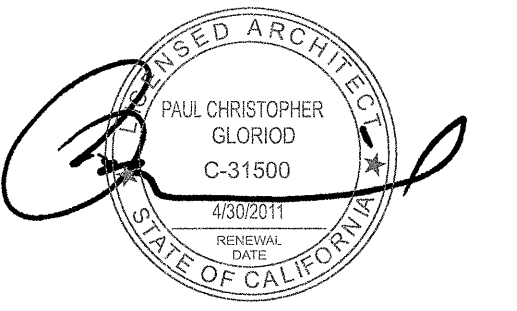

INVENTURE
DESIGN

REVISIONS

NO.	DATE	DESCRIPTION
30	09/27/10	ASI #5
29	07/18/11	CO # 176

PROJECT NAME
**CHILDREN'S
HOSPITAL OF
ORANGE COUNTY**
455 S. Main St.
Orange, CA 92668-3874

TOWER II
RECEIVED
July 20 2011
McCarthy

CHOC
HOSPITAL

PROJECT NUMBER

12011.00
Increment # 7

OSHPD - PROJECT NUMBER

IL 072072-30

ISSUE

CO # 176

DATE

07/18/2011

SCALE

As Noted

DRAWING TITLE

Details (Level 2
Feature Wall)

DRAWING NUMBER

IA7.5

FOR REFERENCE ONLY

RFI 5314: Feature Wall
to be painted PT-1

