


FKP Architects

ARCHITECT OF RECORD

Paul C. Glorid

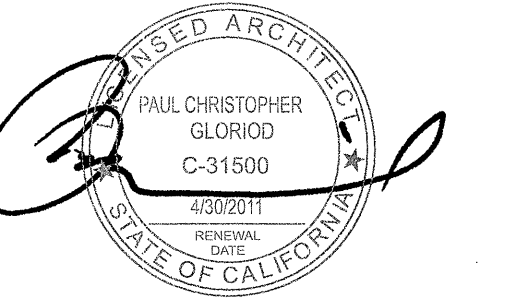

REVISIONS

30	09/27/10	ASI #5
22	07/18/11	CO # 176

PROJECT NAME  
CHILDREN'S  
HOSPITAL OF  
ORANGE COUNTY  
455 S. Main St.  
Orange, CA 92668-3874

TOWER II  
RECEIVED  
July 20 2011  
McCarthy



PROJECT NUMBER

12011.00  
Increment # 7

OSHPD - PROJECT NUMBER

IL 072072-30

ISSUE

CO # 176

DATE

07/18/2011

SCALE

As Noted

DRAWING TITLE



Details (Level 2  
Feature Wall)

DRAWING NUMBER

IA7.6

FOR REFERENCE ONLY

RFI 5314: Feature Wall  
to be painted PT-1

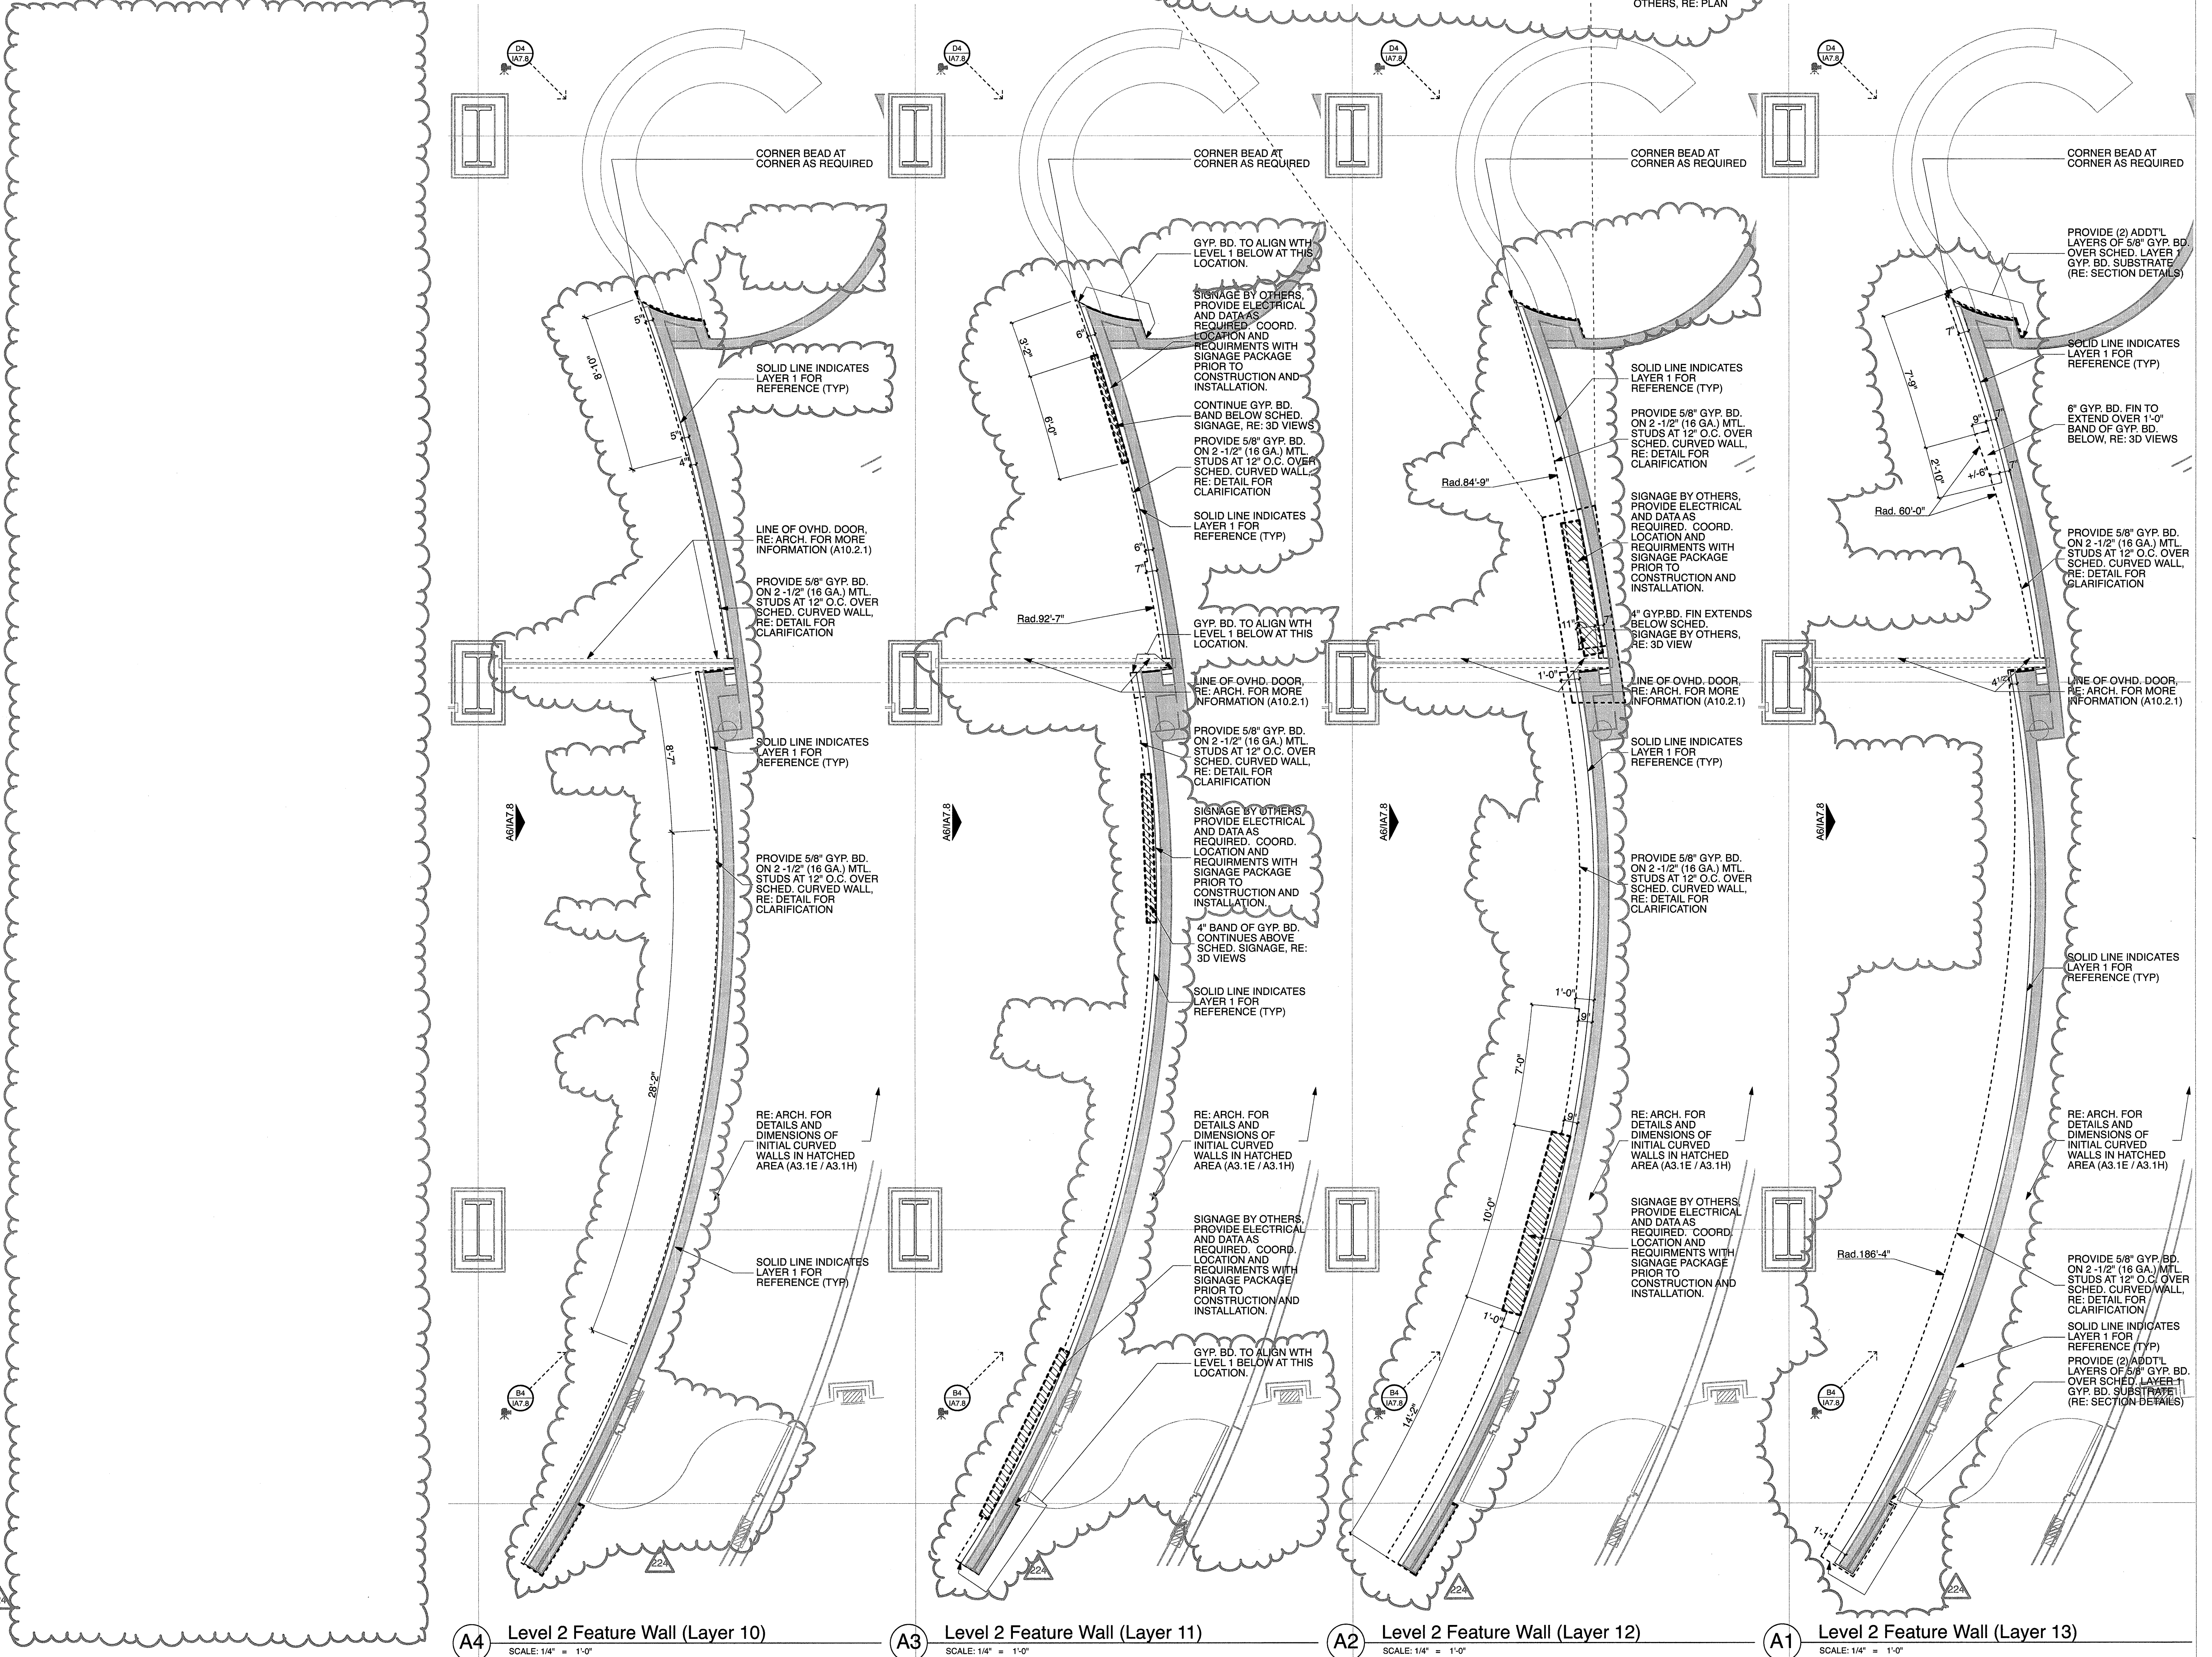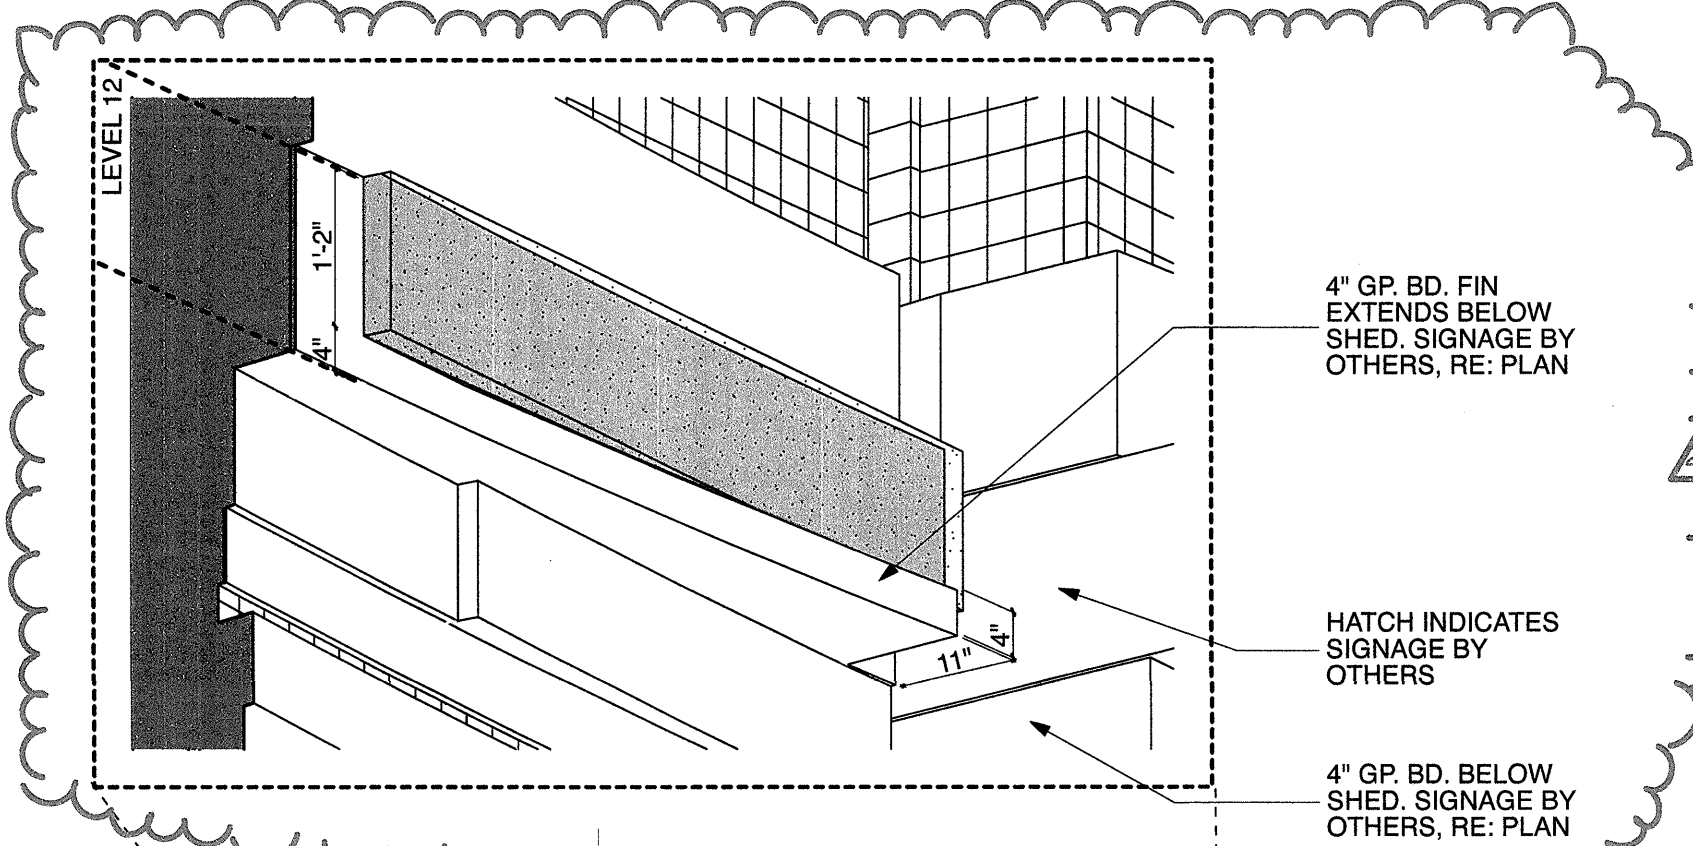

A4 Level 2 Feature Wall (Layer 10)  
SCALE: 1/4" = 1'-0"

A3 Level 2 Feature Wall (Layer 11)  
SCALE: 1/4" = 1'-0"

A2 Level 2 Feature Wall (Layer 12)  
SCALE: 1/4" = 1'-0"

A1 Level 2 Feature Wall (Layer 13)  
SCALE: 1/4" = 1'-0"