


FKP Architects

ARCHITECT OF RECORD

Paul C. Gloriod

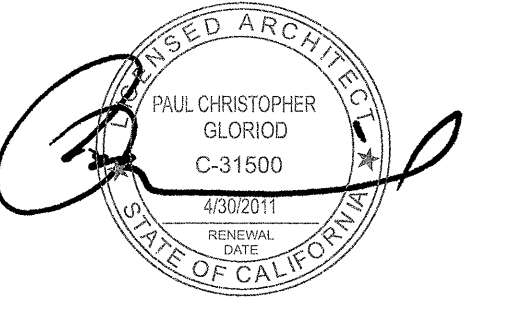

REVISIONS

30	09/27/10	ASI #5
29	07/18/11	CO # 176

NUMBERS INDICATE THE "LEVEL" OF THE CORRESPONDING PLAN DETAIL, RE: IA7.3 / IA7.4 FOR PLAN VIEWS OF EACH LEVEL, TYP.

HATCH INDICATES GRAPHIC LIGHT BOX, TYP. THROUGHOUT. COORDINATE SIZE LOCATION AND DETAILS WITH SIGNAGE PACKAGE. PLAN DIMENSIONS PROVIDED ON IA7.10 / IA7.11 (PROVIDE POWER / DATA CONNECTION PER SIGNAGE PACKAGE)

SCHED. WALL TILE

SCHED. 8" FLUSH BRUSHED SS STL. BASE, RE: DETAILS

SCHED. WALL TILE

HATCH INDICATES GRAPHIC LIGHT BOX, TYP. THROUGHOUT. COORDINATE SIZE LOCATION AND DETAILS WITH SIGNAGE PACKAGE. PLAN DIMENSIONS PROVIDED ON IA7.10 / IA7.11 (PROVIDE POWER / DATA CONNECTION PER SIGNAGE PACKAGE)

SCHED. WALL TILE

SCHED. 8" FLUSH BRUSHED SS STL. BASE, RE: DETAILS

HATCH INDICATES GRAPHIC LIGHT BOX, TYP. THROUGHOUT. COORDINATE SIZE LOCATION AND DETAILS WITH SIGNAGE PACKAGE. PLAN DIMENSIONS PROVIDED ON IA7.10 / IA7.11 (PROVIDE POWER / DATA CONNECTION PER SIGNAGE PACKAGE)

SCHED. PTD. GYP. BD. SUBSTRATE, RE: DETAILS

SCHED. BASE

PROJECT NAME
CHILDREN'S HOSPITAL OF ORANGE COUNTY
455 S. Main St.
Orange, CA 92668-3874

TOWER II RECEIVED
July 20 2011
McCarthy



PROJECT NUMBER

12011.00
Increment # 7

OSHPD - PROJECT NUMBER

IL 072072-30

ISSUE

CO # 176

DATE

07/18/2011

SCALE

As Noted

DRAWING TITLE

Level 1 3D Views

DRAWING NUMBER

IA7.7

FOR REFERENCE ONLY

