


FKP Architects

ARCHITECT OF RECORD
Paul C. Gloriod

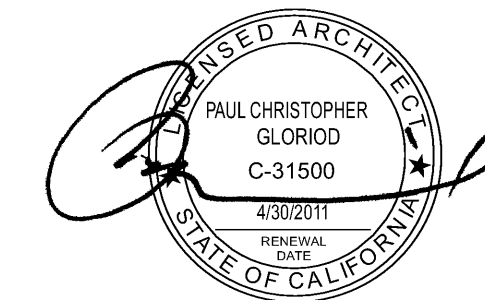

REVISIONS
9.27.2010 ASI No. 14

PROJECT NAME
**CHILDREN'S
HOSPITAL OF
ORANGE COUNTY**
455 S. Main St.
Orange, CA 92868-3874



PROJECT NUMBER

12011.00
Increment # 7

OSHPD - PROJECT NUMBER
IL 072072-30

ISSUE

ASI #14

DATE

07/21/2010

SCALE


As Noted

DRAWING TITLE


ELEVATIONS
LEVEL 2

DRAWING NUMBER


IA8.5

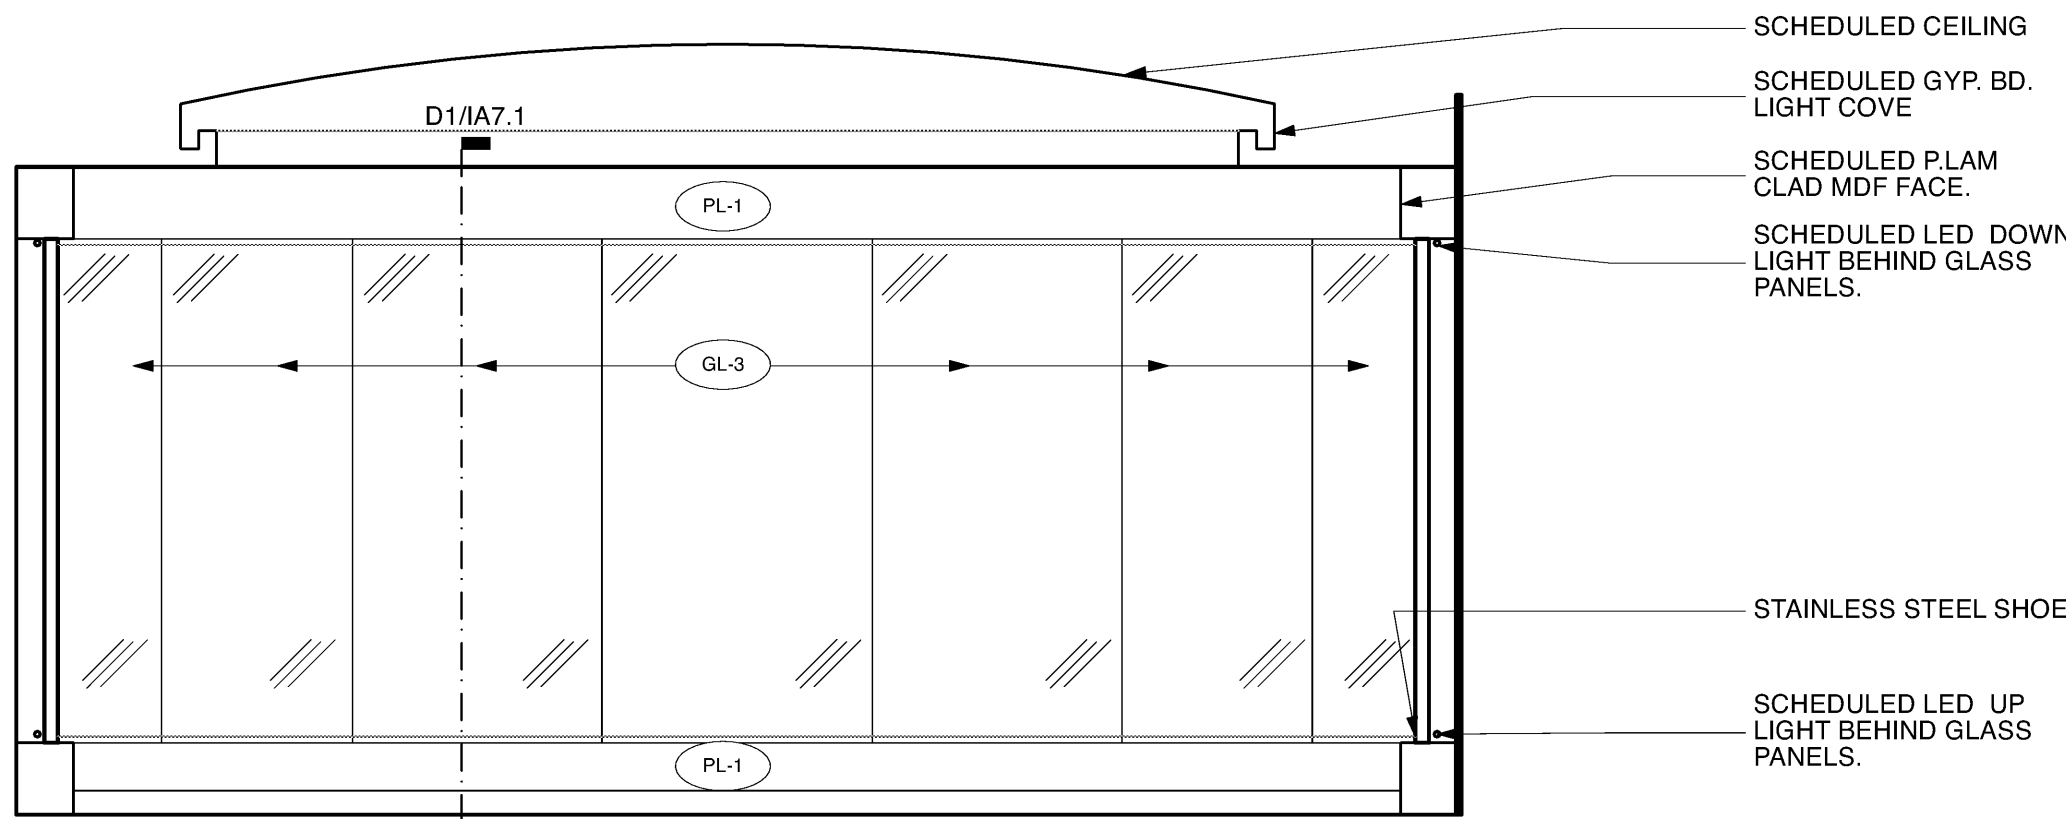


E5 Level 2 Meditation 1
SCALE: 3/8" = 1'-0"

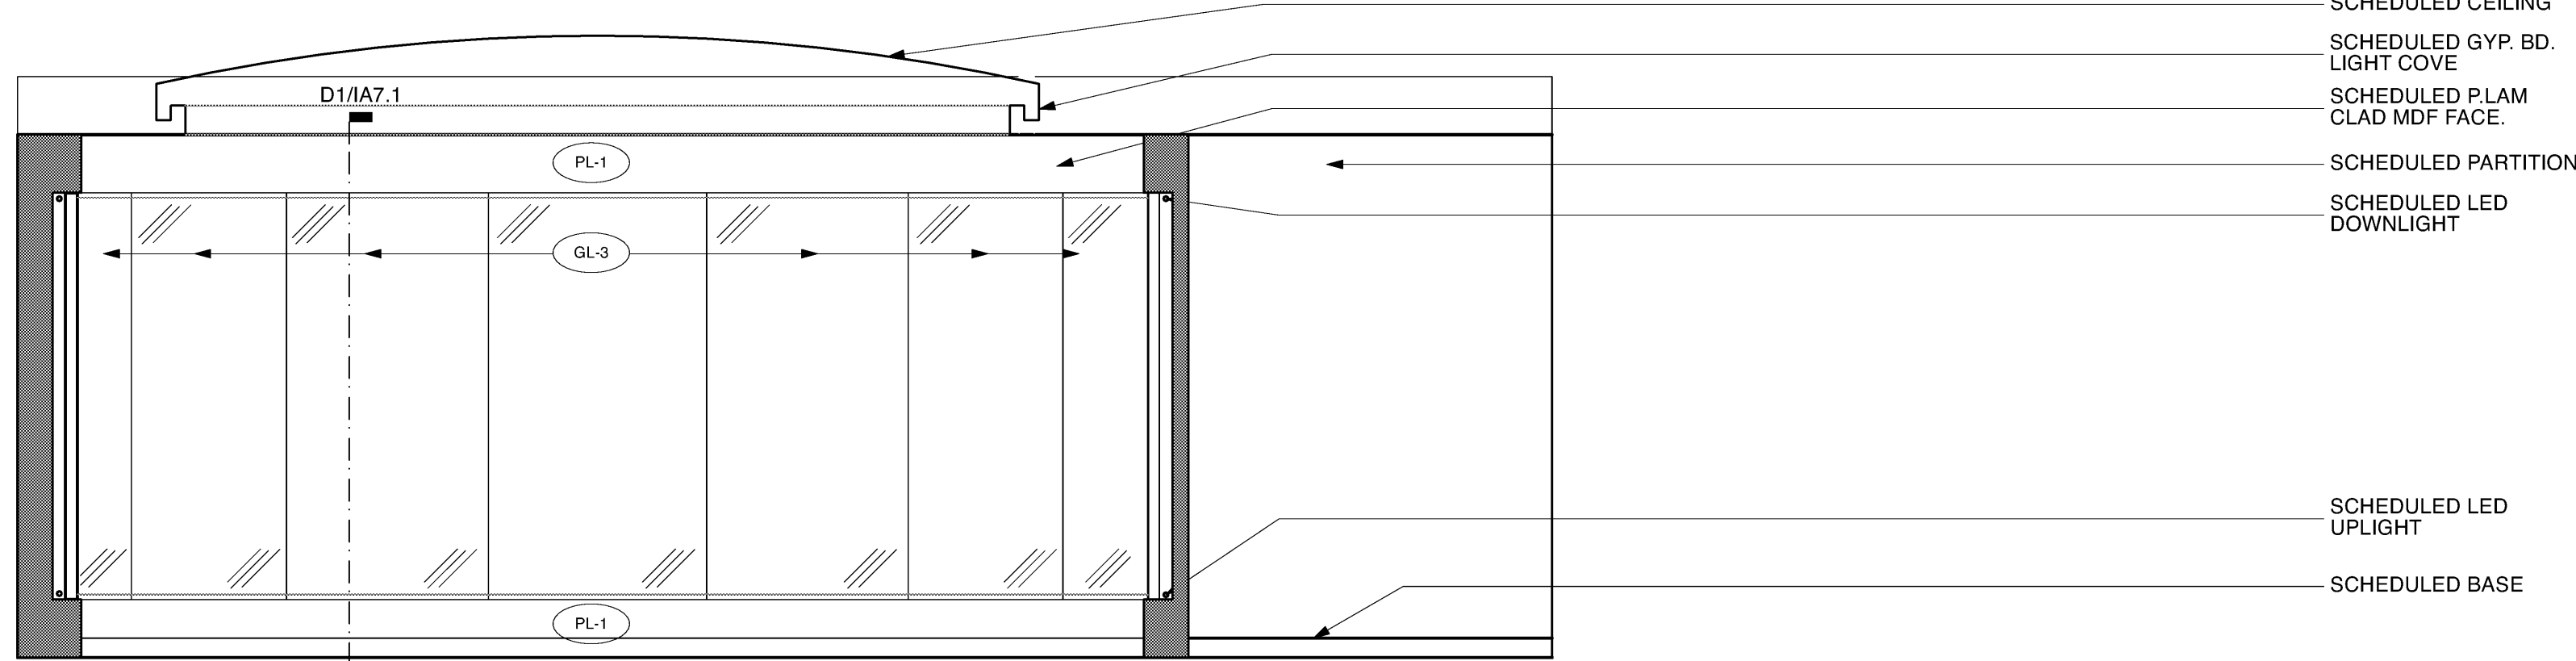


E3 Level 2 Meditation 2
SCALE: 3/8" = 1'-0"

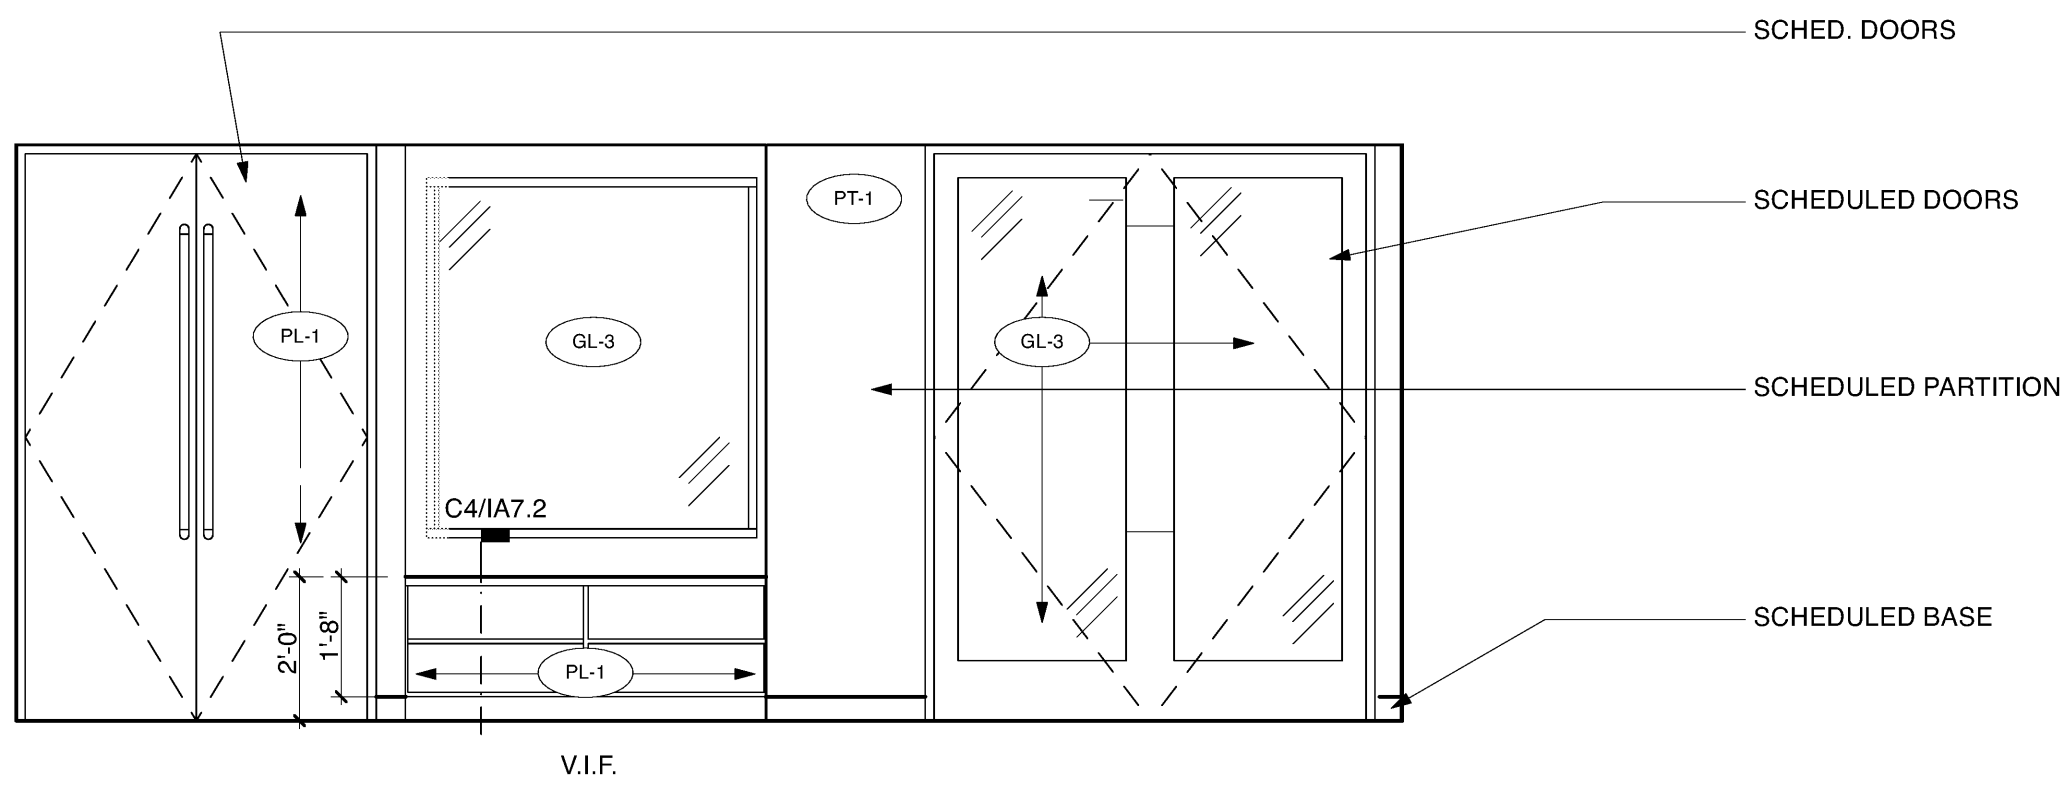


D5 Level 2 Meditation 3
SCALE: 3/8" = 1'-0"

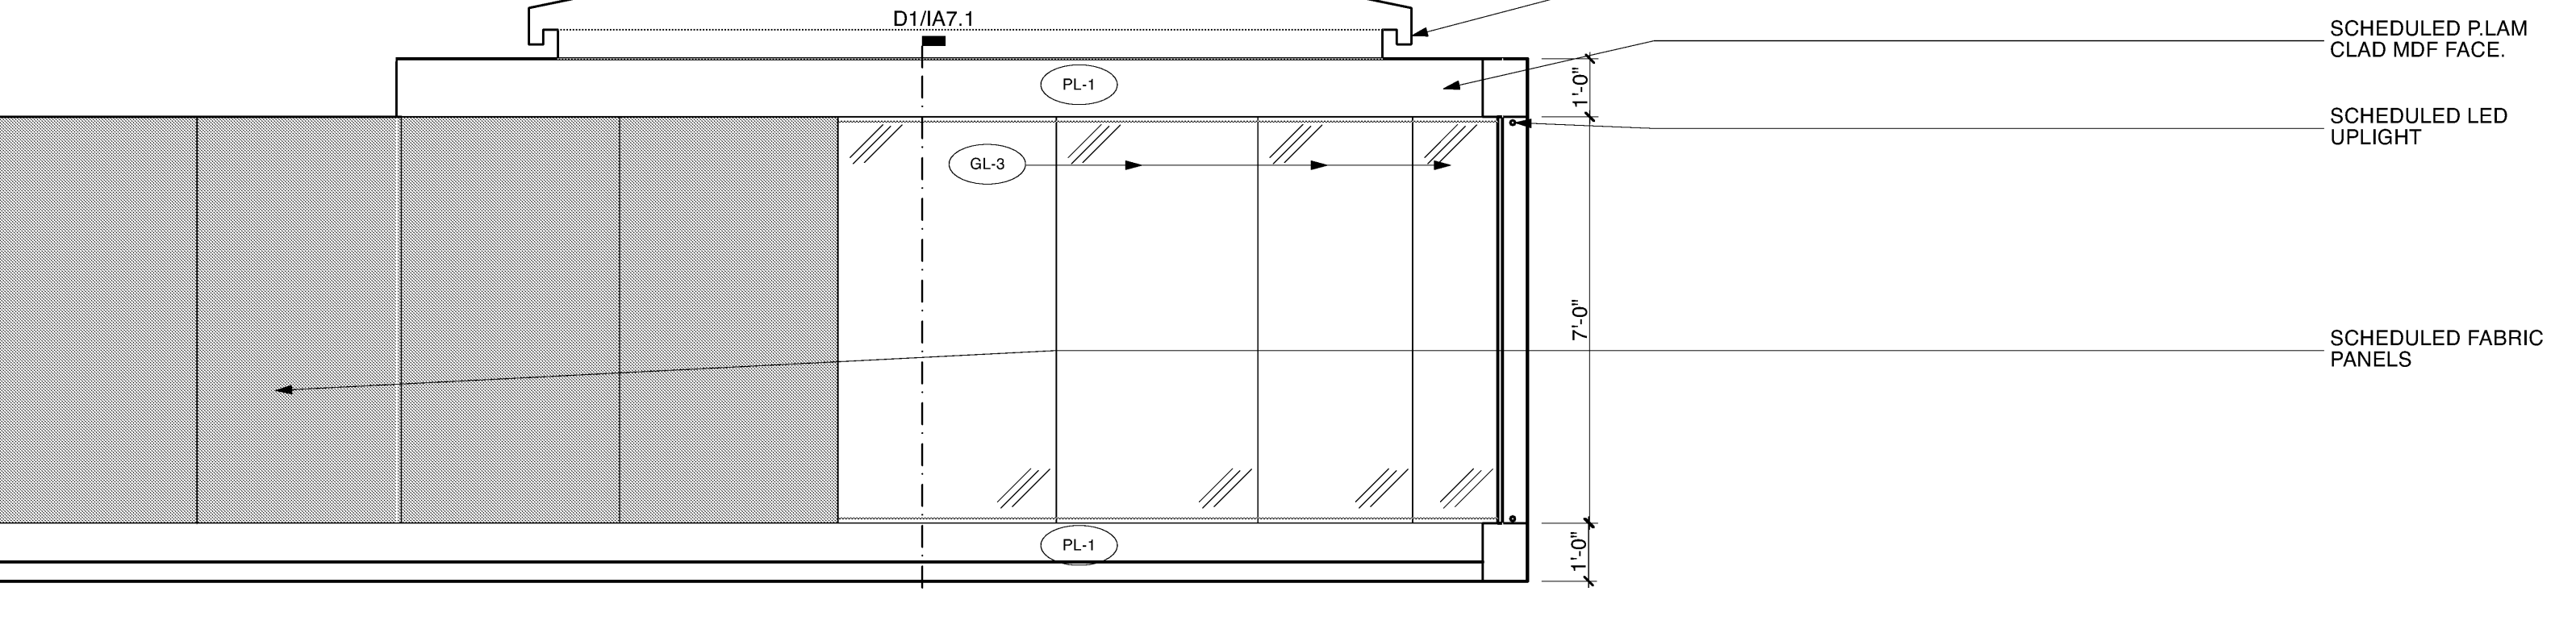


D3 Level 2 Meditation 4
SCALE: 3/8" = 1'-0"

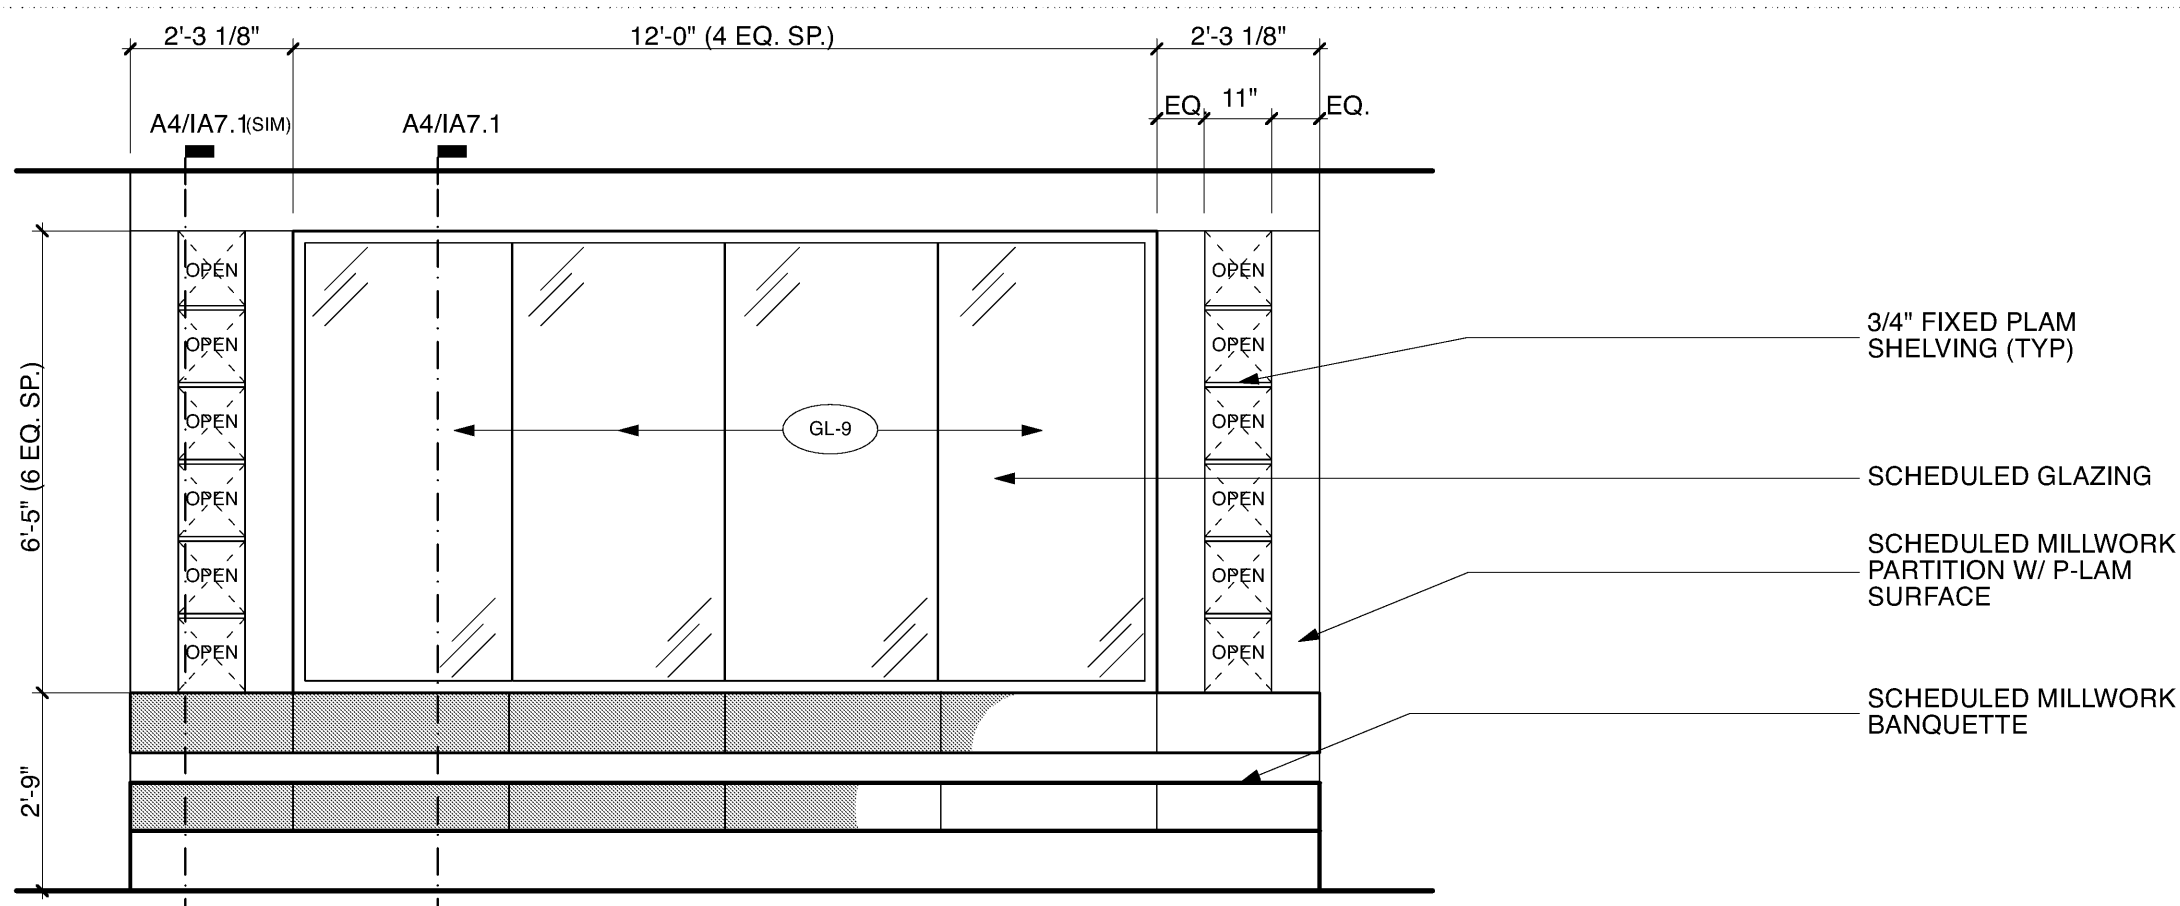


C5 Level 2 MD Dining Screen Wall 1
SCALE: 3/8" = 1'-0"

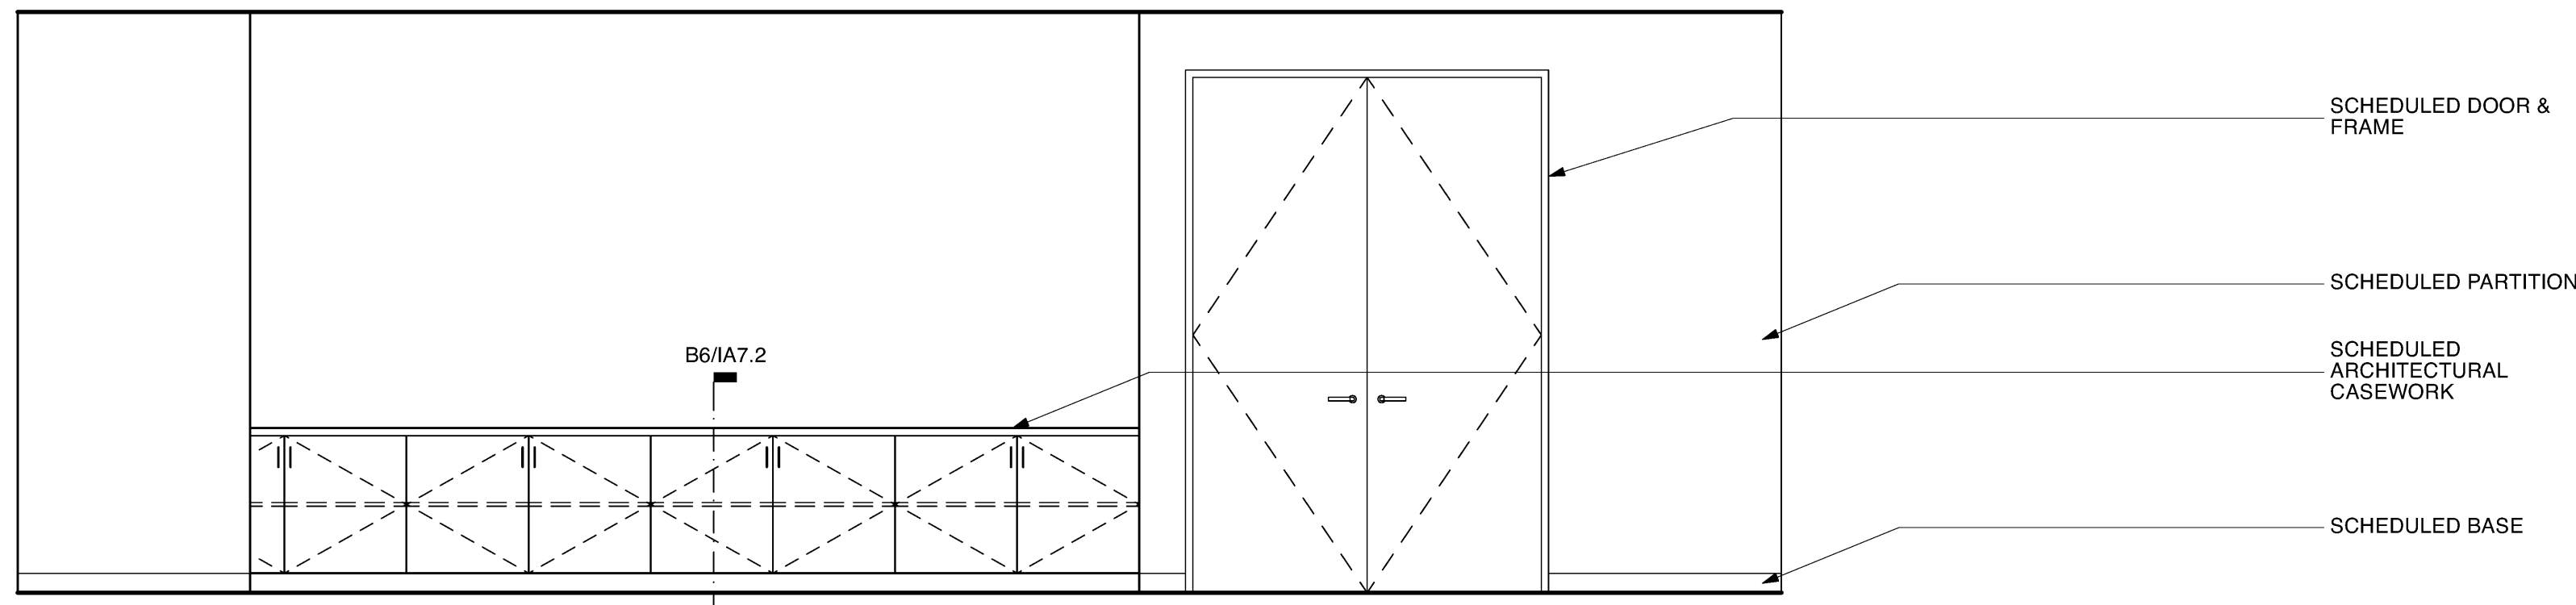


C3 Level 2 MD Dining 1
SCALE: 3/8" = 1'-0"

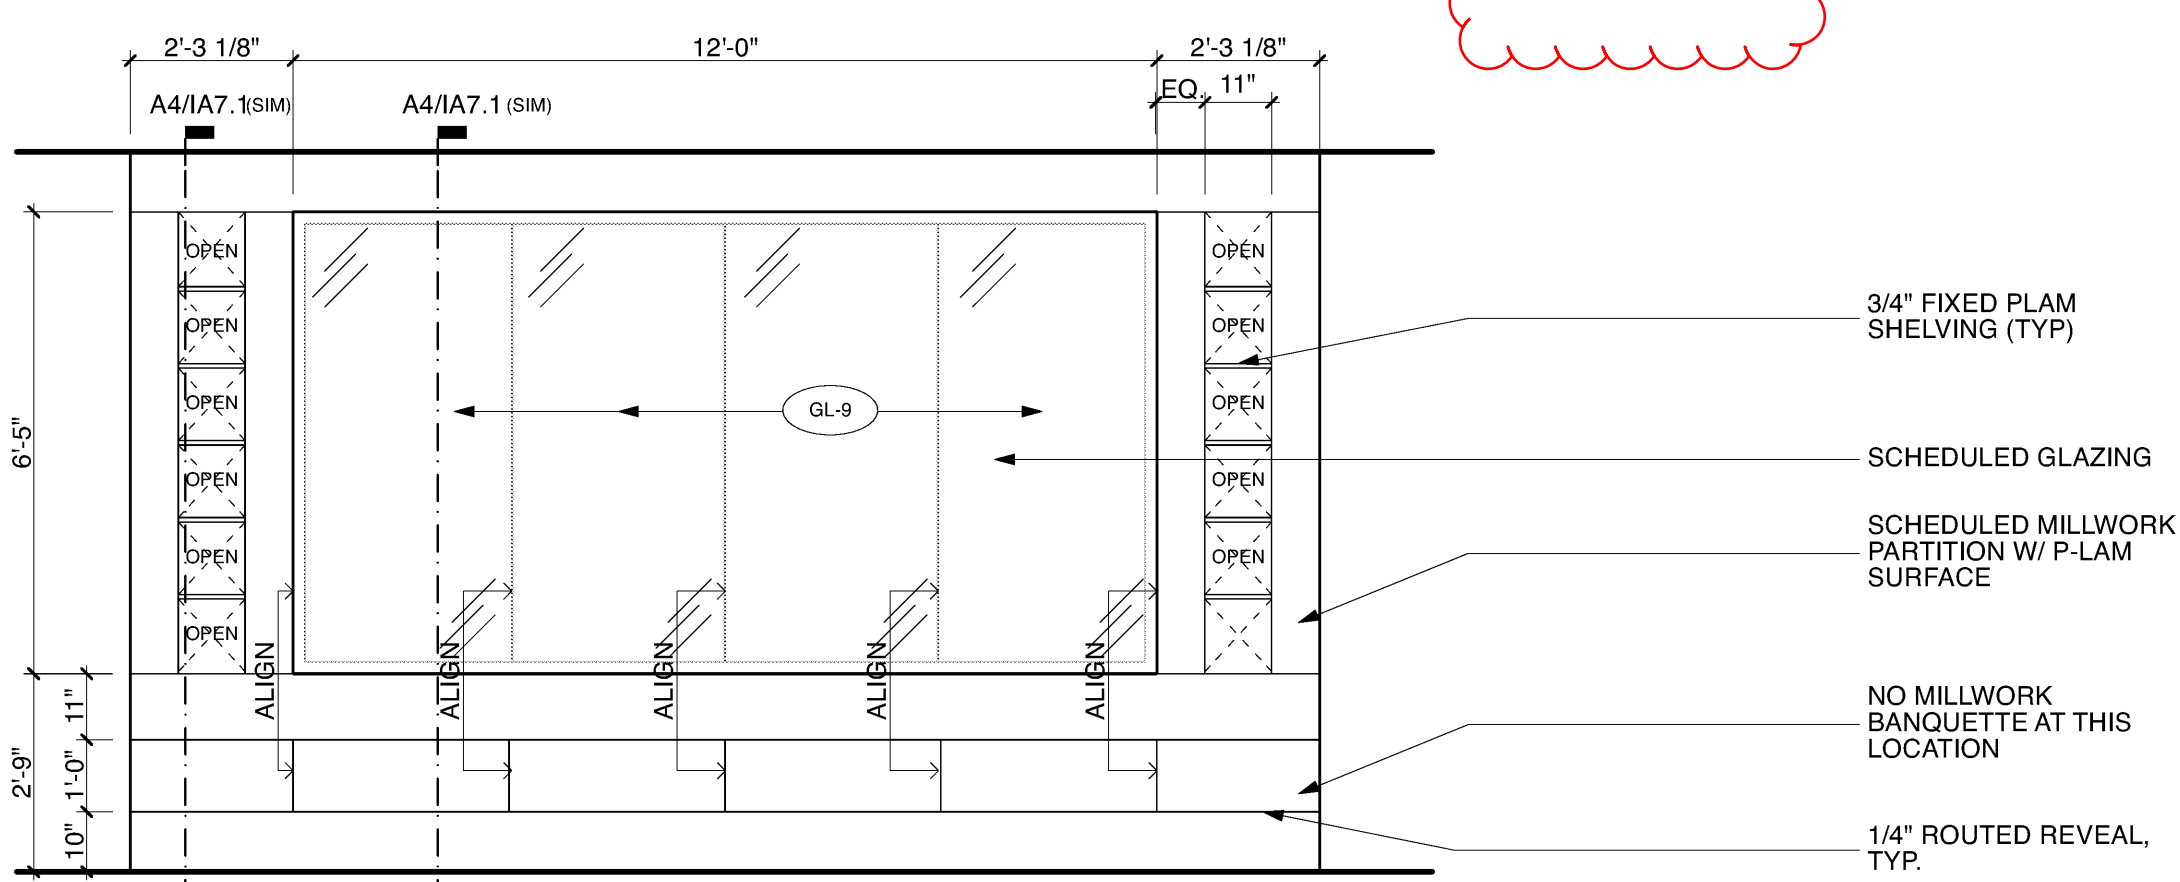


B5 Level 2 MD Dining Screen Wall 2
SCALE: 3/8" = 1'-0"

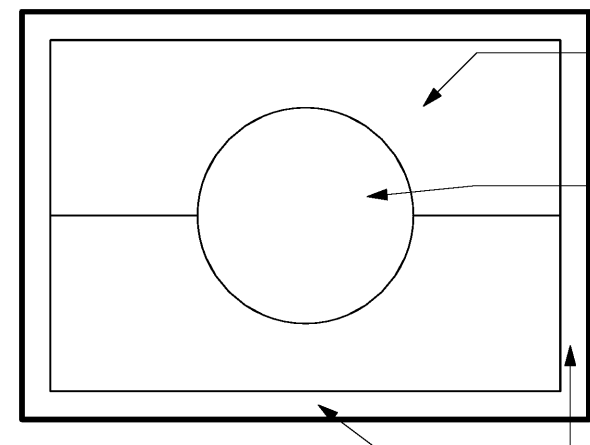

B3 Typical Elevator Cab 2
SCALE: 3/8" = 1'-0"

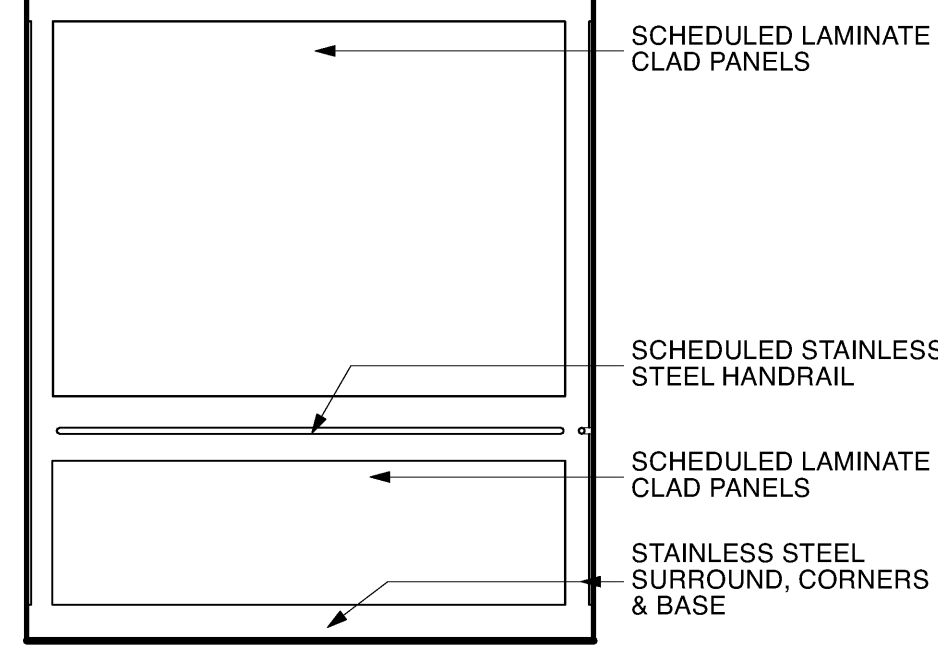


B2 Typical Elevator Cab 2
SCALE: 3/8" = 1'-0"

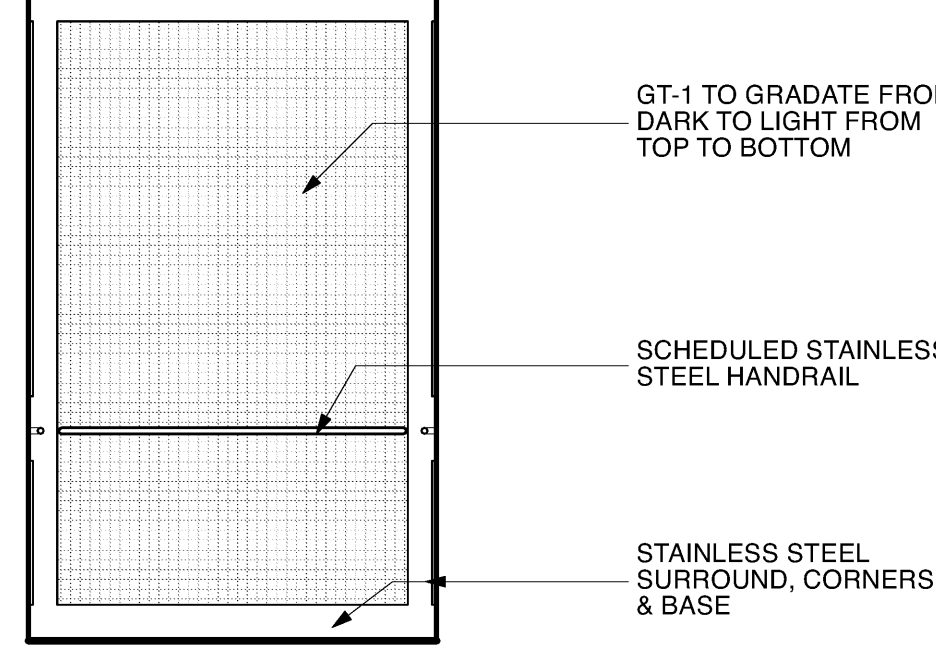


B1 Typical Elevator Cab 1
SCALE: 3/8" = 1'-0"

RFI 3414.1
Tiles color rendering

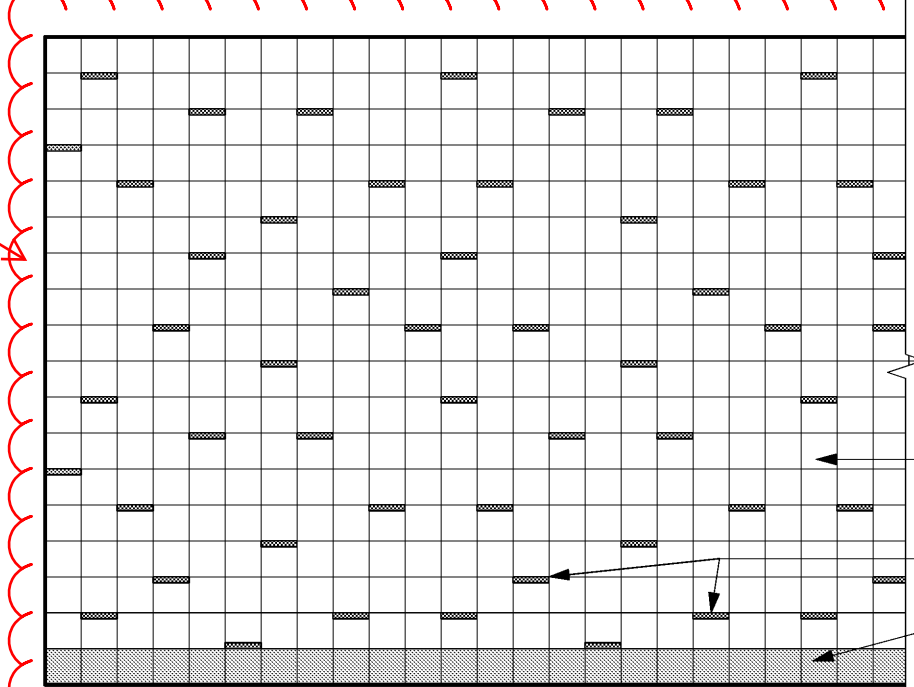

A4 Full Ht. Tile Elevation @ Public Toilet
SCALE: 3/8" = 1'-0"

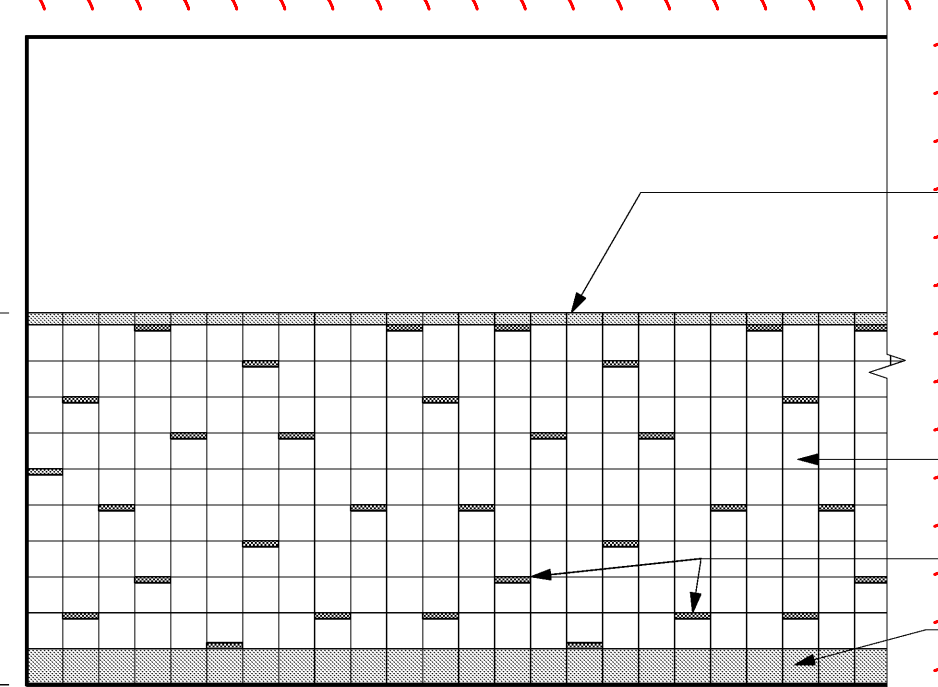

A2 Partial Ht. Tile Elevation @ Public Toilet
SCALE: 3/8" = 1'-0"

SCHED. 2" BULLNOSE
TRIM TO MATCH FIELD
TILE

SCHED. 6" X 6" WALL
TILE (FIELD TILE)

SCHED. 1" X 6" ACCENT
TILE (TYPICAL)

SCHED. 6" COVED WALL
BASE