


FKP Architects

ARCHITECT OF RECORD
Paul C. Gloriod

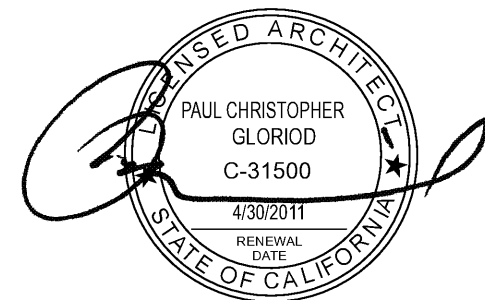

REVISIONS
2/ 02/24/2011 - ASI 58 / CO - 97
3/ 11/11/2011 ASI 129

PROJECT NAME
CHILDREN'S
HOSPITAL OF
ORANGE COUNTY
455 S. Main St.
Orange, CA 92668-3874

TOWER II

RECEIVED
Dec 13 2011
McCarthy



PROJECT NUMBER

12011.00
Increment # 7

OSHPD - PROJECT NUMBER

IL 072072-30

ISSUE

ASI 129 Delta 379

DATE

11/11/2011

SCALE


As Noted

DRAWING TITLE

ELEVATIONS

DRAWING NUMBER


IA8.8

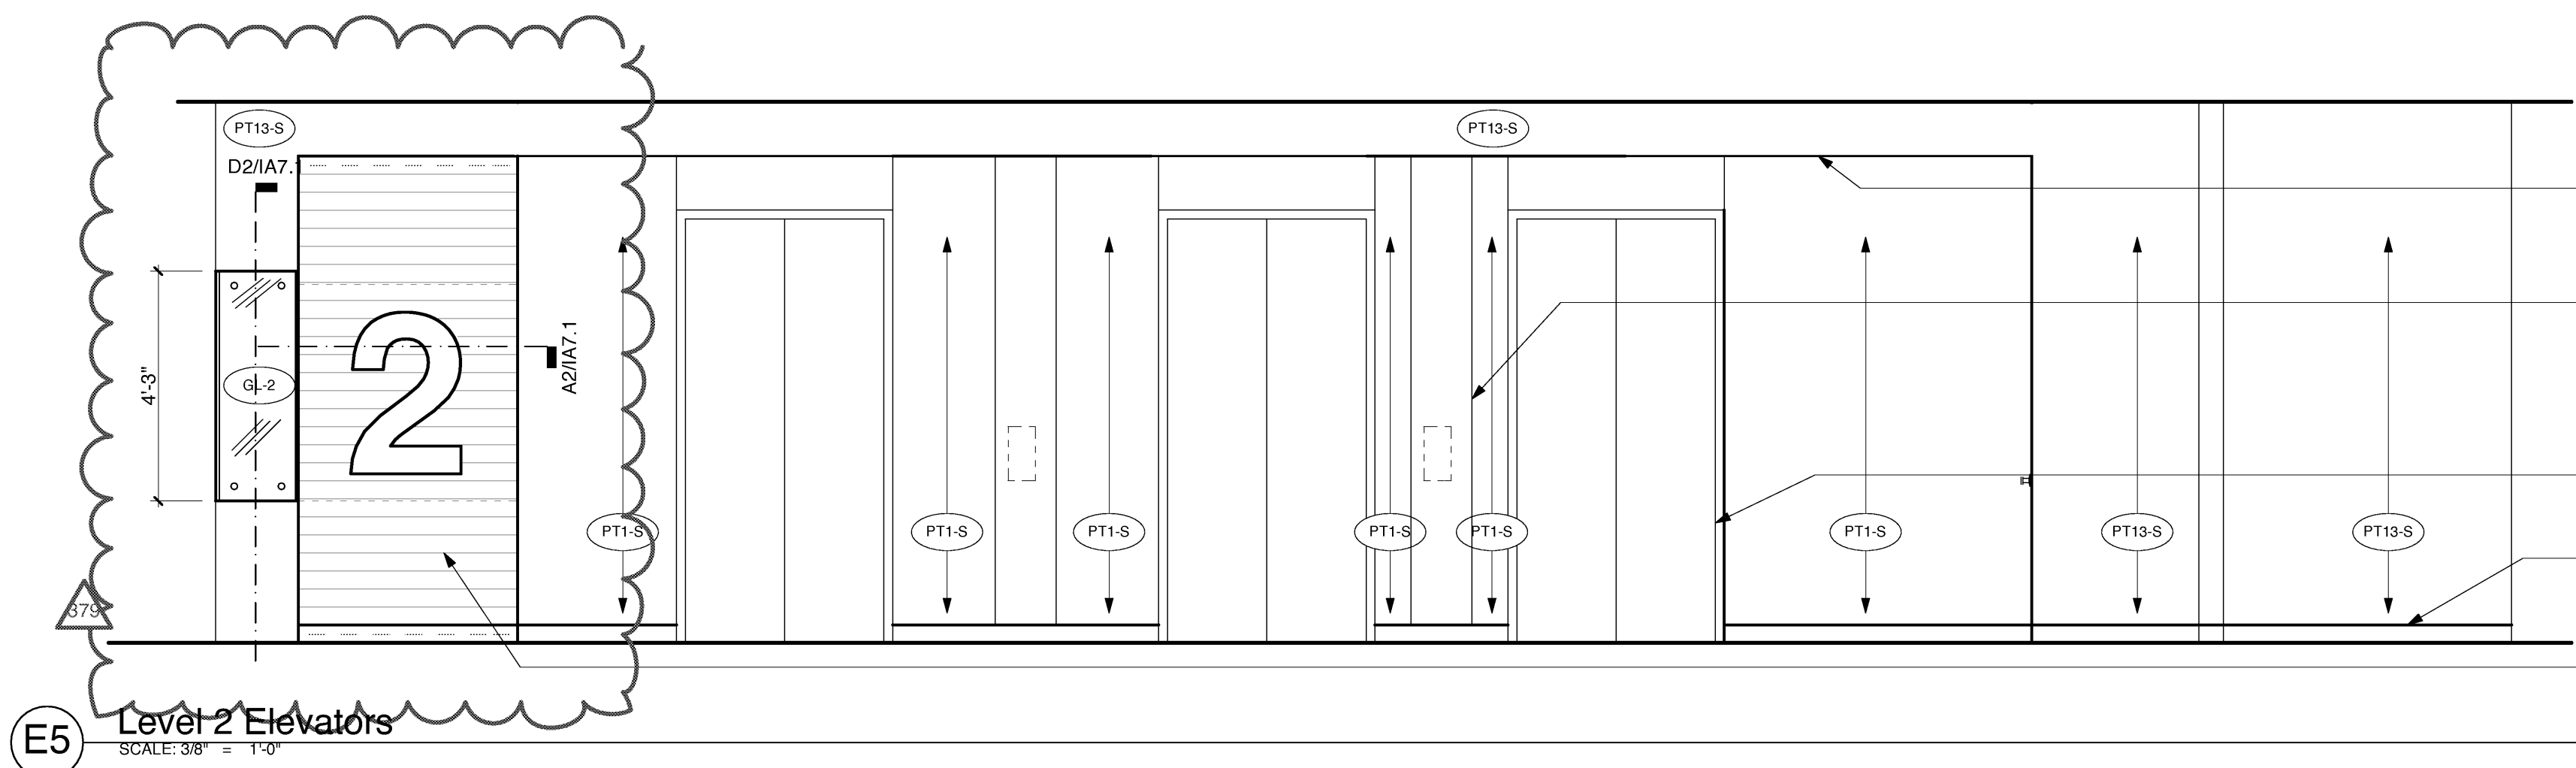

GYP. BOARD SOFFIT TO
RECIEVE PT-19S
12" WIDE FLOOR TO
CEILING SSTL ELEVATOR
CALL BUTTON COVER FLUSH
MOUNTED TO WALL WITH
ETCHED & PAINTED EGRESS
MAP.


STAINLESS STEEL
ELEVATOR CAB DOOR &
FRAME #4 FINISH

SCHEDULED BASE
RECESSED DECORATIVE
WALL PANEL (DWP-1)
WITH OUTOUT FOR
GRAPHIC ACRYLIC
FLOOR NUMBER.
PROVIDE J-BOX FOR
ELECTRICAL AS
REQUIRED. RE: DETAILS

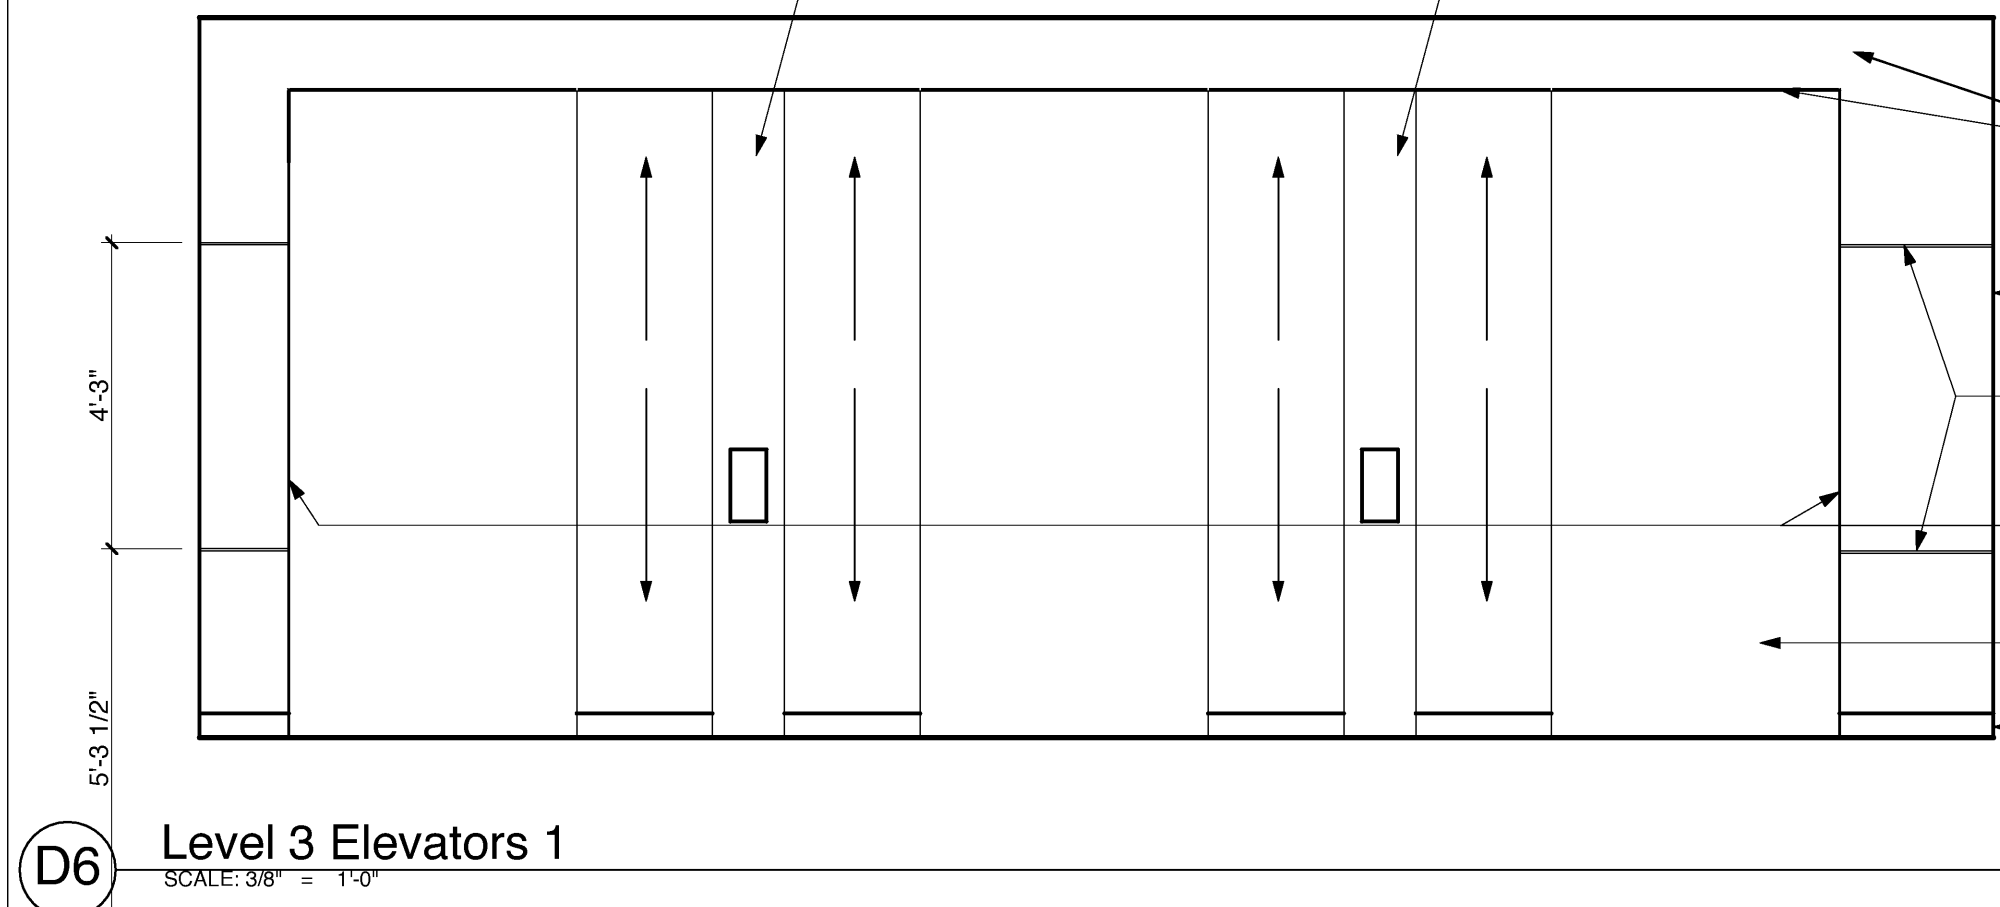

12" WIDE FLOOR TO
CEILING STAINLESS
STEEL ELEVATOR CALL
BUTTON COVER FLUSH
MOUNTED TO WALL WITH
ETCHED & PAINTED
EGRESS MAP


SCHEDULED PARTITION
1/4" DRYWALL REVEAL.
PAINT TO MATCH
ADJACENT FINISH. RE:
DETAILS
CONTINUE FINISHES
AND REVEALS TO
ADJACENT
PERPENDICULAR
PARTITION
STAINLESS STEEL
ELEVATOR CAB DOOR &
FRAME #4 FINISH
SCHEDULED BASE

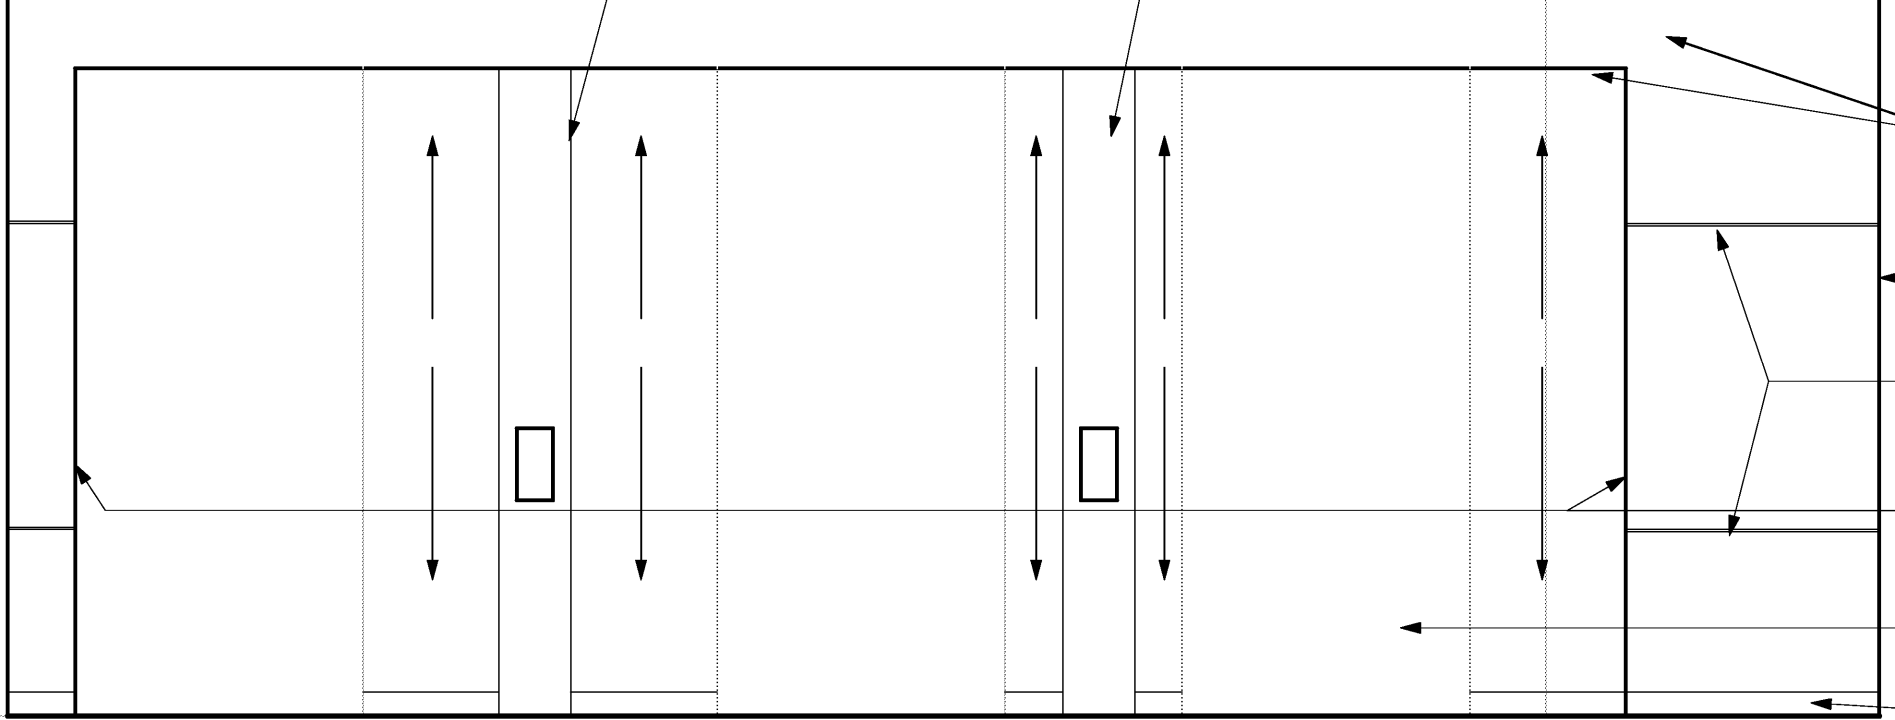

12" WIDE FLOOR TO
CEILING STAINLESS
STEEL ELEVATOR CALL
BUTTON COVER FLUSH
MOUNTED TO WALL WITH
ETCHED & PAINTED
EGRESS MAP


GYP. BOARD SOFFIT,
APPLY SCHED FINISH OF
VERTICAL SURFACE
ABOVE, TYP.

SCHEDULED PARTITION
1/4" DRYWALL REVEAL.
PAINT TO MATCH
ADJACENT FINISH. RE:
DETAILS
CONTINUE FINISHES
AND REVEALS TO
ADJACENT
PERPENDICULAR
PARTITION
STAINLESS STEEL
ELEVATOR CAB DOOR &
FRAME #4 FINISH
SCHEDULED BASE

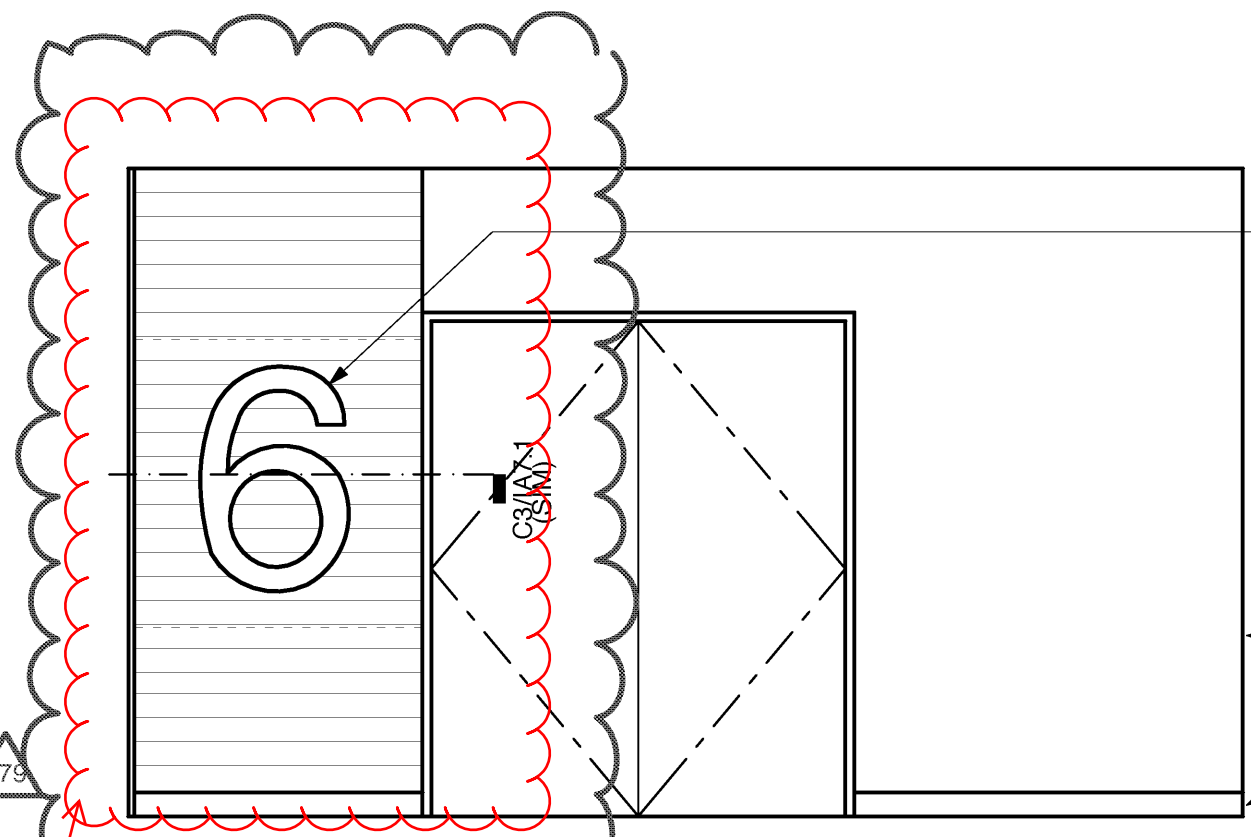


RECESSED
DECORATIVE WALL
PANEL (DWP-1) WITH
CUTOUT FOR GRAPHIC
ACRYLIC FLOOR
NUMBER. PROVIDE J-
BOX IN WALL FOR
FLUORESCENT LIGHT
FIXTURE RECESSED IN
WALL. (REFER TO
SECTION FOR
ADDITIONAL INFO) PAINT
PT1-S.

SCHEDULED PARTITION
SCHEDULED BASE

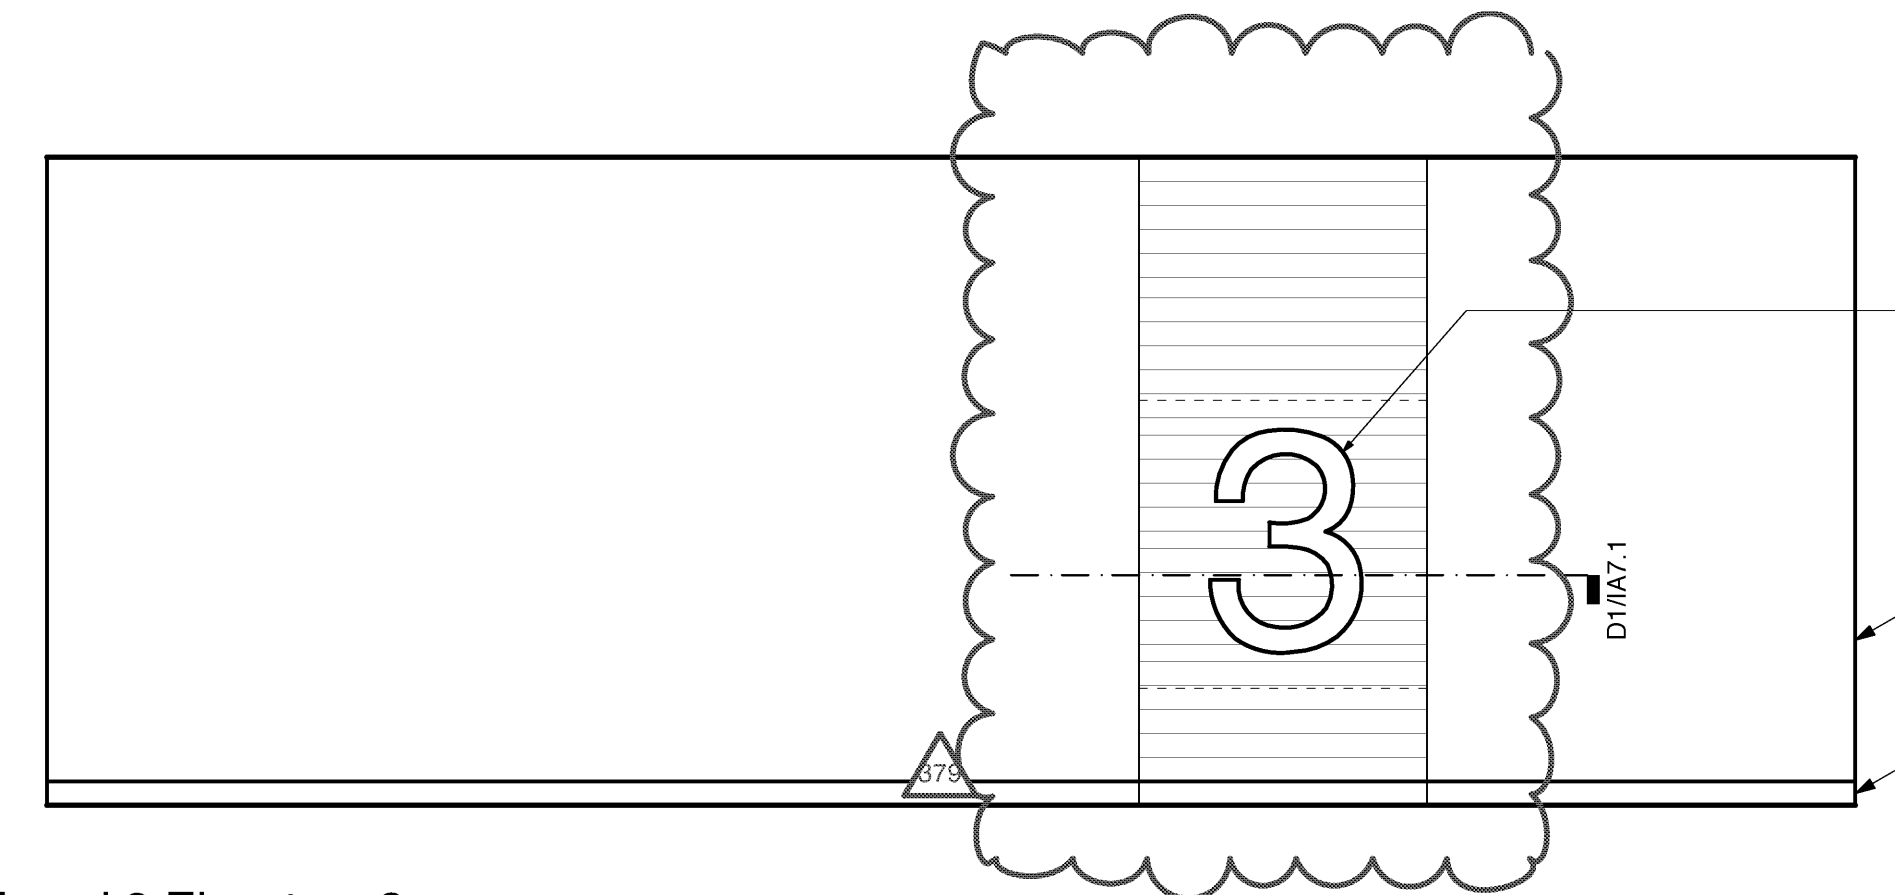


RECESSED
DECORATIVE WALL
PANEL (DWP-1) WITH
CUTOUT FOR GRAPHIC
ACRYLIC FLOOR
NUMBER. PROVIDE J-
BOX IN WALL FOR
FLUORESCENT LIGHT
FIXTURE RECESSED IN
WALL. (REFER TO
SECTION FOR
ADDITIONAL INFO)

SCHEDULED PARTITION
SCHEDULED BASE

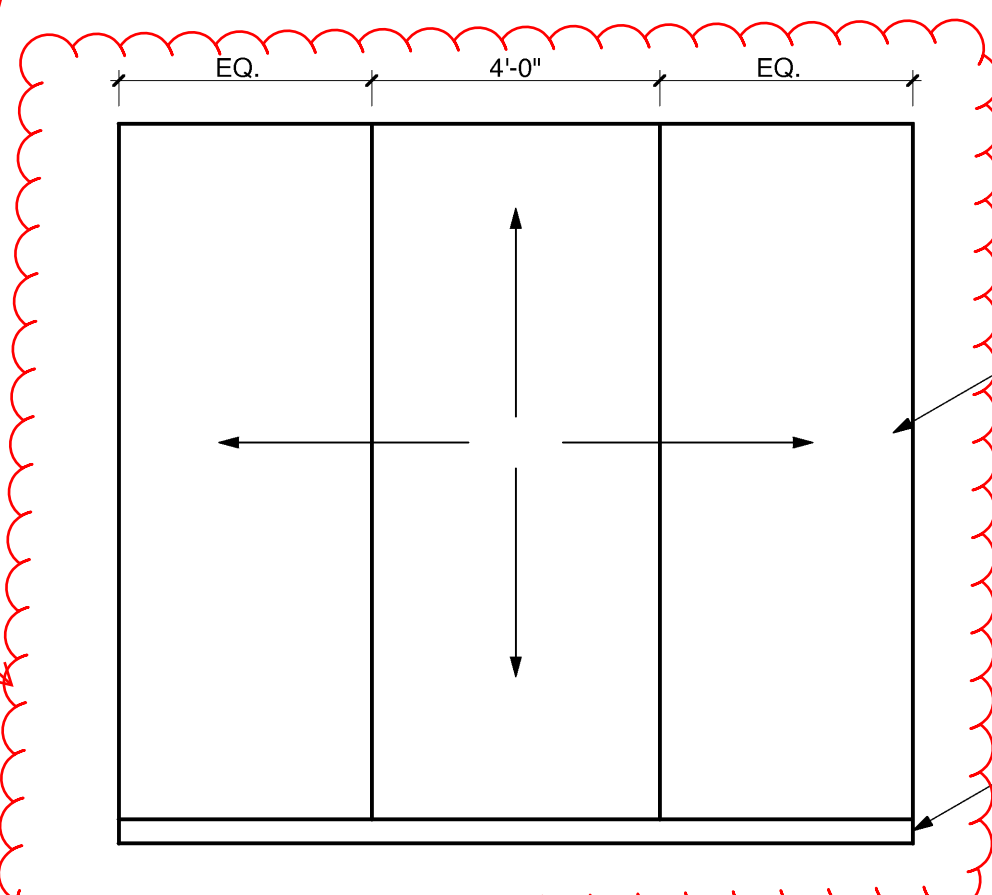

FULL HEIGHT BUTT-
JOINTED WALL PANEL
ATTACHED TO SCHED.
PARTITION. PROVIDE
BLOCKING IN WALL PER
MANUFACTURER
RECOMMENDATIONS.
RE: FINISH PLAN ON
EACH FLOOR FOR
ADDITIONAL INFO.

FLUSH PTD WOOD BASE

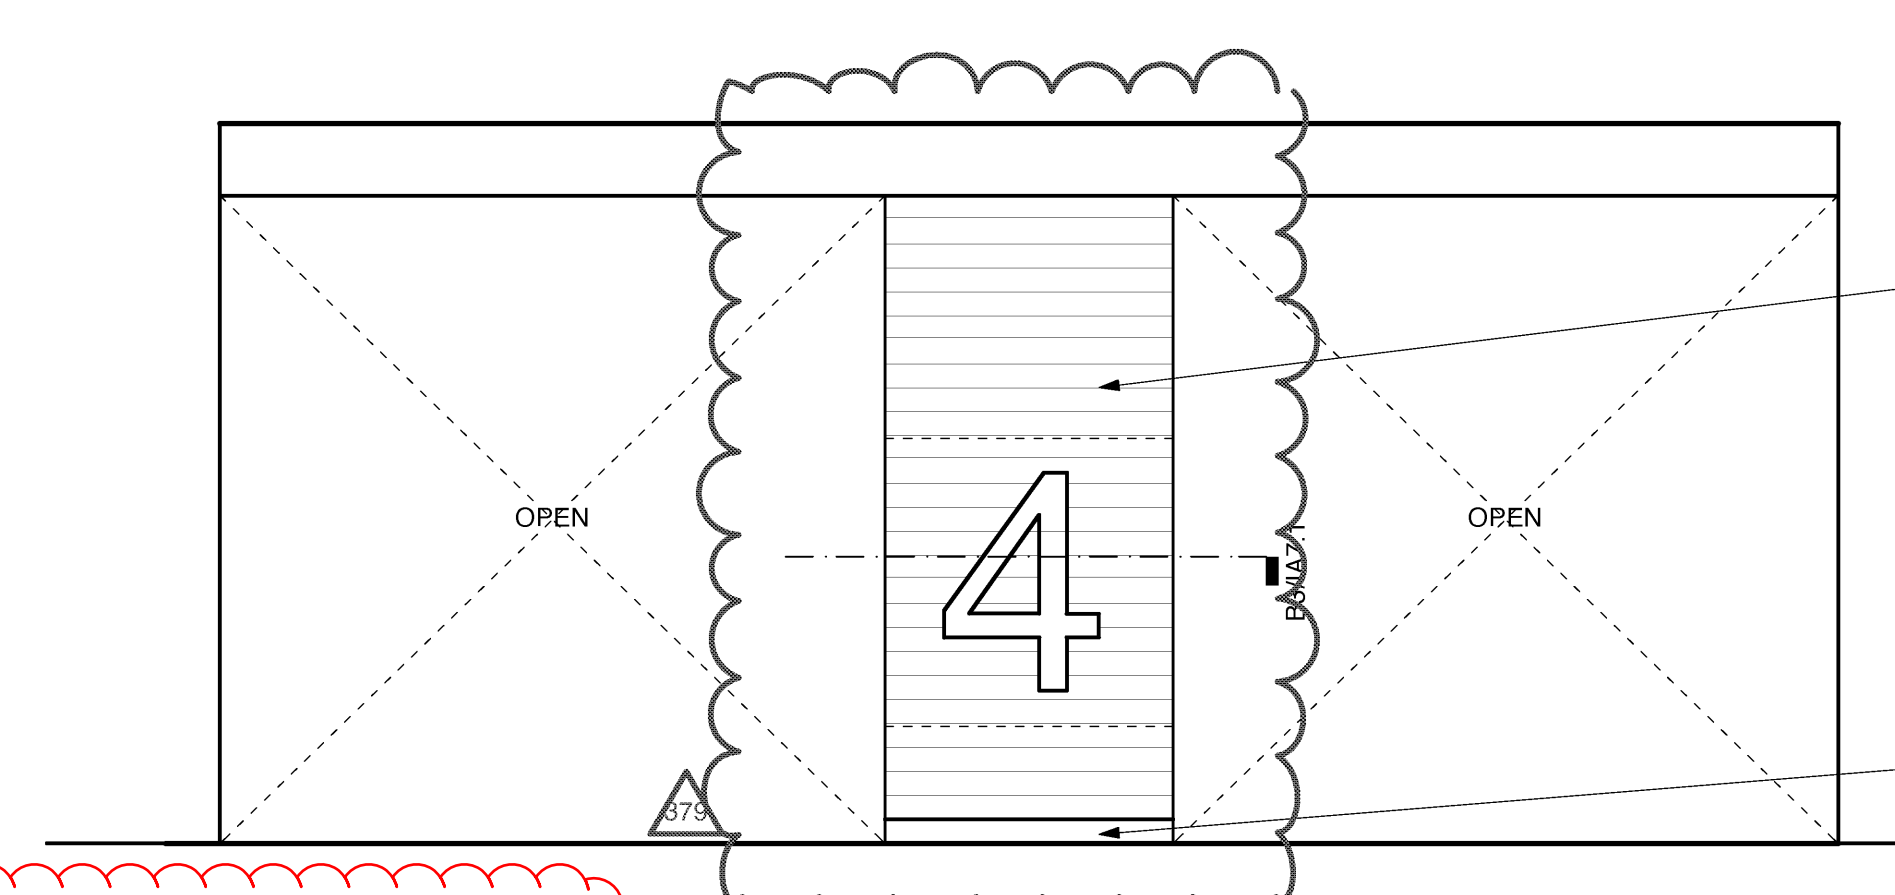

FREE STANDING WALL
WITH DECORATIVE
PANEL (DWP-1) WITH
CUTOUT FOR GRAPHIC
ACRYLIC FLOOR
NUMBER. PROVIDE J-
BOX IN WALL FOR
FLUORESCENT LIGHT
FIXTURE RECESSED IN
WALL. (REFER TO
SECTION FOR
ADDITIONAL INFO)

SCHEDULED PARTITION
SCHEDULED BASE

See RFI 5251 regarding condition
at Light Fixture on Levels 5-7

RFI 4109
Remove DWP. Paint wall
to match adjacent.

RFI 6047

OMIT