


ALL EQUIP. MOUNTING HEIGHTS PER THIS SHEET UNLESS OTHERWISE LOCATED ON ARCH. INTERIOR ELEVATIONS, IN WHICH CASE MOUNT PER ARCH. ELEVATION.

NOTE: REFER TO MEP DRAWINGS AND EQUIPMENT BOOK FOR COORDINATION.

D6 Typical Equipment Mounting Heights

RFI 1371 per RFI 1371, mount pyxis stations 16108, 16125, 16131, 16133, 16134 and 16152 at 86" AFF


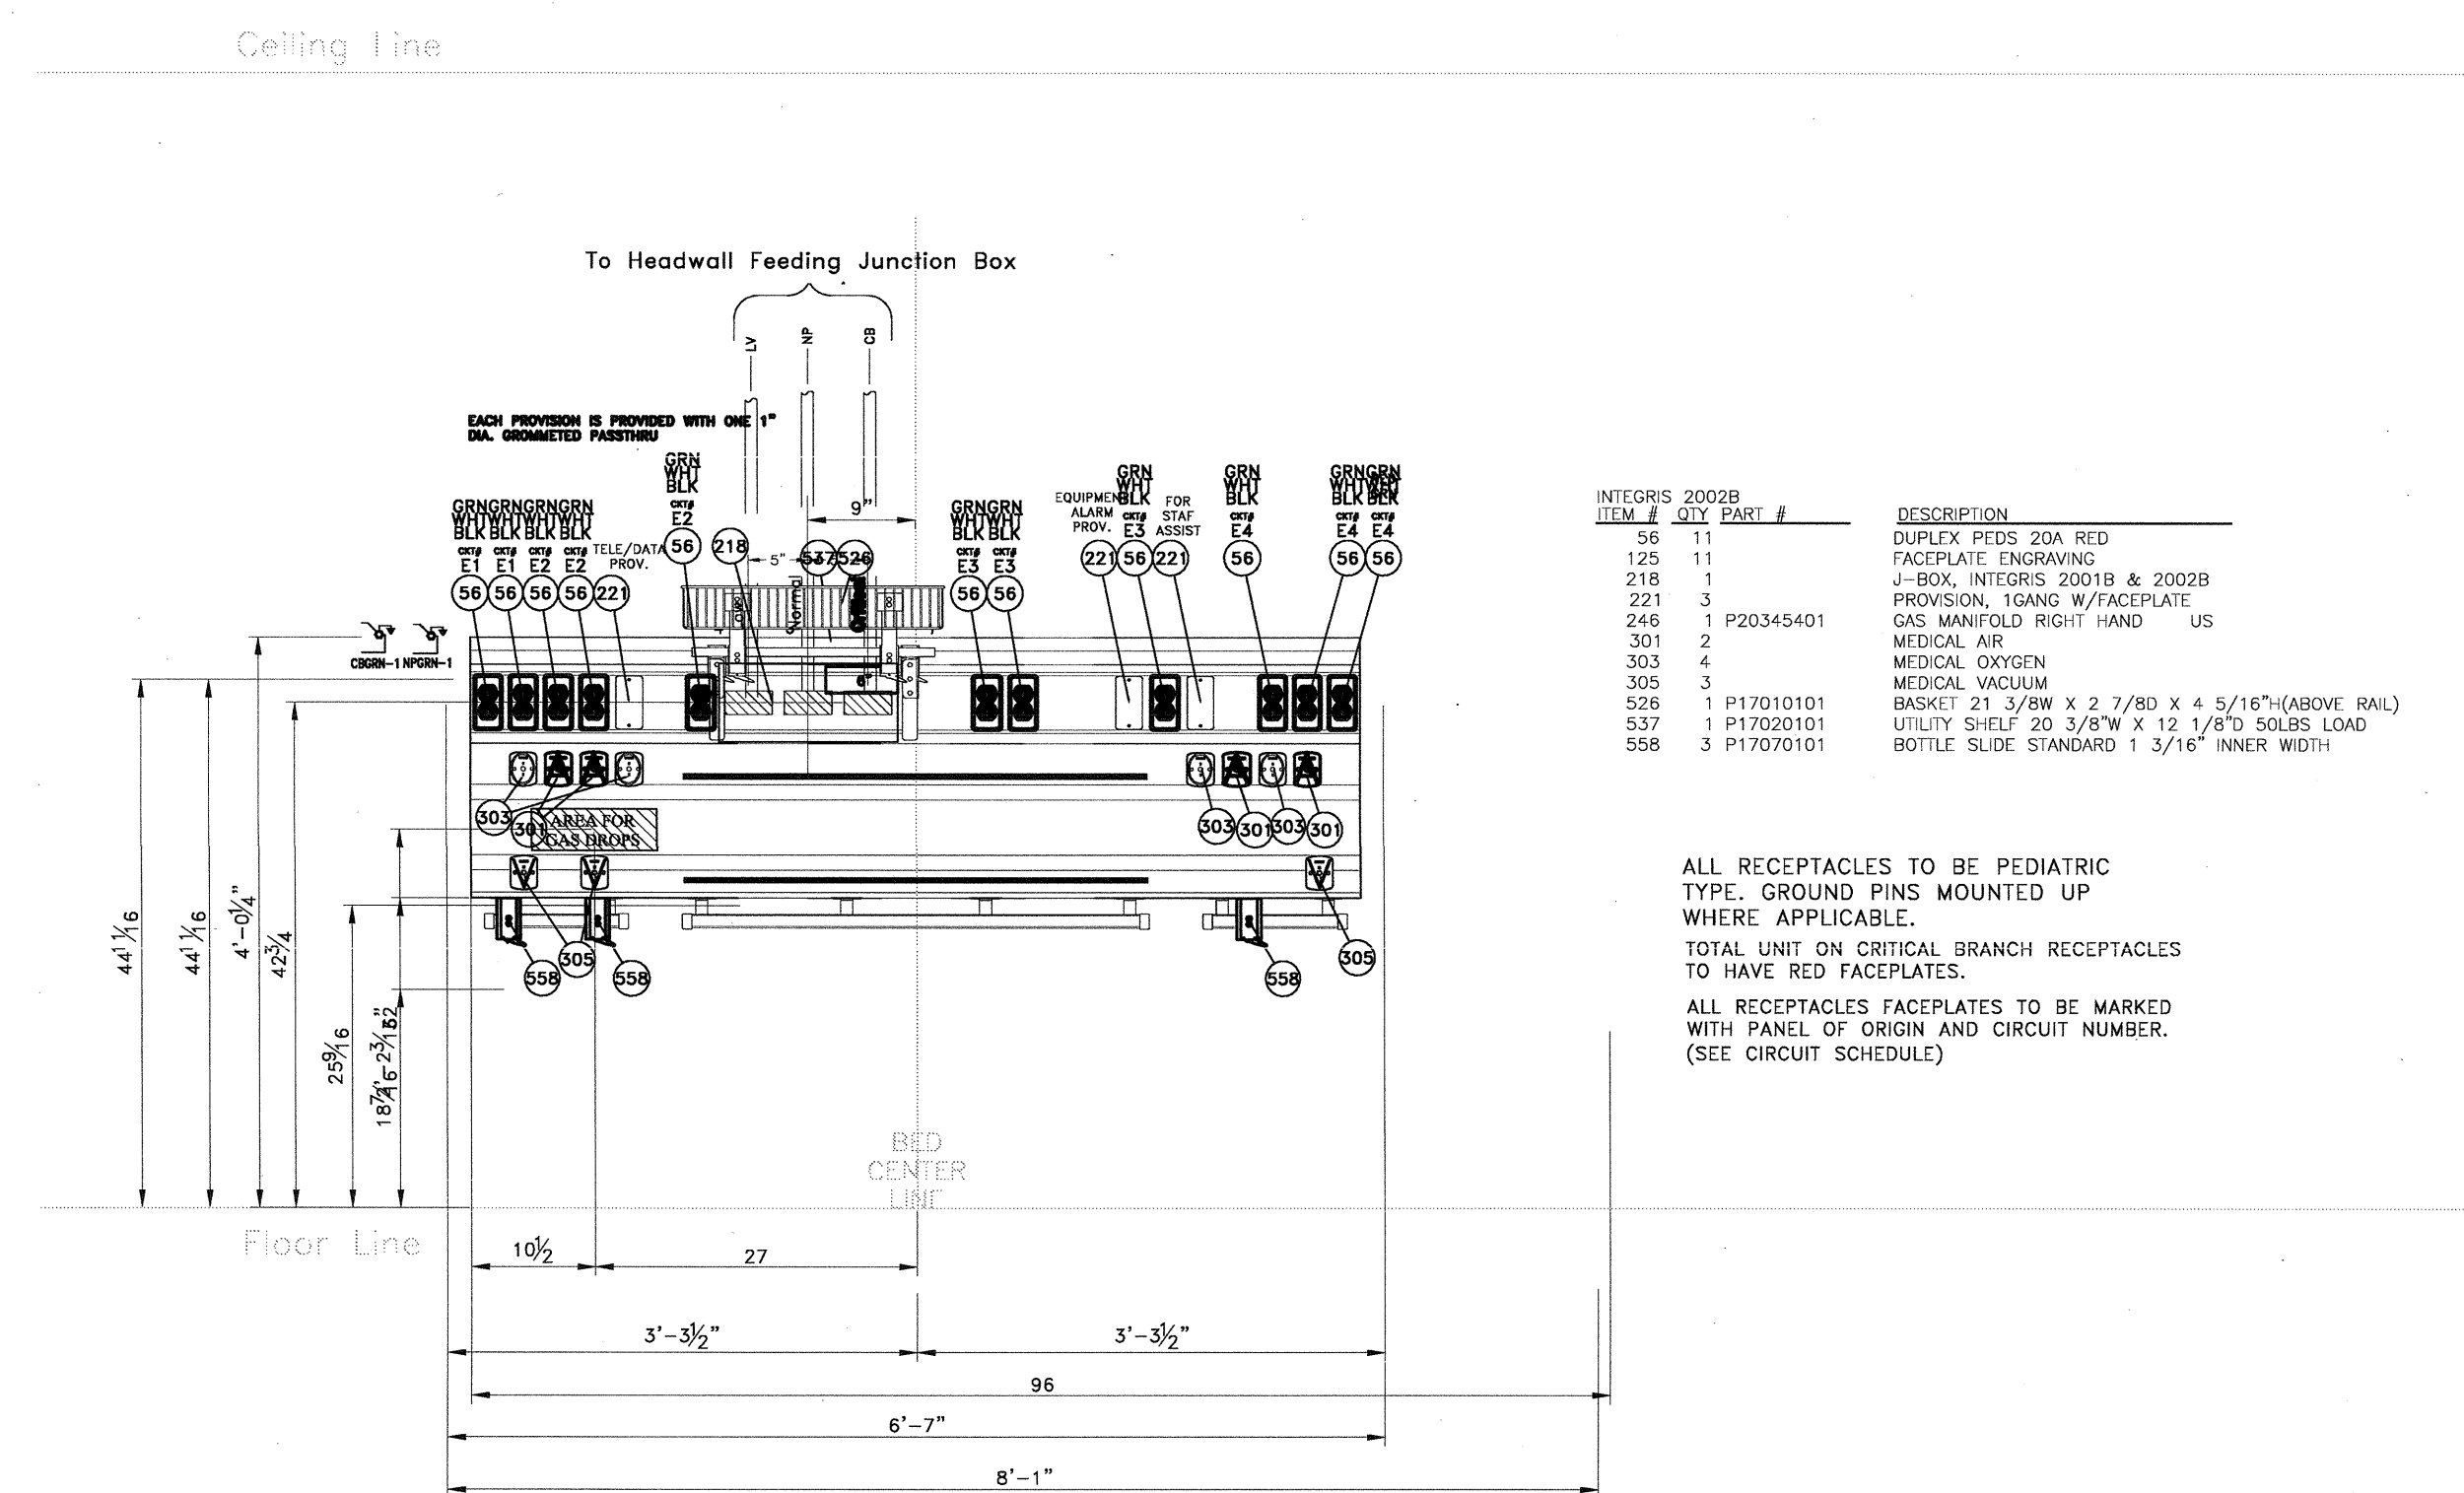


A5 Typical Headwall

A3 General Notes

A2 Drawing Abbreviations

A1 Plan Symbols Legend

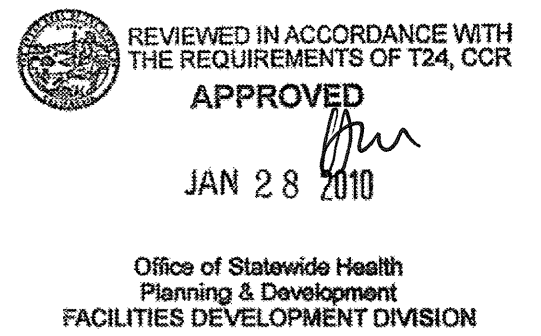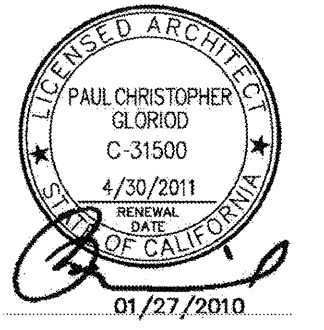

CHILDREN'S HOSPITAL
OF ORANGE COUNTY
455 S. Main St.
Orange, CA 92868-3874

TOWER II

12011.00
Increment #7, Vol. 2E

IL 072072-30

OSHPD Permit

01/27/2010

NTS

EQUIPMENT GENERAL
NOTES & INFO

Q0.02