


FKP Architects

ARCHITECT OF RECORD

Paul C. Gloriod

FOR INFORMATION ONLY

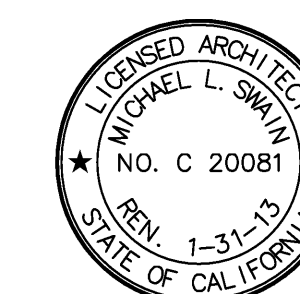

Changes on these drawings do not consist of
materially altered changes to approved drawings
and don't require a change order.
OSHPD review ACO _____
OSHPD review FLSO _____
OSHPD review DSE _____

RTKL

RTKL Associates Inc.
1717 Pacific Avenue
Dallas, TX 75201
Tel: 214.871.8877
Fax: 214.871.7023
www.rtkl.com

PROJECT NUMBER 10.07099.05

REVISIONS

CO. 262 09/26/11
CO. 261 03/12/12
ASI 243 08/02/12

APPROVAL



CHANGE ORDER
INSTRUCTION BULLETIN
DEFERRED APPROVAL
10/20/11

PROJECT NAME

CHILDREN'S HOSPITAL
OF ORANGE COUNTY

455 S. Main St.
Orange, CA 92668-3874

TOWER II



PROJECT NUMBER

12011.00
Increment #7

OSHPD - PROJECT NUMBER

IL 072072-30

ISSUE

OSHPD PERMIT

DATE

01/27/2010


SCALE

1/4" = 1'-0"

DRAWING TITLE

DRAWING NUMBER

Q3.0F

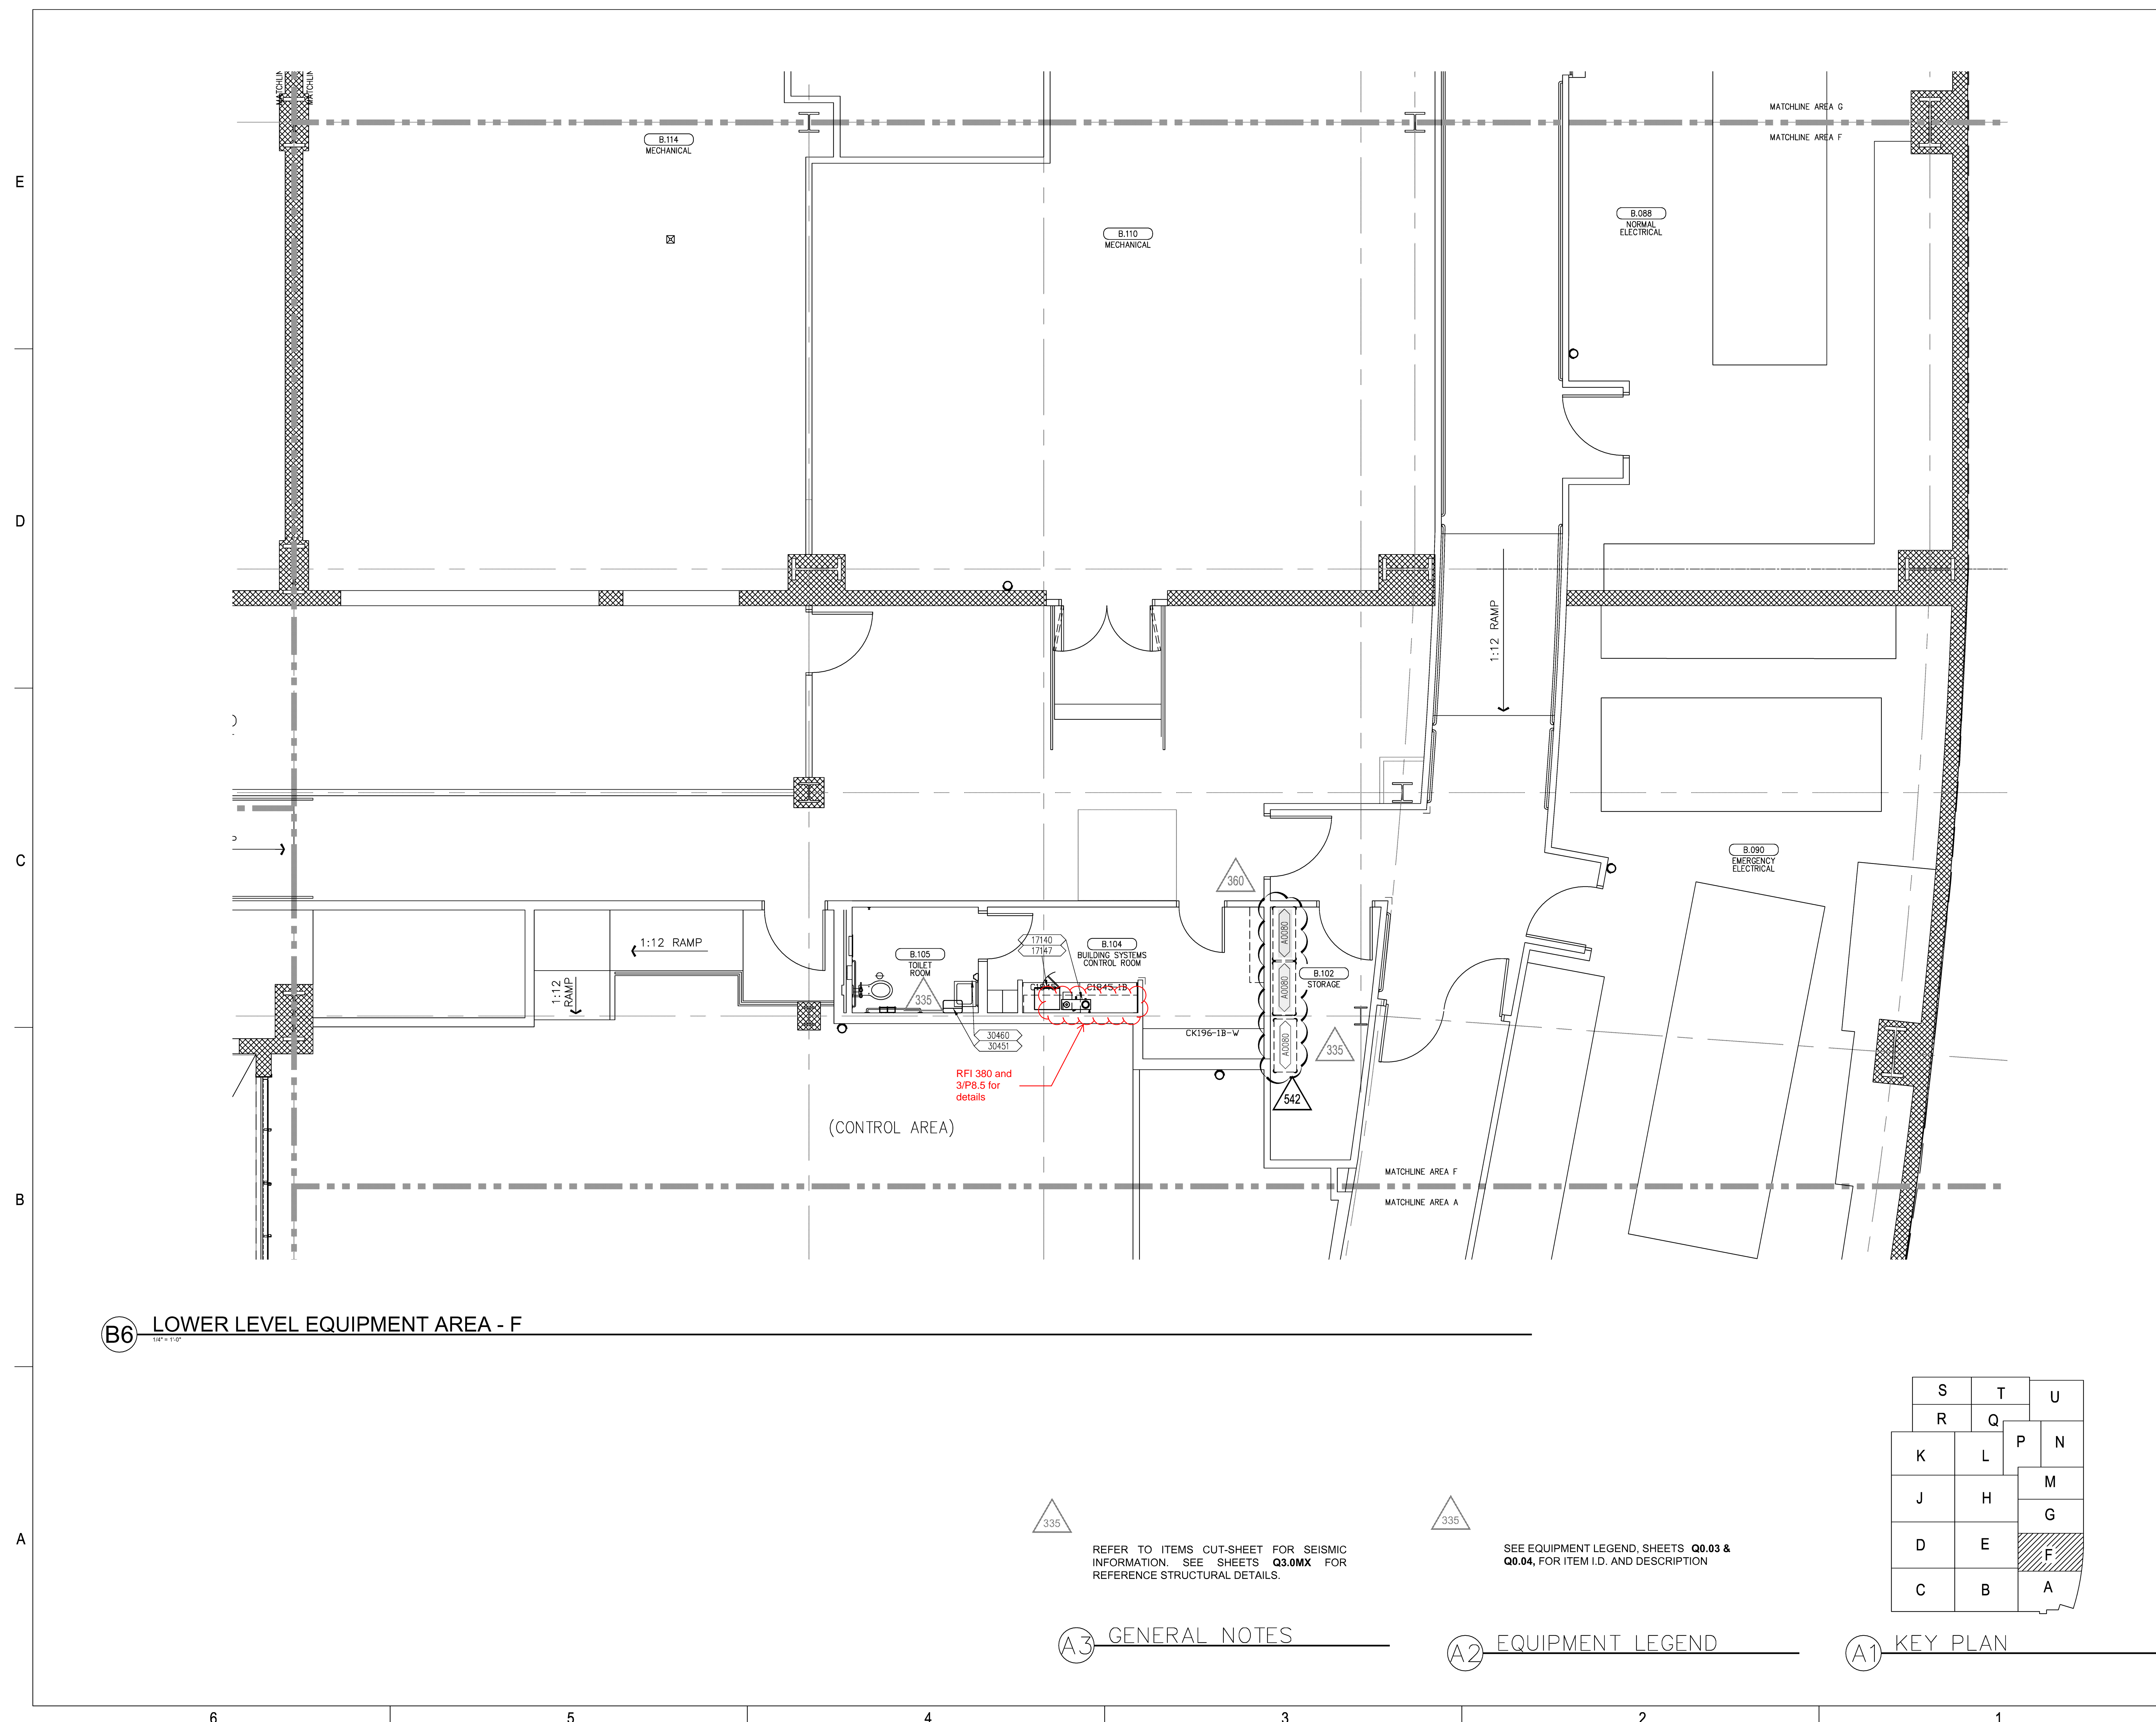

B6 LOWER LEVEL EQUIPMENT AREA - F

A3 GENERAL NOTES

A2 EQUIPMENT LEGEND

A1 KEY PLAN

S	T	U
R	Q	P
K	L	N
J	H	M
D	E	G
C	B	A

335

335

REFER TO ITEMS CUT-SHEET FOR SEISMIC
INFORMATION. SEE SHEETS Q3.0MX FOR
REFERENCE STRUCTURAL DETAILS.

SEE EQUIPMENT LEGEND, SHEETS Q0.03 &
Q0.04, FOR ITEM I.D. AND DESCRIPTION