




FOR INFORMATION ONLY

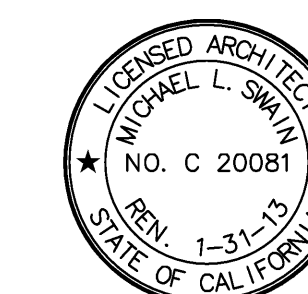

Changes on these drawings do not consist of materially altered changes to approved drawing and don't require a change order.

OSHPD review ACO

OSHPD review FLSO

OSHPD review DSE

BTKU

RTKL Associates Inc
1717 Pacific Avenue
Dallas, TX 75201
Tel: 214.871.8877
Fax: 214.871.7023
www.rtkl.com

PROJECT NUMBER 10.07099.05

REVISIONS

	CO. 262	09/26/1
	CO. 281	03/12/1
	ASI 186	04/27/12
	ASI 243	08/02/12

APPROVAL



CHANGE ORDER# _____
INSTRUCTION BULLETIN# _____
DEFERRED APPROVAL# _____

PROJECT NAME

CHILDREN'S HOSPITAL
OF ORANGE COUNTY

455 S. Main St.
Orange, CA 92868-3874

TOWER II



PROJECT NUMBER

12011.00
Increment #7

OSHPD - PROJECT NUMBER
IL 072072-30

ISSUE
OSHPD PERMIT

DATE 01/27/2010

SCALE _____


$$1/4" = 1'-0"$$

DRAWING TITLE

LOWER LEVEL
EQUIPMENT AREA - L

DRAWING NUMBER

Q3.0L

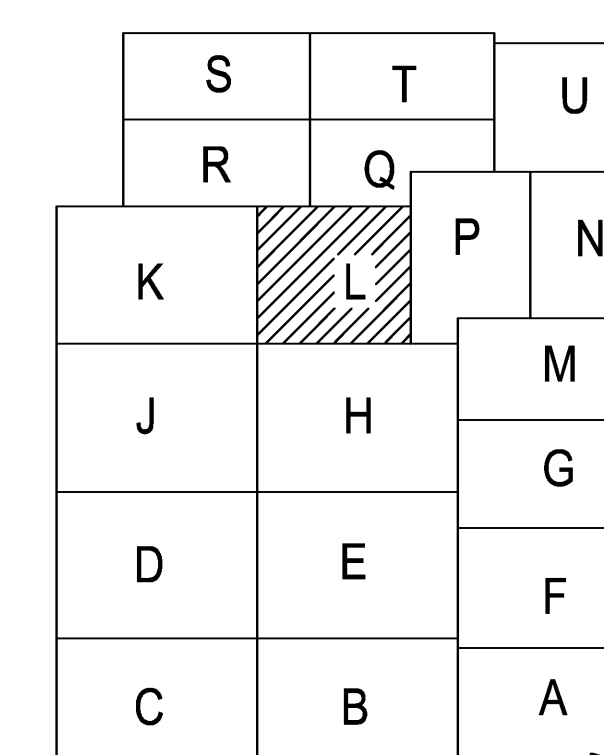

SEE EQUIPMENT LEGEND, SHEETS **Q0.03 & Q0.04**, FOR ITEM I.D. AND DESCRIPTION

REFER TO ITEMS CUT-SHEET FOR SEISMIC
INFORMATION. SEE SHEETS **Q3.0MX** FOR
REFERENCE STRUCTURAL DETAILS.

A4 SHEET KEYNOTES

1. PLACEHOLDER FOR TV/DVD/TRACKING BOARD, AND ASSOCIATED BRACKET. REFER TO OTHERS FOR SPECIFICATION INFORMATION.

③ GENERAL NOTES

EQUIPMENT LEGEND

⊙ KEY PLAN

F

D

C

B

A

6

5

4

2

2

X:\ACTIVE PROJECTS\CA -- CHILDREN'S HOSPITAL OF ORANGE COUNTY\DRAWINGS\RTL\SHEETS\Q3_01_LOWER_LEVEL_EQ_AREA_1.DWG
3/25/2012
SFARRELL