


FKP Architects

ARCHITECT OF RECORD

Paul C. Glorio

FOR INFORMATION ONLY

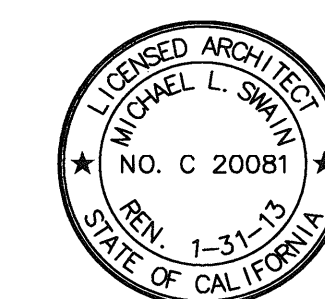

Changes on these drawings do not consist of
materially altered changes to approved drawings
and don't require a change order.
OSHPD review ADO
OSHPD review FLSO
OSHPD review DSE



RTKL Associates Inc.
1717 Pacific Avenue
Dallas, TX 75201
Tel: 214.871.8877
Fax: 214.871.7023
www.rtkl.com

PROJECT NUMBER 10.07099.05

REVISIONS

CO. 263 10/05/11

ASI 186 04/27/12

APPROVAL



CHANGE ORDER
INSTRUCTION BULLETIN
DEFERRED APPROVAL
CORRECTION

PROJECT NAME

CHILDREN'S HOSPITAL
OF ORANGE COUNTY

455 S. Main St.
Orange, CA 92668-3874

TOWER II



PROJECT NUMBER

12011.00
Increment #7

OSHPD - PROJECT NUMBER
IL 072072-30

ISSUE
OSHPD PERMIT

DATE

01/27/2010

SCALE


3/32" = 1'-0"

DRAWING TITLE

LEVEL 1 EQUIPMENT
OVERALL

DRAWING NUMBER

Q3.01

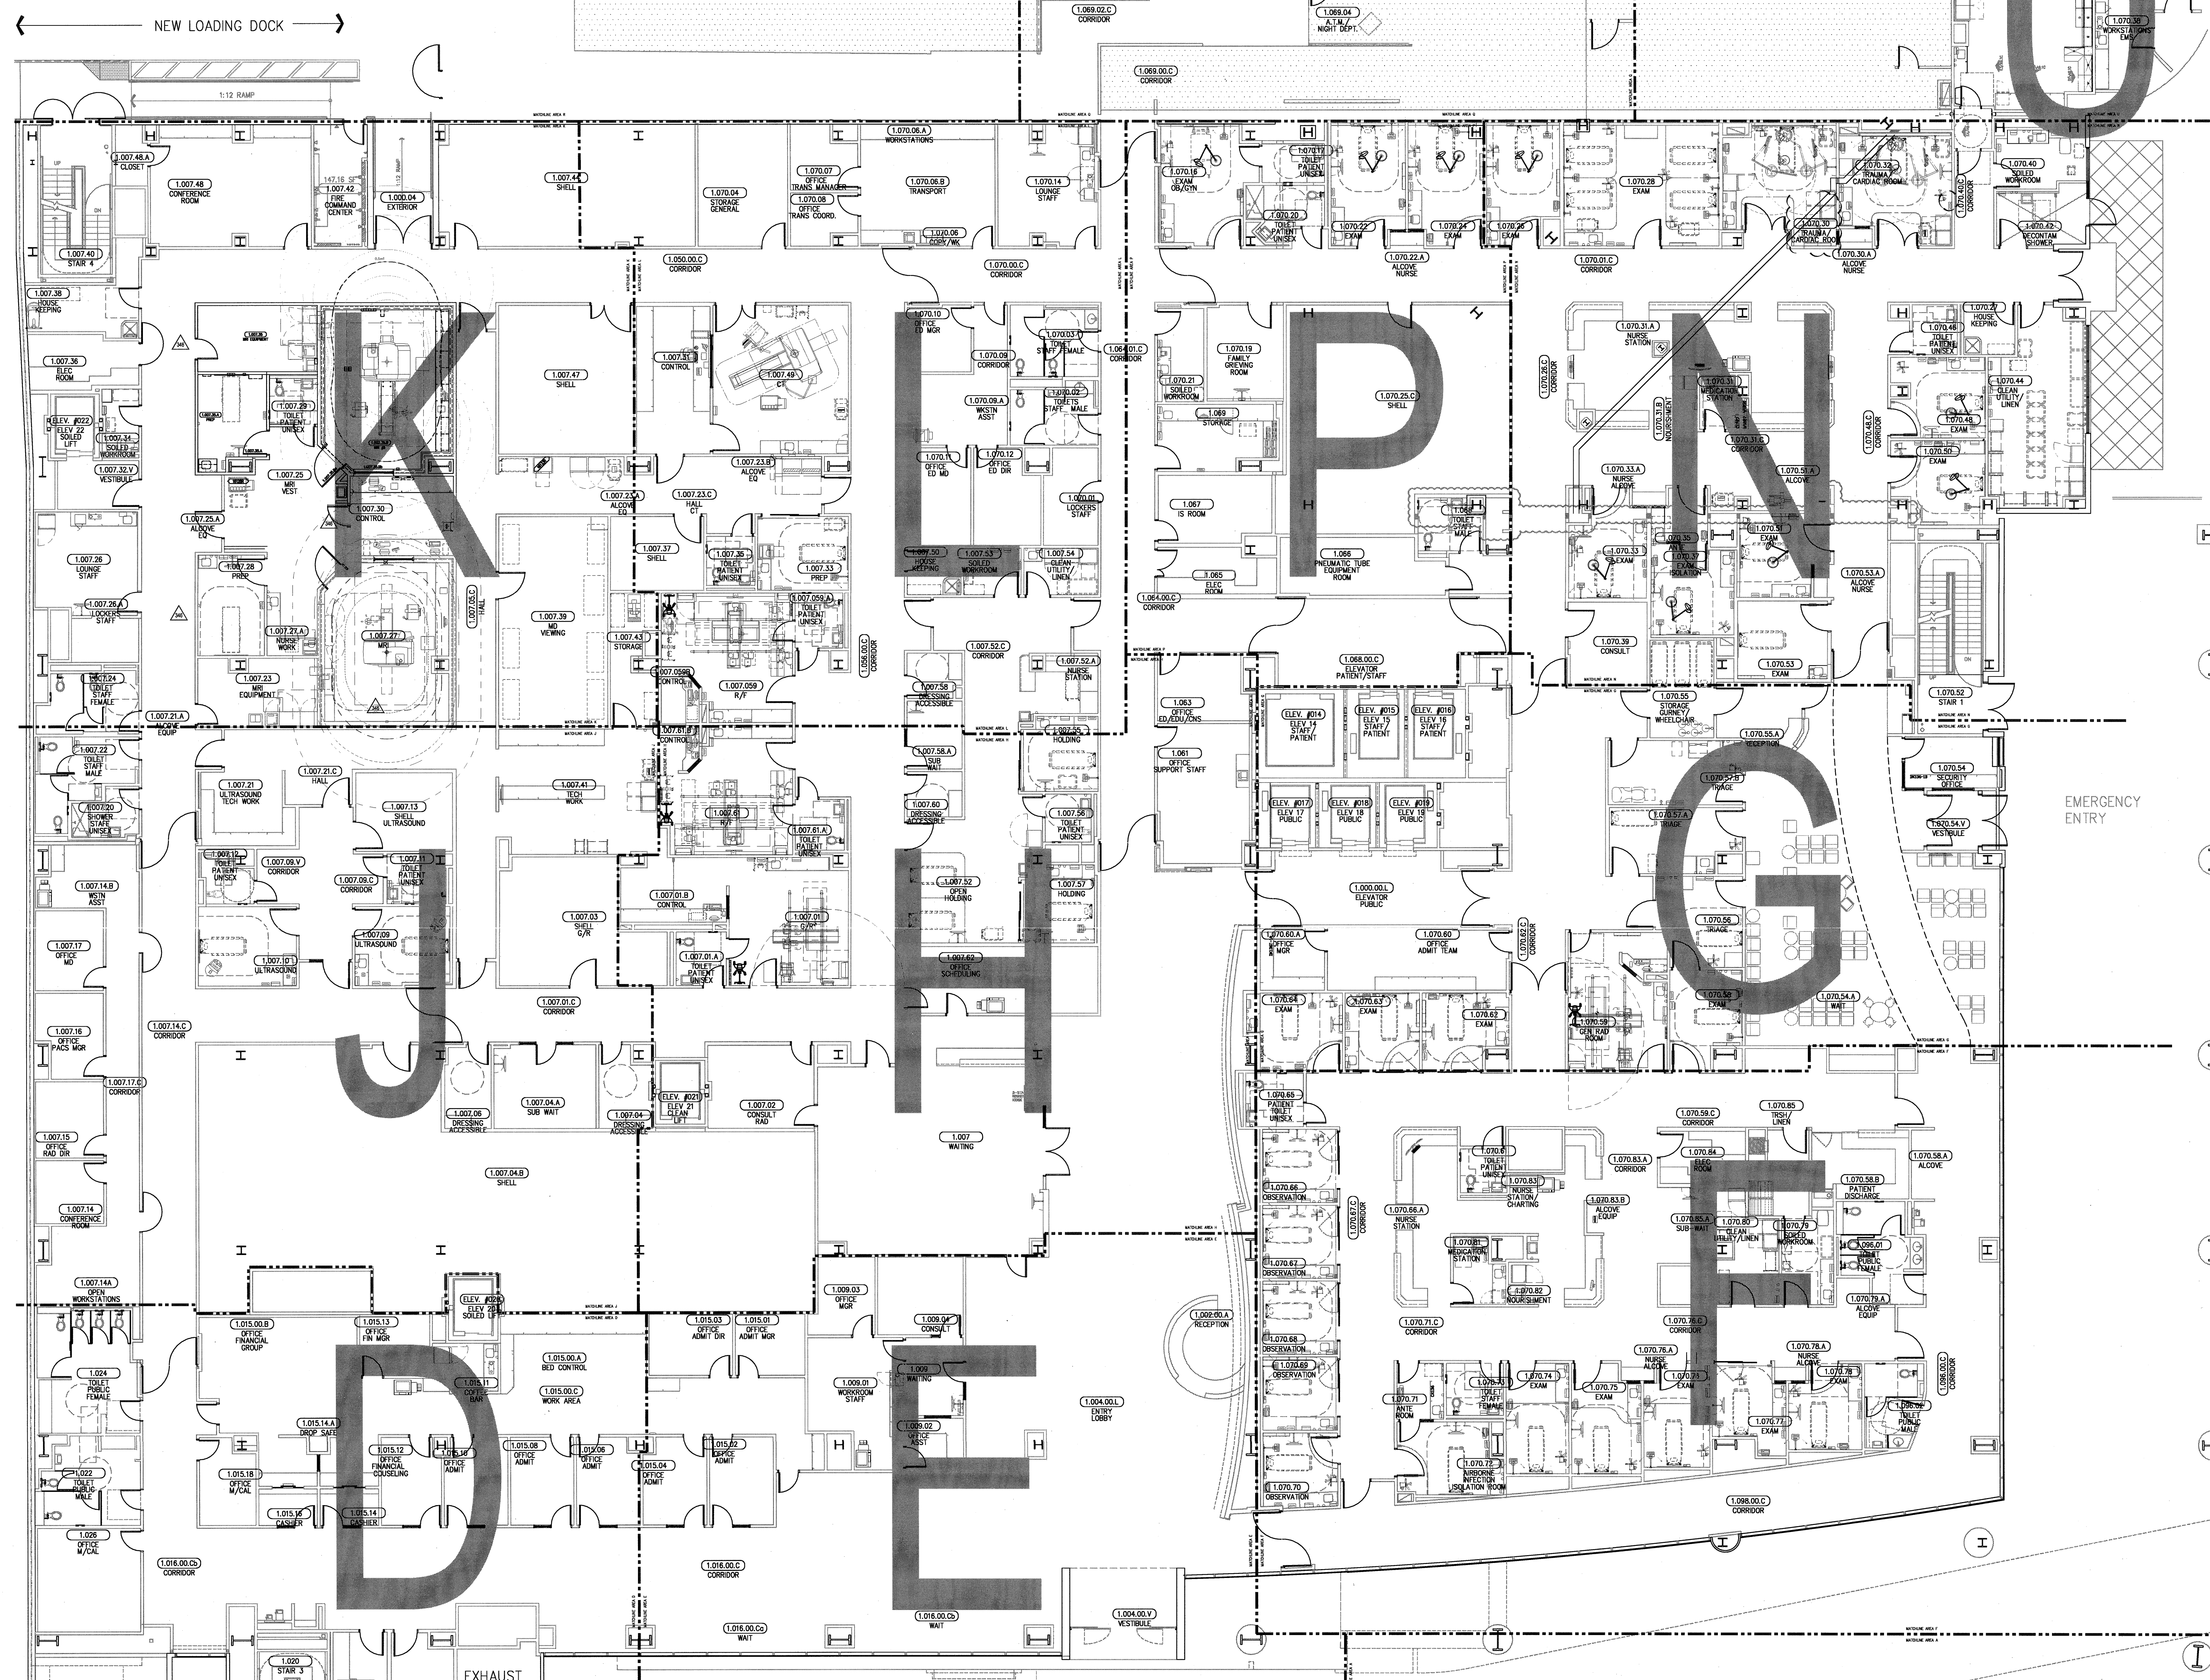

A LEVEL 1 - EQUIPMENT PLAN - OVERALL