


FKP Architects

ARCHITECT OF RECORD

Paul C. Gloriot

FOR INFORMATION ONLY

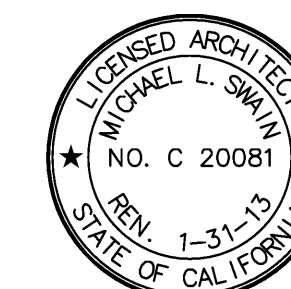

Changes on these drawings do not consist of
materially altered changes to approved drawings
and don't require a change order.
OSHPD review ACO
OSHPD review FLSO
OSHPD review DSE

RTKL

RTKL Associates Inc.
1717 Pacific Avenue
Dallas, TX 75201
Tel: 214.871.8877
Fax: 214.871.7023
www.rtkl.com

PROJECT NUMBER 10.07099.05

REVISIONS

△	CO. 263	10/03/11
△	CO. 281	03/12/12
△	ASI 186	04/27/12
△	ASI 243	08/02/12

APPROVAL



CHANGE ORDER
INSTRUCTION BULLETIN
DEFERRED APPROVAL
10/03/11

PROJECT NAME

**CHILDREN'S HOSPITAL
OF ORANGE COUNTY**

455 S. Main St.
Orange, CA 92668-3874

TOWER II



PROJECT NUMBER

**12011.00
Increment #7**

OSHPD - PROJECT NUMBER

IL 072072-30

ISSUE

OSHPD PERMIT

DATE

01/27/2010

SCALE


1/4" = 1'-0"

DRAWING TITLE

**LEVEL 1 EQUIPMENT
AREA - J**

DRAWING NUMBER

Q3.1J

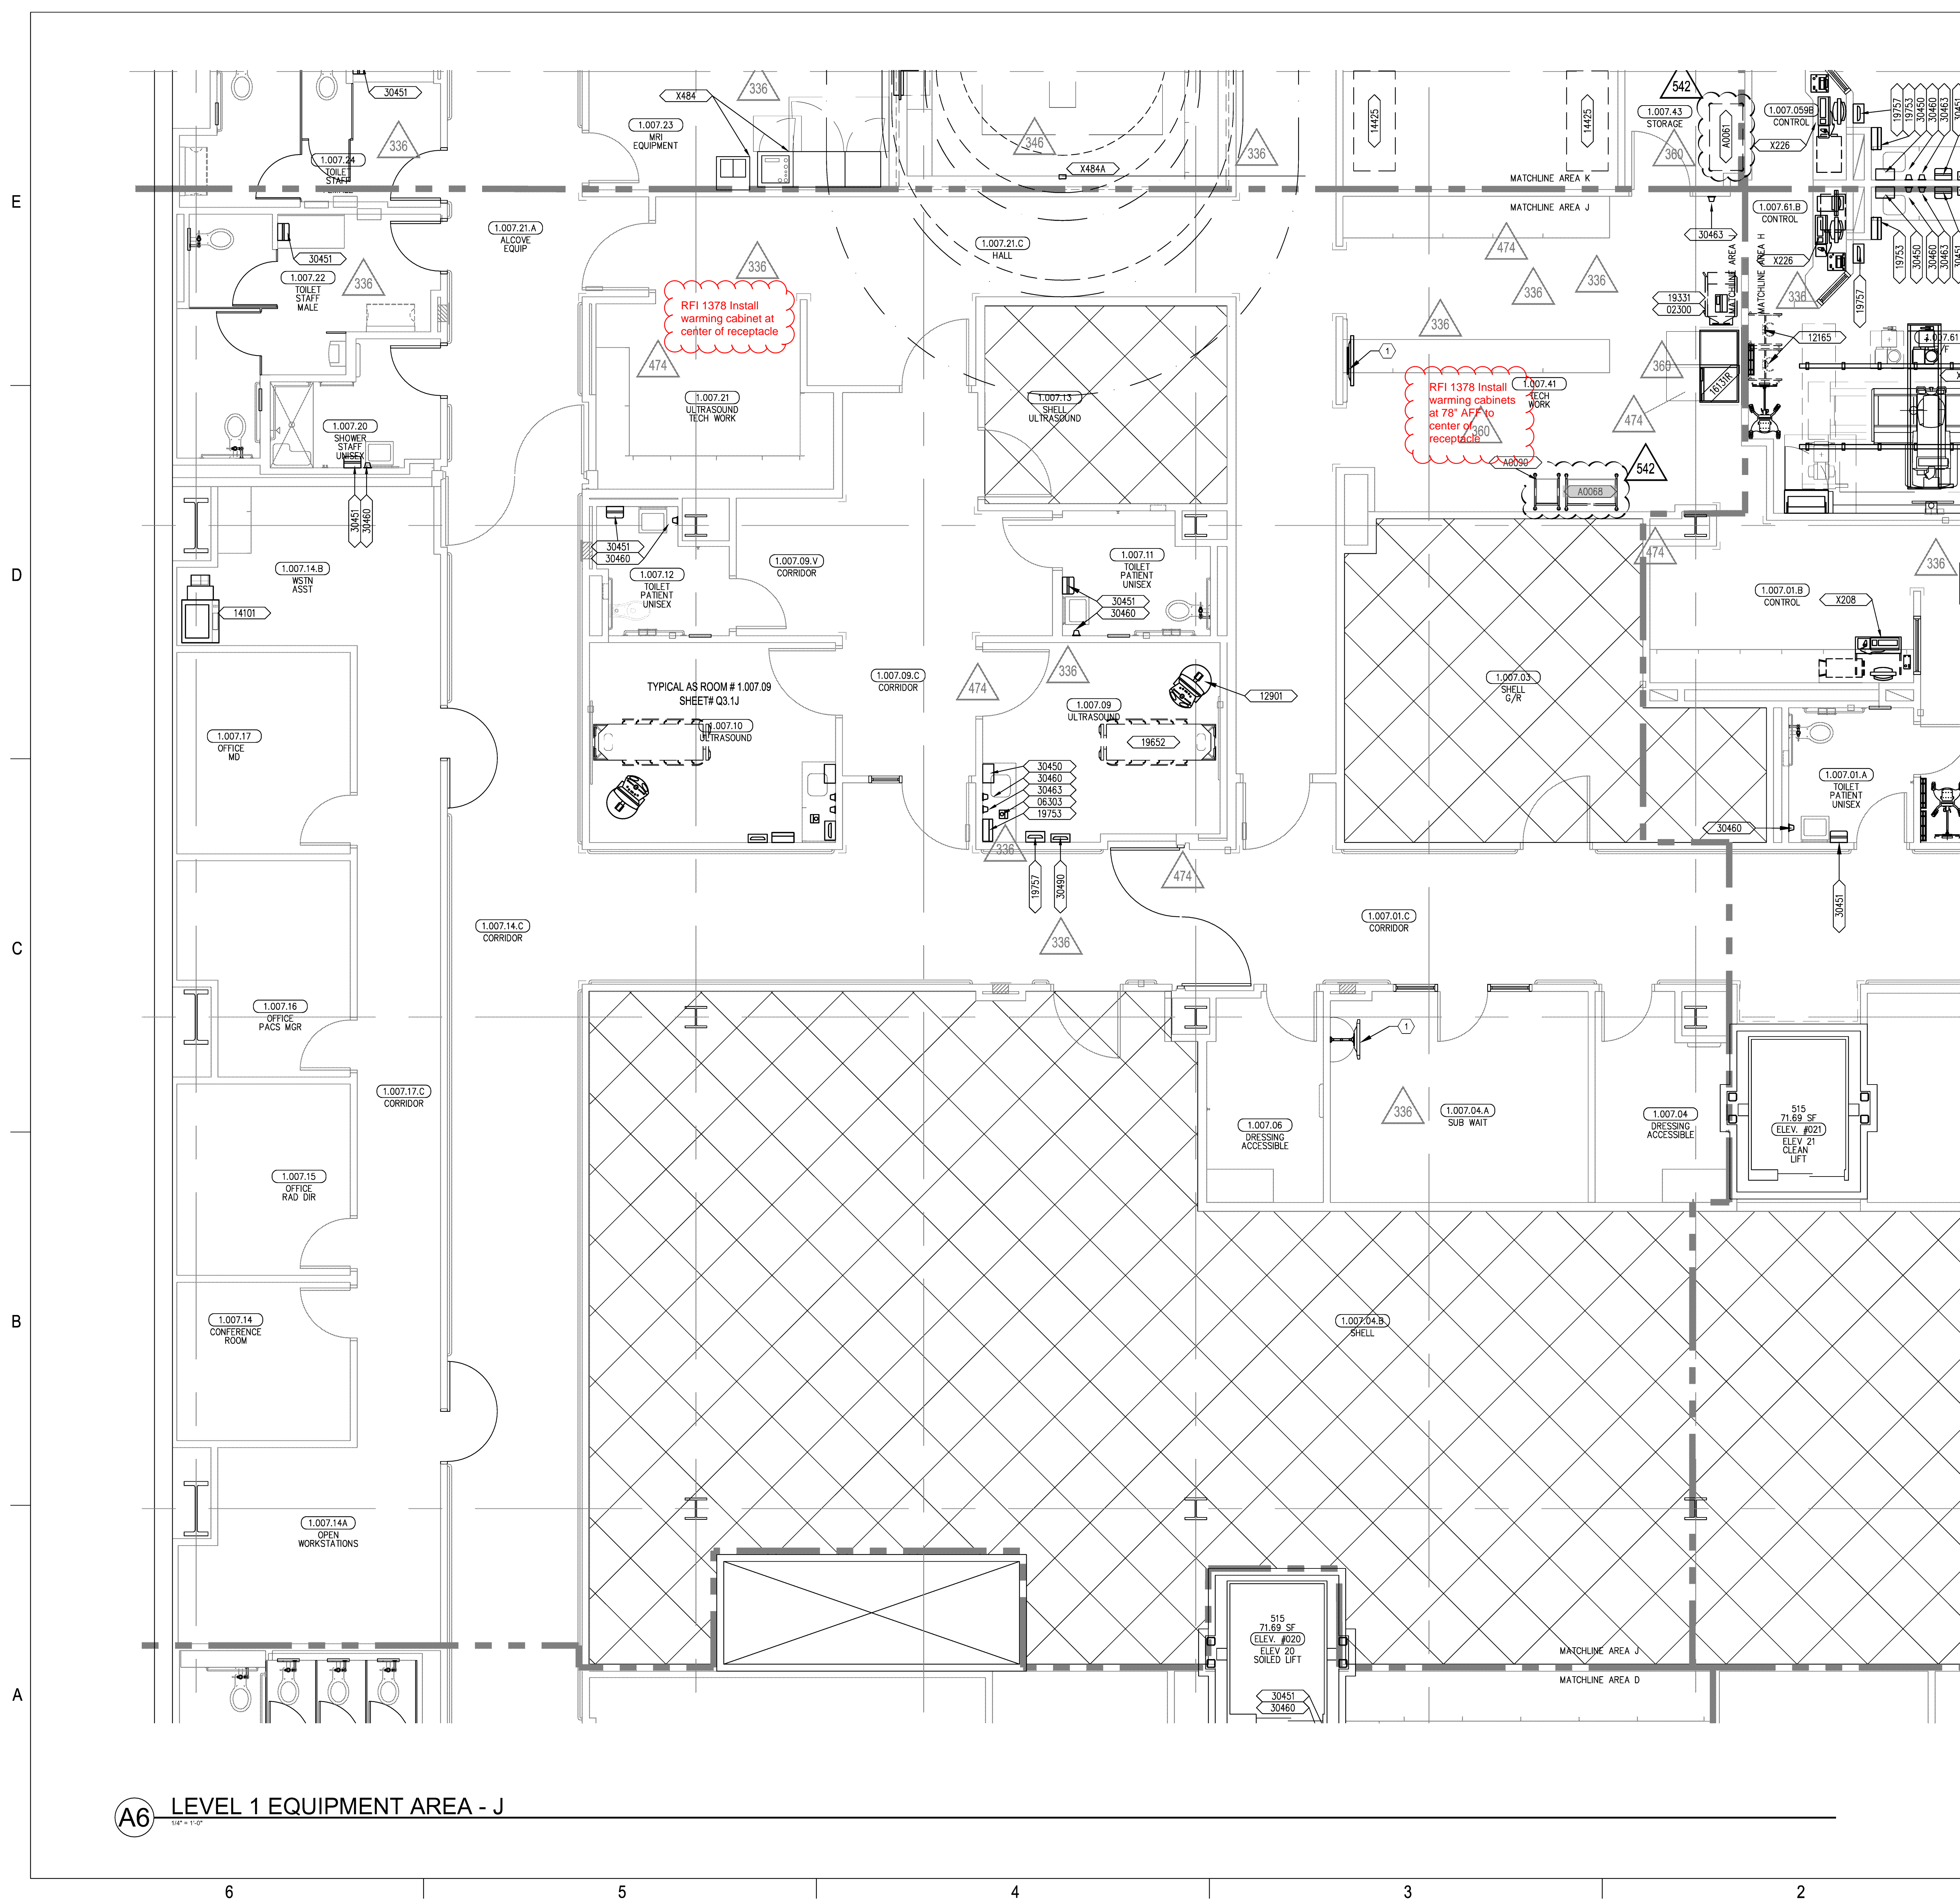

A4 SHEET KEYNOTES

1. PLACEHOLDER FOR TV/DVD/TRACKING BOARD, AND ASSOCIATED BRACKET. REFER TO OTHERS FOR SPECIFICATION INFORMATION.

A3 GENERAL NOTES

SEE EQUIPMENT LEGEND, SHEETS **Q0.03 & Q0.04**, FOR ITEM I.D. AND DESCRIPTION

A2 EQUIPMENT LEGEND

S	T	U
R	Q	
K	L	P
J	H	G
D	E	F
		A

A1 KEY PLAN

A6 LEVEL 1 EQUIPMENT AREA - J

1/4" = 1'-0"

6

5

4

3

2

1