


FKP Architects

ARCHITECT OF RECORD

Paul C. Gloriot

FOR INFORMATION ONLY

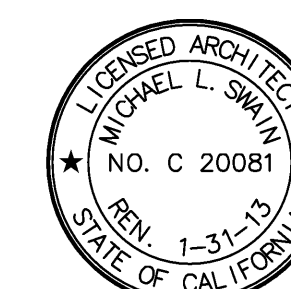

Changes on these drawings do not consist of
materially altered changes to approved drawings
and don't require a change order.
OSHPD review ACO
OSHPD review FLSO
OSHPD review DSE

RTKL


RTKL Associates Inc.
1717 Pacific Avenue
Dallas, TX 75201
Tel: 214.871.8877
Fax: 214.871.7023
www.rtkl.com

PROJECT NUMBER 10.07099.05

REVISIONS

| | |
|---------|----------|
| CO. 253 | 10/03/11 |
| CO. 272 | 02/06/12 |
| CO. 281 | 03/12/12 |
| ASI 186 | 04/27/12 |
| ASI 243 | 08/02/12 |

APPROVAL

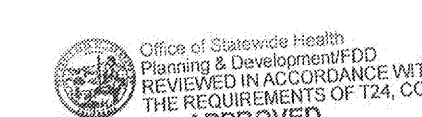

CHANGE ORDER
INSTRUCTION BULLETIN
DEFERRED APPROVAL
10/08/14

PROJECT NAME

CHILDREN'S HOSPITAL
OF ORANGE COUNTY

455 S. Main St.
Orange, CA 92668-3874

TOWER II



PROJECT NUMBER

12011.00
Increment #7

OSHPD - PROJECT NUMBER

IL 072072-30

ISSUE

OSHPD PERMIT

DATE

01/27/2010

SCALE


1/4" = 1'-0"

DRAWING TITLE

LEVEL 1 EQUIPMENT
AREA - K

DRAWING NUMBER

Q3.1K

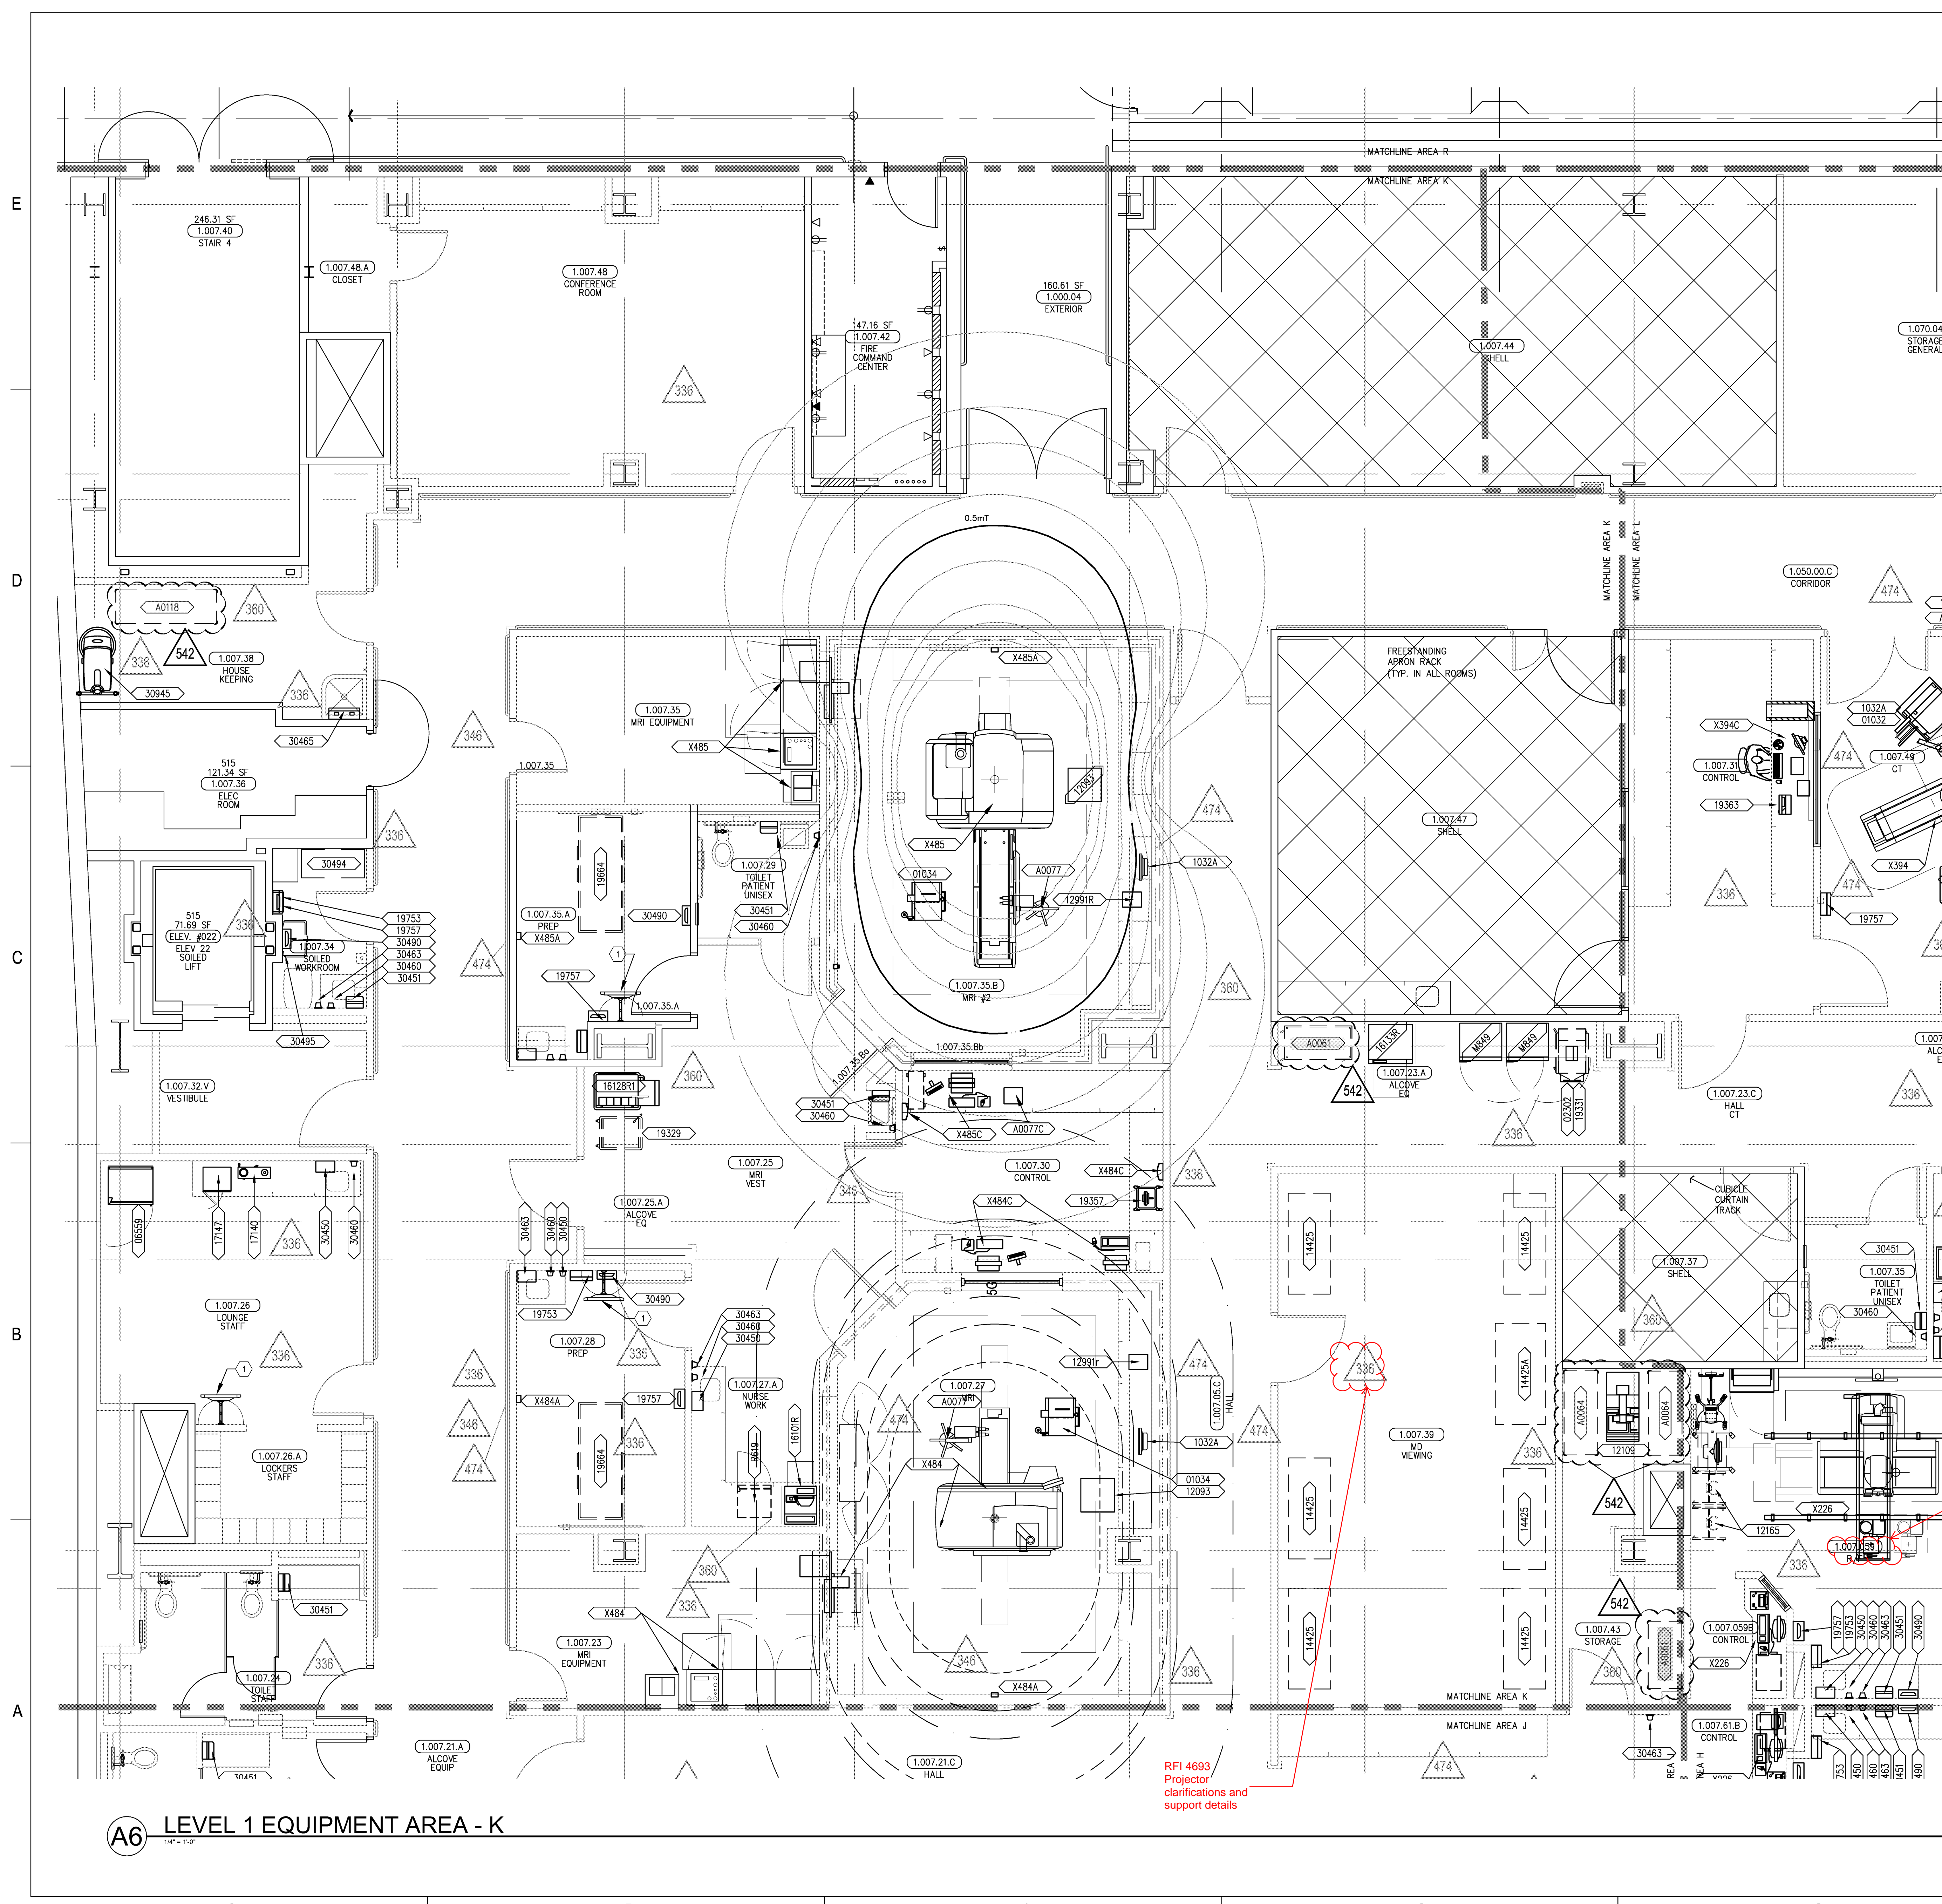

A4 SHEET KEYNOTES

1. PLACEHOLDER FOR TV/DVD/TRACKING BOARD, AND ASSOCIATED BRACKET. REFER TO OTHERS FOR SPECIFICATION INFORMATION.

A3 GENERAL NOTES

SEE EQUIPMENT LEGEND, SHEETS Q0.03 & Q0.04, FOR ITEM I.D. AND DESCRIPTION

A2 EQUIPMENT LEGEND

A12-0889
Relocate In-Wall &
Ceiling Boxes at
Various Locations

| | | |
|---|---|---|
| S | T | U |
| R | Q | |
| K | L | P |
| J | H | G |
| D | E | F |
| | | A |

A1 KEY PLAN

A6 LEVEL 1 EQUIPMENT AREA - K

RFI 4693
Projector
clarifications and
support details