




FOR INFORMATION ONLY

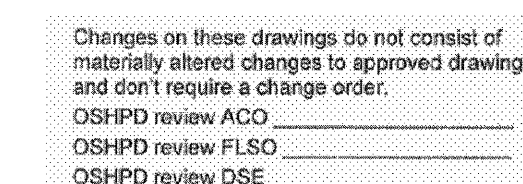


PROJECT NUMBER 10.07099.05

## REVISIONS

PAID-2011-02522

337 CO. 264 11/02/11

APPROVAL

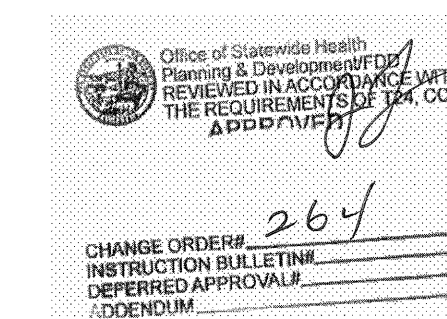

PROJECT NAME

CHILDREN'S HOSPITAL  
OF ORANGE COUNTY

455 S. Main St.  
Orange, CA 92868-3874

TOWER II



PROJECT NUMBER

12011.00  
Increment #7

OSHPD - PROJECT NUMBER

IL 072072-30

ISSUE  
OSHPD PERMIT

DATE \_\_\_\_\_

01/27/2010

SCALE


$$1/4" = 1'-0"$$

DRAWING TITLE

LEVEL 2 EQUIPMENT  
AREA - D

DRAWING NUMBER

### Q3.2D

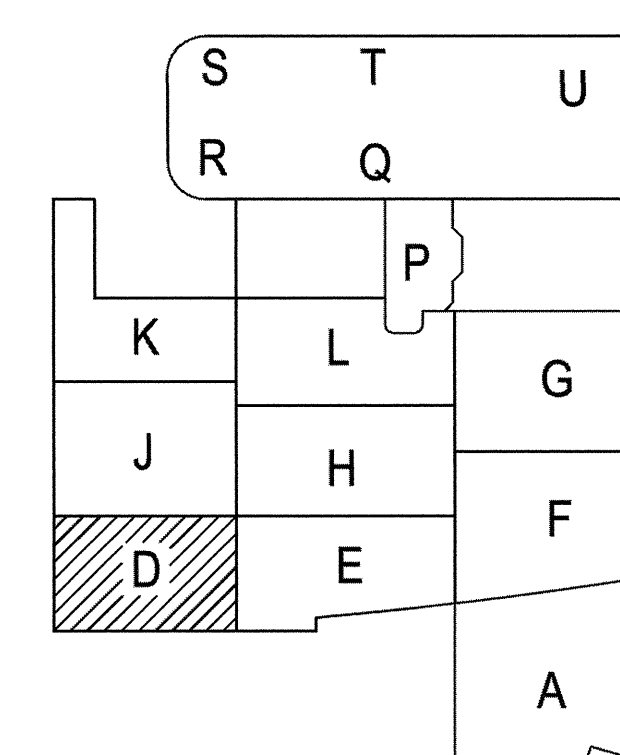

**A1** KEY PLAN

SEE EQUIPMENT LEGEND, SHEETS **Q0.03 & Q0.04**, FOR ITEM I.D. AND DESCRIPTION

REFER TO ITEMS CUT-SHEET FOR SEISMIC  
INFORMATION. SEE SHEETS **Q3.2MX** FOR  
REFERENCE STRUCTURAL DETAILS.

ROOM	CHANGES	REASON OF CHANGE
2.018	① UPDATE EQUIPMENT BACKGROUND. ADD STORAGE RACKS. 31202.	PER OWNER'S REQUEST/COORDINATION.

NOTE BY NUMBER

### GENERAL NOTES

## EQUIPMENT LEGEND

## KEY PLAN

DRAWING NUMBER

### Q3.2D

X:\ACTIVE PROJECTS\CA -- CHILDREN'S HOSPITAL OF ORANGE COUNTY\DRAWINGS\RTKL\SHEETS\03\_2D\_LEVEL\_2\_EQ\_AREA\_D.DWG  
11/21/2011  
ADELANEY