


FKP Architects

ARCHITECT OF RECORD

Paul C. Giorio

FOR INFORMATION ONLY

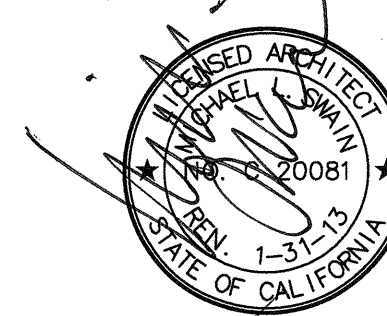

Changes on these drawings do not consist of
materially altered changes to approved drawings
and specifications in any way.
OSHPD review ACO
OSHPD review PLSD
OSHPD review DSE

RTKL


RTKL Associates Inc.
1717 Pacific Avenue
Dallas, TX 75201
Tel: 214.871.8877
Fax: 214.871.7023
www.rtkl.com

PROJECT NUMBER 10.07099.05

REVISIONS

CO. 261 09/05/11
CO. 281 03/12/12
CO. 323 04/28/12

APPROVAL

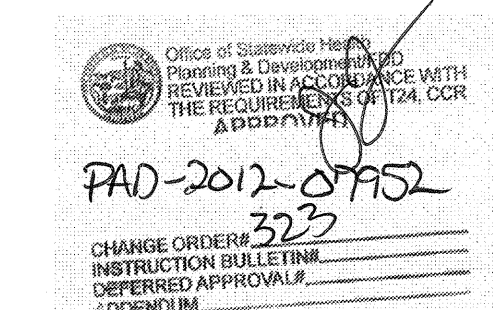

PROJECT NAME

CHILDREN'S HOSPITAL
OF ORANGE COUNTY

455 S. Main St.
Orange, CA 92668-3874

TOWER II

CHOC
HOSPITAL

PROJECT NUMBER

12011.00
Increment #7

OSHPD - PROJECT NUMBER

IL 072072-30

ISSUE

OSHPD PERMIT

DATE

01/27/2010

SCALE


1/4" = 1'-0"

DRAWING TITLE

LEVEL 3 EQUIPMENT
AREA - J

DRAWING NUMBER

Q3.3J

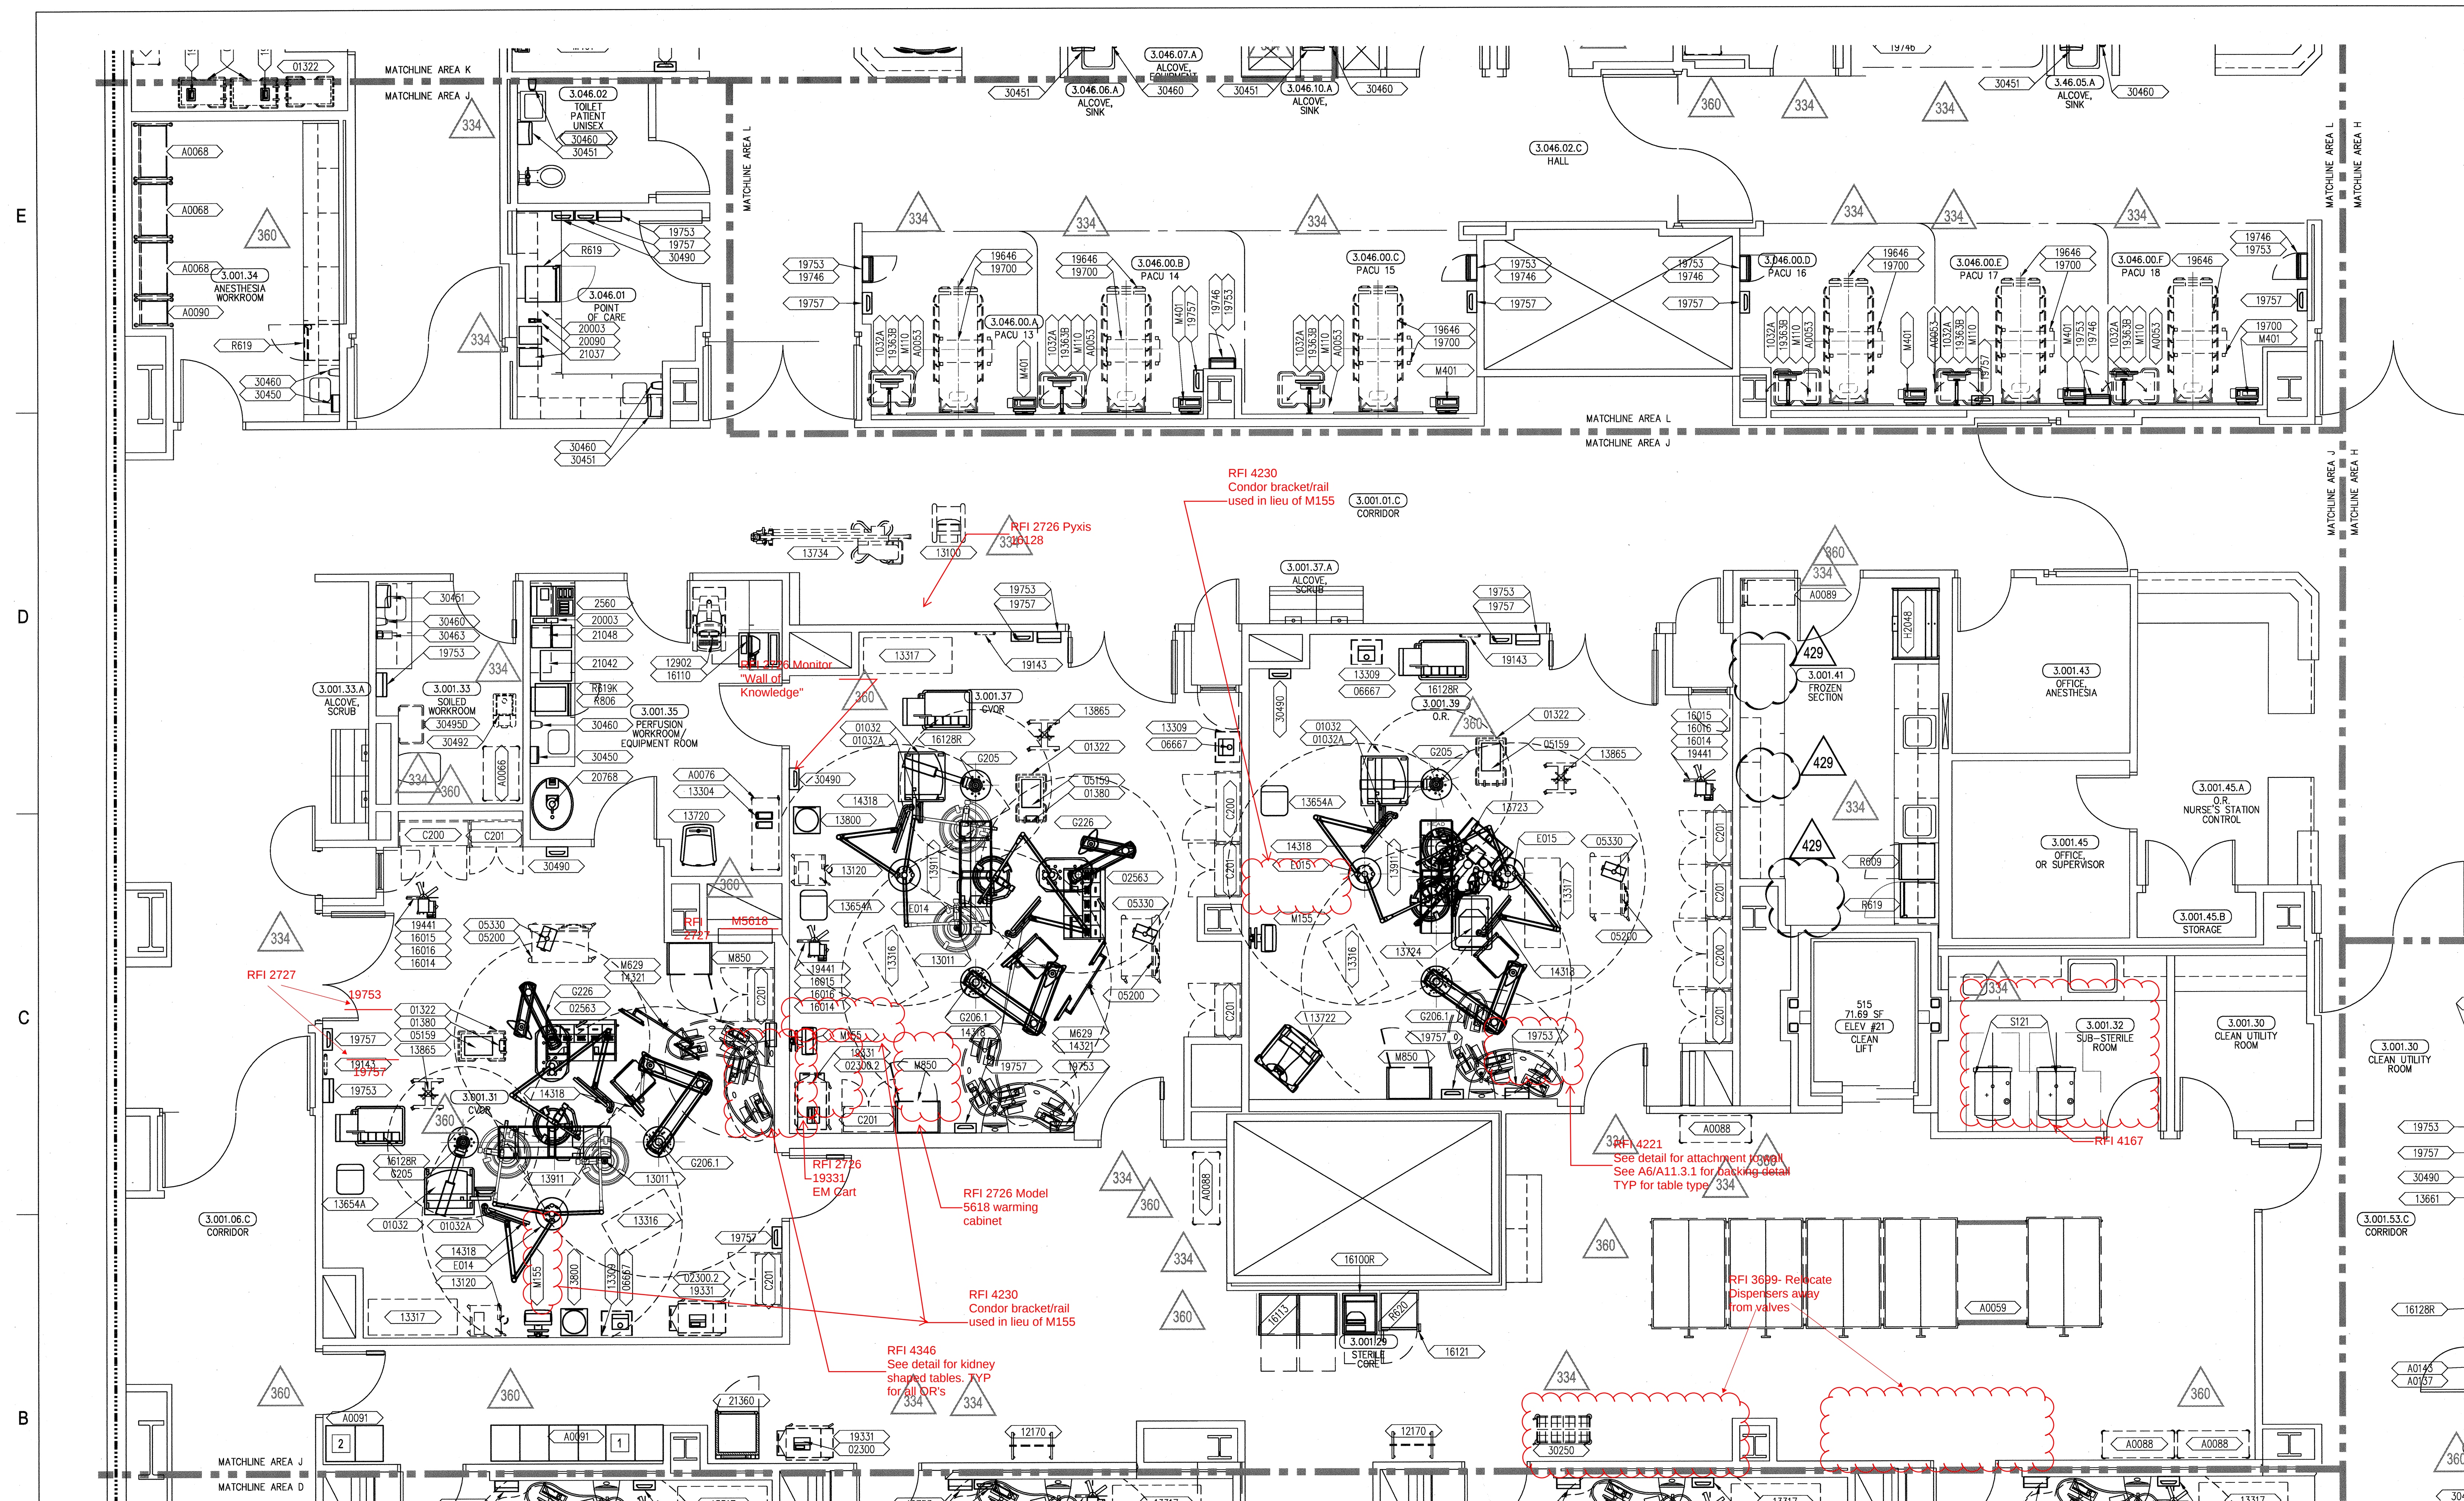

B6 LEVEL 3 EQUIPMENT AREA - J

1. REFER TO ITEMS CUT-SHEET FOR SEISMIC
INFORMATION. SEE SHEETS Q3.3MXA & Q3.3MxB
FOR REFERENCE STRUCTURAL DETAILS.

SEE EQUIPMENT LEGEND, SHEETS Q0.03 &
Q0.04, FOR ITEM I.D. AND DESCRIPTION

A3 GENERAL NOTES

A2 EQUIPMENT LEGEND

A1 KEY PLAN

