


FKP Architects

ARCHITECT OF RECORD

Paul C. Gloriot

FOR INFORMATION ONLY

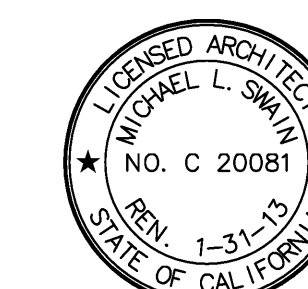

Changes on these drawings do not consist of
materially altered changes to approved drawings
and don't require a change order.
OSHPD review ACO
OSHPD review FLSO
OSHPD review DSE

RTKL

RTKL Associates Inc.
1717 Pacific Avenue
Dallas, TX 75201
Tel: 214.871.8877
Fax: 214.871.7023
www.rtkl.com

PROJECT NUMBER 10.07090.05

REVISIONS

CO. 264	11/02/11
CO. 281	03/12/12
ASI 186	04/27/12
ASI 243	08/02/12

APPROVAL



CHANGE ORDER
INSTRUCTION BULLETIN
DEFERRED APPROVAL
10/08/14

PROJECT NAME

CHILDREN'S HOSPITAL
OF ORANGE COUNTY

455 S. Main St.
Orange, CA 92868-3874

TOWER II



PROJECT NUMBER

12011.00
Increment #7

OSHPD - PROJECT NUMBER

IL 072072-30

ISSUE
OSHPD PERMIT

DATE

01/27/2010

SCALE


1/4" = 1'-0"

DRAWING TITLE

LEVEL 5 EQUIPMENT
AREA - A

DRAWING NUMBER

Q3.5A

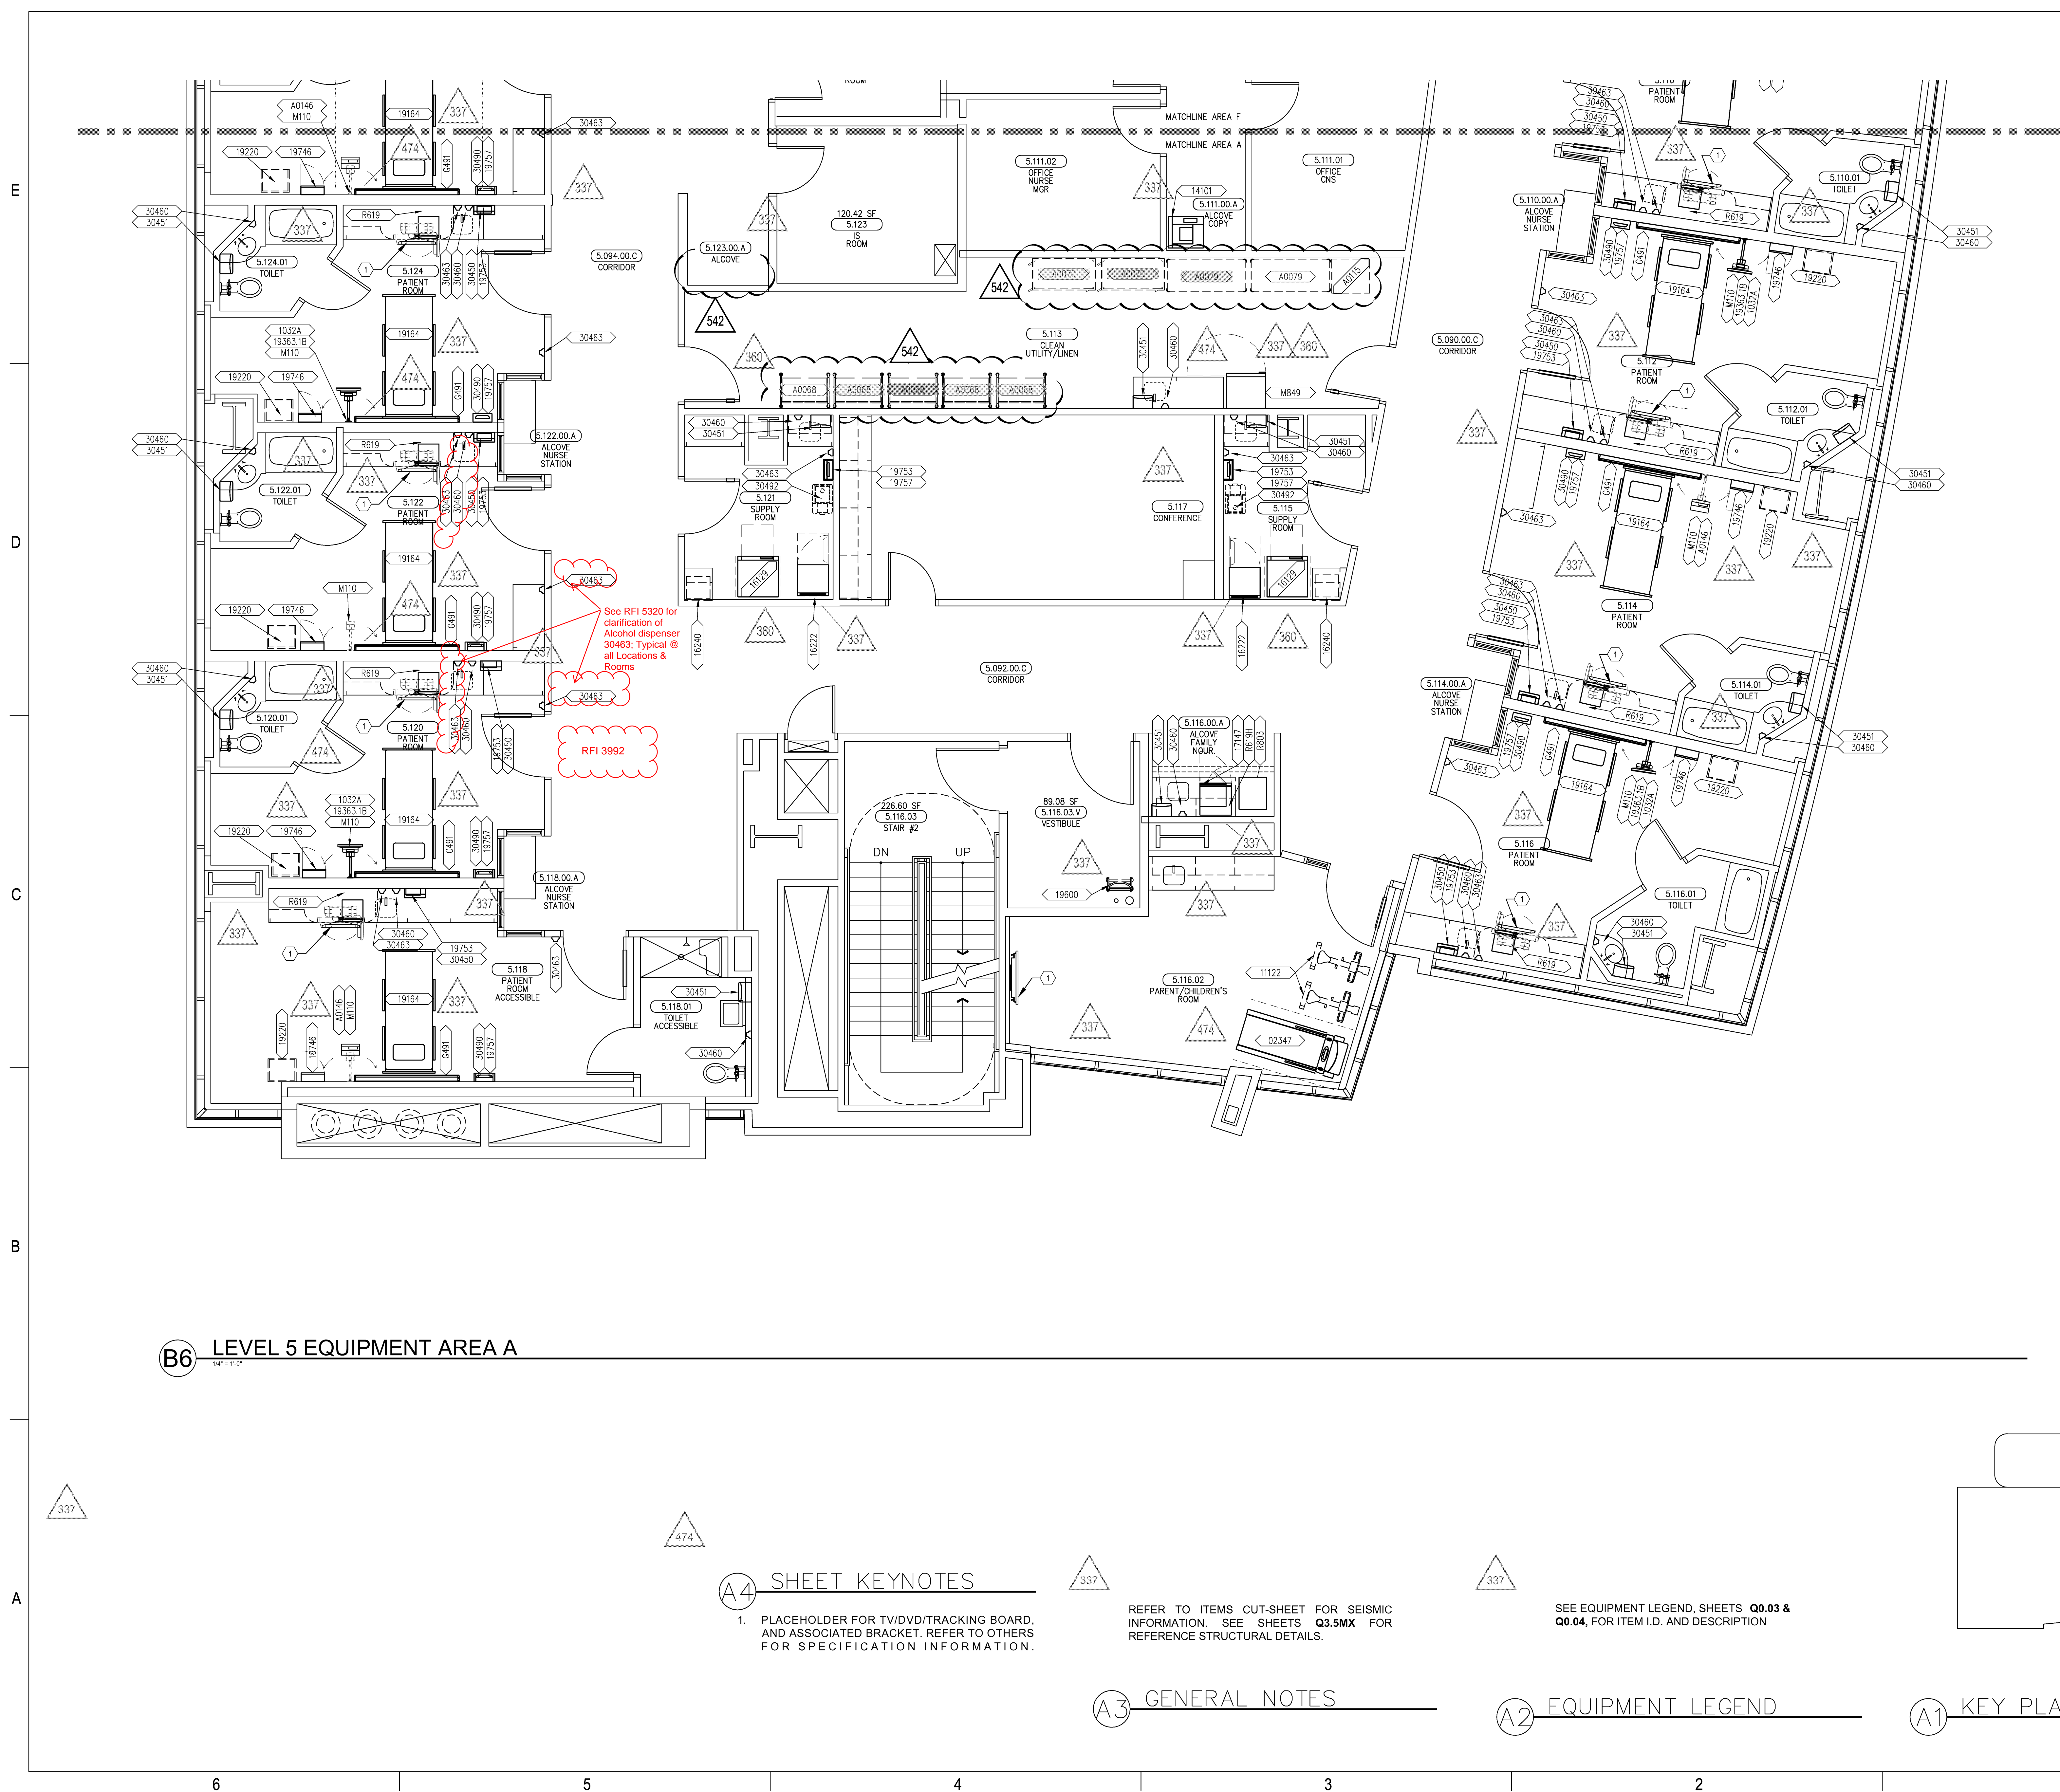

B6 LEVEL 5 EQUIPMENT AREA A

A4 SHEET KEYNOTES

1. PLACEHOLDER FOR TV/DVD/TRACKING BOARD,
AND ASSOCIATED BRACKET. REFER TO OTHERS
FOR SPECIFICATION INFORMATION.

REFER TO ITEMS CUT-SHEET FOR SEISMIC
INFORMATION. SEE SHEETS Q3.5MX FOR
REFERENCE STRUCTURAL DETAILS.

A3 GENERAL NOTES

A2 EQUIPMENT LEGEND

A1 KEY PLAN

