(C) 2007 FKP Architects, Inc. All rights reserved. No part of this document may be reproduced or utilized in any form without prior written authorization of FKP Architects, Inc. Width In. Weight Lbs. (U.N.O.) Length In. Weight Lbs. (U.N.O.) Unit# Unit# Location Equipment Location Detail Equipment Attached to 67 X226 838 Floor/Wall D4/S3.6 Polydoros Generator Cabinet 12090 Ceiling Medrad Injector Maquet boom 68 X226 D1/S3.2 Grid Holder 6501 Cabinet Storage Floor A4/S3.2 69 X226 3M X-Ray Bridge 772 + 118 A1/S2 Ceiling 6502 Cabinet Storage Floor A4/S3.2 A2/S3.3 70 X226 551 Floor/Wall-flo Luminos Wall Stand 6504 Cabinet Storage Floor A4/S3.2 D5/S3.3 X226 3,241 A1/S3.1 Luminos dRF Remote Table Floor 6559 Floor B5/S3.5 Refrigerator 72 X226 110 Floor/Wall A5/S3.11 Fluorospot Container 16108 B1/S3.11 **Automated Dispensing Station** 73 X226 DCS 2 Ceiling A1/S2 6602 Floor B5/S3.5 X226 Docking Station Wall D2/S3.1 16229 Refrigerator / Freezer Not Used 16133 Automated Dispensing Station 2,920 Floor B1/S3.11 16134 Automated Dispensing Station - 2,920 F1001 D1/55.11 iomotom Sensation Floor D4/S3.3 & X394C X394 Ceiling B4/S3.6 Care Vision Monitor A4/S3.4 L126 Table, Morgue Autopsy Floor & X394C 12 31018 Shelving Unit - - 1,200 Floor X394 1,785 B5/S3.3 Patient Table Floor & X394C Not Used 31020 **Shelving Unit** Floor B2/S3.3 D2/S3.12 Eaton SPD Wall 31022 1,200 Shelving Unit Floor B2/S3.3 & X394C Not Used 1,827 C200 A5/S3.2 OR Supply Cabinet X394 PDC A & B Cabinet D5/S3.2 Floor C201 2,800 Cabinet Wall A5/S3.2 & X394C X248 PCDU-100VL Distribution Unit A5/S3.8 Floor C602 M1208 Scope Cabinet B4/S3.12 Wall 84 X248 **Double Rack Cabinet** A5/S3.4 Floor C609 M1800 Scope Cabinet Wall B4/S3.12 85 DFP-8000 Computer Cabinet Floor D1/S3.4 19 C613 Cabinet 2,800 Wall A5/S3.2 86 X248 B1/S3.4 CAT-880B Table Floor E011 Surgical Light 494 Max. Ceiling SEE PLANS 87 X248 882 or 243 A2/S3.1 Single Rack Cabinet Floor E012 Surgical Light 494 Max. Ceiling A2/S3 88 X248 CAS-820 Suspension 2,626 C4/S2 Ceiling E014 Ceiling SEE PLANS Surgical Light X248 CAS-880 C-Arm 2,426 D2/S3.7 Floor 23 SEE PLANS E015 494 Max. Ceiling Surgical Light T.B.D X248 HEX-125 Cooling Unit 200 max. Rack E031 Surgical Light FPD Coolant Circulator & 200 max. Floor B5/S3.10 25 E015.13 Surgical Light 494 Max. Ceiling DFP-8000D Box 92 X821 3,307 B4/S3.2 E016 Surgical Light Ceiling X821 Symbia S. 6,114 Floor E039 Surgical Light 494 Max. Ceiling E228 Satellite Care 512 Max. Ceiling G200 Support Column Ceiling 6606 Refrigerator Floor G205 Support Column 512 Max. Ceiling 6618 G206 Support Column Ceiling 23131 hampen property and the second 32 G206.1 512 Max. Support Column manner menter me 99 20743 Freezer (Double Door) 33 ORETA41 Bracket Monitor 70.9 B5/S3.5 Floor 100 24191 G223 Support Column Ceiling 512 Max.  $\frac{}{}$ R902 2,000 Floor 35 G226 Support Columns SEE PLANS Refrigerator, Morgue 1,100 Max. Ceiling your the transfer of the trans 36 G491 Wall A5/S3.1 G492 Headwall Wall A5/S3.1 M626 DVD/VCD Bracket - - 45 Wall D1/S3.6 Not Used L525 Hood-Air Flow Floor M630 Flat Panel Monitor Ceiling D1/S3.5 Not Used 106 R176 Ice Maker (under counter) A0104 M Series Cabinet Anchorage 1530 B4/S3.3 Floor <400 R609 Freezer (under counter) L350 Cabinet Bio Sofoty A1/S3.2 108 Not Used L353 Cabinet Bio Sofoty A1/S3.2 Refrigerator 25 A0047 Dual Flat Panel 110 Not Used Accordance of the second Not Used 280 Floor R803 B1/S3.5 Not Used 112 Not Used M849 Warming Cabinet by Blickman 1,046 113 R806 Wall A4/S3.5 M850 & M850A 799 Max. Warming Cabinet Not Used Sink Scrub (Single Bay) B1/S3.6 115 X163 Rack (Apron) Wall D2/S3.6 P302 Sink Scrub (Double Bay) Wall B1/S3.1 116 X601 Wall B4/S3.5 illuminator S121 Sterilizer M401 Charting Station Wall Mount Bracket S521 Steam Sterilizer 4,700 D2/S3.4 Not Used S521A Amsco Evolution Piping Stand D4/S3.11 Shower Seat Support 54 S951 & S951A Sonic Cleaner Not Used Reliance Vision Washer Disinfector 1187 Floor 16125 Automated Dispensing Station Floor 56 W122A, B, C, Washer/Disinfector Conveyor 122 30465 Dispenser Wall B2/S3.4 123 31132 Shelving Unit W197 Return Conveyor W292 Reliance Washer Disinfector James Comment of the same of t X080 Medrad Injector Ceiling C331 Cabinet Storage Floor X208 Ysio Wall Stand 551 Floor/Wall-floo A0125 Bracket Monitor B5/S3.12 the state of the s <del>muuuuuuuu</del> X208 Grid Holder Wall X208 Ysio Table 1,632 A1/S3.3 31014 Floor B2/S3.3 Sim. 129 31105 Shelving Unit Polydoros Generator Cabinet Floor/Wall B2/S3.3 Sim. Floor 130 31134 X208 3M X-Ray Bridge 772+118 Ceiling Shelving Unit Floor B2/S3.3 Sim. X208 Imaging Container 131 A0008 X-Ray Unit Wall X208 Docking Station Wall

					T			T
No.	Unit#	Equipment	Length in.	Width In.	Height In.	Weight Lbs. (U.N.O.)	Location	Detail
132				Not Used				
133	M629	Bracket	45	7	4	12	Ceiling	D1/S3.5 Sim.
134		Storage Cabinet				65	Counter	A2/S3.10
35	6506 16226R	Refrigerator	<b>.</b> .	_	<u> </u>	950	Floor	A4/S3.6
136	كسر		~~~	~~~ <u>~</u>	- August 1	<del>~~~</del>		June 1
-	\$407 ~~~~	Sterrad 100S Sterilizer		كسما	\ \ \ \ \ \ \ \ \ \ \ \ \ \ \ \ \ \ \	830	FLOOR	B1/S3.12
37		<del>~~~~~~</del>		Not Used	<del>-</del>	<del>~~~~</del>	سممس	ارسسم
138	19363.1B	Bracket	-	-	مرند ع	60 Max.	Wall	D4/S3.4
139	X602	Viewbox		٠,٠٠٠	<u>}</u> .		Wall	B4/S3.5
140	14102	Photocopier	Cia	<u>.</u>	-		Floor	
41	13113	Heater (temperature booster)	-	-	-	30	Wall	D1/S3.12
42	C1204	M1204 Scope Cabinet	<del>-</del>		-	205	Wall	B4/S3.12
43	13102	Sterilizer	32	24	38	165	Counter	D1/S3.13
44	Hoose	Sumo Hood	25	42	C1	650	FloorAMall	DE/63 & 61m
	H2036	Fume Hood	36	42	61	650	Floor/Wall	D5/S3.5 Sim
45	16102R	Dispenser	-	# · · · · · · · · · · · · · · · · · · ·	-	1,960	Floor	B1/S3.11
46	16111	Dispenser	-	-	-	1,460	Floor	B1/S3.11
47	16113	Dispenser	<u>-</u>	-		2,920	Floor	B1/S3.11
48	16129	Dispenser		*	78	1,460	Floor	B1/S3.11
49	M648	Phlebotomy Station	41	18	18	<b>26</b>	Wall	D4/S3.10
50	P096	Water Spray	(	-		20	Wall	A2/\$3.4
51			<u> </u>	Not Used	سسا		<u> </u>	Lauren
52	20764	Analyzer	بمنيك		· ·	200	Counter	D1/S3.13
53	21025	Analyzer	} -	<b>2</b>	=	250	Counter	D1/S3.13
			}	-			<b>1</b>	D1/S3.13
54	21030	Analyzer	مسا	ستسا	سسما	250,	Counter	Lun
155	21196	Processor	18	30	61	430	Mobile/Wall	A5/S3.3
56	21358	Refrigerator	<u> </u>		-	950	Floor	A4/\$3.6
57	21367	Freezer	-		=	950	Floor	A4/S3.6
58	22122	Cytometer	<b>\</b>		- {	495	Counter	<b>T.B.D.</b>
59	20303	Freezer, Laboratory	-		-	860	Floor	B5/S3.5
60	20299	Freezer, Laboratory	-		-	950	Floor	A4/S3.6
61	20645	Refrigerator, Lab	-		-	751	Floor	B5/S3.5
62	20700	Refrigerator, Lab	<b>*</b>	**	-	806	Floor	B5/S3.5
63	20768	Freezer, Liquid Nitrogen	-	_	-	751	Floor	A4/S3.3
64	~~~	minim	7		<b>16</b>		<del>~~~</del>	
$-\downarrow$	26197	Dryer		*	*	200	Floor	D5/S3.10
65	H2036	Fume Hood	-		-	650	Floor	A1/S3.5
66 (	H2048	Fume Hood	سنم	~~~·	·	630	Floor	A1/S3.5
67	30914	Cart	-			130	Mobile/Wall	D5/A11.8
68	31013	Shelving		**	₩	1200	Floor	B2/S3.3
69	31052	Shelving		39	*	1200	Floor	B2/S3.3
70	31102	Shelving			#	1037	Floor	B2/S3.3
71	31171	Shelving	-		•	1200	Floor	B2/S3.3
72	31199	Solid Cart Supply	-		-	112	Wall	D5/A11.8
73	31203	Shelving		**		1200	Floor	B2/S3.3
74			-					
$\dashv$	20032A	Analyzer	110	36	84	2360	Floor	D1/S3.10
75	24051	Tissue-Tek VIP6			su .	584	Floor	D4/S3.12
76	A0035	FrameWRX HD	<u>~~~</u>	~··~	~~~	4,846	Wall-Floor	A1/S3.12
77				Not Used				
78	7011	Irradiator-Blood Bank	44.5	21.75	59.25	1750	Floor	T.B.D.
79	14101	Copier	48.75	26.75	46.25	<400	***	
80		<b></b>		Not Used	·	<b>~~</b> -		h
81				Not Used				****
82	19677	Incubator	35	28	62	195	Mobile/Wall	A5/S3.3 Sim.
83			حشر		~~~~	17		D1/S3.13
	20161	Water Bath	كنب	ستس	لمنتبر	ہہر آ	Counter	D 1/33.13
84				Not Used	<del>~~~</del>			<del>}                                    </del>
85	20241	Centrifuge	28	28	50	558	Floor	T.B.D. }
86	24067	Cabinet Slide Filing	u.		**	500	Floor	T.B.D.
87	L130	Workstation Grossing	*	26	*	395	Counter	A4/S3.12
88	L137	Workstation Grossing	-	-		480	Floor	-
89	20707	Refrigerator	7.		-	1,600	Floor	A4/S3.6
90	20713	Refrigerator	<b>{</b>		-	950	Floor	A4/S3.6
99				<u> </u>	سسا	تتسسا	<u> </u>	7
			~~~	<u>~~</u>	<u>~~~</u>		h _ /	<u> </u>
91	00750	Freezer	لسا	·		950	Floor	A4/S3.6
91 92	20752			Not Used				
91 92	20752							
91 92 93	20/52			Not Used				
91 92 93 94	20752 S403R	STERILIZER	-		-	910	Floor	A1/S3.11
191 192 193 194 195		STERILIZER			- 5\$		Floor	A1/S3.11



## **FKP Architects**

ARCHITECT OF RECORD

"Achitect of Record signature line only; this drawing was not prepared under the direct supervision of the Architect of Record. The direct responsibility for preparation of this sheet lies with its corresponding professional stamp and signature. The signature of the Architect of Record in general responsible charge of the project is provided as required by Title 24, Part 1 Section 7-115 (a)".

ARCHITECT - PAUL C. GLORIOD

Changes on these drawings do not consist of materially altered changes to approved drawings and don't require a change order.

OSHPD review ACO
OSHPD review FLSO

CONSULTANT

STRUCTURAL

MECHANICAL

TAYLOR
& GAINES


\*\*ELECTRICAL
- CIVIL

320 North Halstead Street, Suite 200

Pasadena, California 91107

Phone: 626.351.8881

Fax: 626.351.5319

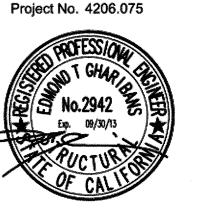

## REVISIONS Refer to sheet S0 for revisions not noted

02/05/2010 INFORMATION BULLETIN #5

09/05/11 OSHPD Change Order 261

09/26/11 OSHPD Change Order 262

10/12/11 OSHPD Change Order 263


11/09/11 OSHPD Change Order 264

05/30/12 OSHPD Change Order 364

06/06/12 OSHPD Change Order 379

06/13/12 OSHPD Change Order 381
08/01/12 OSHPD Change Order 387

APPROVAL

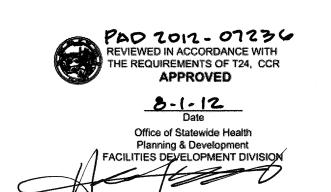

## CHILDREN'S HOSPITAL OF ORANGE COUNTY 455 S. Main St.

Orange, CA 92868-3874

TOWER II



PROJECT NUMBER

12011.00 Increment #7

OSHPD - PROJECT NUMBER

IL 072072-30

OSHPD Permit

01/28/2010

NONE

DRAWING TITLE

MEDICAL EQUIPMENT SCHEDULE

DRAWING NUMBER

S<sub>0.1</sub>