



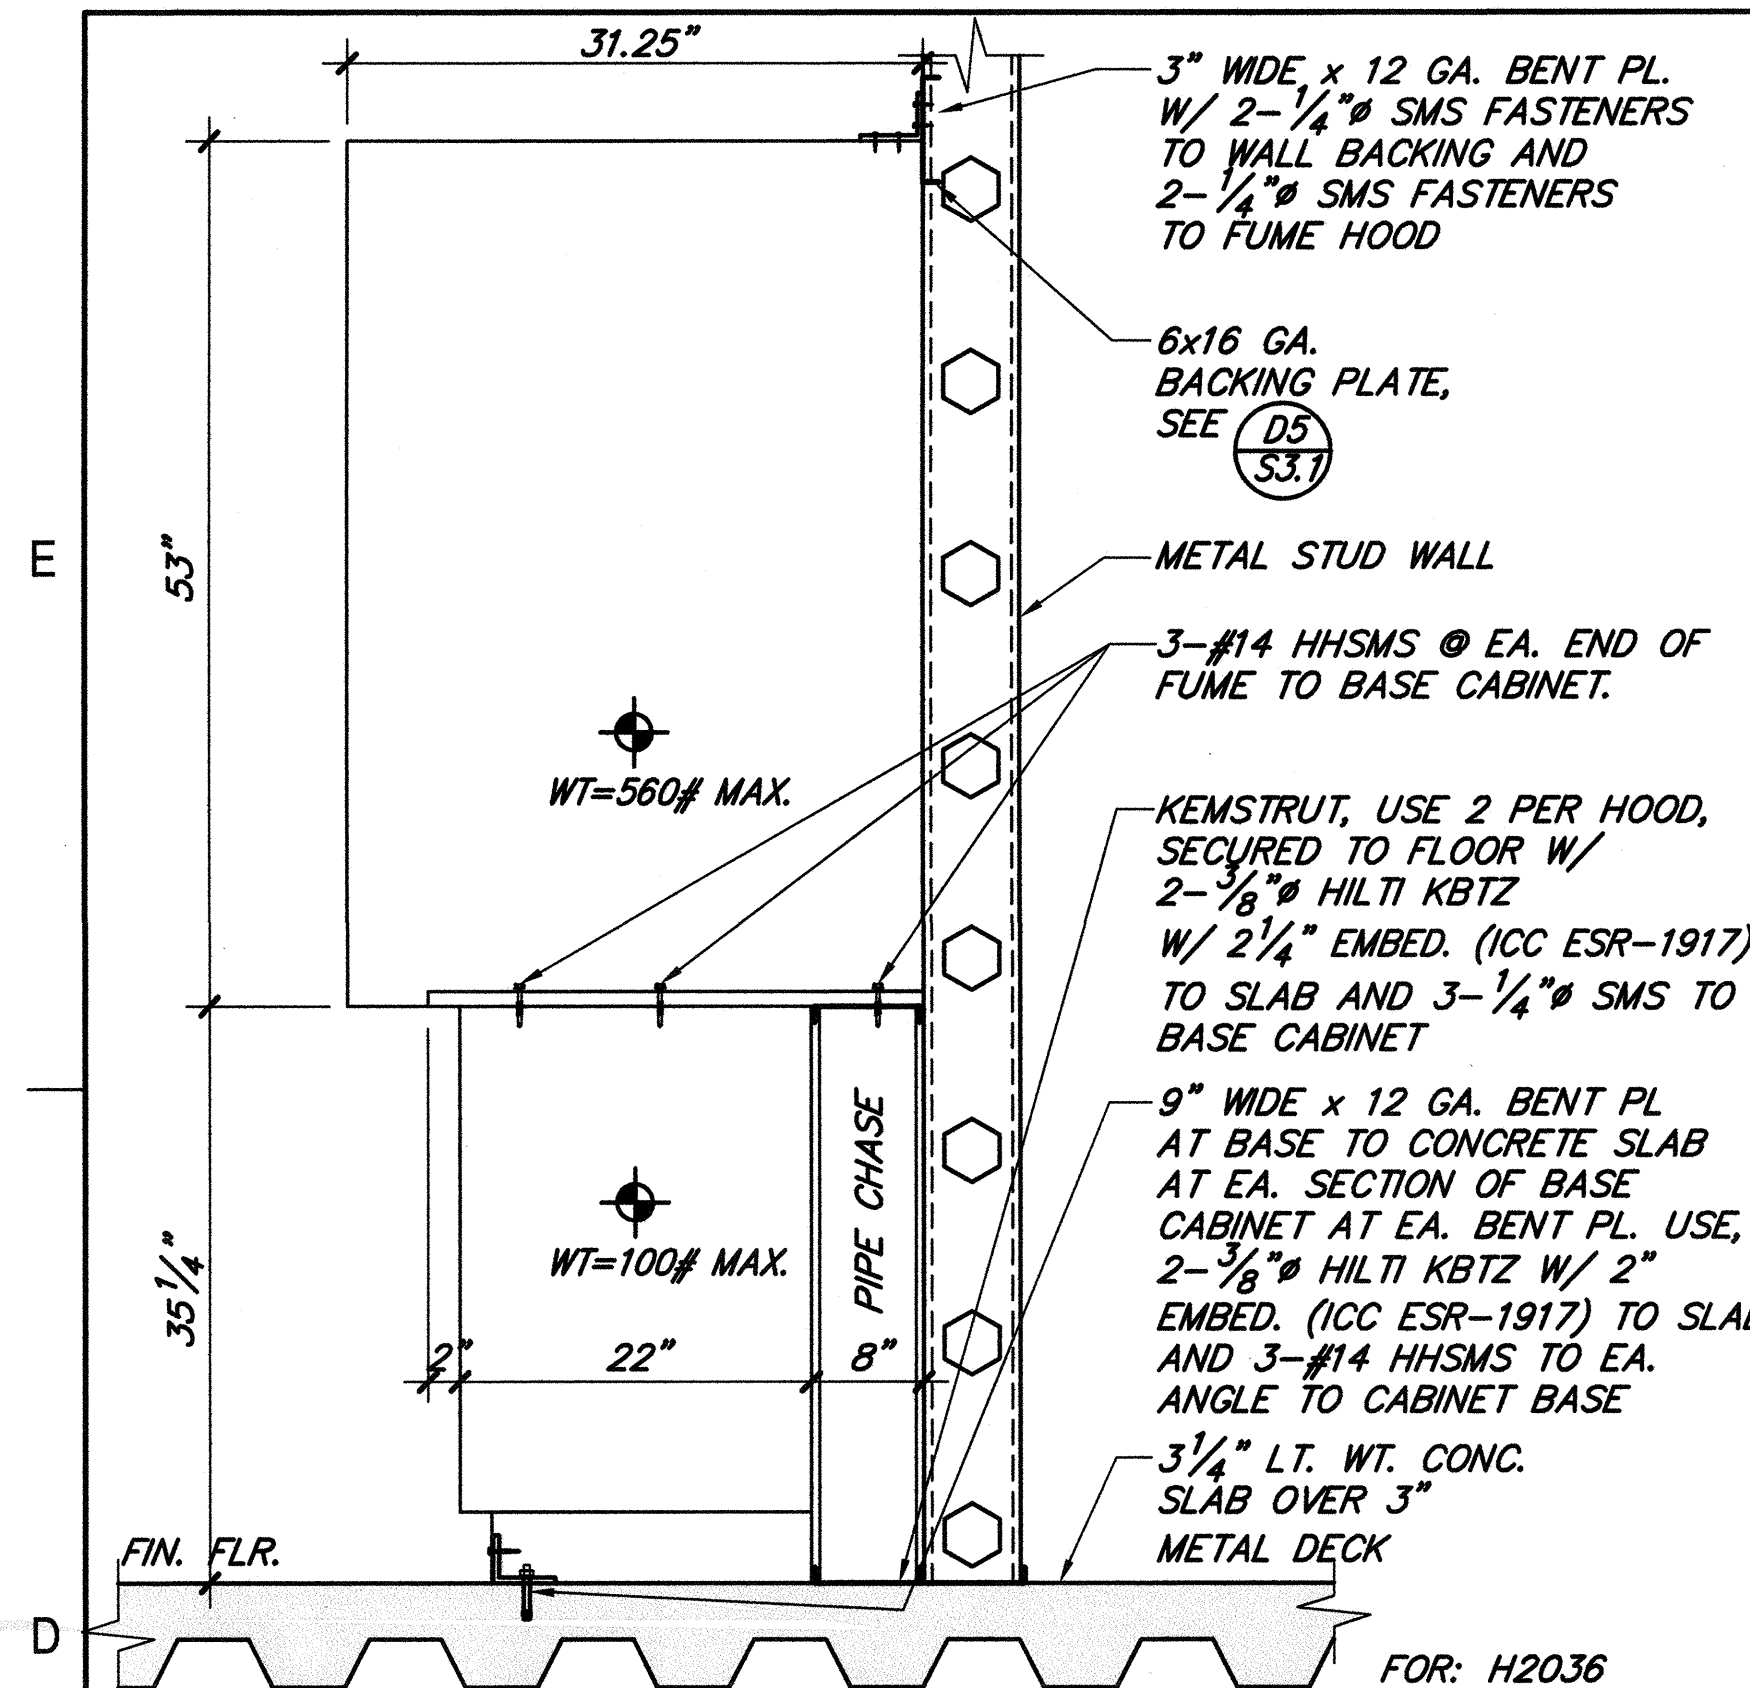


FUME HOOD ANCHORAGE DETAIL

NONE D5

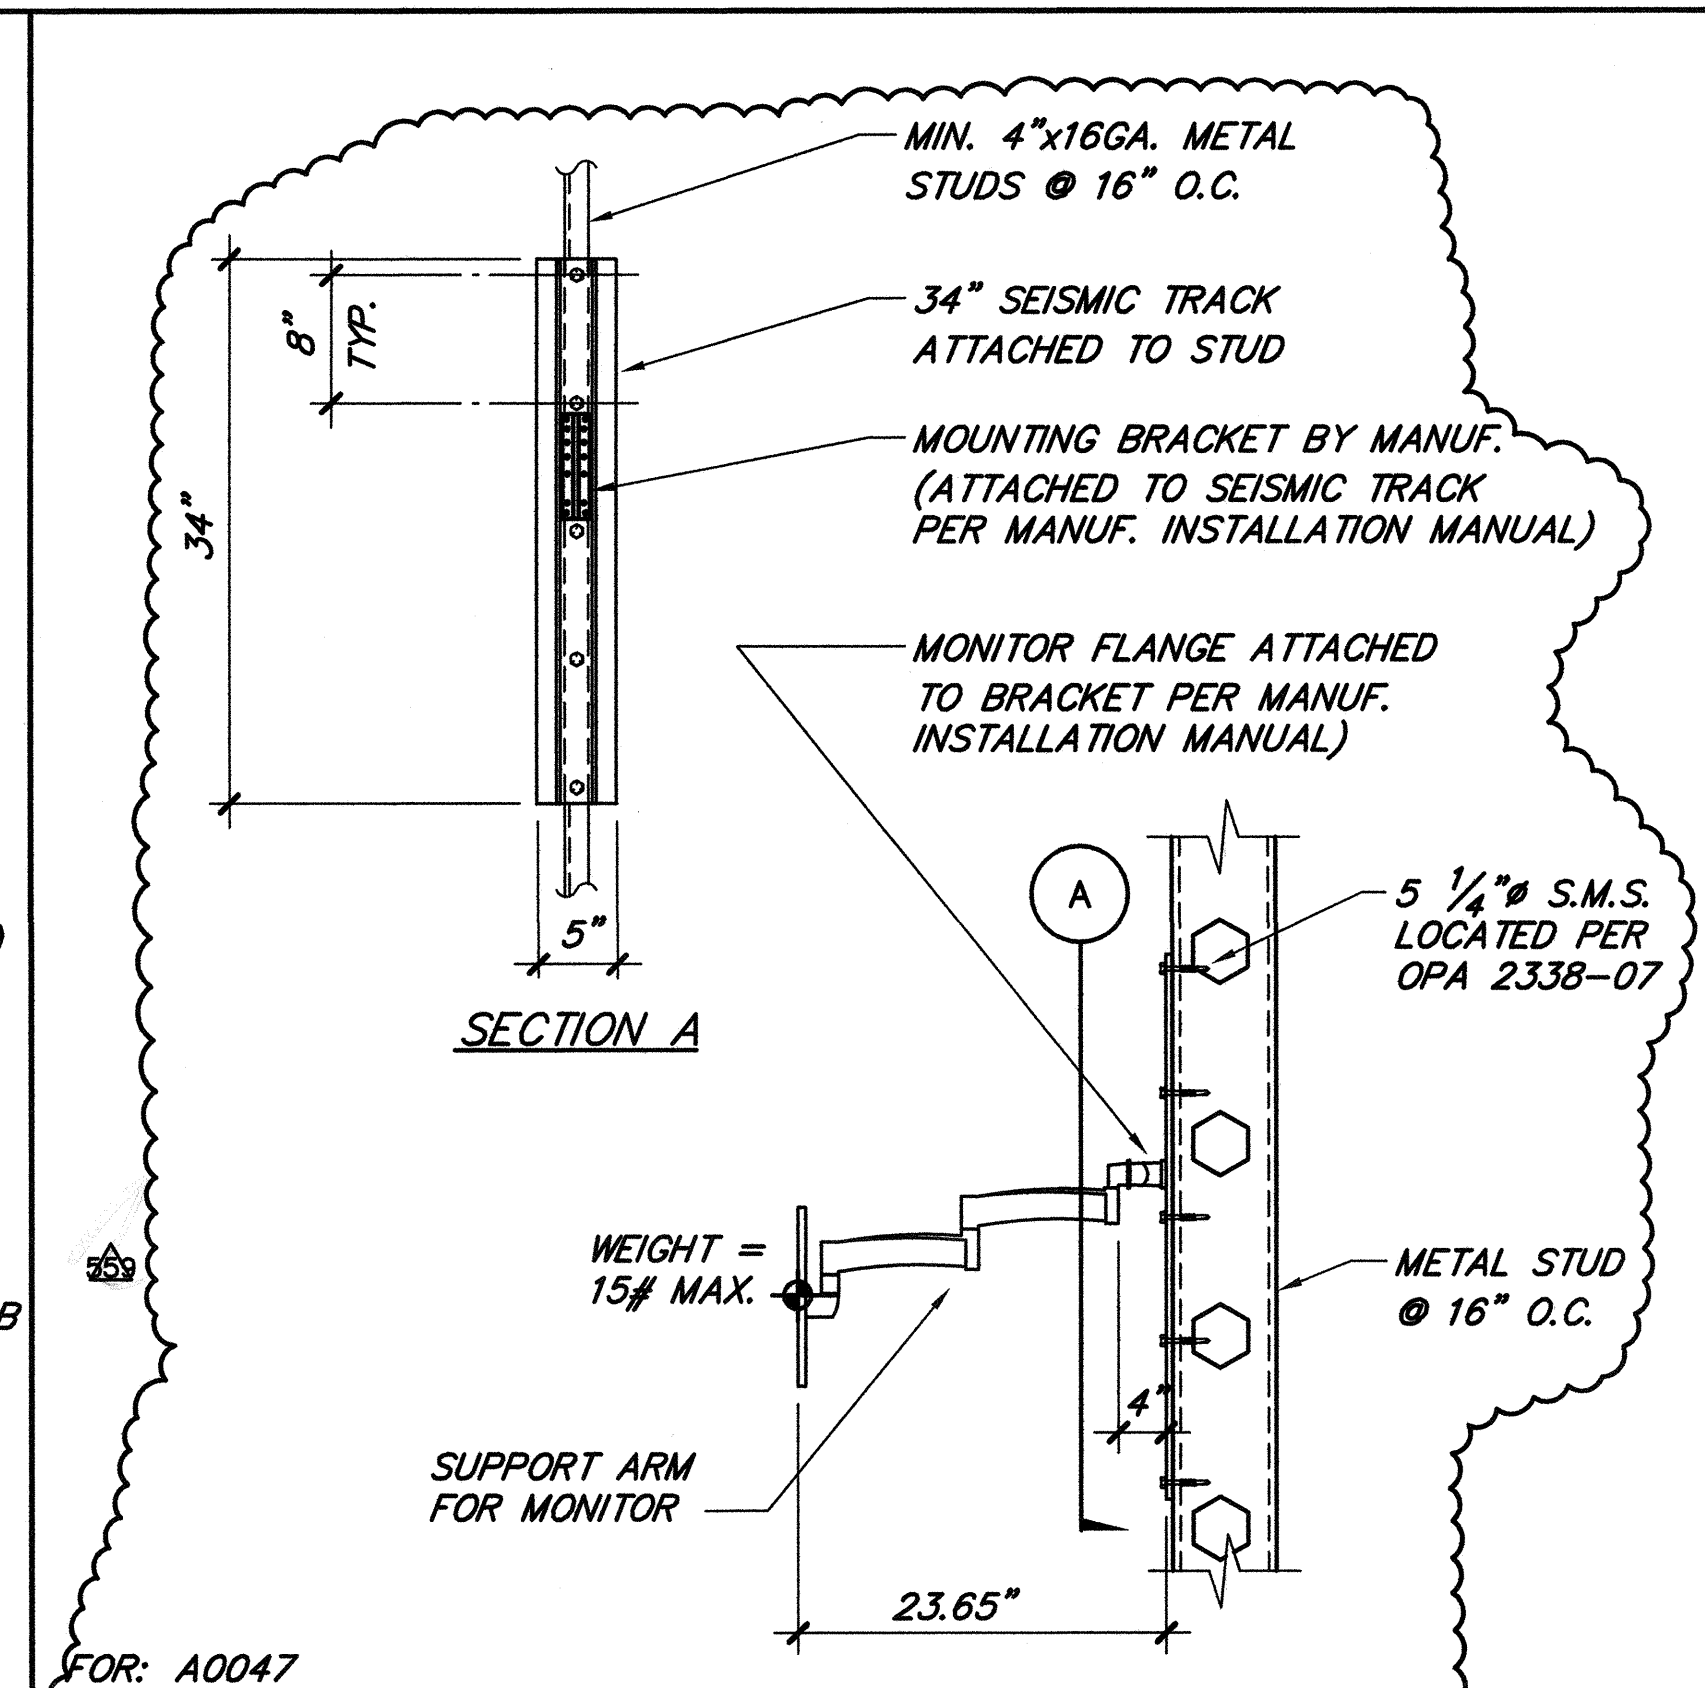


ERGOTRON 200 SERIES MONITOR ANCH.

NONE D4

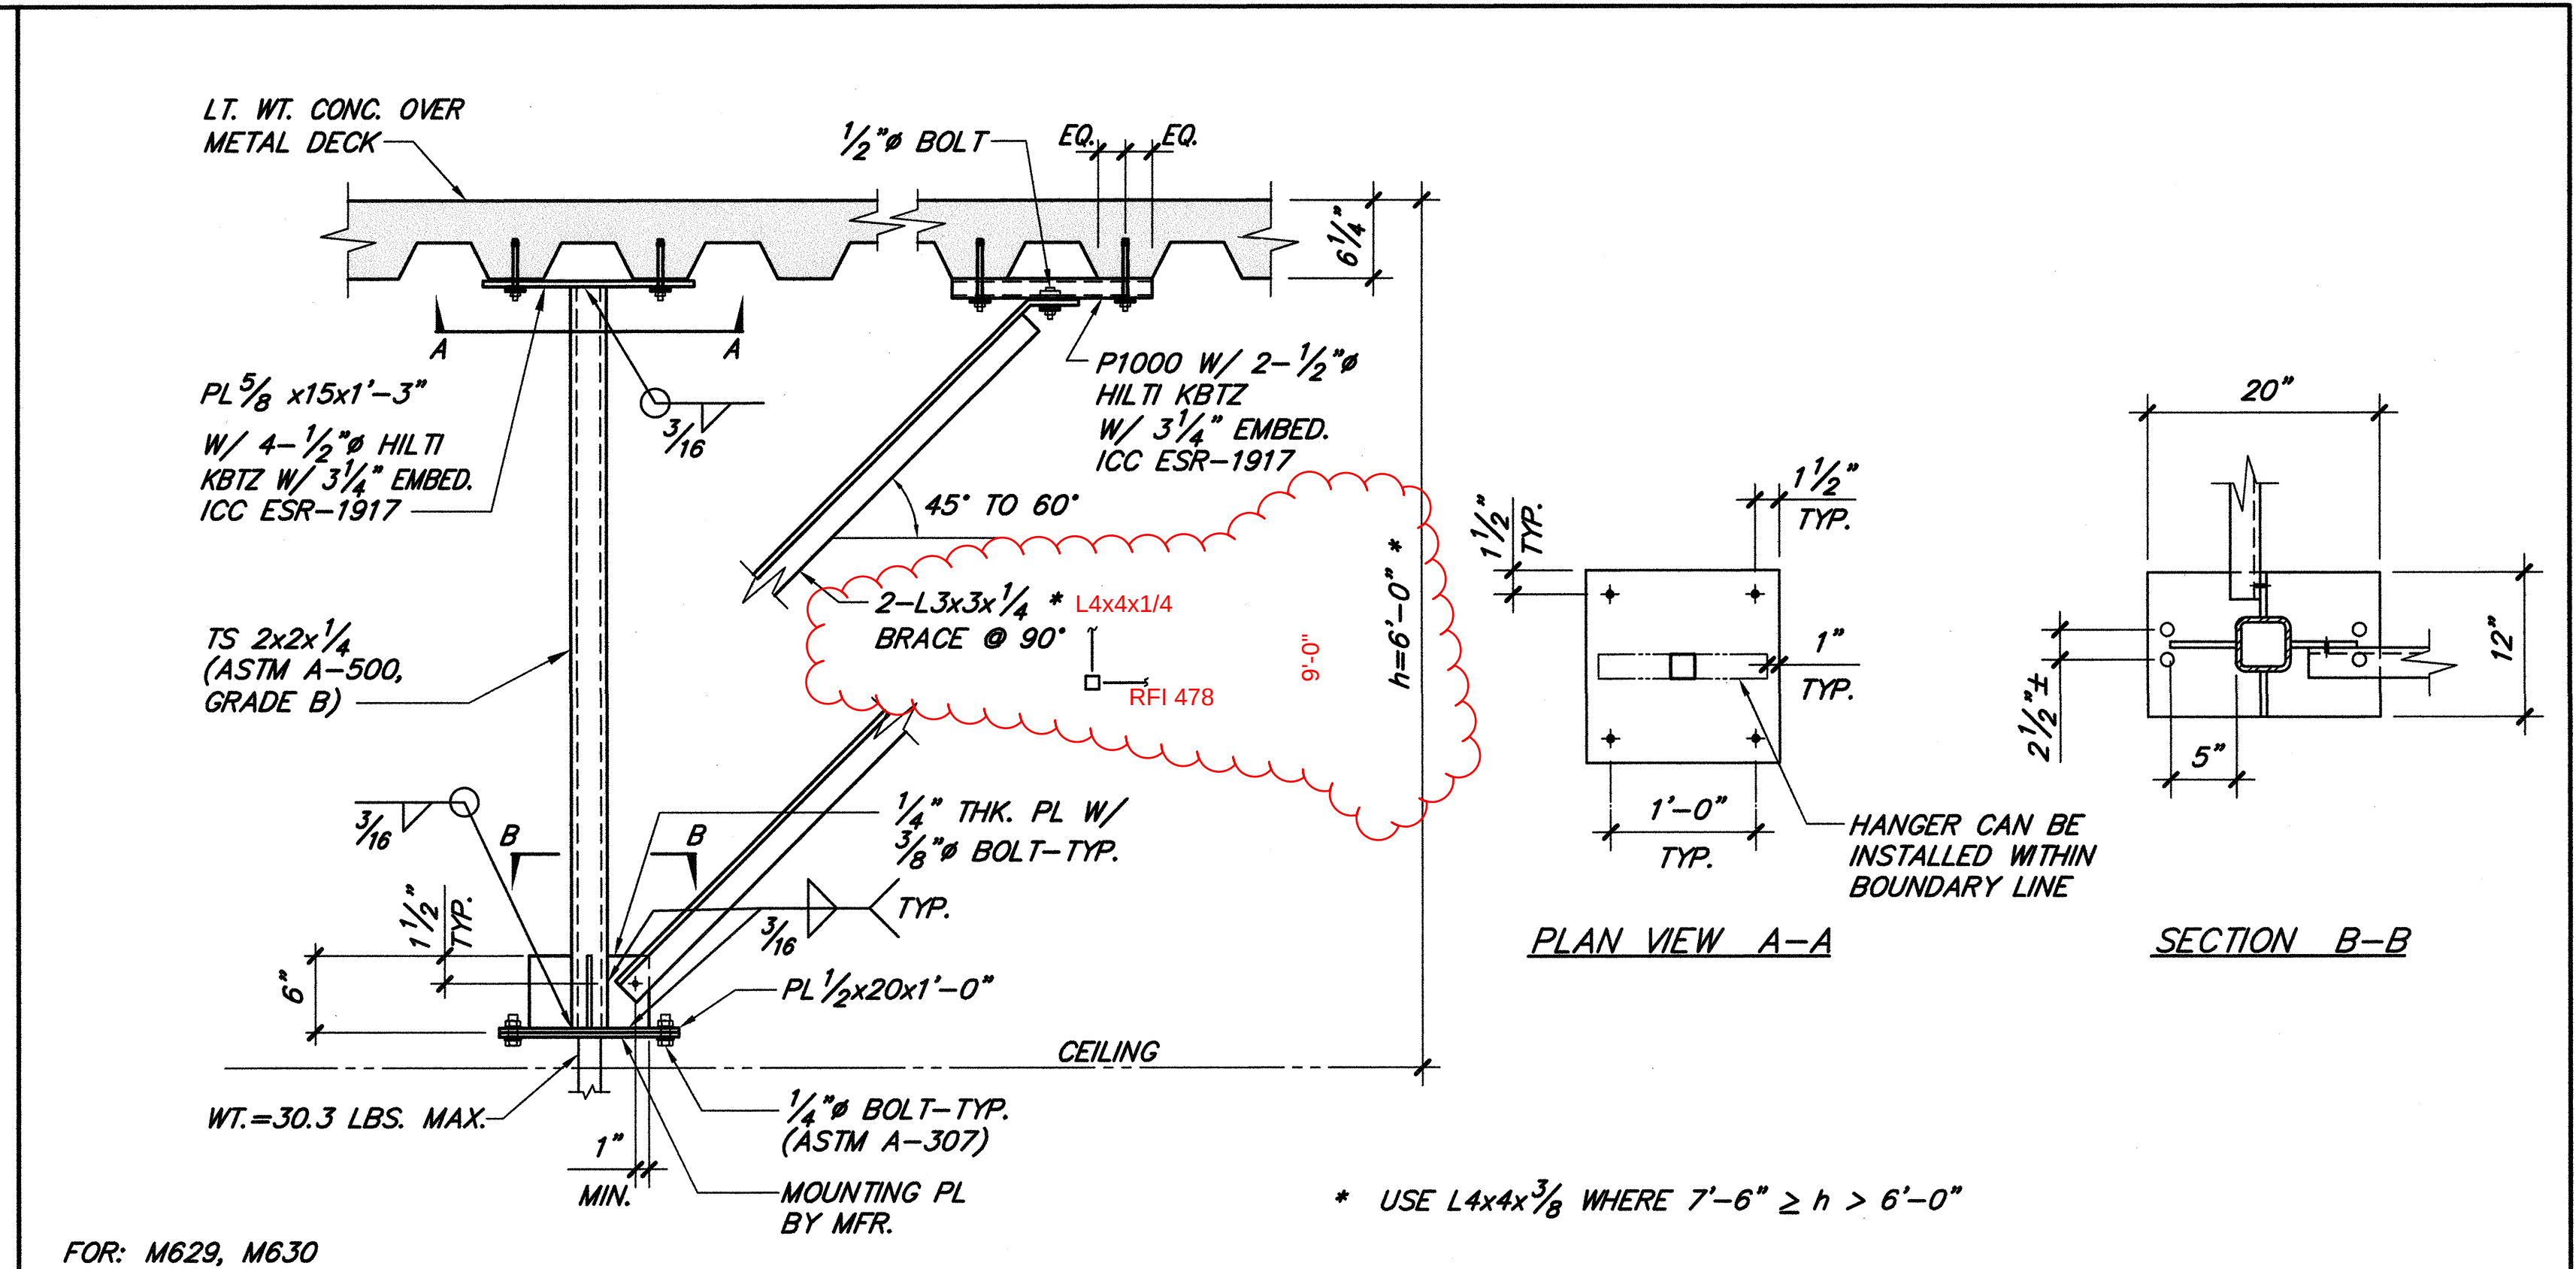


CEILING MOUNTED PLC SUPPORT

NONE D1

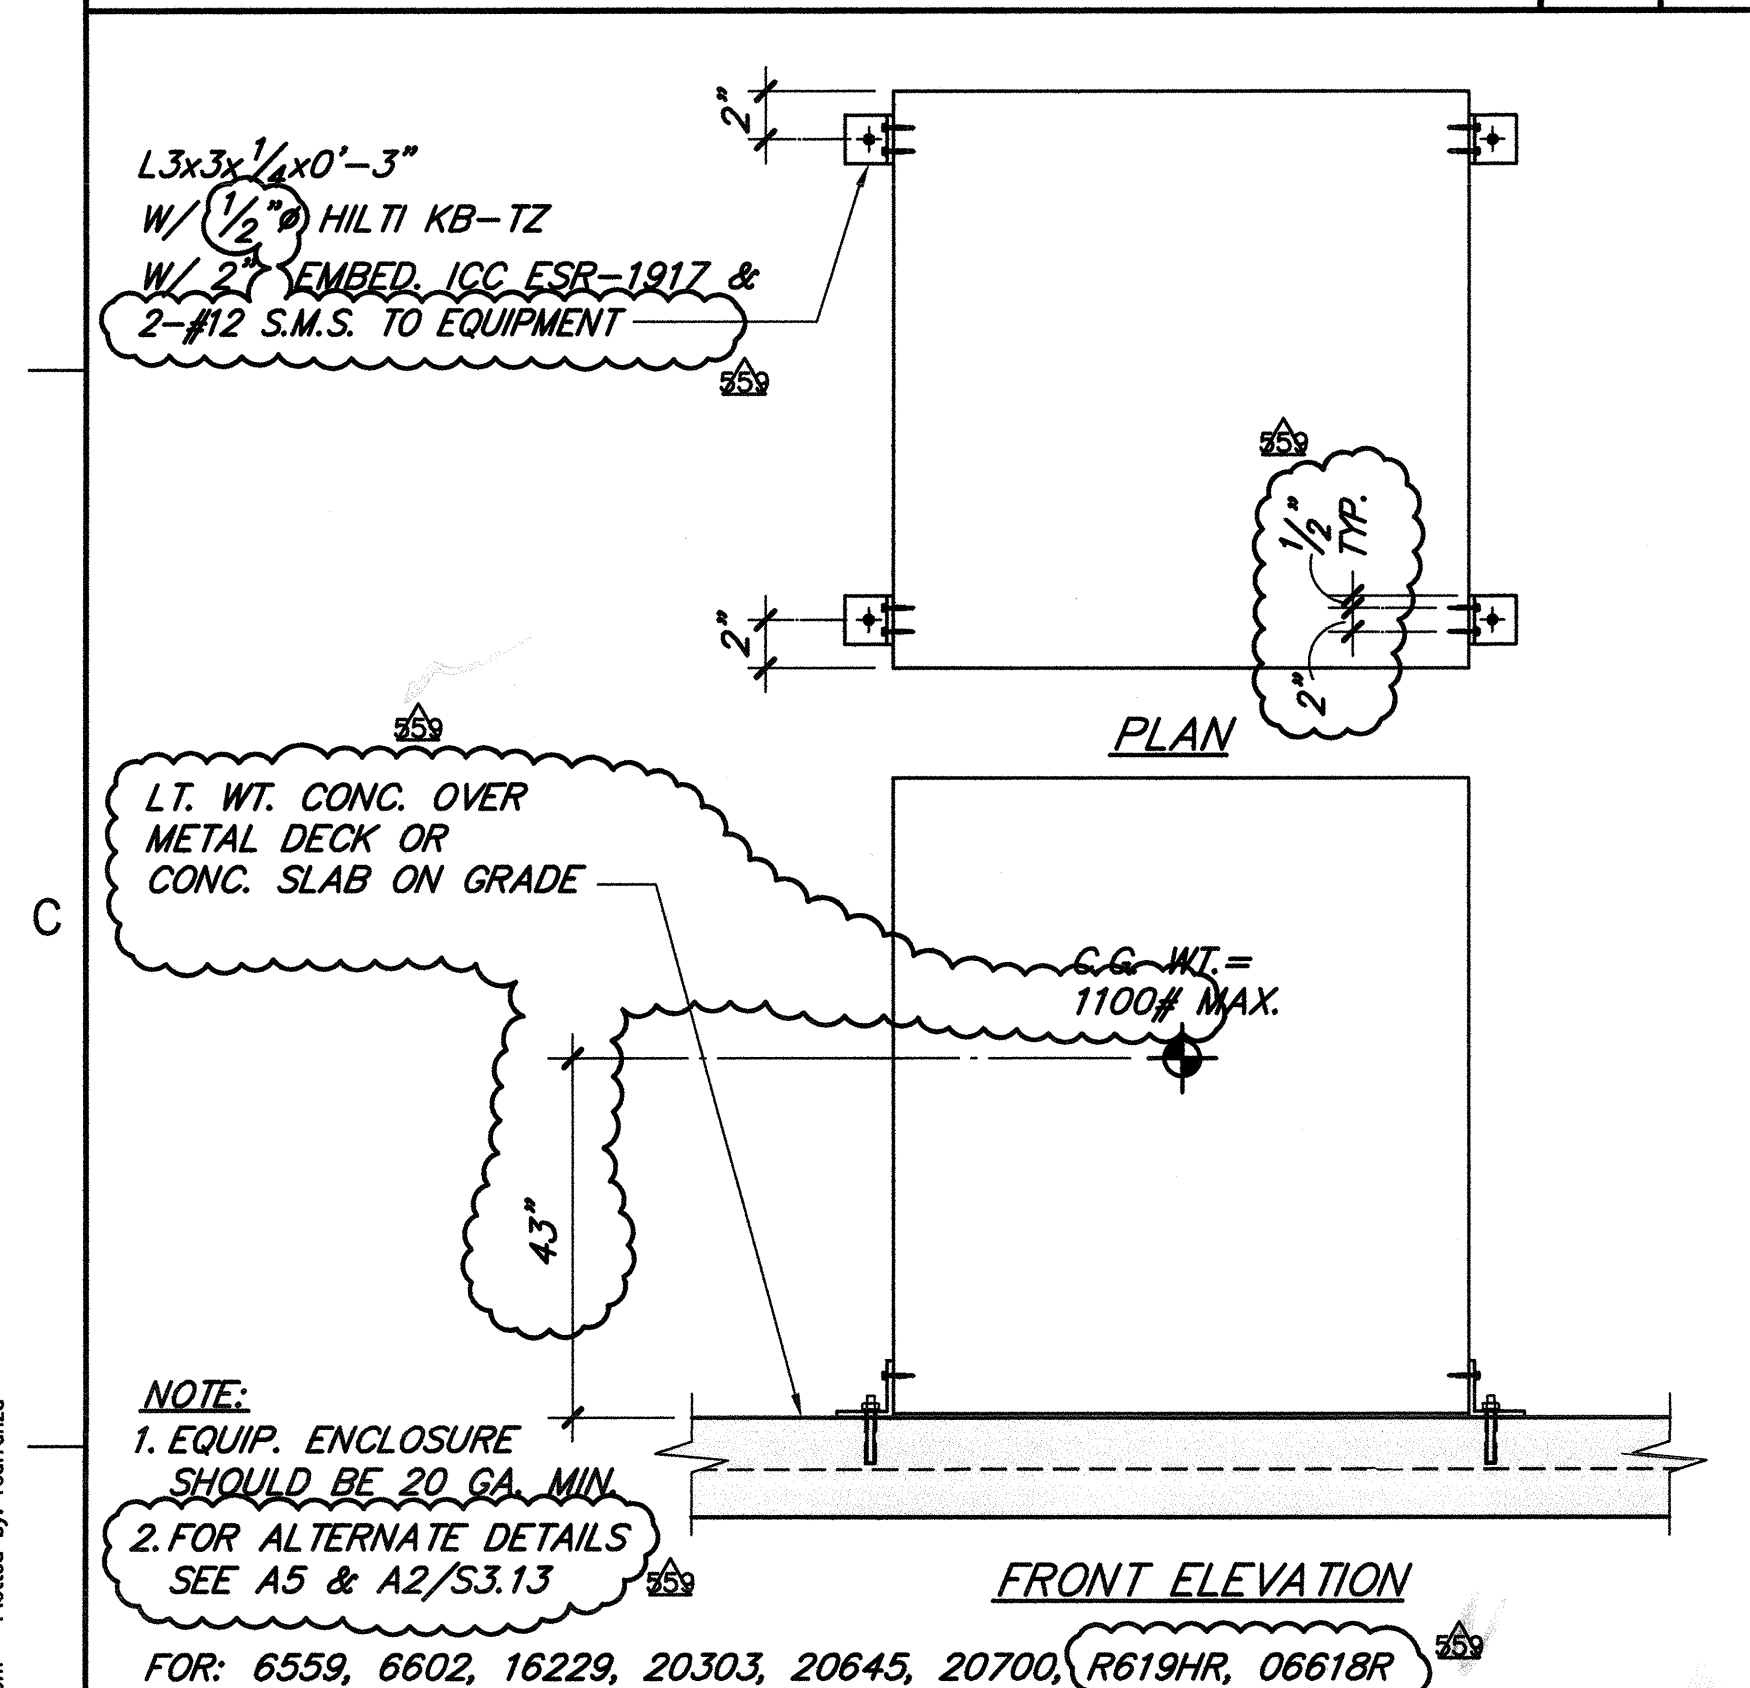


REFRIGERATOR ANCHORAGE DETAIL

NONE B5

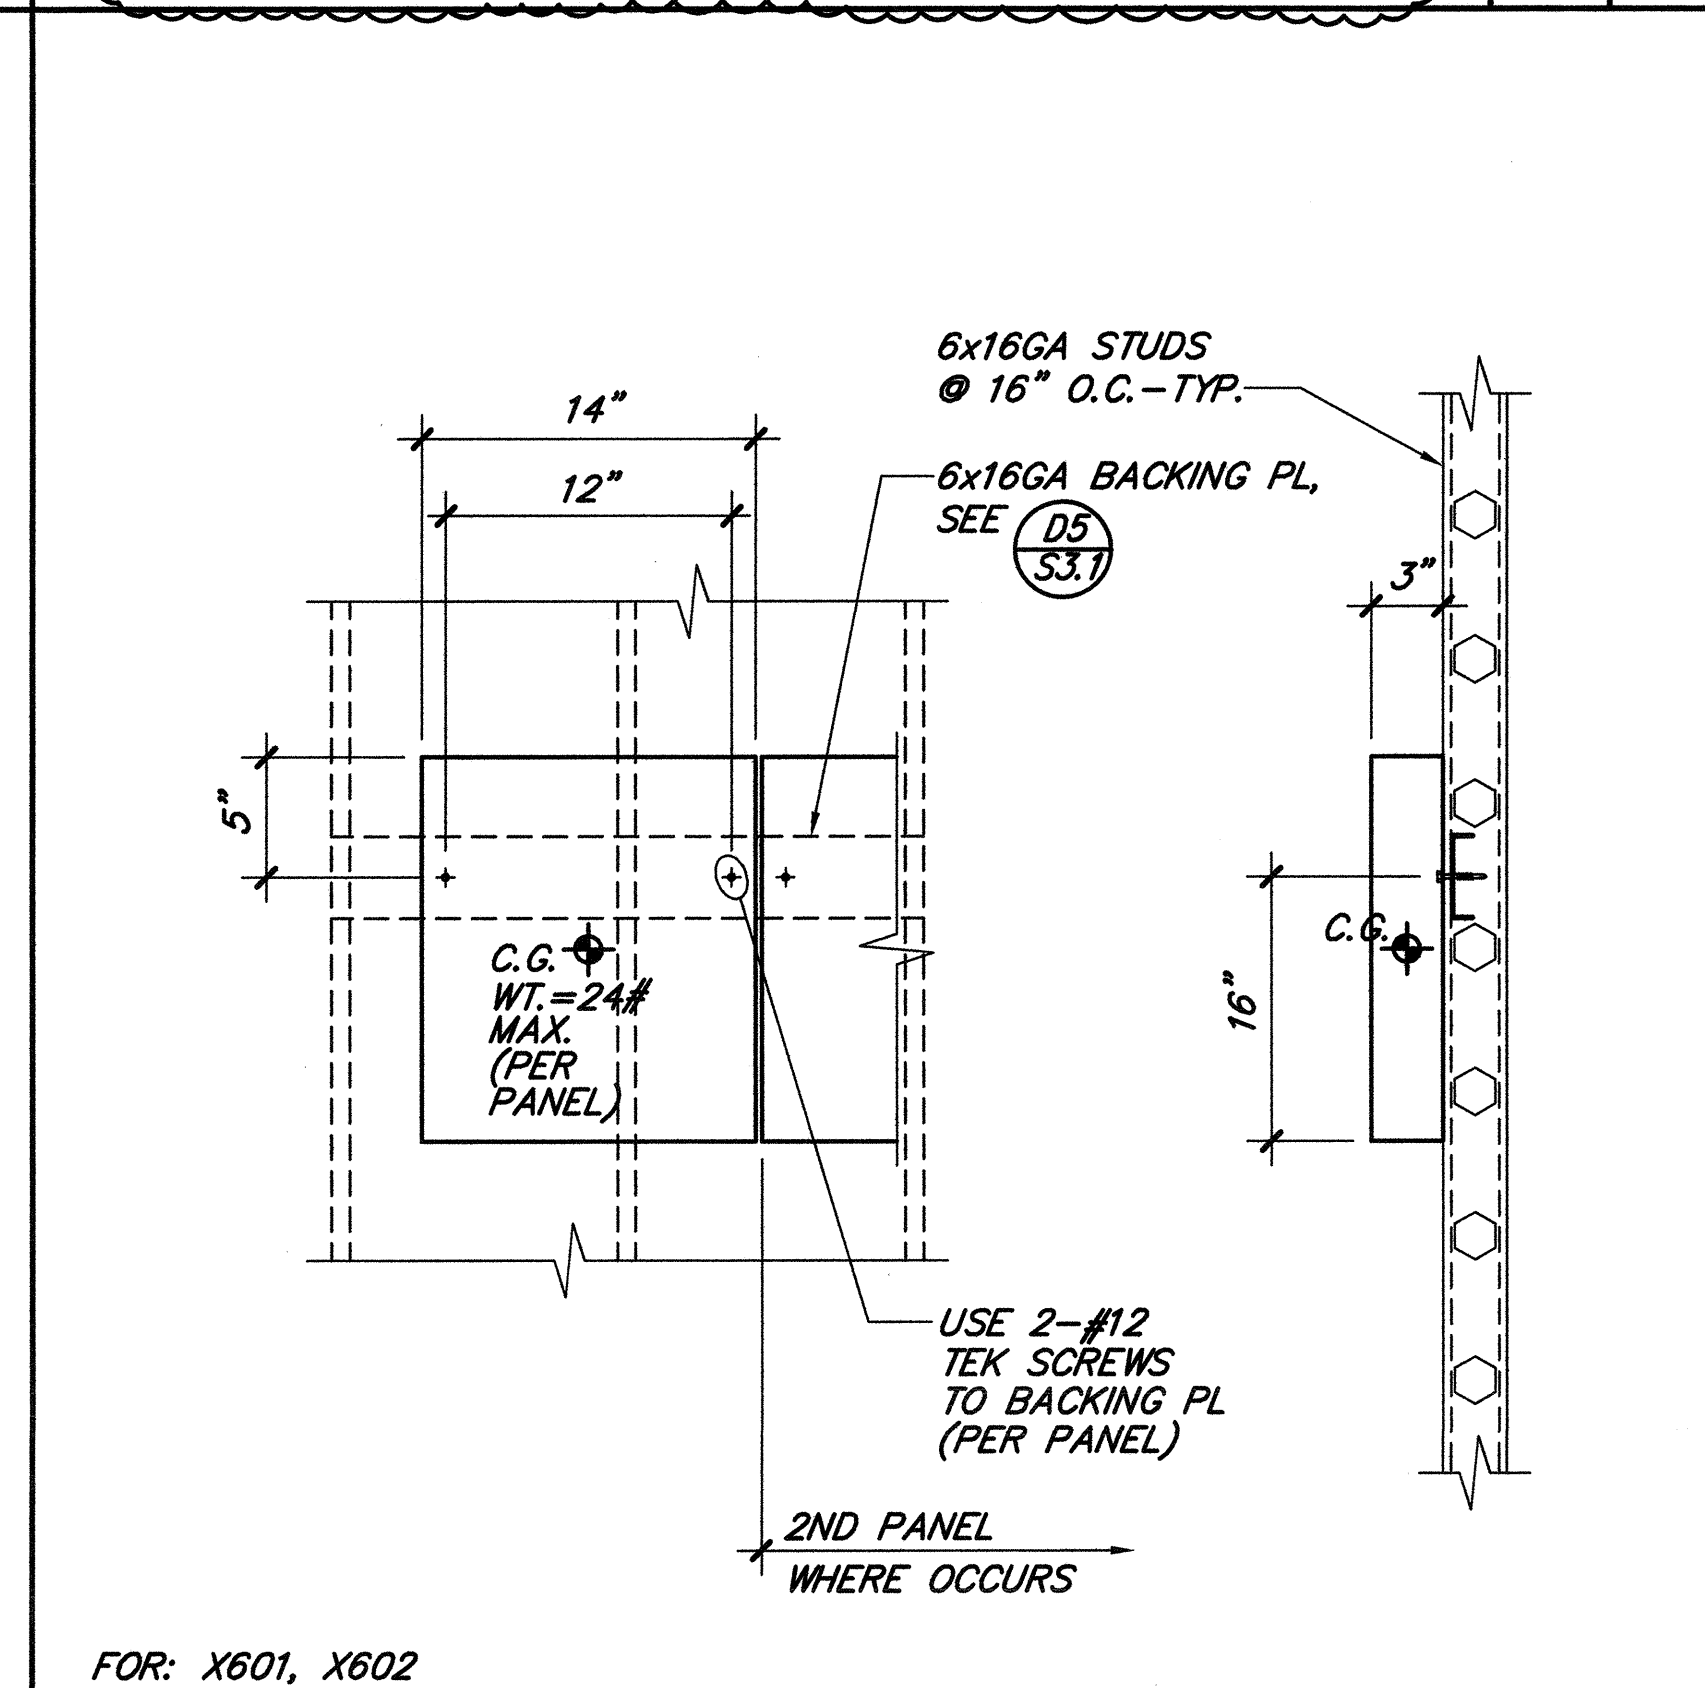


SINGLE OR DOUBLE PANEL ILLUMINATOR ANCH.

NONE B4

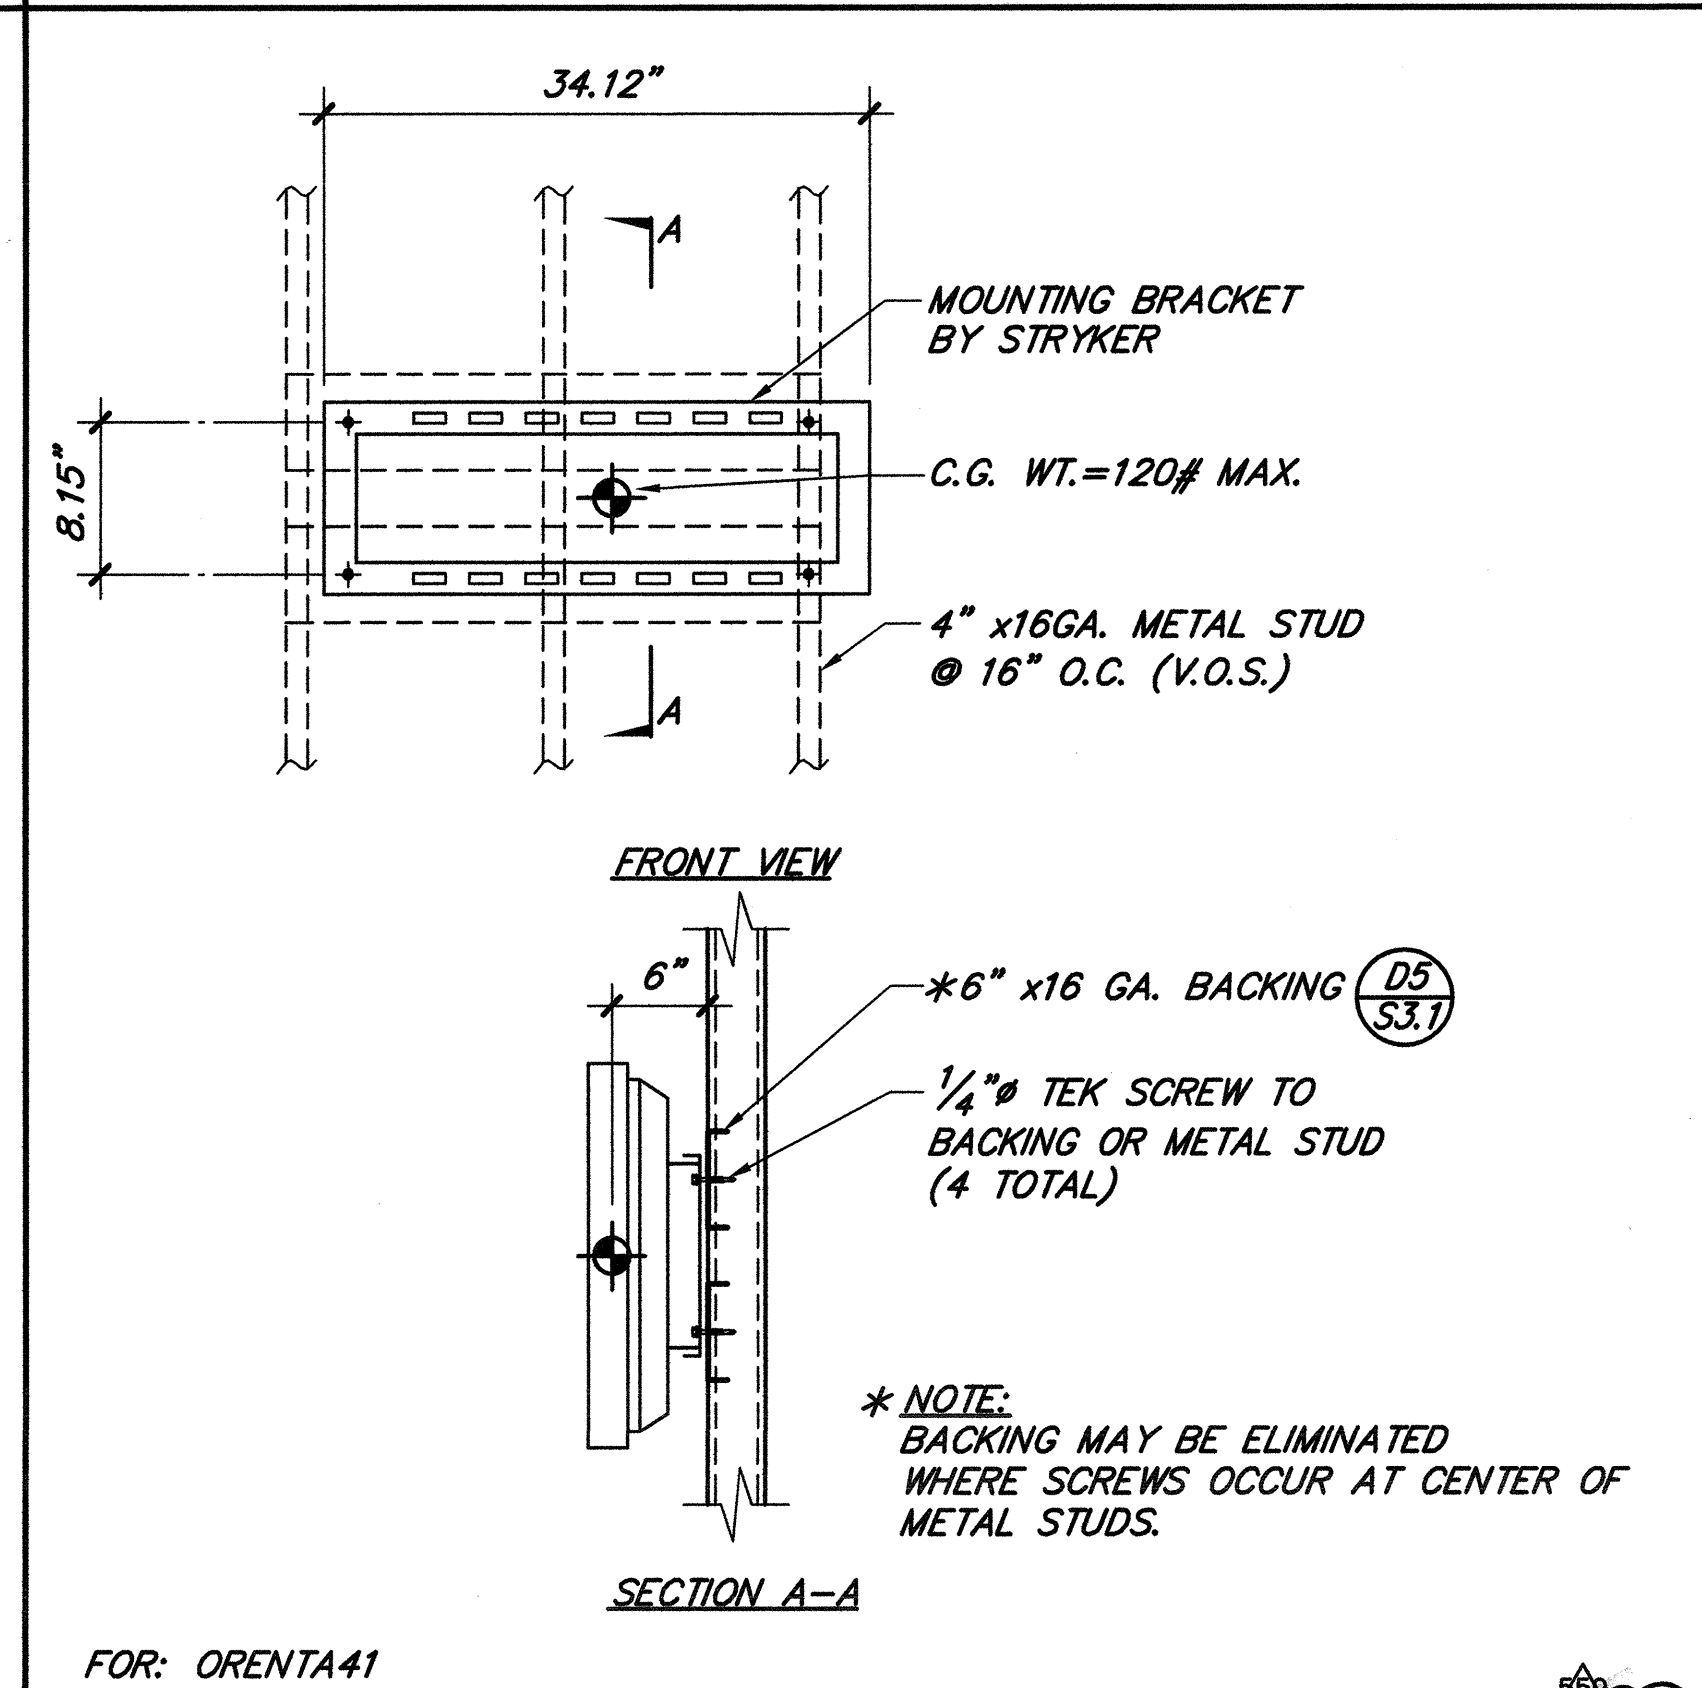


BRACKET, MONITOR, FLAT PANEL ANCHORAGE

1" B2

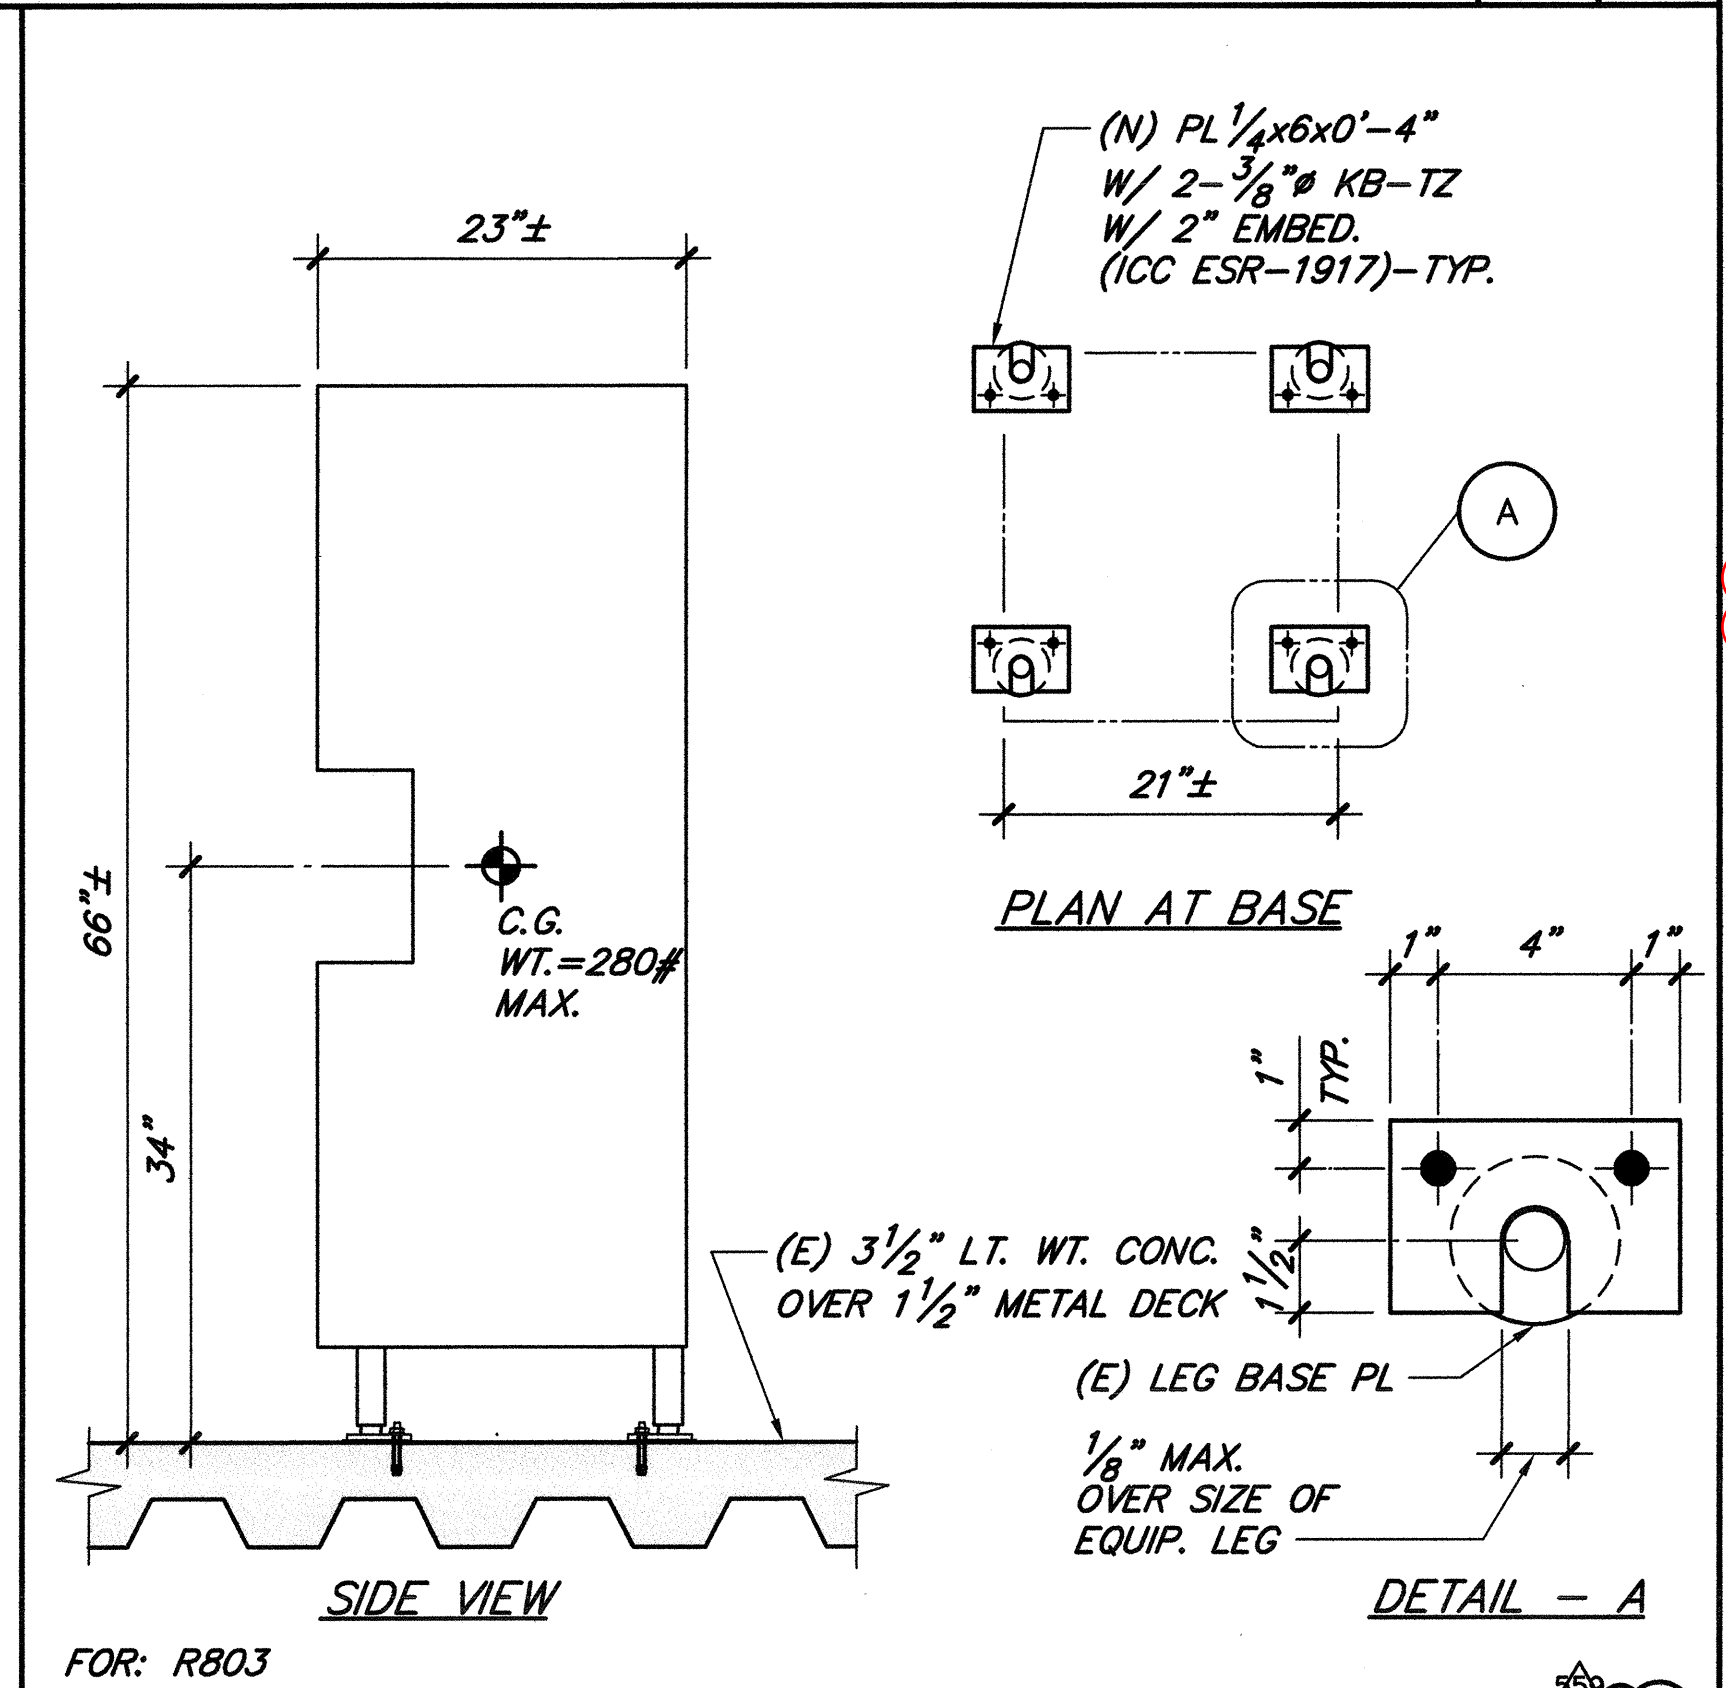


ICE MAKER ANCHORAGE

NONE B1

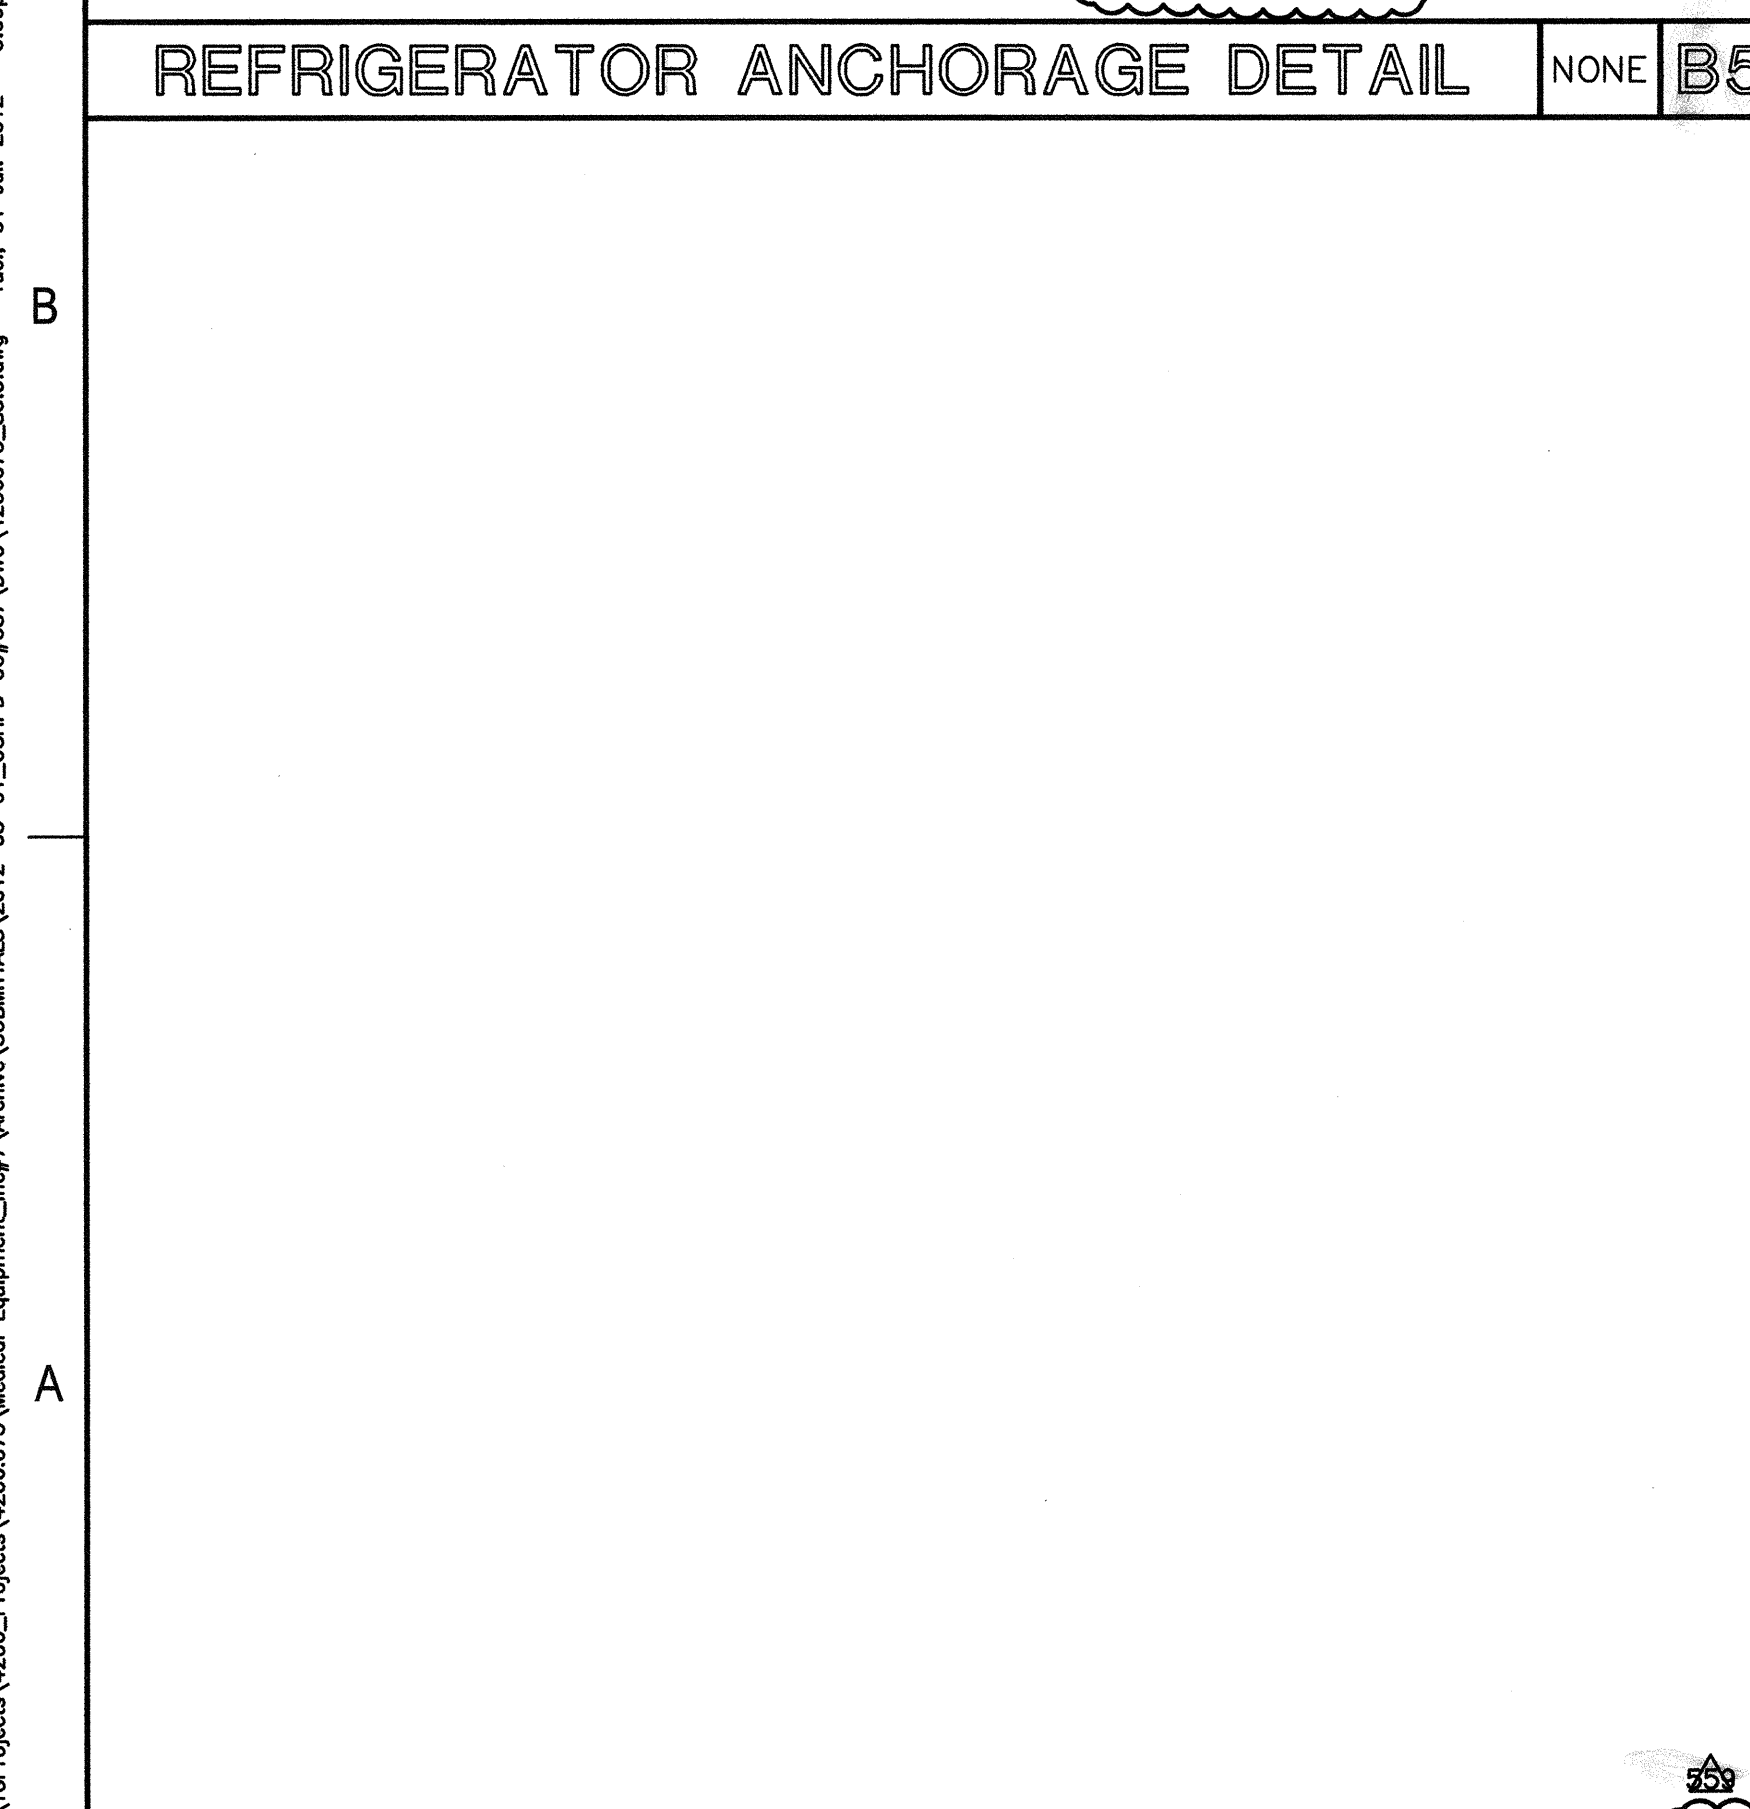


NOT USED

- A5

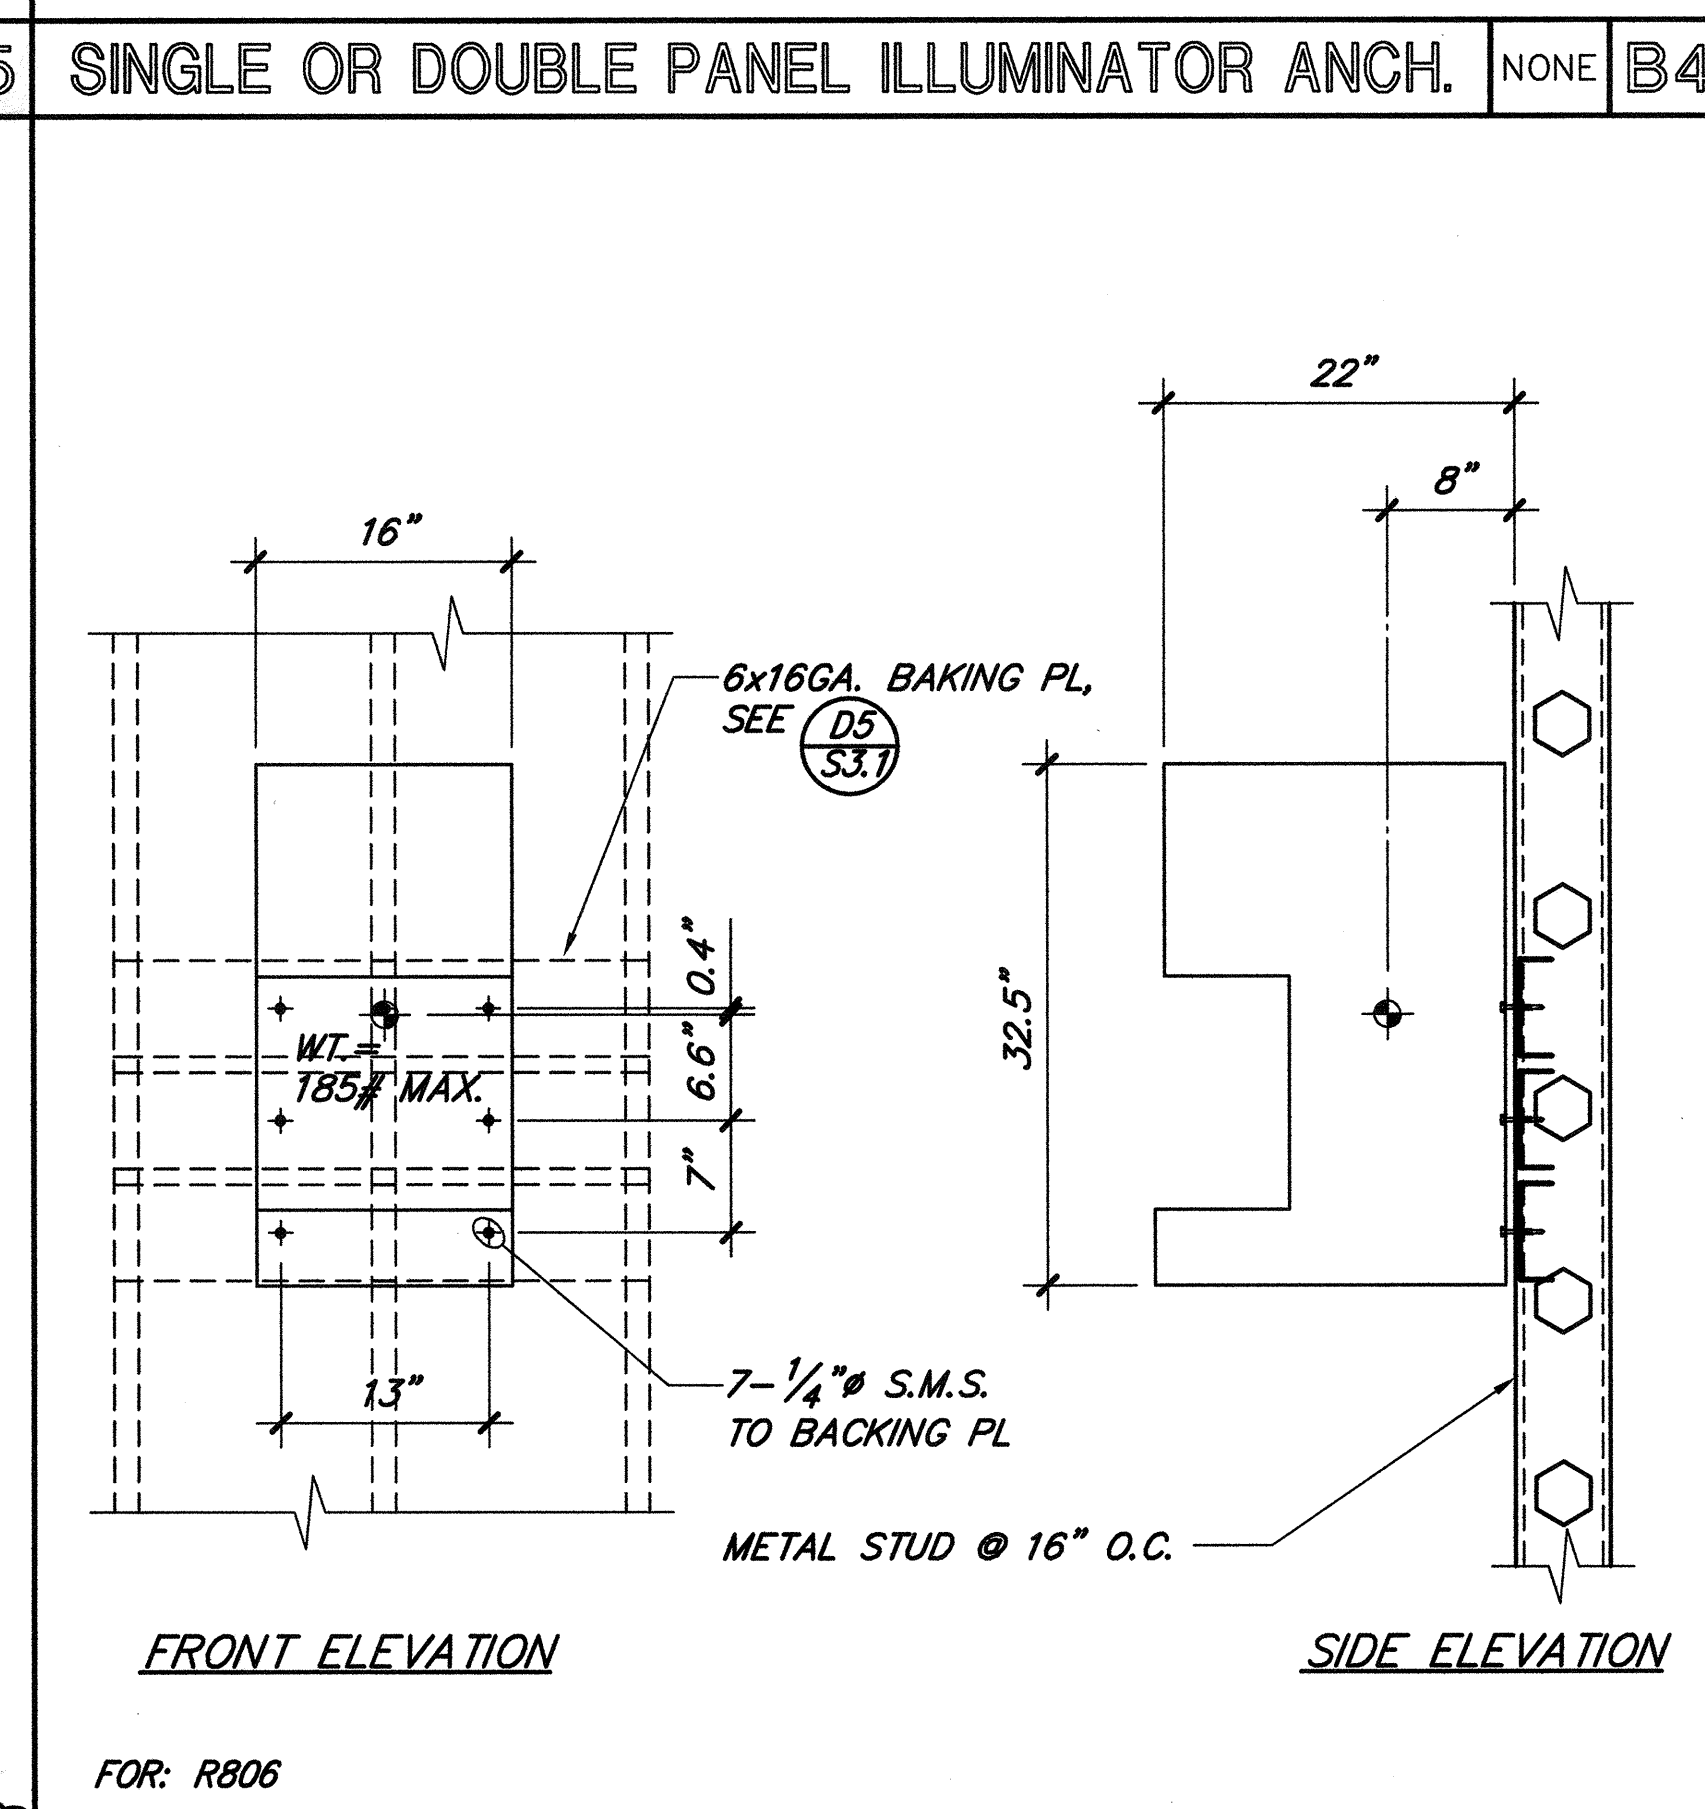

CABINET STORAGE ANCHORAGE DET.

NONE A2

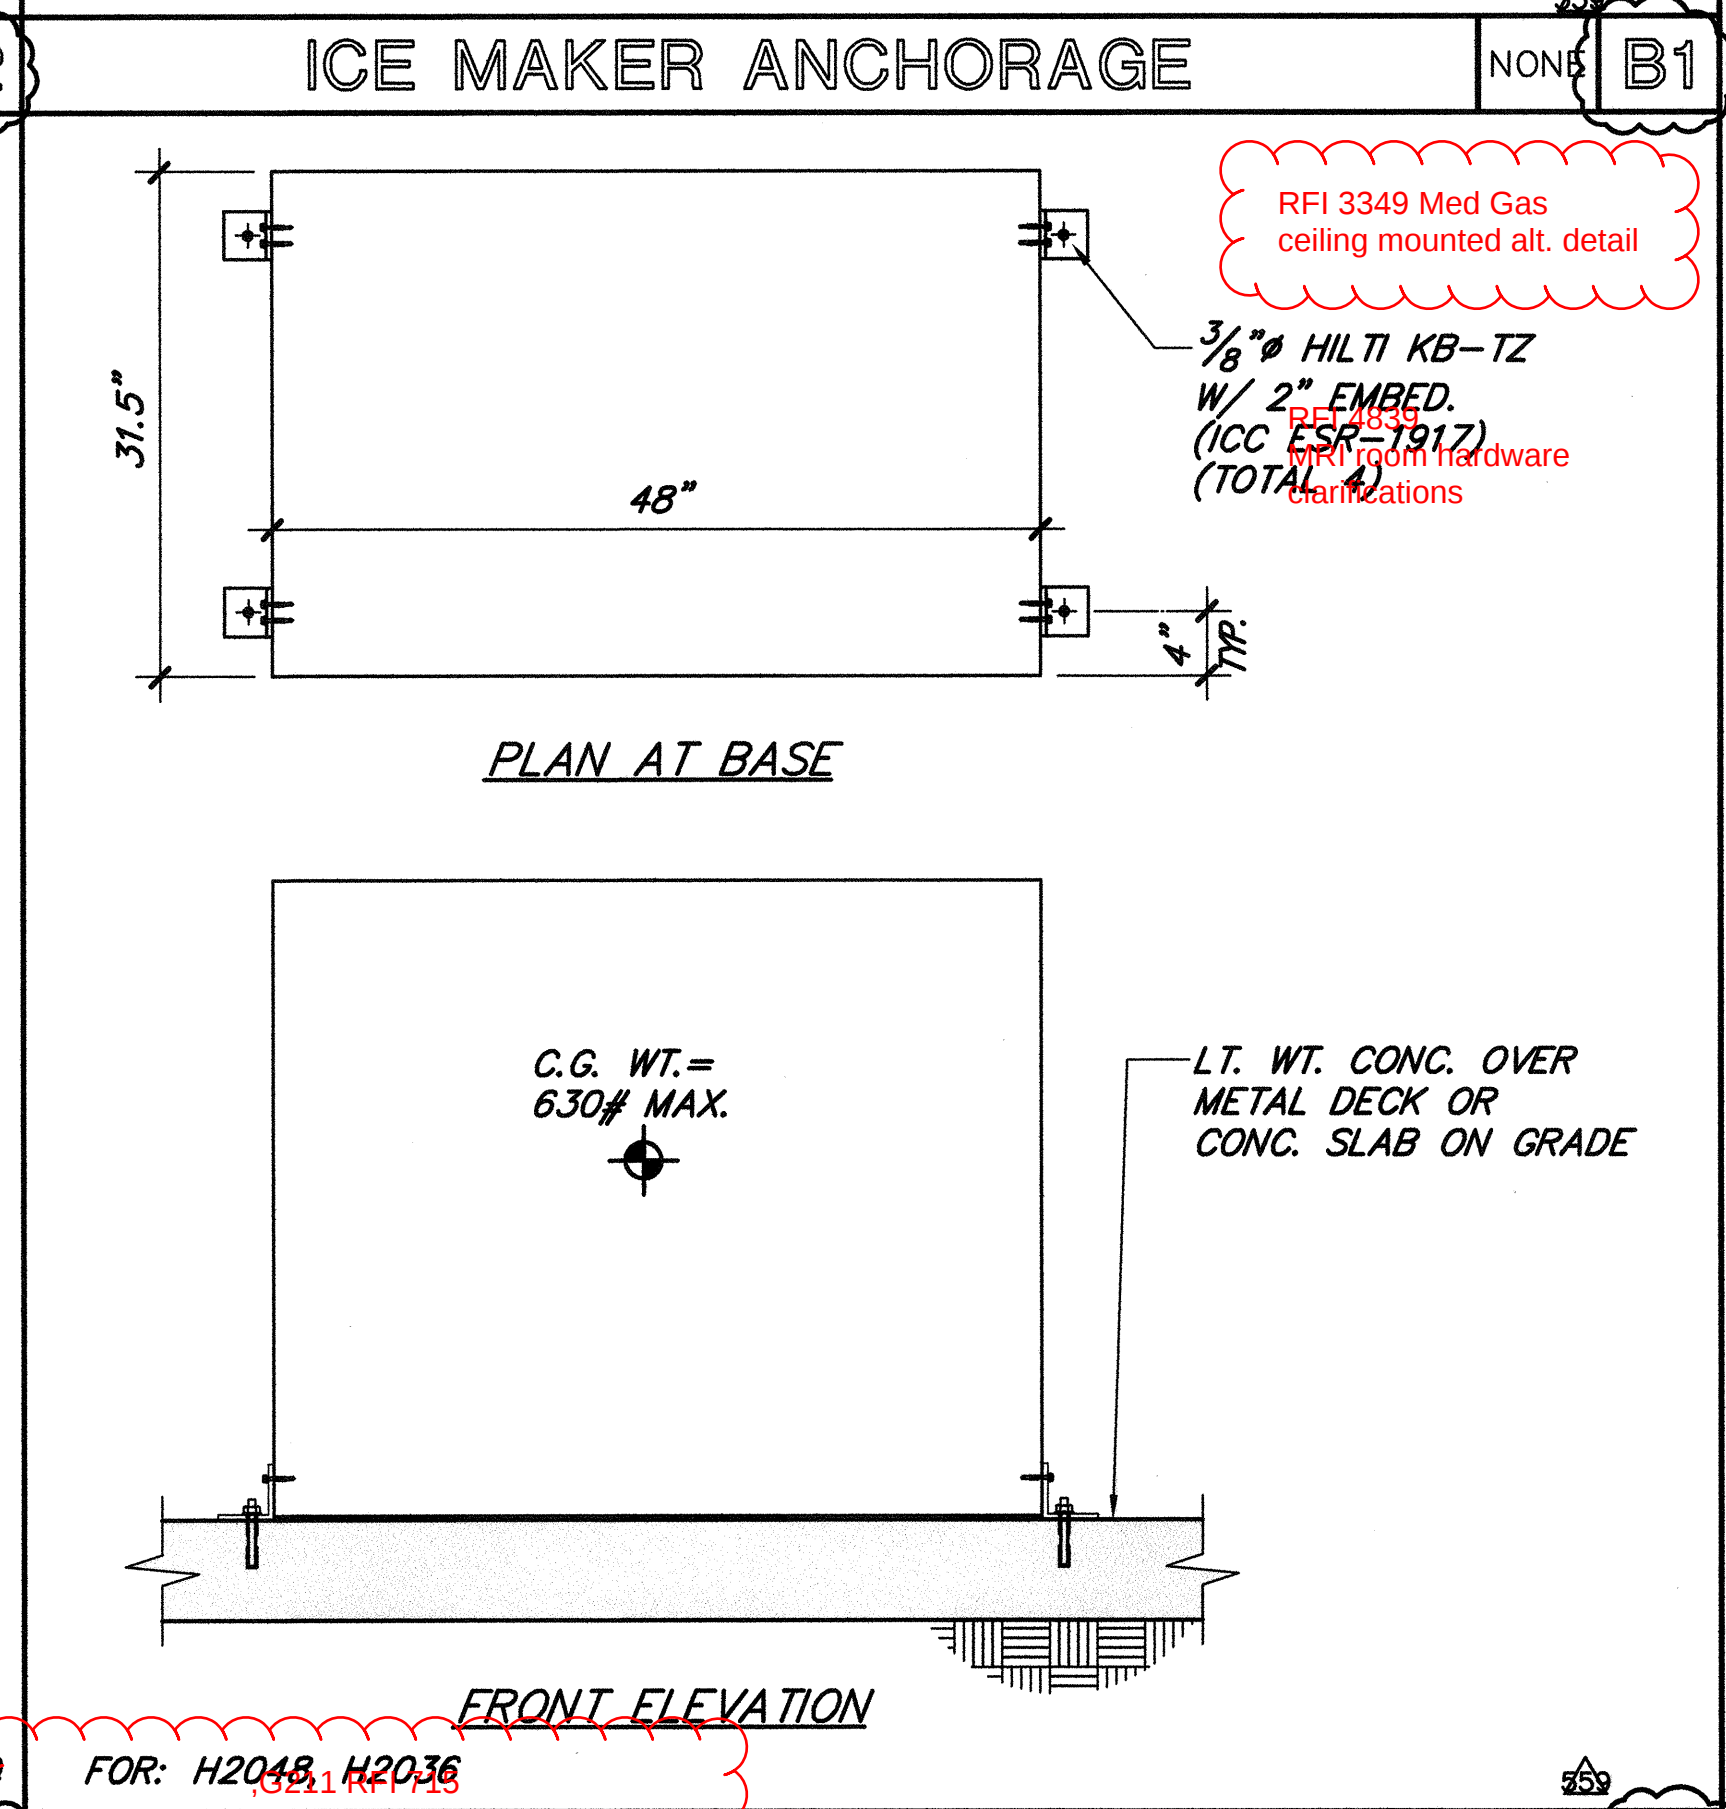

FUME HOOD LABORATORY

NONE A1

**FKP Architects**  
ARCHITECT OF RECORD

\*Architect of Record signature line only; this drawing was not prepared under the direct supervision of the Architect of Record. The direct responsibility for preparation of this sheet lies with its corresponding professional stamp and signature. The signature of the Architect of Record in general represents the signature of the project as provided as required by Title 24, Part 9, Section 7-115 (a).

ARCHITECT - PAUL C. GLORIO

Changes on these drawings do not consist of materially altered changes to approved drawings and don't require a change order.  
OSHPD review ACO  
OSHPD review FLSO  
OSHPD review DSE

CONSULTANT  
T M A D  
TAYLOR & GAINES  
STRUCTURAL  
MECHANICAL  
ELECTRICAL  
CIVIL

320 North Halstead Street, Suite 200  
Pasadena, California 91107  
Phone: 626.351.8881  
Fax: 626.351.5319  
Project No. 4206.075

REVISIONS  
Refer to sheet S0 for revisions not noted

| DATE       | REVISION                |
|------------|-------------------------|
| 02/05/2010 | INFORMATION BULLETIN #6 |
| 09/29/10   | OSHPD Change Order 82   |
| 09/05/11   | OSHPD Change Order 281  |
| 09/26/11   | OSHPD Change Order 282  |
| 10/12/11   | OSHPD Change Order 283  |
| 01/04/12   | OSHPD Change Order 271  |
| 05/30/12   | OSHPD Change Order 384  |
| 08/01/12   | OSHPD Change Order 381  |
| 08/01/12   | OSHPD Change Order 387  |

APPROVAL

PAID 2012-07236  
REVIEWED IN ACCORDANCE WITH THE REQUIREMENTS OF TOL CCR APPROVED  
8-1-12  
Date  
Office of Statewide Health Planning & Development  
REGULATORY DEVELOPMENT DIVISION

PROJECT NAME  
**CHILDREN'S HOSPITAL OF ORANGE COUNTY**  
455 S. Main St.  
Orange, CA 92668-3874

TOWER II

**CHOC**  
HOSPITAL

PROJECT NUMBER  
12011.00  
Increment #7

OSHPD - PROJECT NUMBER  
IL 072072-30

ISSUE  
OSHPD Permit

DATE  
01/28/2010

SCALE  
AS NOTED

DRAWING TITLE  
**MEDICAL EQUIPMENT ANCHORAGE DETAILS**

DRAWING NUMBER  
S3.5