

FKP Architects

ARCHITECT OF RECORD

Architect of Record signature line only, this drawing was not prepared under the direct supervision of the Architect of Record. The direct responsibility for preparation of this sheet lies with its corresponding professional stamp and signature. The signature of the Architect of Record in general responsible change of the project is provided as required by Title 24, Part 2, Section 7-115 (a).

ARCHITECT - PAUL C. GLORIO

CONSULTANT

T M A D  
TAYLOR  
& GAINES

• STRUCTURAL  
• MECHANICAL  
• ELECTRICAL  
• CIVIL

100 South Anaheim Boulevard, Suite 150  
Anaheim, California 92805  
Phone: 714.490.5555 Fax: 714.490.5550  
Project No. 2305-163-07




Changes on these drawings do not consist of materially altering changes to approved drawings and don't require a change order.  
OSHPD review ACO  
OSHPD review FLSD  
OSHPD review DSE

REVISIONS

04/15/2011 CHANGE ORDER #135

APPROVAL

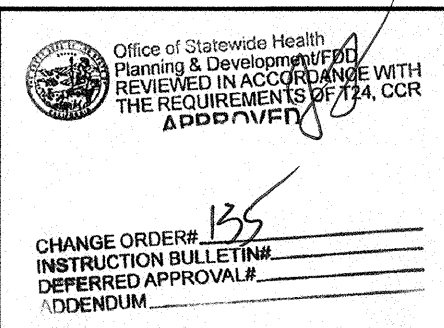

PROJECT NAME

CHILDREN'S HOSPITAL  
OF ORANGE COUNTY  
455 S. Main St.  
Orange, CA 92868-3874

RECEIVED  
SEPT. 21 2011  
McCARTHY



PROJECT NUMBER

12011.00  
Increment #7

OSHPD - PROJECT NUMBER

IL 072072-30

ISSUE

OSHPD PERMIT

DATE

01/27/2010

SCALE

DRAWING TITLE

LEVEL 5 - MECHANICAL  
DEMOLITION PLAN  
AREA - P


DRAWING NUMBER

M2.5P

DESIGN KEY NOTES

EXISTING NOT IN CONTRACT  
EXISTING TO REMAIN  
DEMOLISH

LEGEND

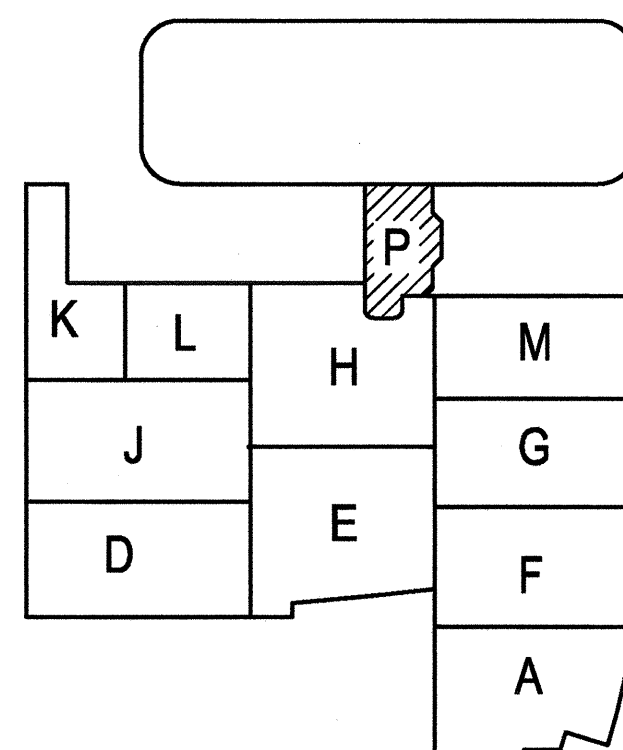

KEY PLAN

DEMOLITION - LEVEL 5

SCALE  
1/4"=1'-0"

E

D

C

B

A

6

5

4

3

2

1