



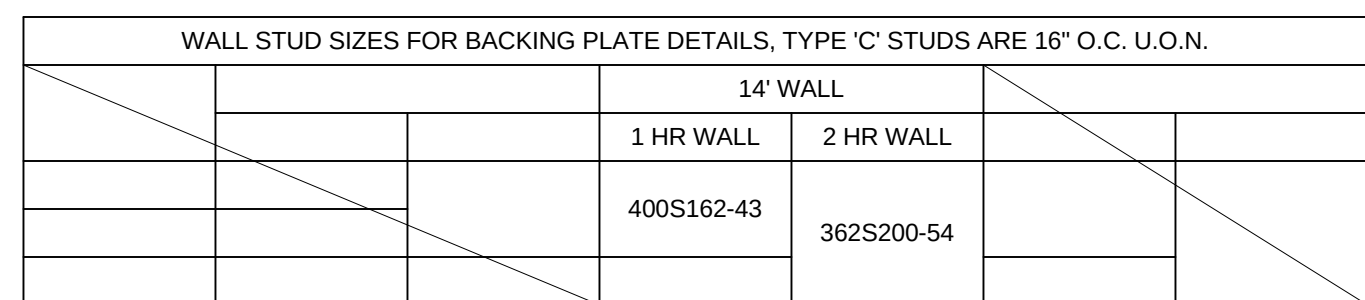


SCALE	N.T.S.	CODE	2012 IBC
NUMBER	092216-59C-GS	SPEC	1.00 < Sds <= 1.50
DATE	05/27/14		

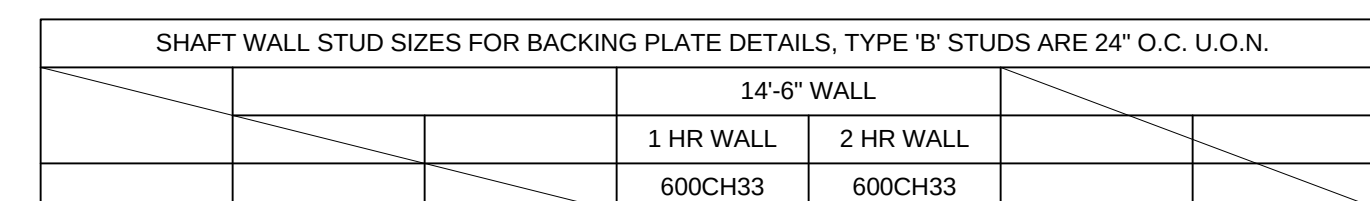


WALL STUD SIZES FOR BACKING PLATE DETAILS, TYPE 'B' STUDS ARE 16" O.C. U.O.N.				
		14" WALL		
		1 HR WALL	2 HR WALL	
		400S162-43	362S162-43	

2	SCALE	N.T.S.	CODE	2012 IBC
	NUMBER	092216-56C-GS	SPEC	1.00 < Sds <= 1.50
	DATE	05/27/14		

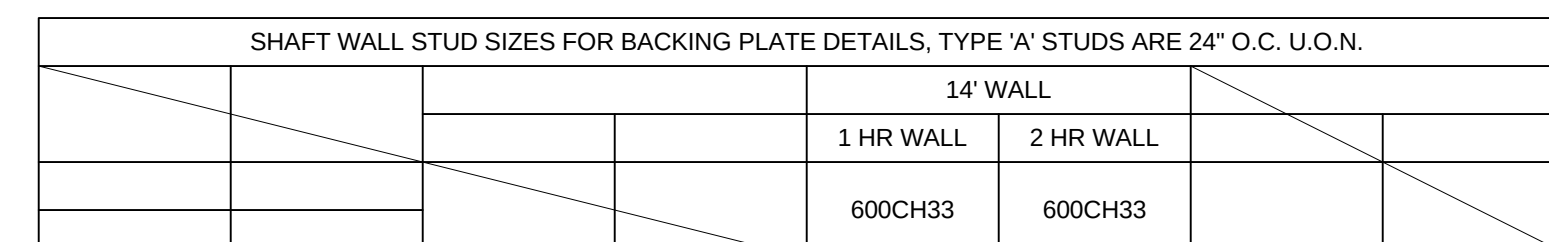[illegible]

SCALE	3"=1'-0"	CODE	2012 IBC
NUMBER	092216-55C-GS	SPEC	1.00 < Sds <= 1.50
DATE	05/27/14		



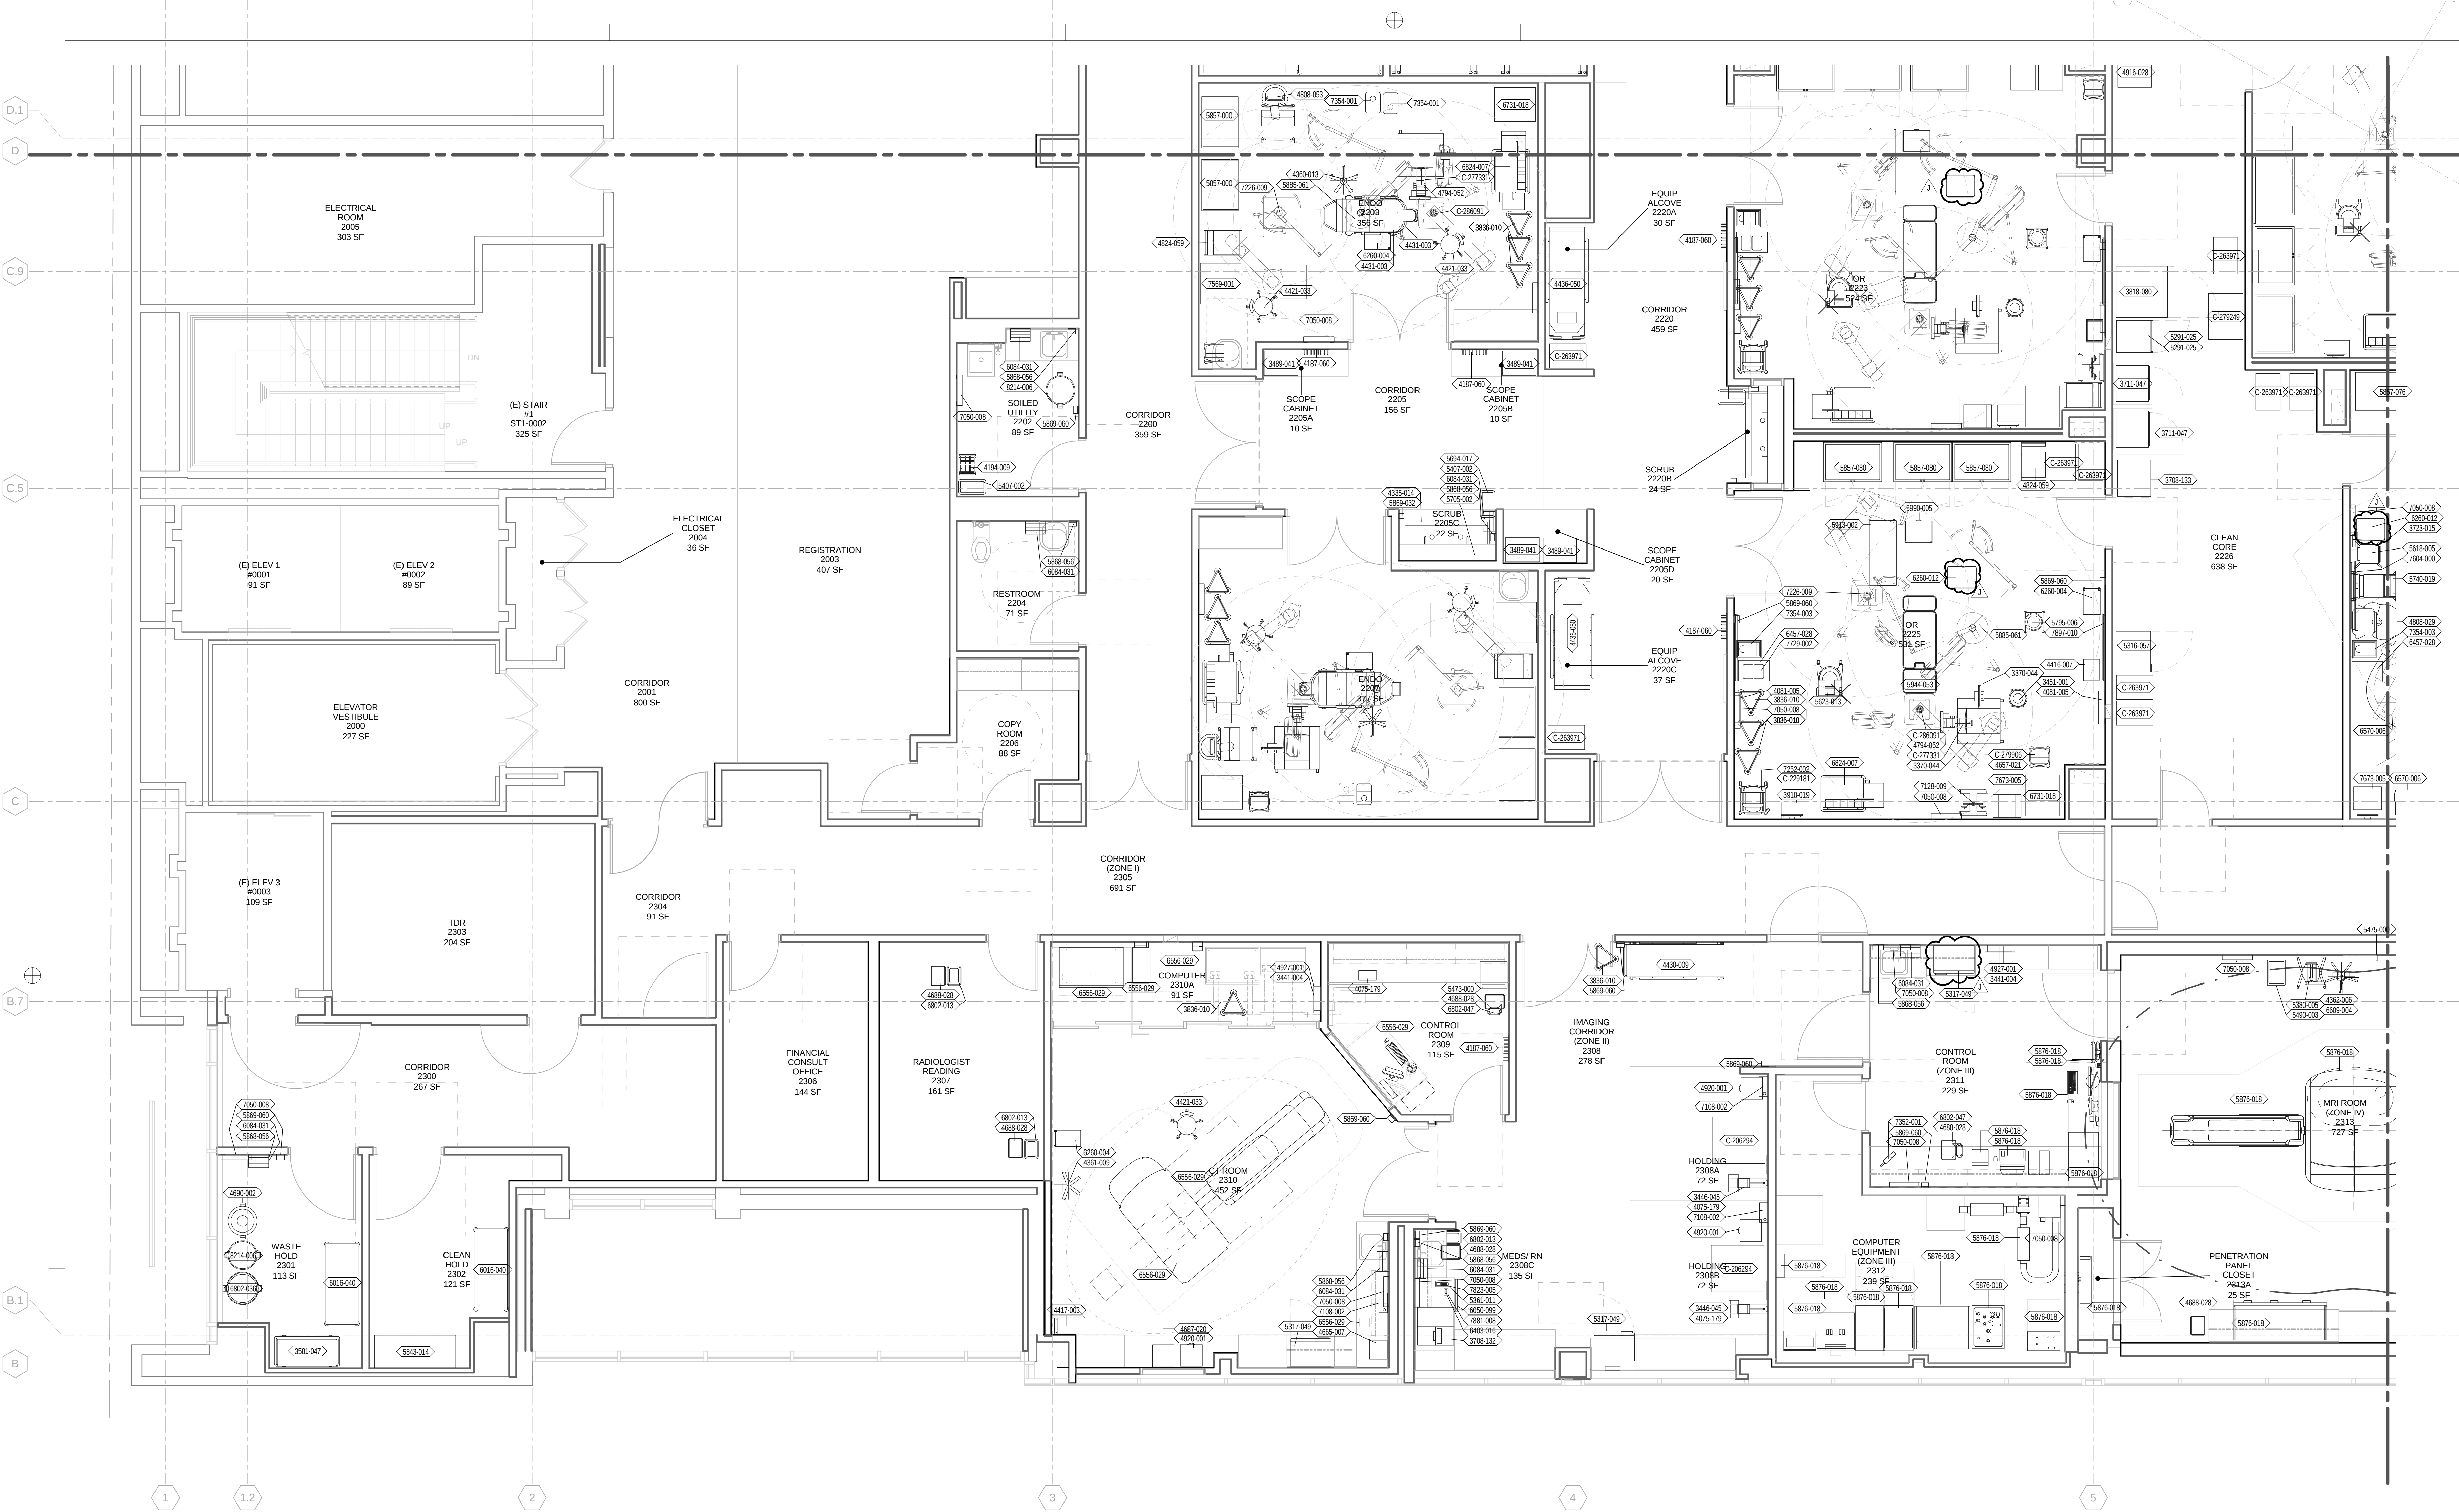

1 LEVEL 2 - SEGMENT PLAN - AREA B
1/4" = 1'-0"

KEY PLAN AND NORTH ARROW - CH. SHEET NOTES

KEY PLAN

RTKL
AN ARCADIS COMPANY

HENSEL PHELPS
Plan. Build. Manage.

K M D
ARCHITECTS
222 VALLEJO SAN FRANCISCO, CA 94133

NO.	REVISION	DATE	BY	CHK	APP
J	DP#2B - J GENERAL COORDINATION	2016/01/29			
B	DP#2B - B GENERAL COORDINATION	2016/01/29			
A	DP#2B - A GENERAL COORDINATION	2016/01/29			
	DESIGN DEVELOPMENT	2015/09/18			
	DP#2B - B GENERAL COORDINATION	2015/09/18			

CERTIFIED BY

EMERYVILLE - MOB

PLAN CHECK#
PROJECT NO.


DATE
2016/01/25

LEVEL 2 AREA B

EQ-102B

PLOT DATE: 1/29/2016 12:55:24 PM

COPYRIGHT © 2015 BY KMD ARCHITECTS. ALL RIGHTS RESERVED.

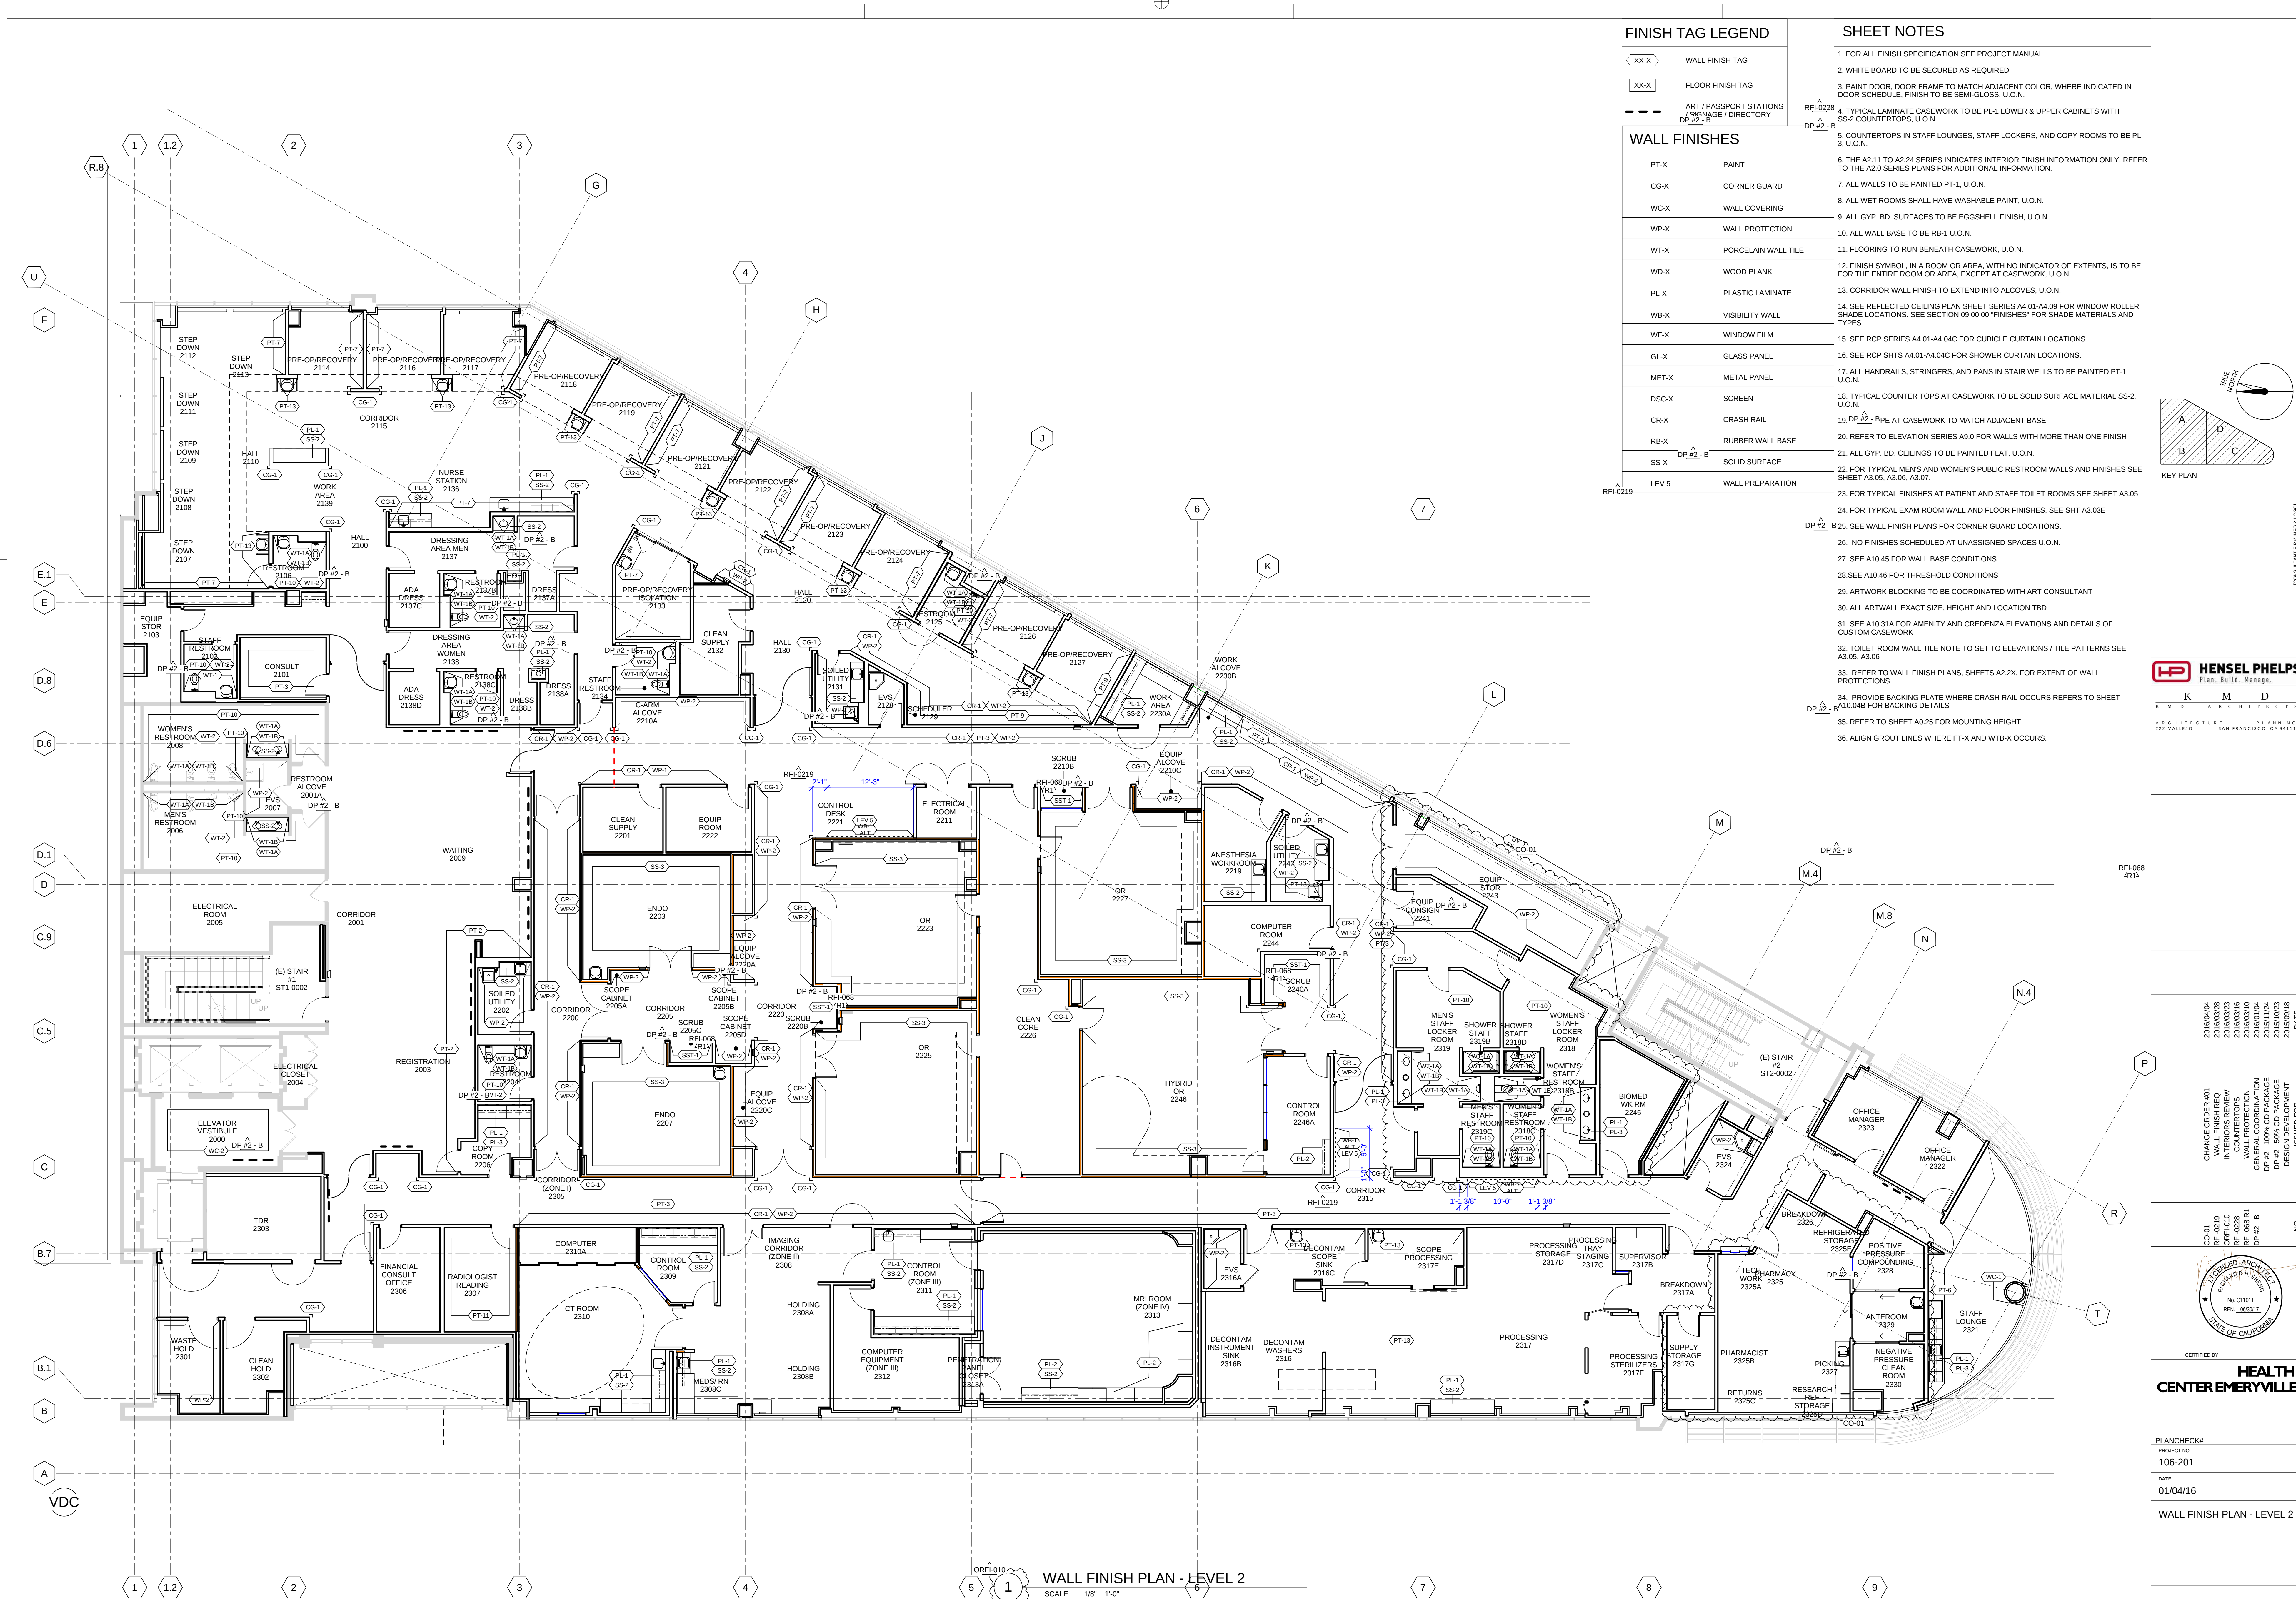

FINISH TAG LEGEND


XX-X	WALL FINISH TAG
XX-X	FLOOR FINISH TAG
---	ART / PASSPORT STATIONS ON IMAGE / DIRECTORY DP #2-B

WALL FINISHES

PT-X	PAINT
CG-X	CORNER GUARD
WC-X	WALL COVERING
WP-X	WALL PROTECTION
WT-X	PORCELAIN WALL TILE
WD-X	WOOD PLANK
PL-X	PLASTIC LAMINATE
WB-X	VISIBILITY WALL
WF-X	WINDOW FILM
GL-X	GLASS PANEL
MET-X	METAL PANEL
DSC-X	SCREEN
CR-X	CRASH RAIL
RB-X	RUBBER WALL BASE
SS-X	SOLID SURFACE
LEV 5	WALL PREPARATION

SHEET NOTES

- FOR ALL FINISH SPECIFICATION SEE PROJECT MANUAL
- WHITE BOARD TO BE SECURED AS REQUIRED
- PAINT DOOR, DOOR FRAME TO MATCH ADJACENT COLOR, WHERE INDICATED IN DOOR SCHEDULE, FINISH TO BE SEMI-GLOSS, U.O.N.
- TYPICAL LAMINATE CASEWORK TO BE PL-1 LOWER & UPPER CABINETS WITH SS-2 COUNTERTOPS, U.O.N.
- COUNTERTOPS IN STAFF LOUNGES, STAFF LOCKERS, AND COPY ROOMS TO BE PL-3, U.O.N.
- THE A2.11 TO A2.24 SERIES INDICATES INTERIOR FINISH INFORMATION ONLY. REFER TO THE A2.0 SERIES PLANS FOR ADDITIONAL INFORMATION.
- ALL WALLS TO BE PAINTED PT-1, U.O.N.
- ALL WET ROOMS SHALL HAVE WASHABLE PAINT, U.O.N.
- ALL GYP. BD. SURFACES TO BE EGGSHELL FINISH, U.O.N.
- ALL WALL BASE TO BE RB-1 U.O.N.
- FLOORING TO RUN BENEATH CASEWORK, U.O.N.
- FINISH SYMBOL IN A ROOM OR AREA, WITH NO INDICATOR OF EXTENTS, IS TO BE FOR THE ENTIRE ROOM OR AREA, EXCEPT AT CASEWORK, U.O.N.
- CORRIDOR WALL FINISH TO EXTEND INTO ALCOVES, U.O.N.
- SEE REFLECTED CEILING PLAN SHEET SERIES A4.01-A4.09 FOR WINDOW ROLLER SHADE LOCATIONS. SEE SECTION 09.00.00 "FINISHES" FOR SHADE MATERIALS AND TYPES
- SEE RCP SERIES A4.01-A4.04C FOR CURBICLE CURTAIN LOCATIONS.
- SEE RCP SHTS A4.01-A4.04C FOR SHOWER CURTAIN LOCATIONS.
- ALL HANDRAILS, STRINGERS, AND PANS IN STAIR WELLS TO BE PAINTED PT-1, U.O.N.
- TYPICAL COUNTER TOPS AT CASEWORK TO BE SOLID SURFACE MATERIAL SS-2, U.O.N.
- DP #2-B: BPE AT CASEWORK TO MATCH ADJACENT BASE
- REFER TO ELEVATION SERIES A9.0 FOR WALLS WITH MORE THAN ONE FINISH
- ALL GYP. BD. CEILINGS TO BE PAINTED FLAT, U.O.N.
- FOR TYPICAL MEN'S AND WOMEN'S PUBLIC RESTROOM WALLS AND FINISHES SEE SHEET A3.05, A3.06, A3.07.
- FOR TYPICAL FINISHES AT PATIENT AND STAFF TOILET ROOMS SEE SHEET A3.05
- FOR TYPICAL EXAM ROOM WALL AND FLOOR FINISHES, SEE SHT A3.03E
- NO FINISHES SCHEDULED AT UNASSIGNED SPACES U.O.N.
- SEE A10.45 FOR WALL BASE CONDITIONS
- SEE A10.46 FOR THRESHOLD CONDITIONS
- ARTWORK BLOCKING TO BE COORDINATED WITH ART CONSULTANT
- ALL ARTWORK EXACT SIZE, HEIGHT AND LOCATION TBD
- SEE A10.31A FOR AMENITY AND CREDENZA ELEVATIONS AND DETAILS OF CUSTOM CASEWORK
- TOILET ROOM WALL TILE NOTE TO SET TO ELEVATIONS / TILE PATTERNS SEE A3.05, A3.06
- REFER TO WALL FINISH PLANS, SHEETS A2.2X, FOR EXTENT OF WALL PROTECTIONS
- PROVIDE BACKING PLATE WHERE CRASH RAIL OCCURS REFERS TO SHEET A10.04B FOR BACKING DETAILS
- REFER TO SHEET A0.25 FOR MOUNTING HEIGHT
- ALIGN GROUT LINES WHERE FT-X AND WT-B-X OCCURS.

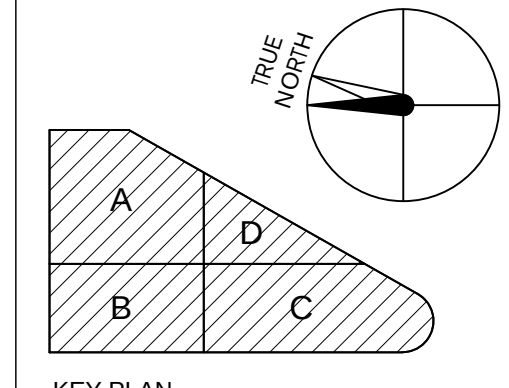

KEY PLAN




K M D ARCHITECTS
ARCHITECTURE PLANNING
222 VALLEJO SAN FRANCISCO, CALIF. 94101

NO.	DATE	DESCRIPTION
1	2016/04/04	CHANGE ORDER #01
2	2016/03/28	WALL FINISH REQ
3	2016/03/23	INTERIORS REVIEW
4	2016/03/16	COUNTERTOPS
5	2016/03/16	WALL FINISH REQ
6	2016/01/04	GENERAL COORDINATION
7	2015/11/24	DP #2 - 100% CD PACKAGE
8	2015/10/23	DESIGN DEVELOPMENT
9	2015/09/28	ISSUED FOR

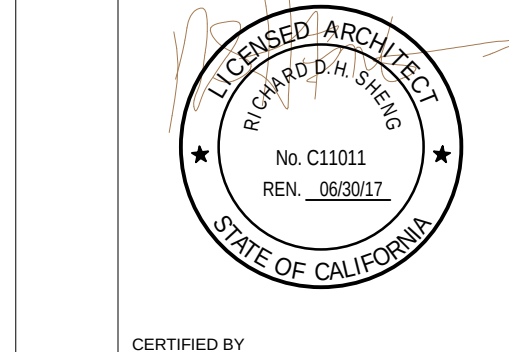


CERTIFIED BY
HEALTH CENTER EMERYVILLE

PLAN CHECK #
PROJECT NO.
106-201


DATE
01/04/16

WALL FINISH PLAN - LEVEL 2

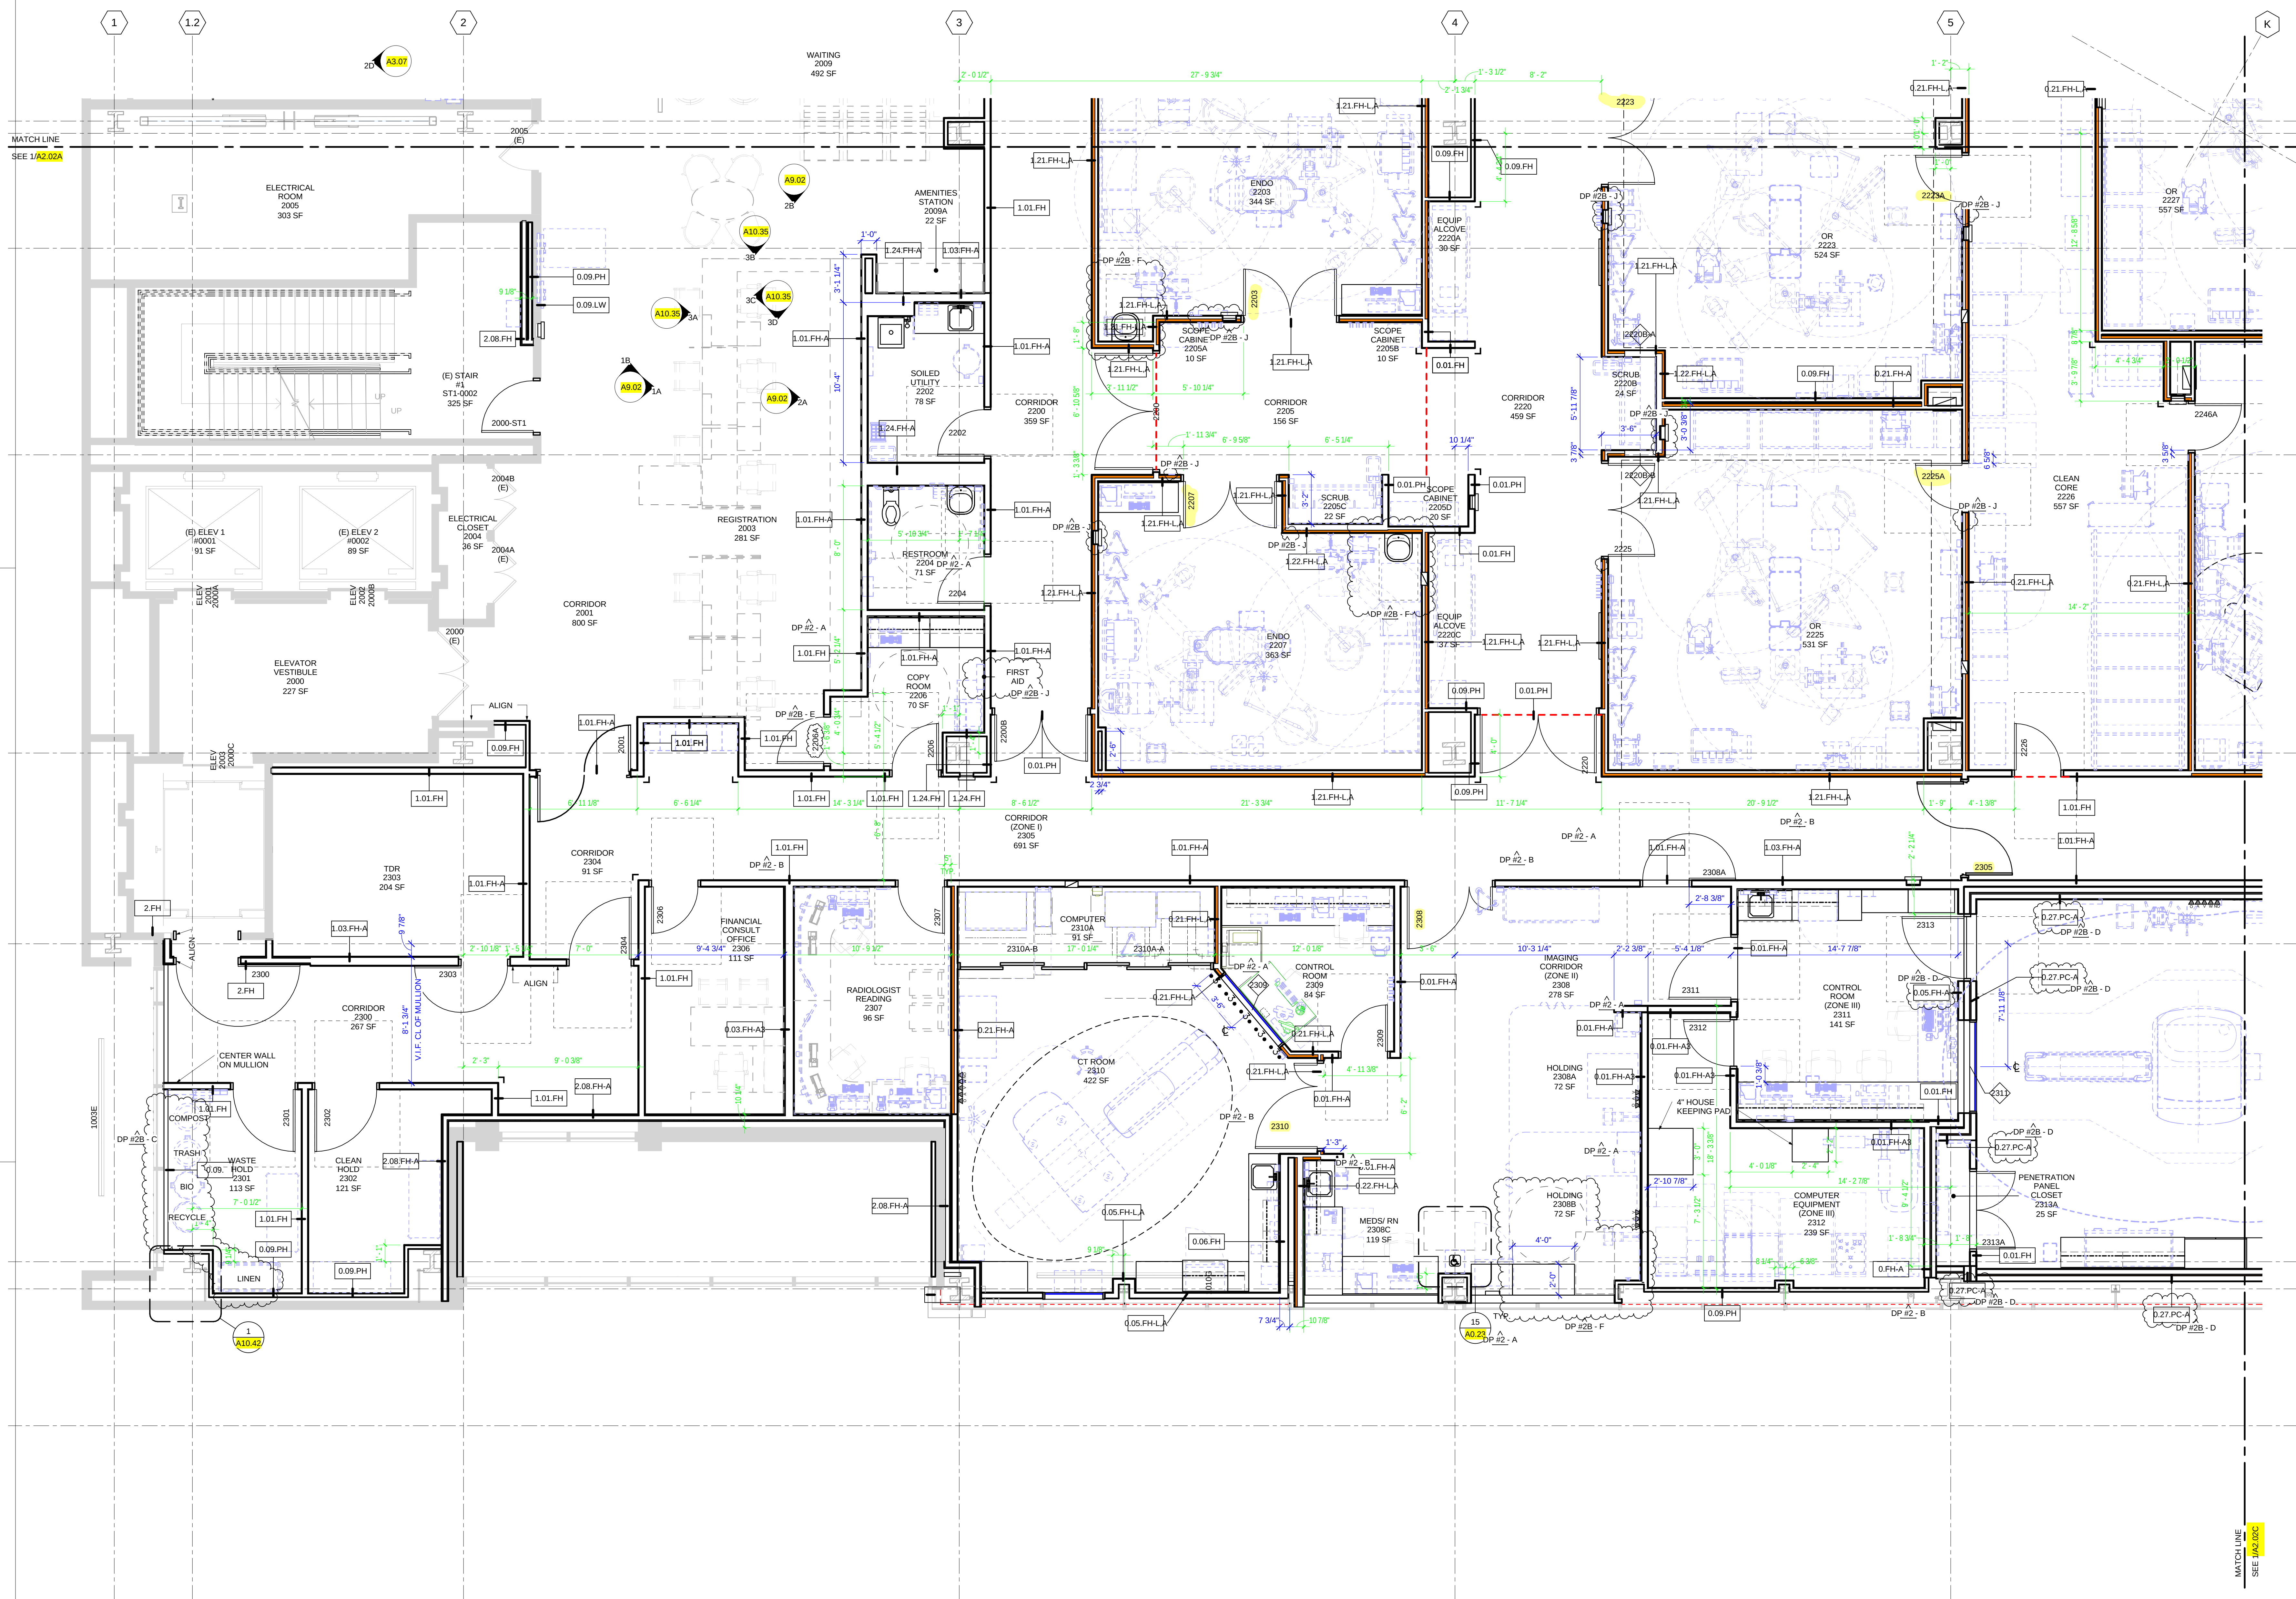

KEYNOTES AND LEGEND

- ① APPLY FRIT TO INTERIOR OF (E) GLAZING
- SHADE SHADOW BOX SCREE
ON FRAME, SEE
DETAILS 9/A10.11

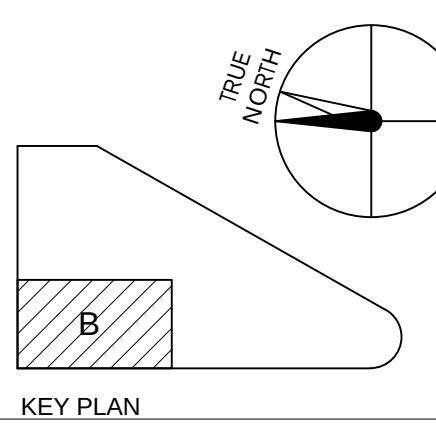

K M D
K M D A R C H I T E C T
A R C H I T E C T U R E P L A N N I N G
222 VALLEJO SAN FRANCISCO, CA 94104

[illegible]

2018/01/29	RESPONSE TO PLAN REVIEW	DP #28 - F
2018/01/29	RESPONSE TO FIRE REVIEW	DP #28 - B
2018/01/29	RESPONSE TO PLUMBING REVIEW	DP #28 - C
2018/01/29	WASTE MANAGEMENT	DP #28 - J
2018/01/29	GENERAL COORDINATION	DP #2 - A
2018/01/04	RESPONSE TO PLAN REVIEW	DP #2 - B
2018/01/04	RESPONSE TO FIRE REVIEW	DP #2 - C
2018/01/04	RESPONSE TO PLUMBING REVIEW	DP #2 - J
2018/01/04	DP #2 - JUMBO CD PACKAGE	DP #2 - JUMBO CD PACKAGE
2018/01/04	DP #2 - 50% CD PACKAGE	DP #2 - 50% CD PACKAGE
2018/09/18	DESIGN DEVELOPMENT	DP #2 - 50% CD PACKAGE
2018/09/18	DESIGN DEVELOPMENT	DP #2 - 50% CD PACKAGE




**HEALTH
CENTER EMERYVILLE**


PLANCHECK#
PROJECT NO.
106-201
DATE
01/04/16

ENLARGED FLOOR PLAN -
LEVEL 2 SECTOR B

A2.02B

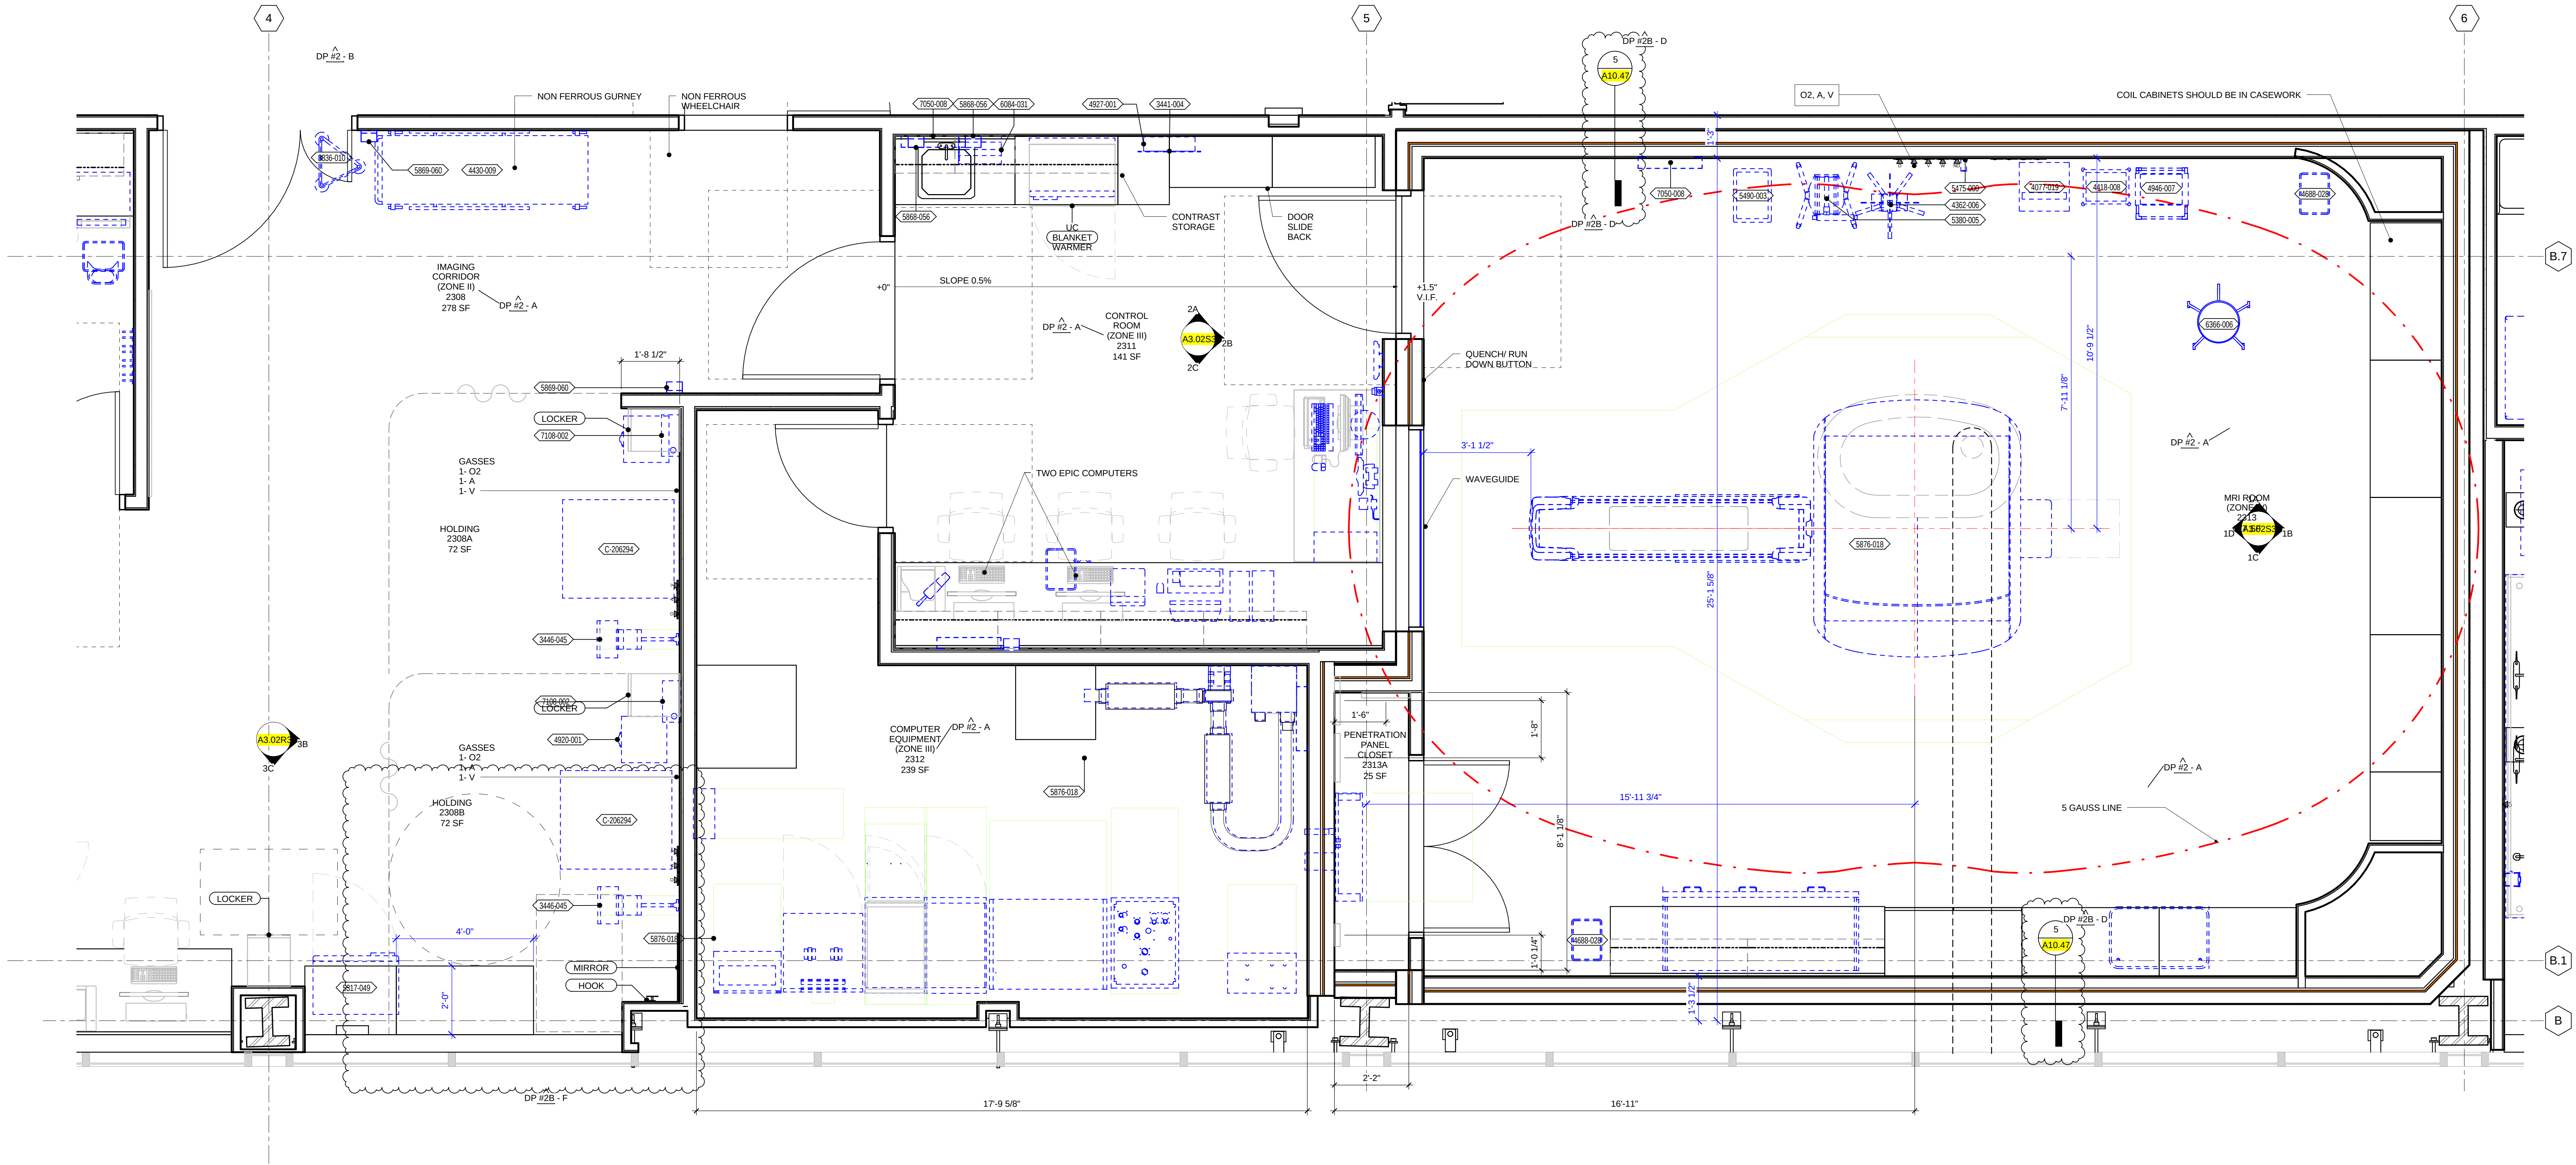


1 2313 MRI
SCALE 1/2" = 1'-0"

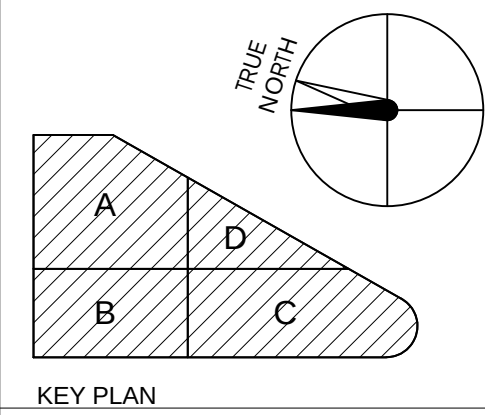

KEY PLAN

HENSEL PHELPS
Plan. Build. Manage.
K M D ARCHITECTS
ARCHITECTURE PLANNING
222 VALLEJO SAN FRANCISCO, CA 94111


NO.	DATE	ISSUED FOR
1	2016/01/29	RESPONSE TO PLAN REVIEW
2	2016/01/29	MRI COORDINATION
3	2016/01/29	GENERAL COORDINATION
4	2016/01/29	GENERAL COORDINATION
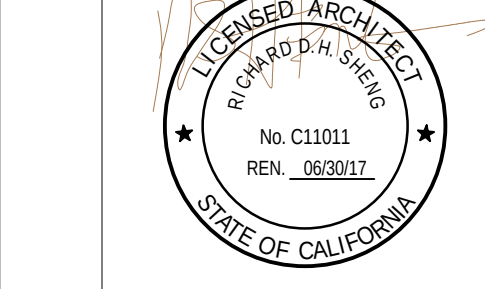



CERTIFIED BY
HEALTH CENTER EMERYVILLE

PLANCHECK#
PROJECT NO.
106-201
DATE
01/04/16
2313 MRI


A3.02S1

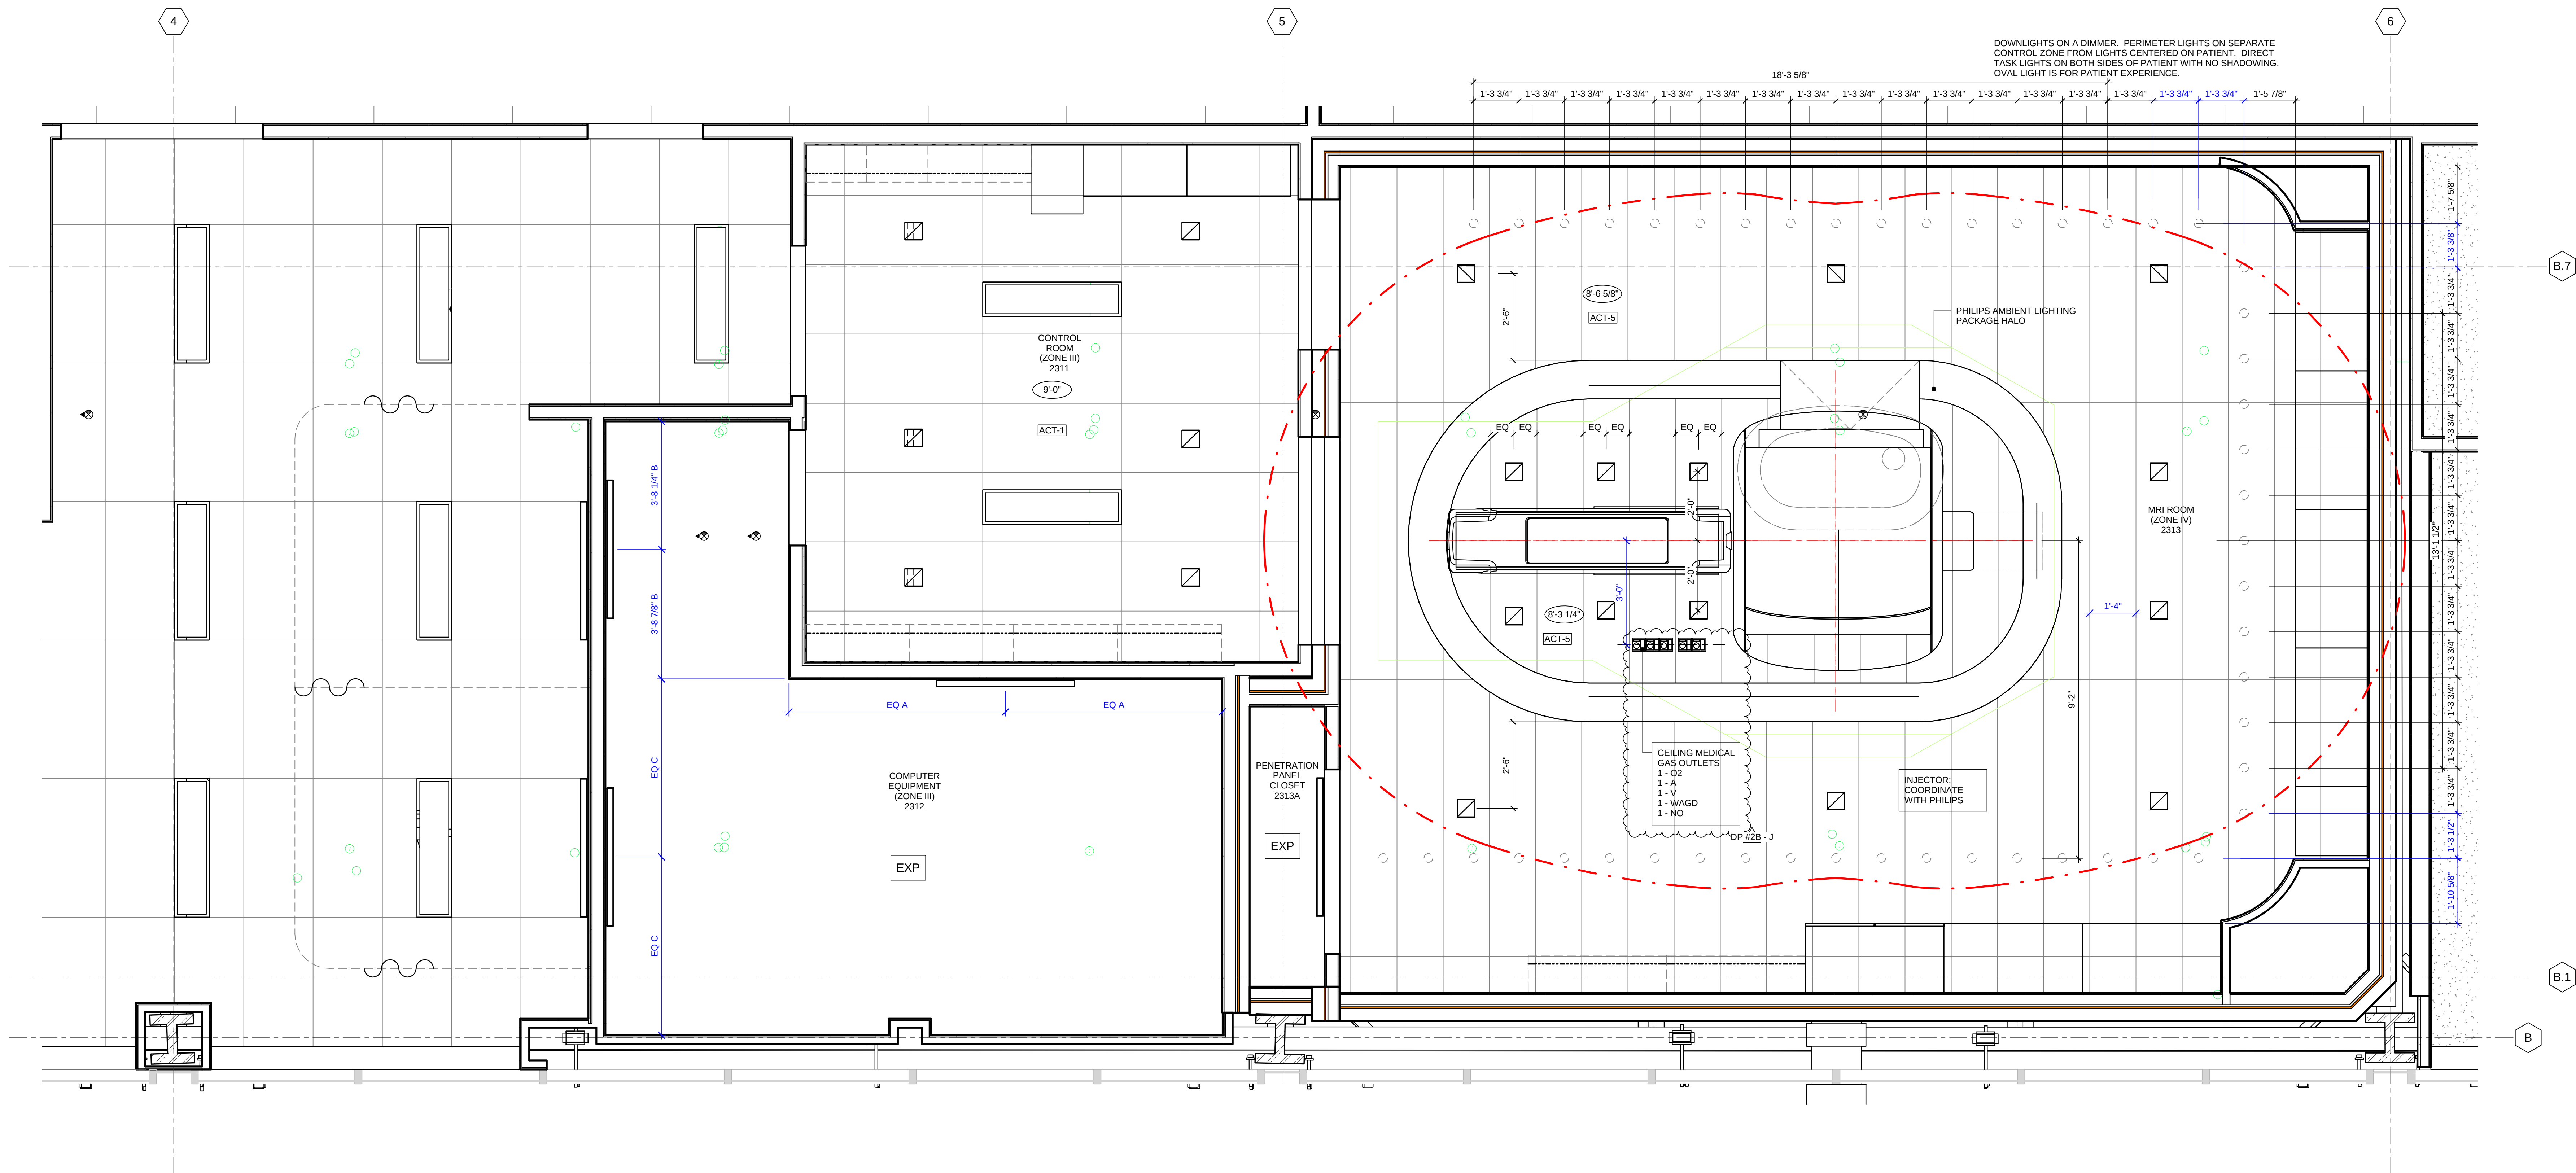

2 2313 MRI
SCALE 1/2" = 1'-0"

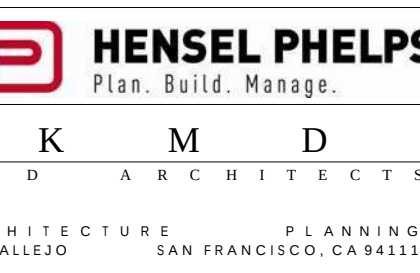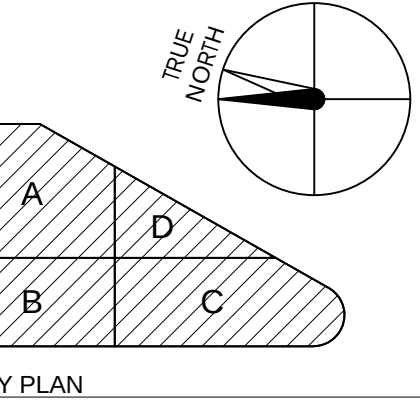








NO.	DATE	ISSUED FOR
DP 12B-J	2015/01/29	GENERAL COORDINATION
	2015/11/24	DP #2 - 100% CD PACKAGE
	2015/10/23	DP #2 - 50% CD PACKAGE
	2015/09/28	DESIGN DEVELOPMENT

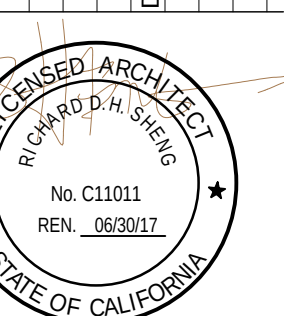

CERTIFIED BY
**HEALTH
CENTER EMERYVILLE**

PLANCHECK#
PROJECT NO.
106-201
DATE
01/04/16
2313 MRI

A3.02S2

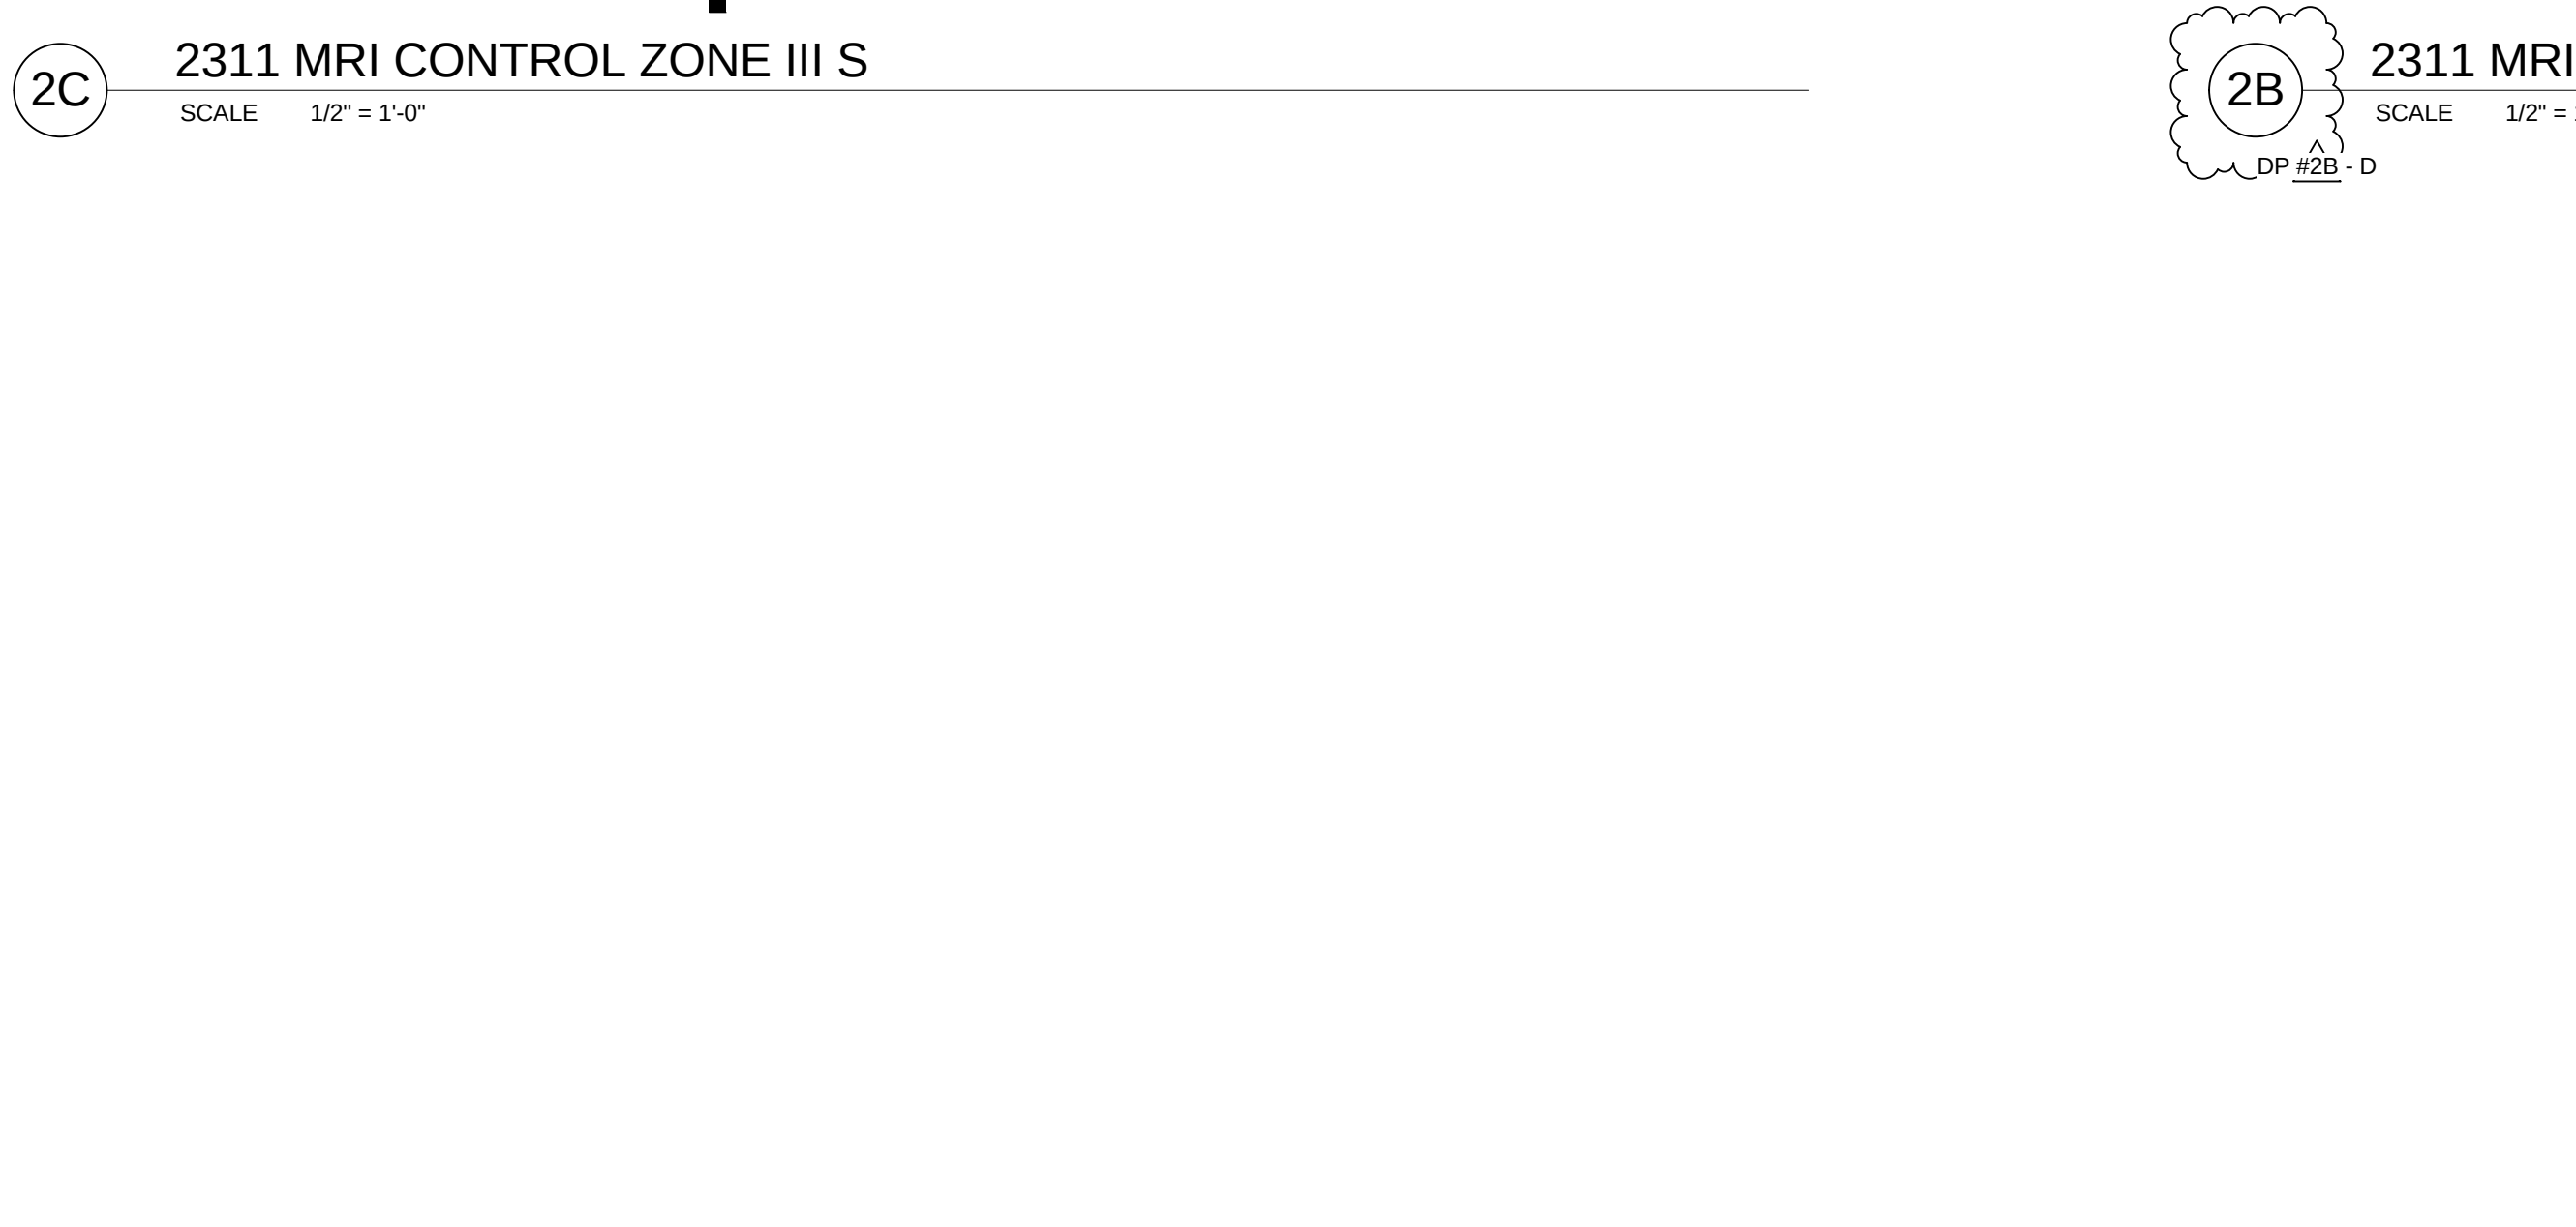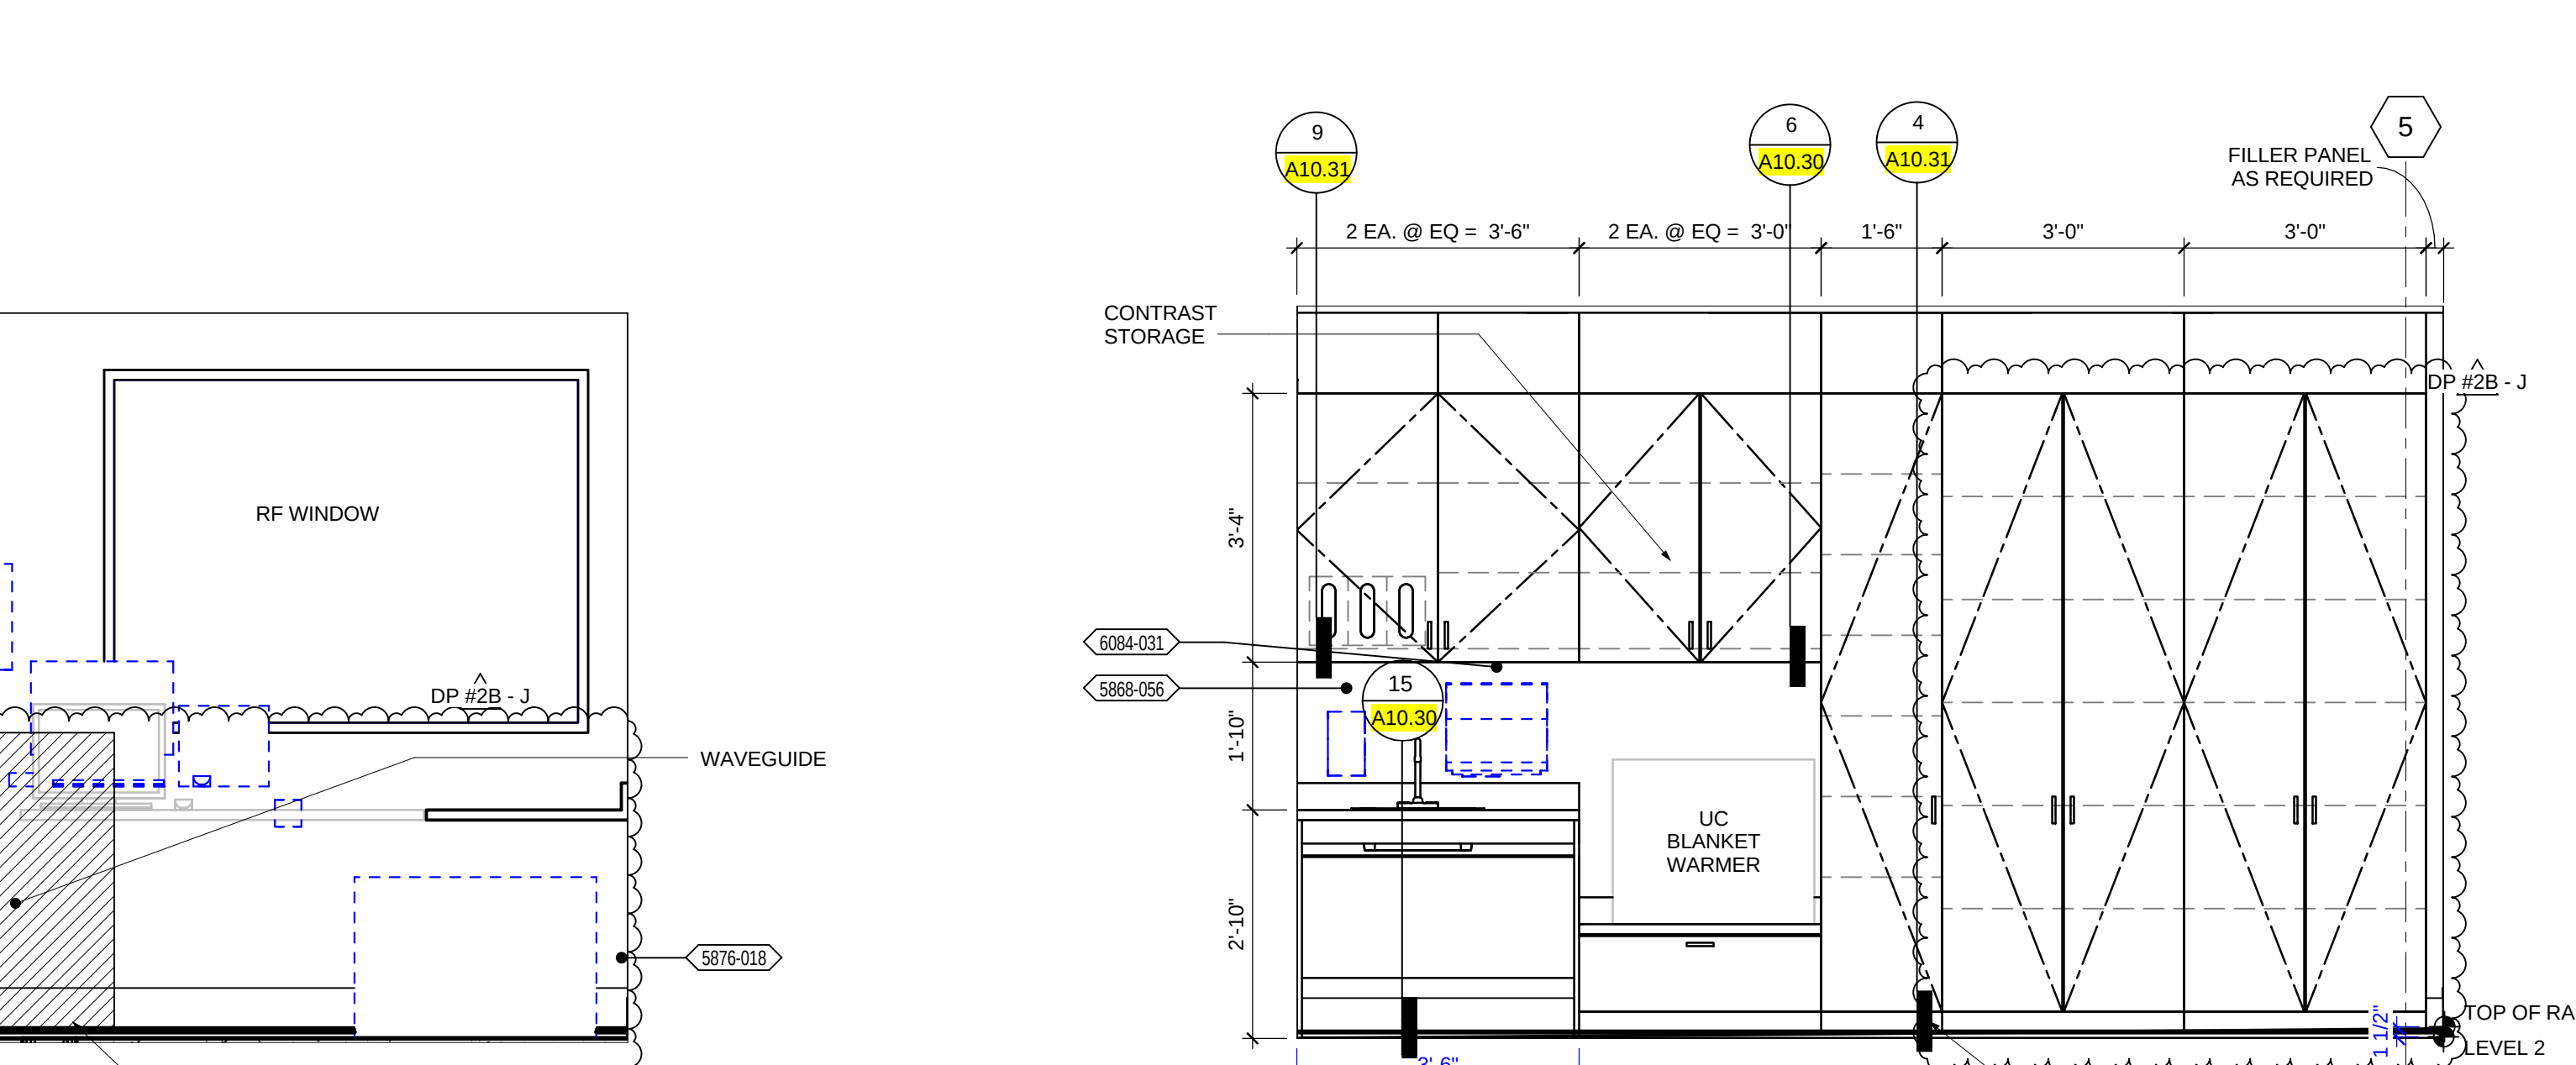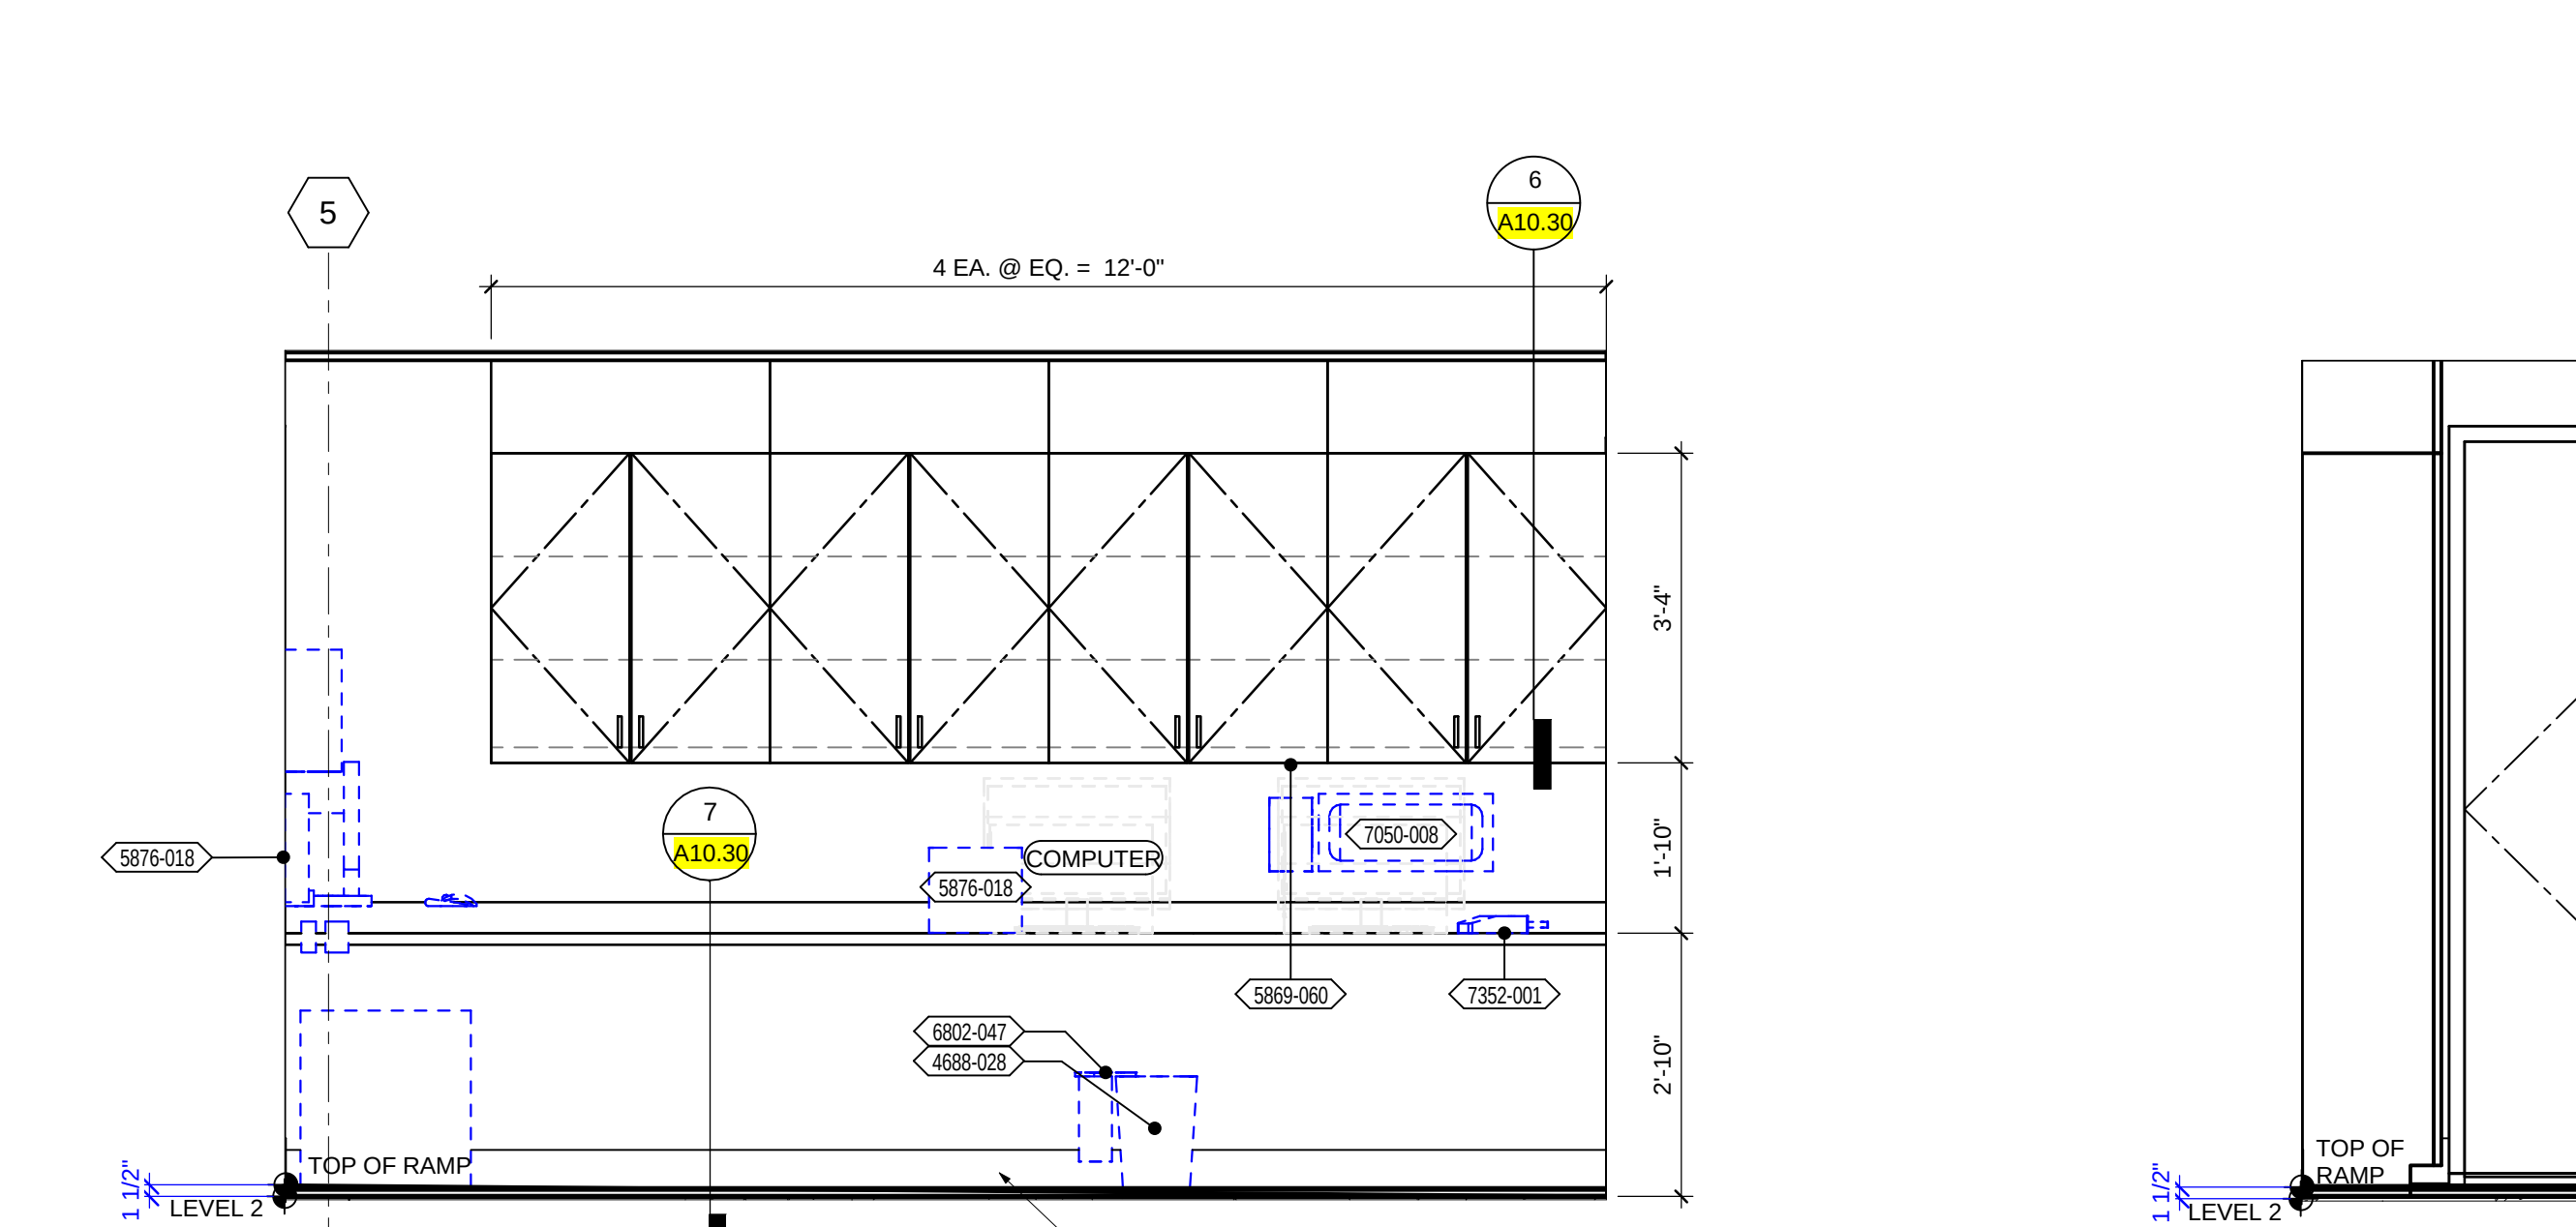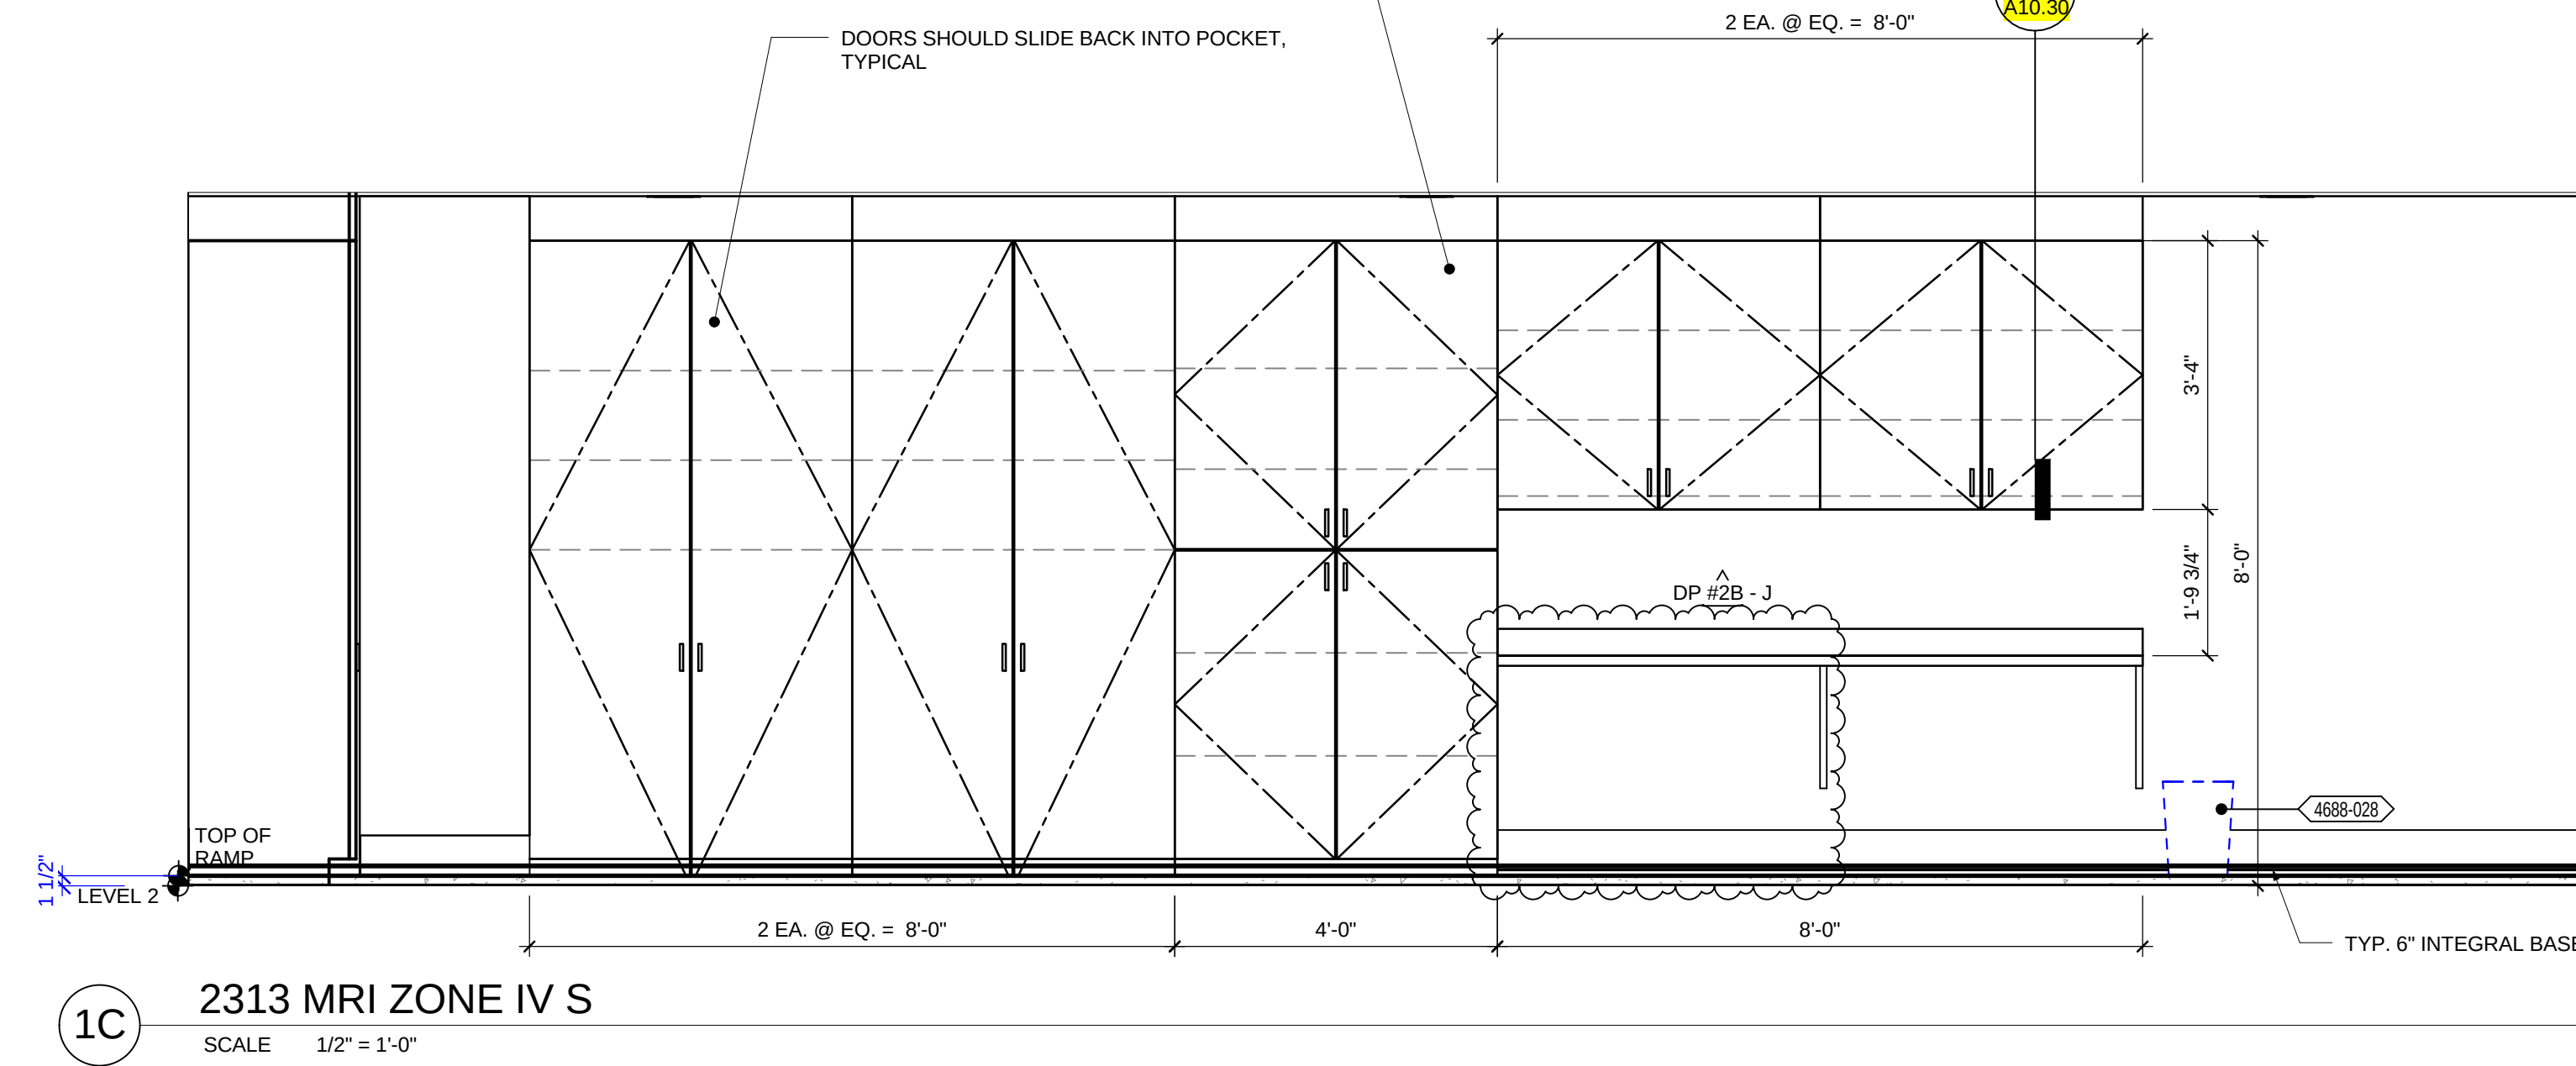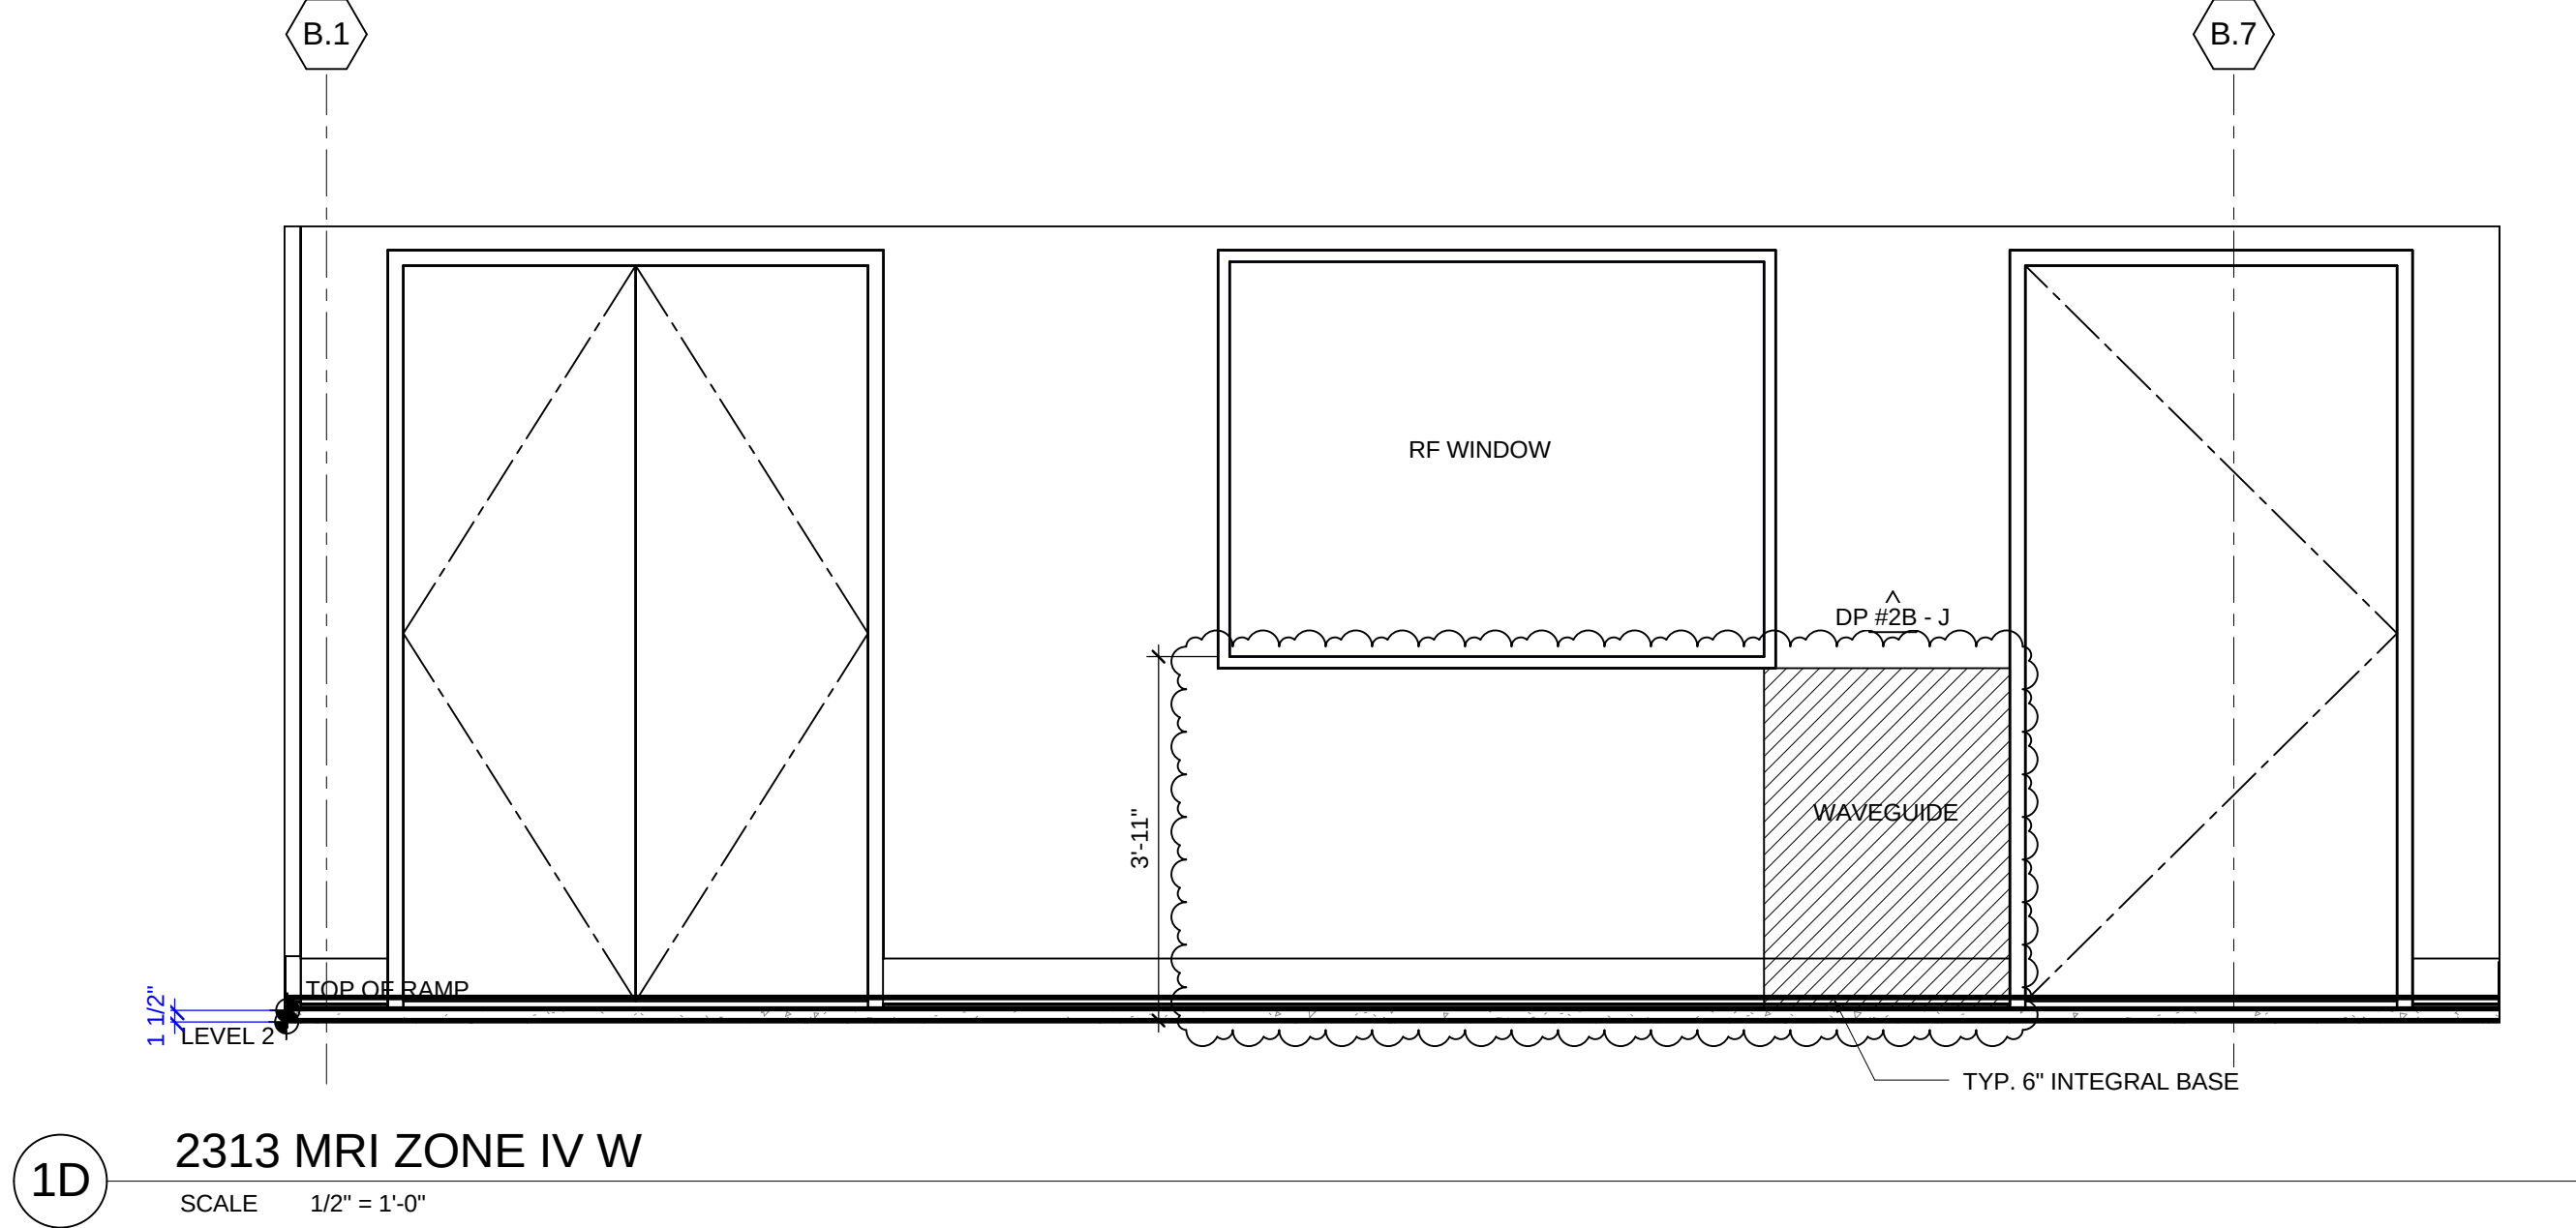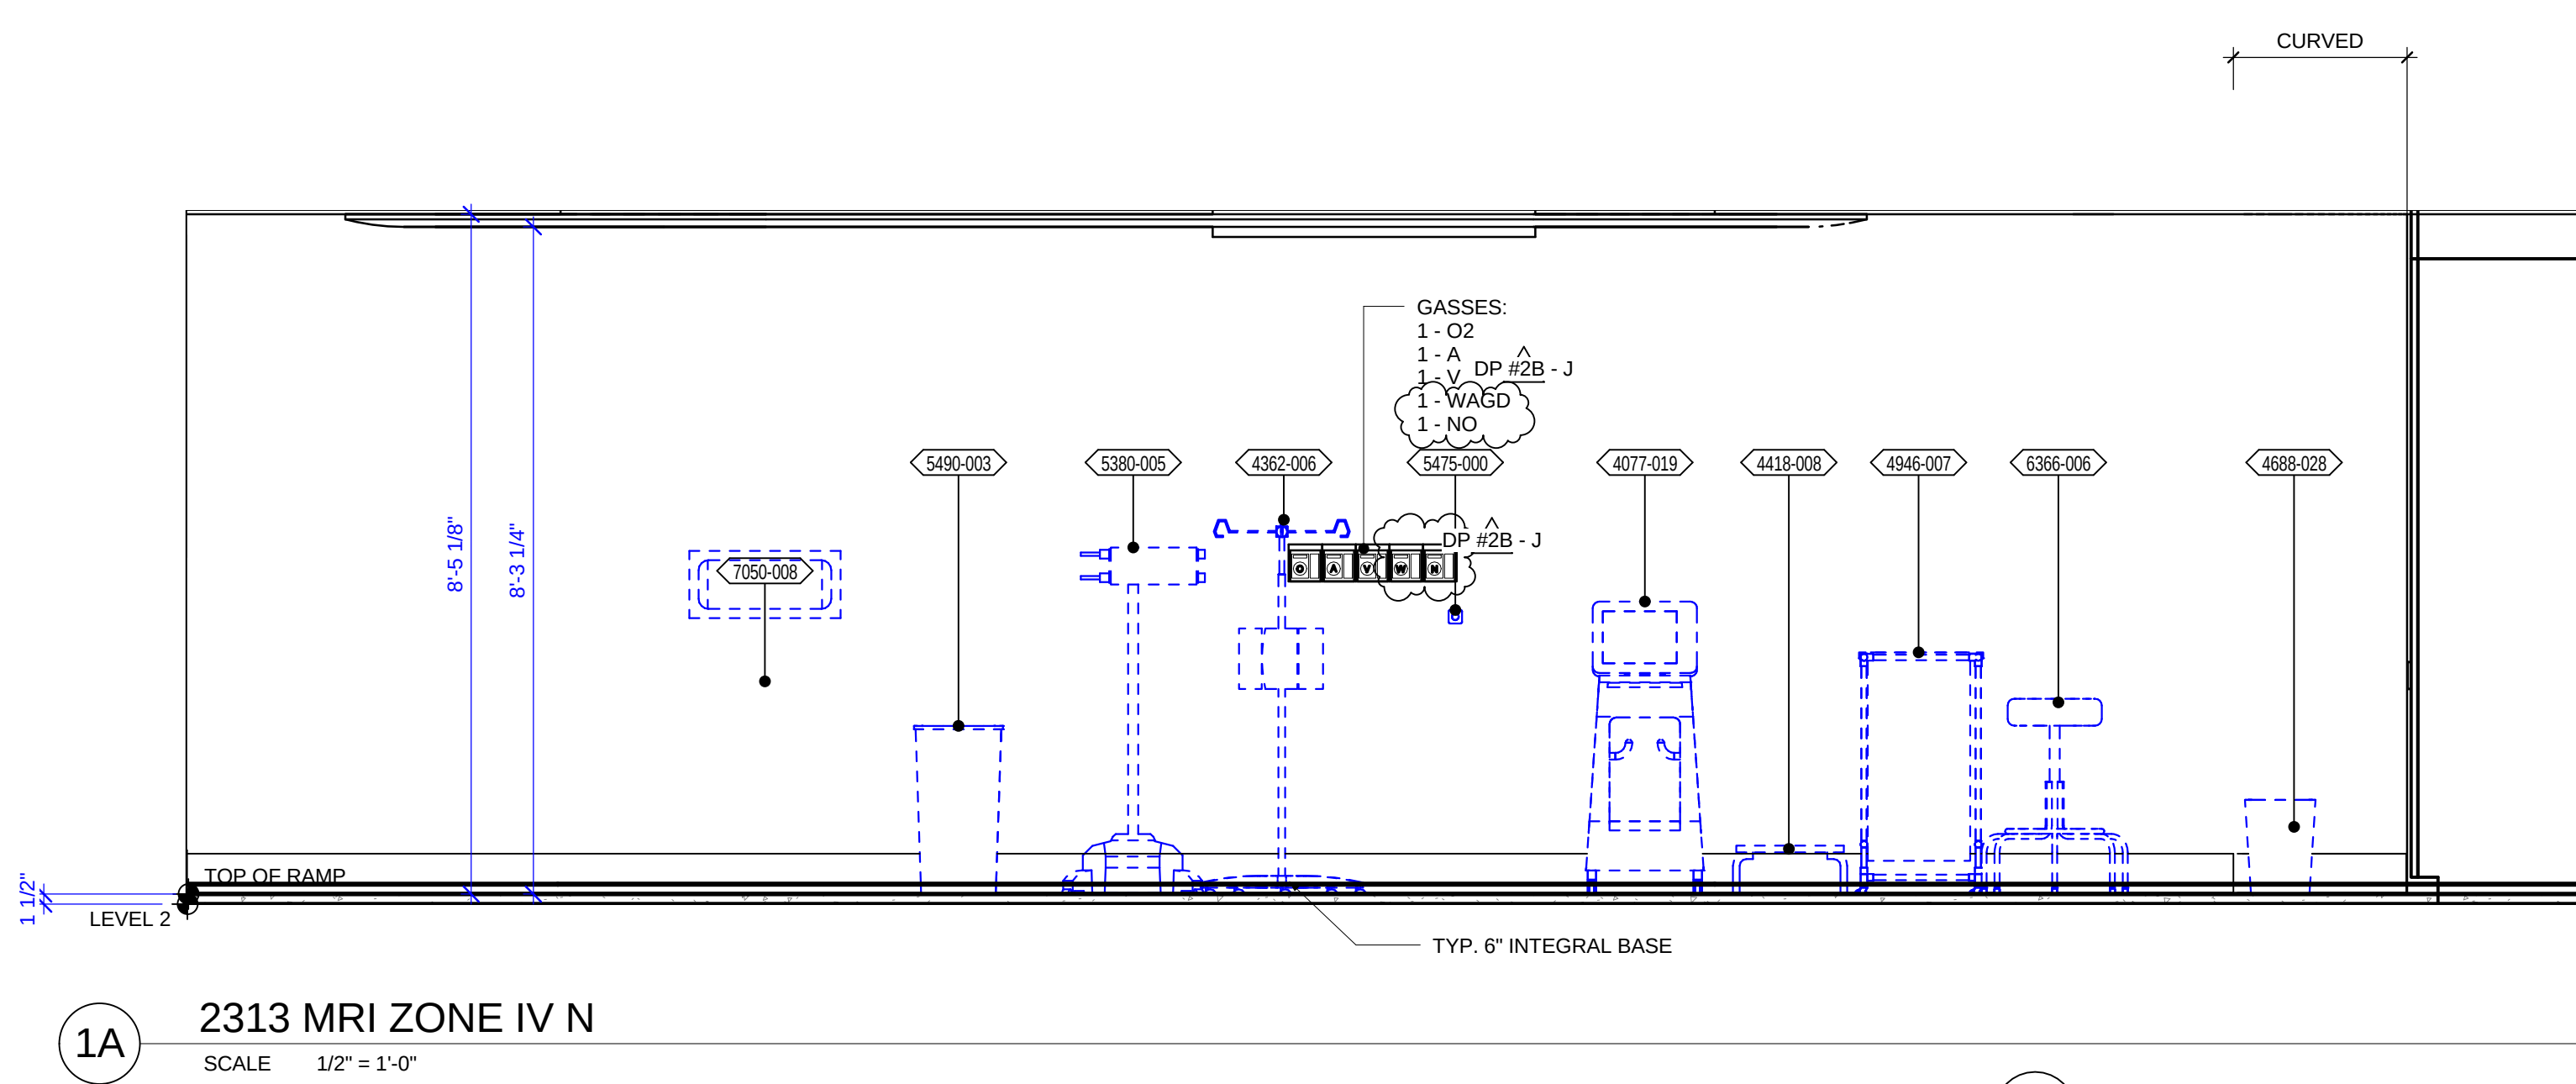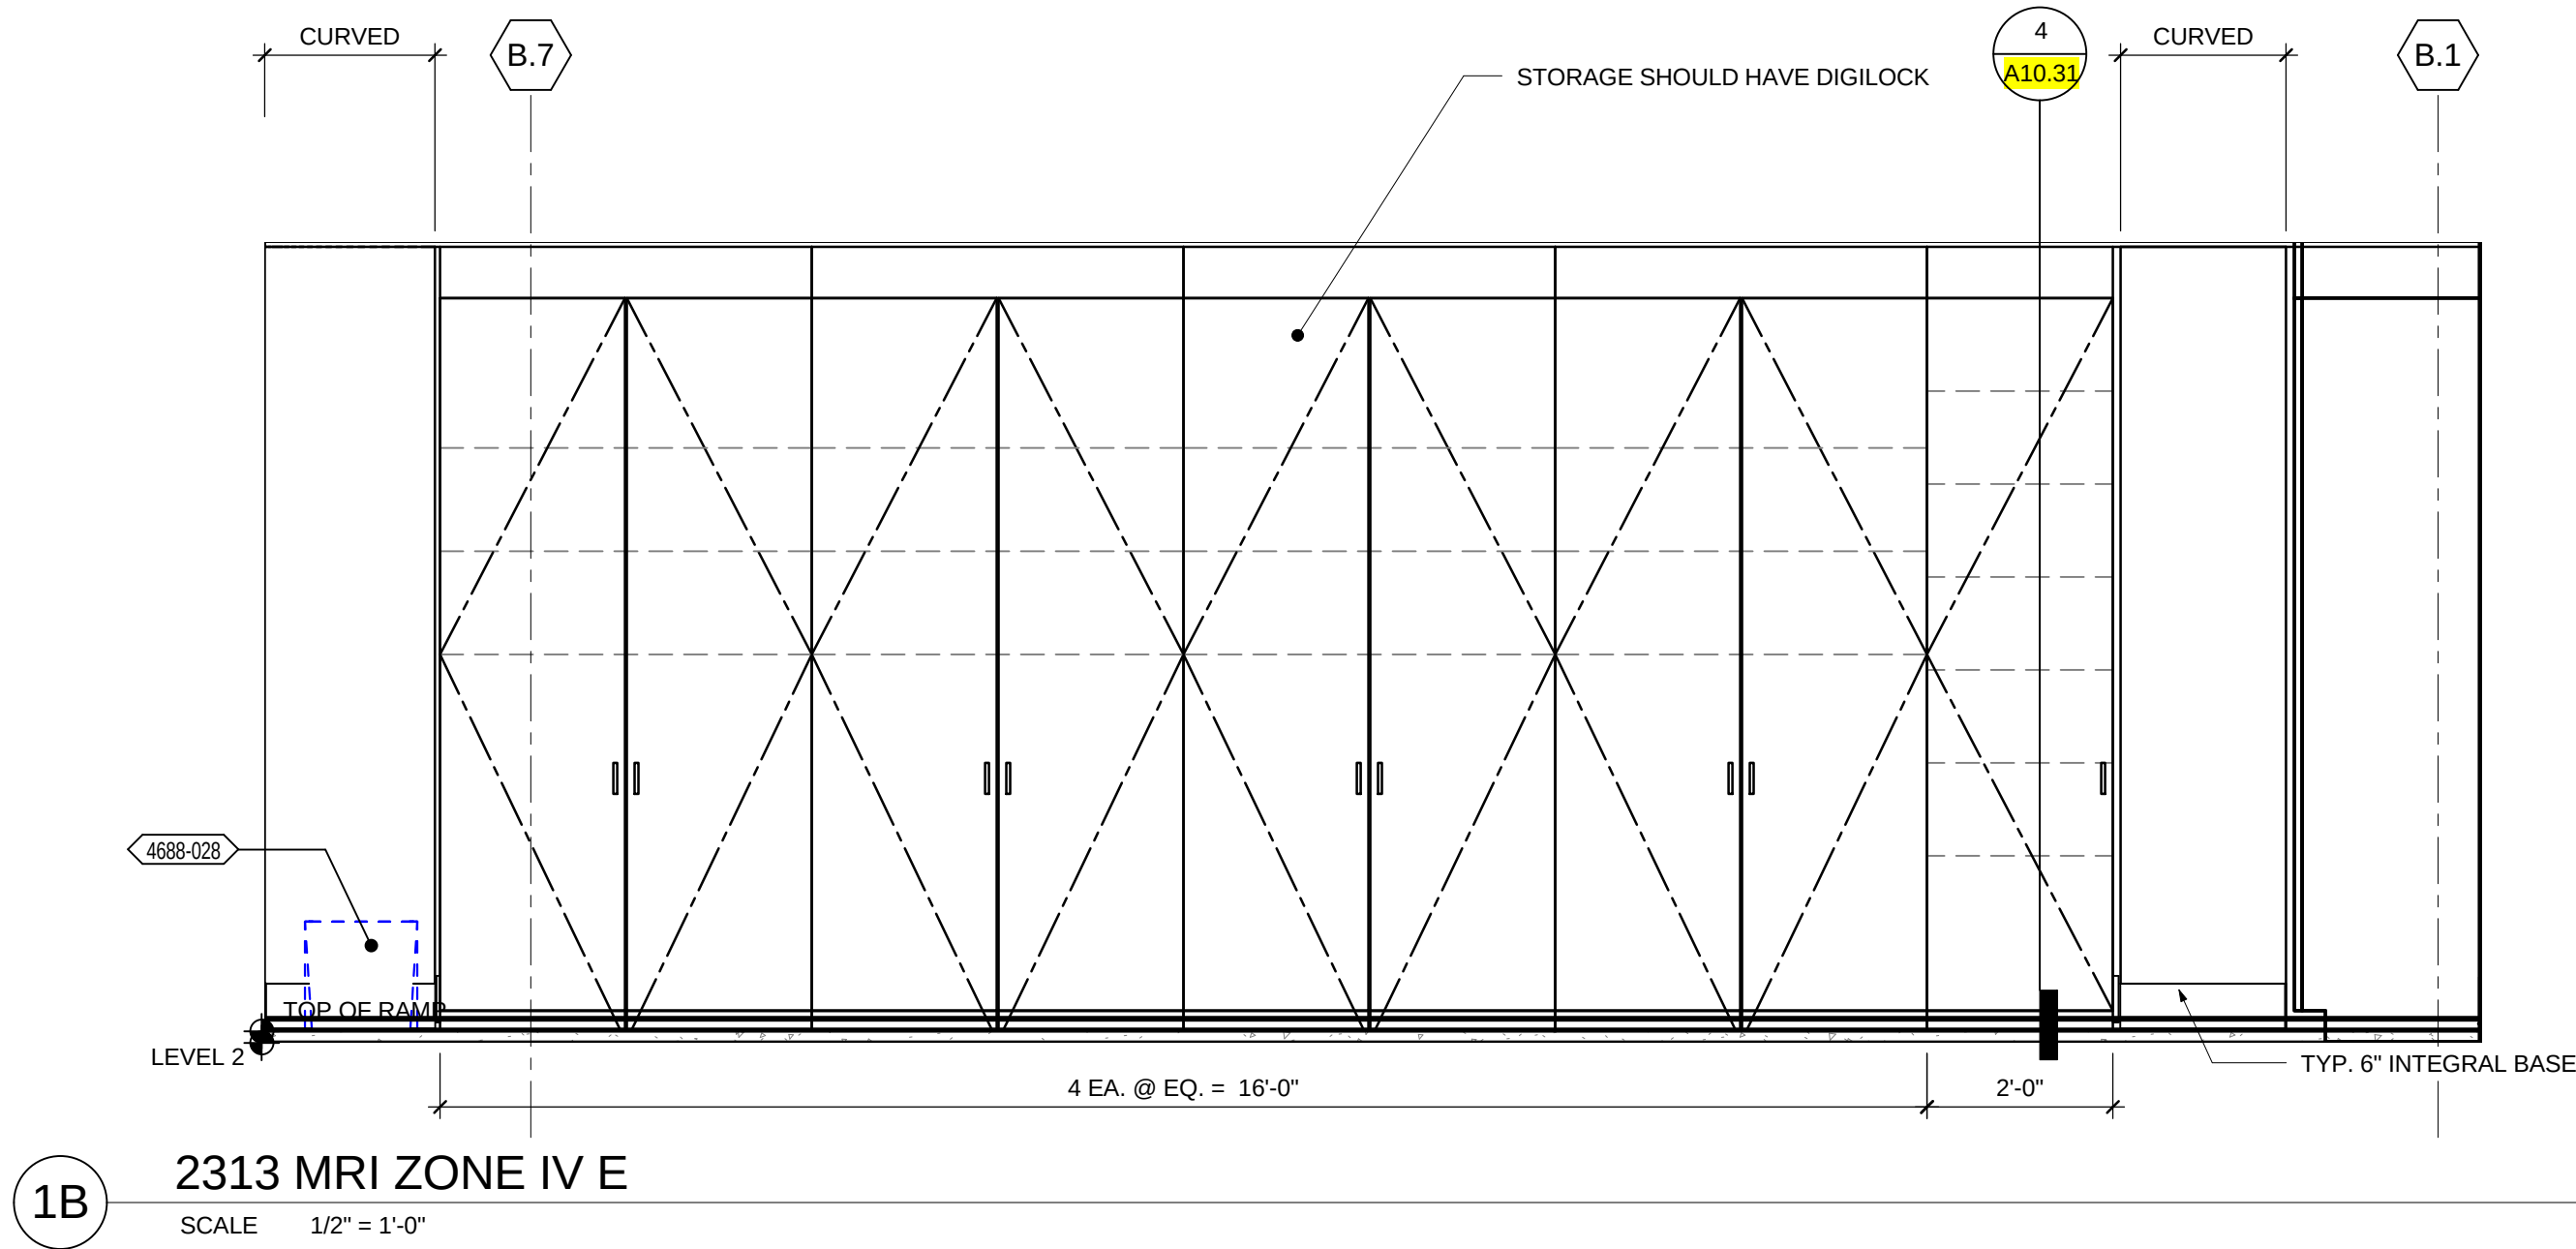

KEY PLAN

A

B

C

D

HENSEL PHELPS

Plan. Build. Manage.

K

M

D

ARCHITECTS

PLANNING

222 VALLEJO

SAN FRANCISCO, CA 94111

NO.	DATE	ISSUED FOR
1	2015/01/29	MRI COORDINATION
2	2015/01/29	GENERAL COORDINATION
3	2015/11/24	DP #2 - 100% CD PACKAGE
4	2015/10/23	DP #2 - 50% CD PACKAGE
5	2015/09/28	DESIGN DEVELOPMENT
6	2015/09/28	ISSUED FOR

APPROVED ARCHITECT

NO. C11011

REN. 000011

DATE OF CALIF. REG.

CERTIFIED BY

HEALTH

CENTER EMERYVILLE

PLANCHECK#

PROJECT NO.

106-201

DATE


01/04/16

2313 MRI

A3.02S3


PLOT DATE: 1/31/2016 12:37:35 PM

COPYRIGHT © 2016 BY KMD ARCHITECTS. ALL RIGHTS RESERVED.

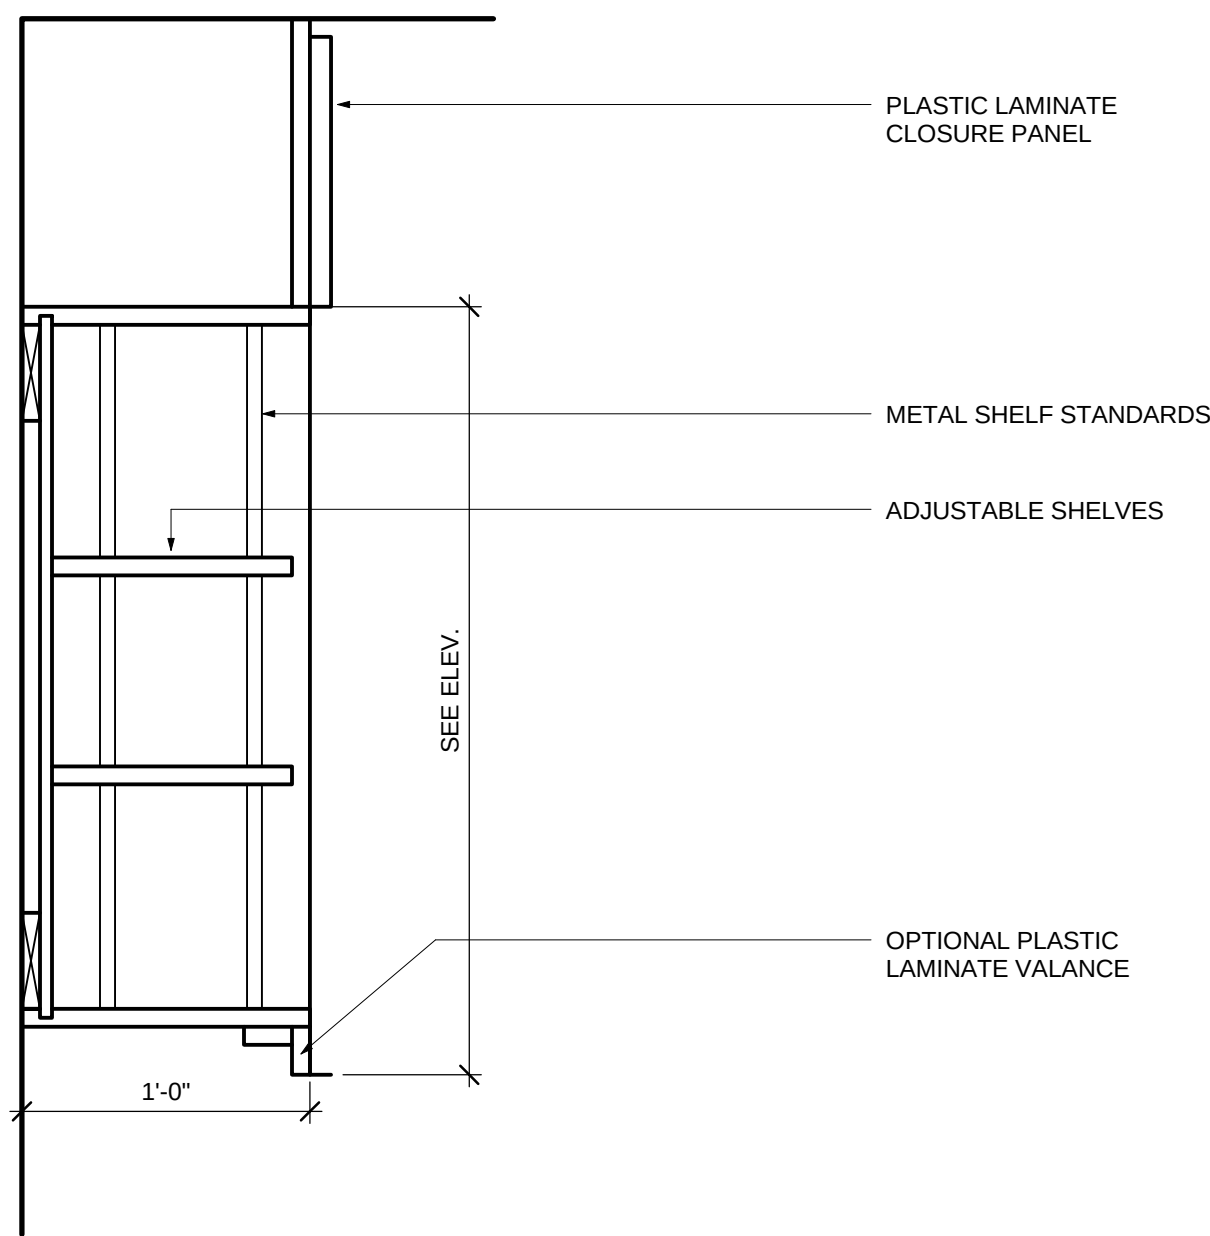


12 WALL CABINET - 3 OPEN SHELF

SCALE 1-1/2"=1'-0" CODE
NUMBER 123500-07-GS SPEC
DATE 06/28/13

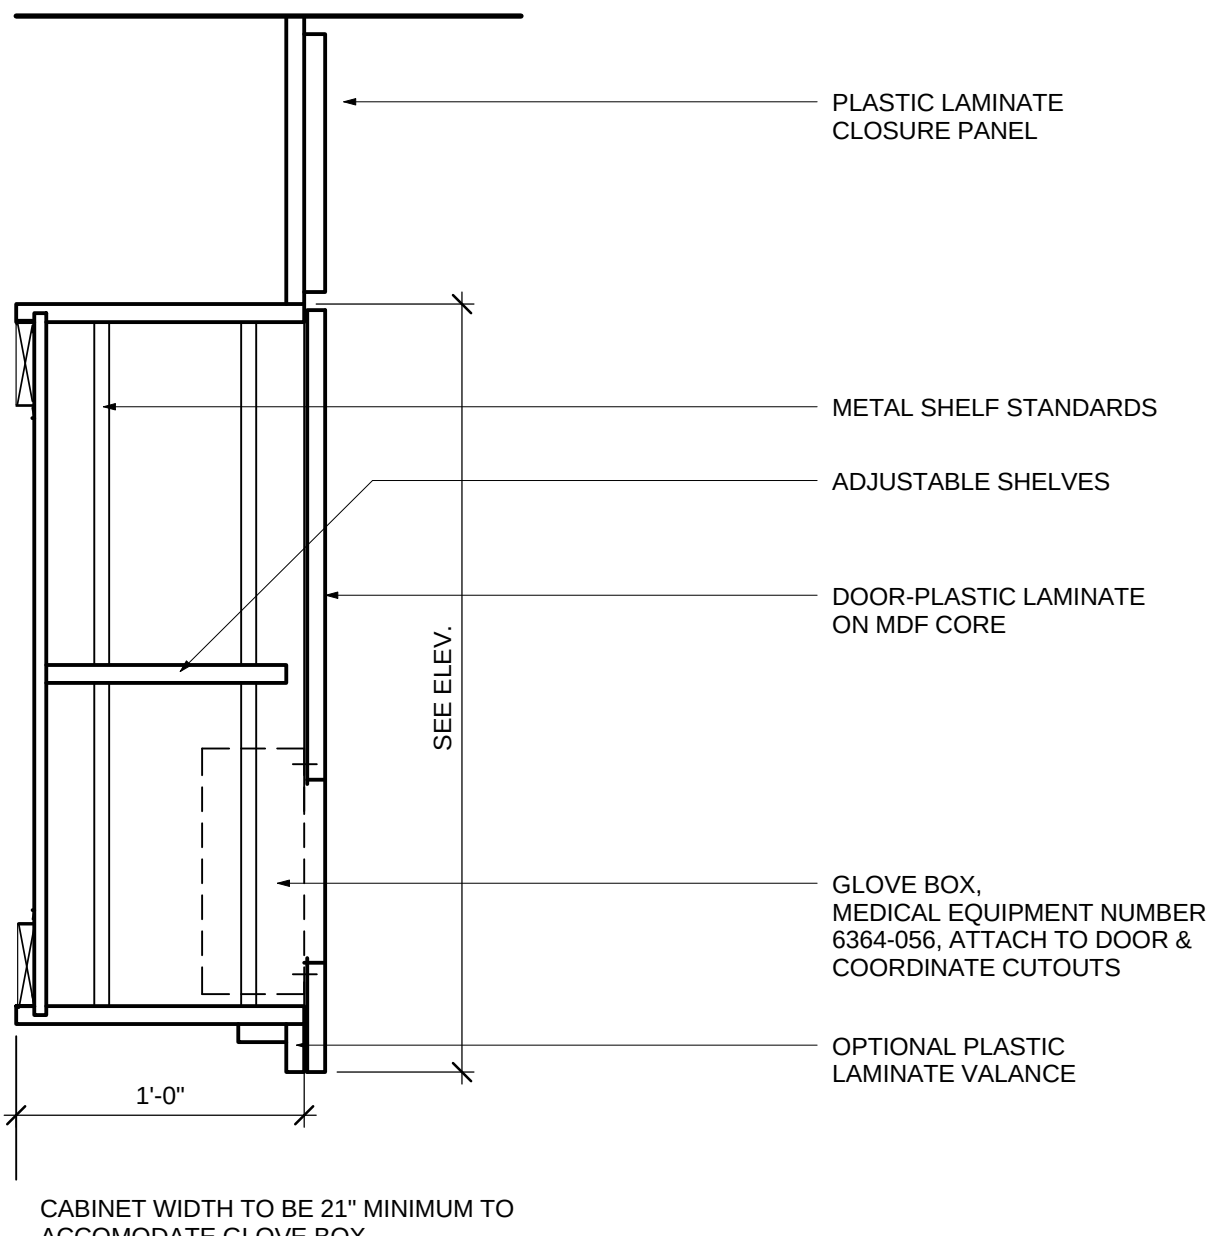

9 CASEWORK DETAIL GLOVE BOX

SCALE 1-1/2"=1'-0" CODE
NUMBER 123500-XX-X SPEC
DATE 08/28/03

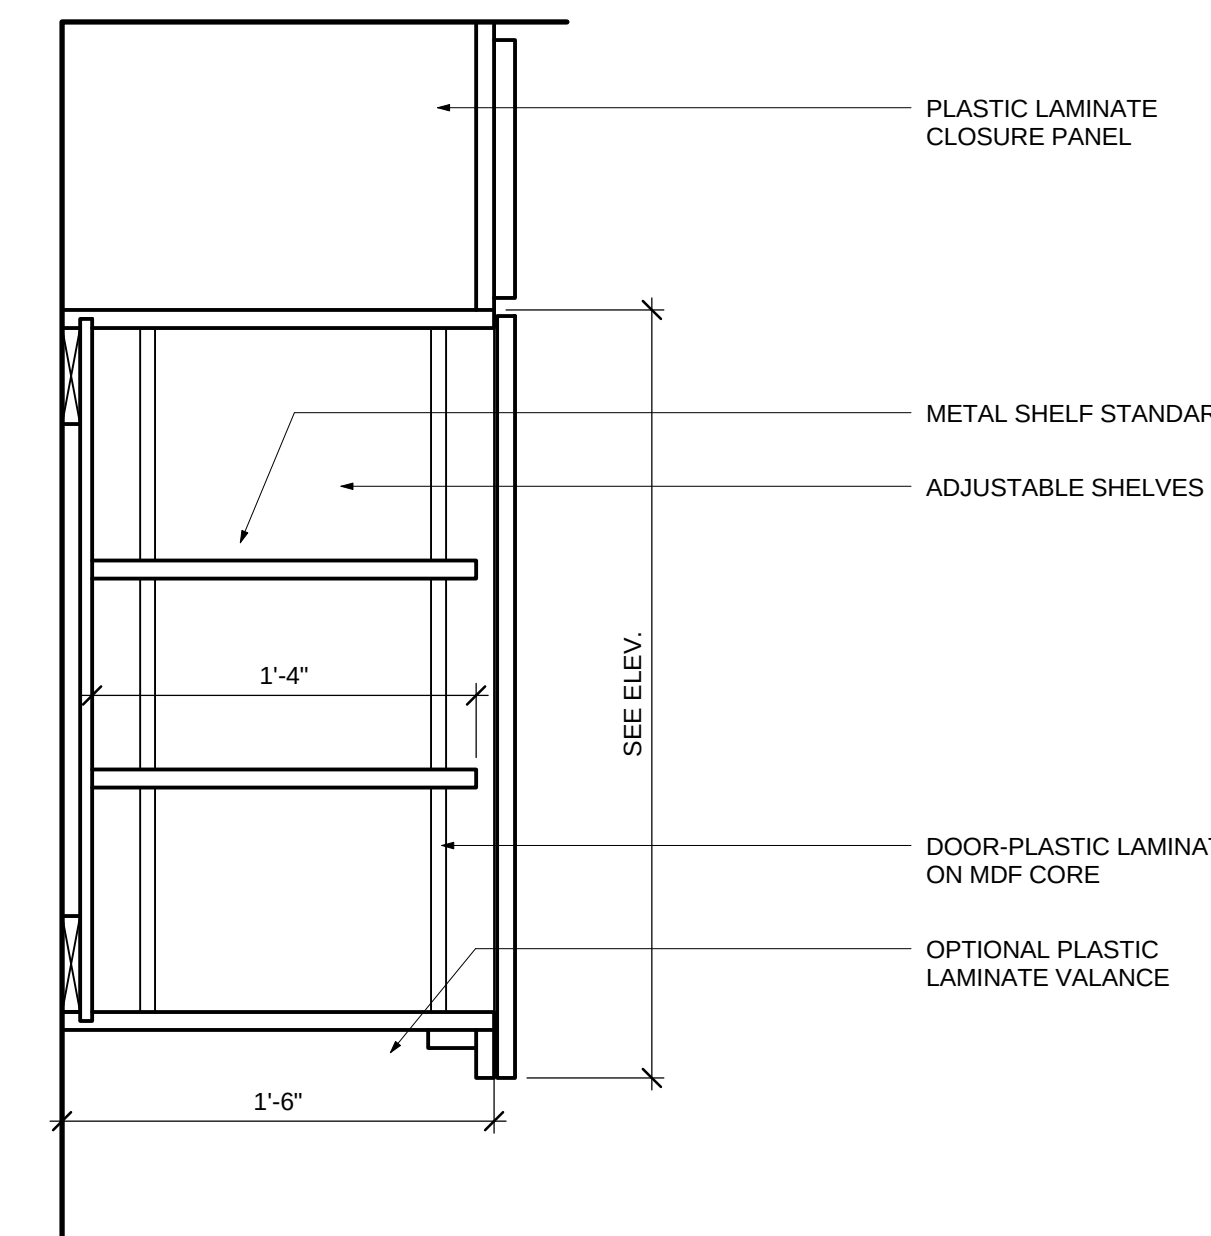


6 WALL CABINET 18"

SCALE 1-1/2"=1'-0" CODE
NUMBER 123500-XX-XX SPEC
DATE 06/28/13

SHEET NOTES

1. FOR ALL FINISH SPECIFICATION SEE PROJECT MANUAL
2. ALL CASEWORK TO BE PL-1 LOWER & UPPER CABINETS WITH SS-1 COUNTERTOPS, U.O.N.
3. TYPICAL LAMINATE CASEWORK TO BE PL-1, U.O.N.
4. TYPICAL COUNTER TOPS AT CASEWORK TO BE SOLID SURFACE MATERILA SS-1, U.O.N.
5. BASE TYPE AT CASEWORK TO MATCH ADJACENT BASE
6. SEE **A10.39** DETAIL 3 FOR ADDITION WALL ATTACHMENTS
7. SEE **A10.38** FOR AMENITY AND CREDENZA ELEVATIONS AND DETAILS CUSTOM CASEWORK
8. ALL INTERIOR CABINETRY MDF
9. SEE FLOOR PLANS FOR EXACT SIZE OF AMENITY BAR, (SIZE VARIES)
10. ALL MILLWORK TO BE WD-4 LOWER CABINETS AND SS-1 FOR COUNTERTOP, U.O.N.

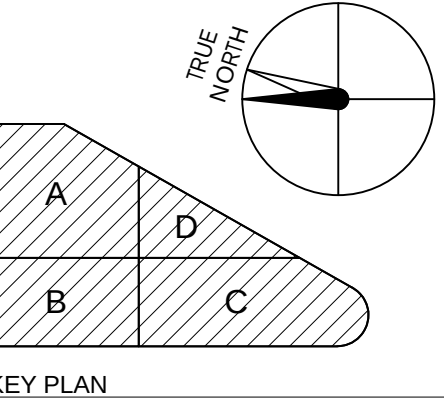


KEY PLAN

CONSULTANT DRAWING LOG

HENSEL PHELPS
Plan. Build. Manage.
K M D ARCHITECTS
ARCHITECTURE PLANNING
222 VALLEJO SAN FRANCISCO, CA 94111

NO.	DATE	ISSUED FOR
1	2016/01/29	WASTE MANAGEMENT
2	2016/01/04	GENERAL COORDINATION
3	2016/11/24	DP #2 - 100% CO PACKAGE

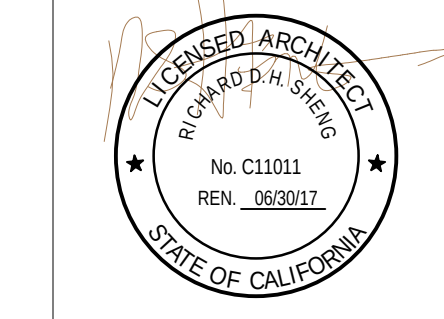


CERTIFIED BY
HEALTH CENTER EMERYVILLE

PLANCHECK#
PROJECT NO.
106-201
DATE
01/04/16

CASEWORK DETAILS

A10.31

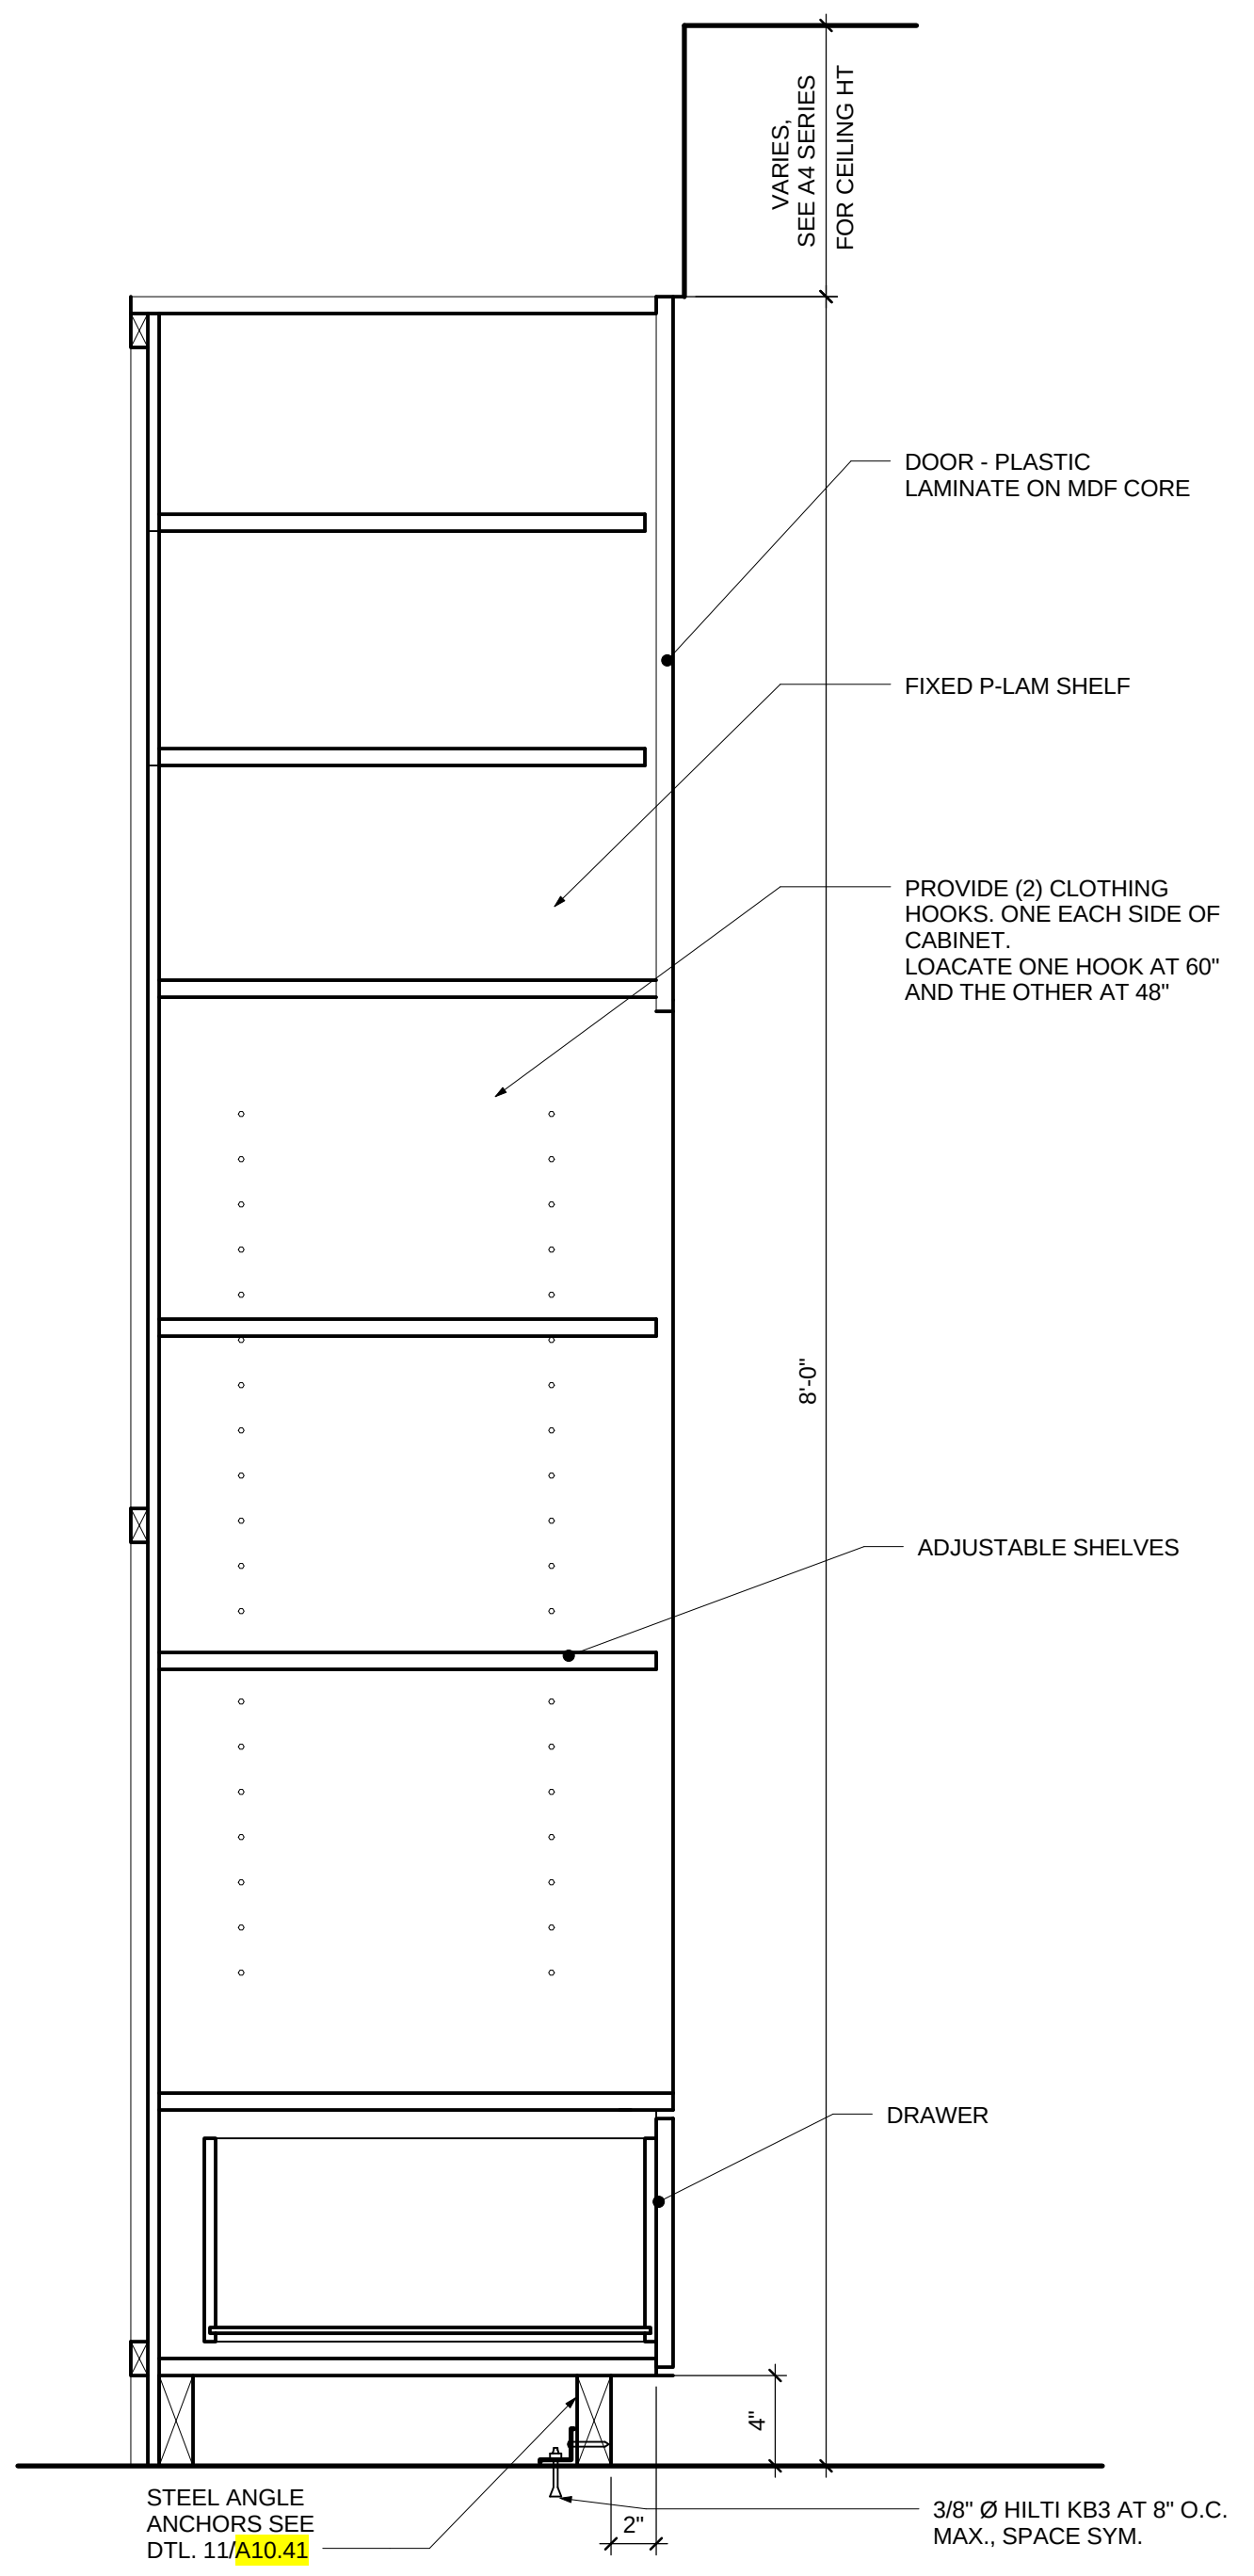


13 CASEWORK CABINET

SCALE 1-1/2"=1'-0" CODE
NUMBER 123570 SPEC
DATE 11/23/15

11 CASEWORK W/ DOORS AT TUCK BACK


SCALE 1-1/2"=1'-0" CODE
NUMBER 123500-XX-XX SPEC
DATE 0X/XX

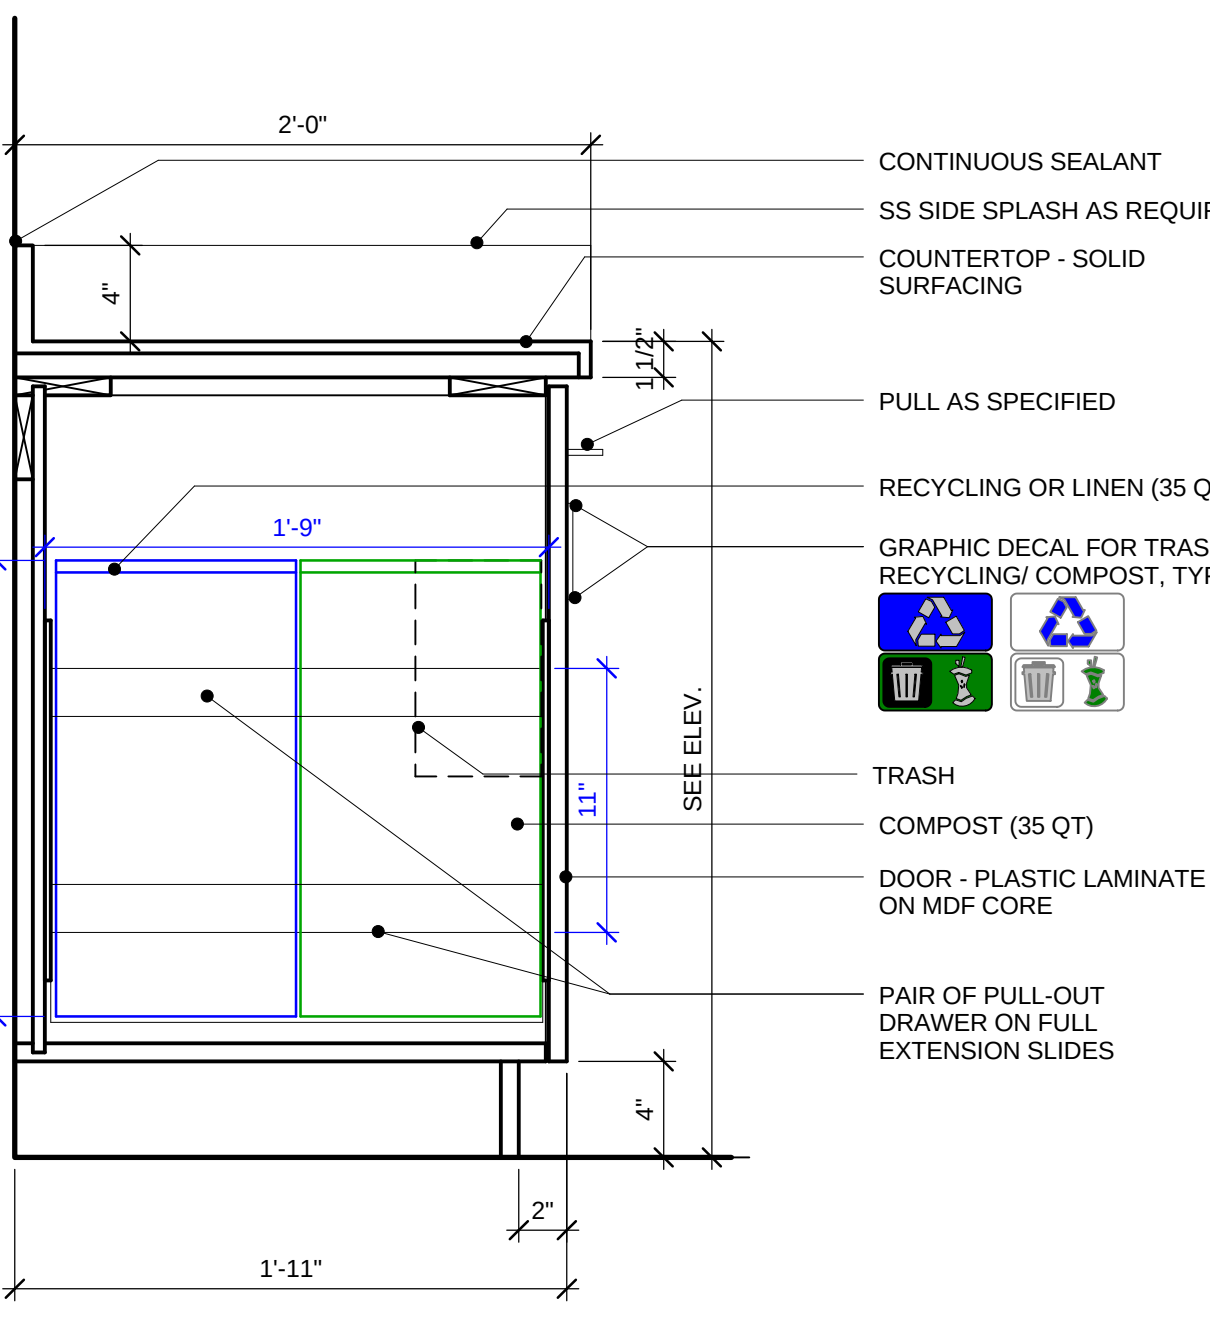

8 BASE CABINET - DOOR


SCALE 1-1/2"=1'-0" CODE
NUMBER 123500 SPEC
DATE 01/20/06

TO BE REVISED

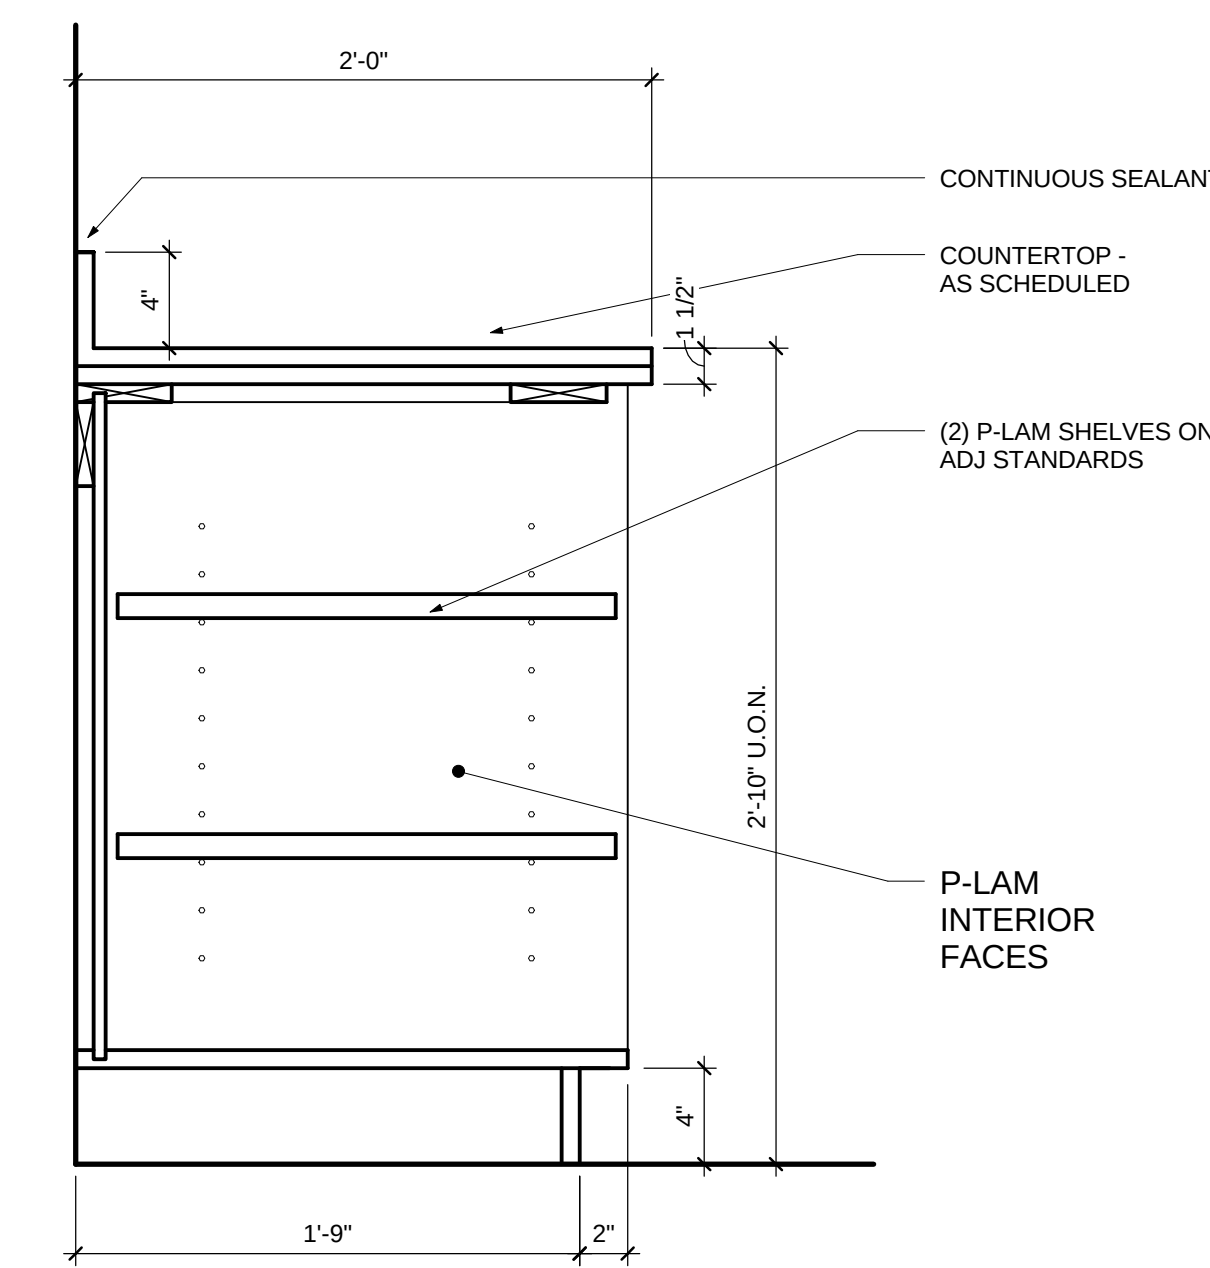


7 BASE CABINET - 2 SHELF

SCALE 1 1/2" = 1'-0"

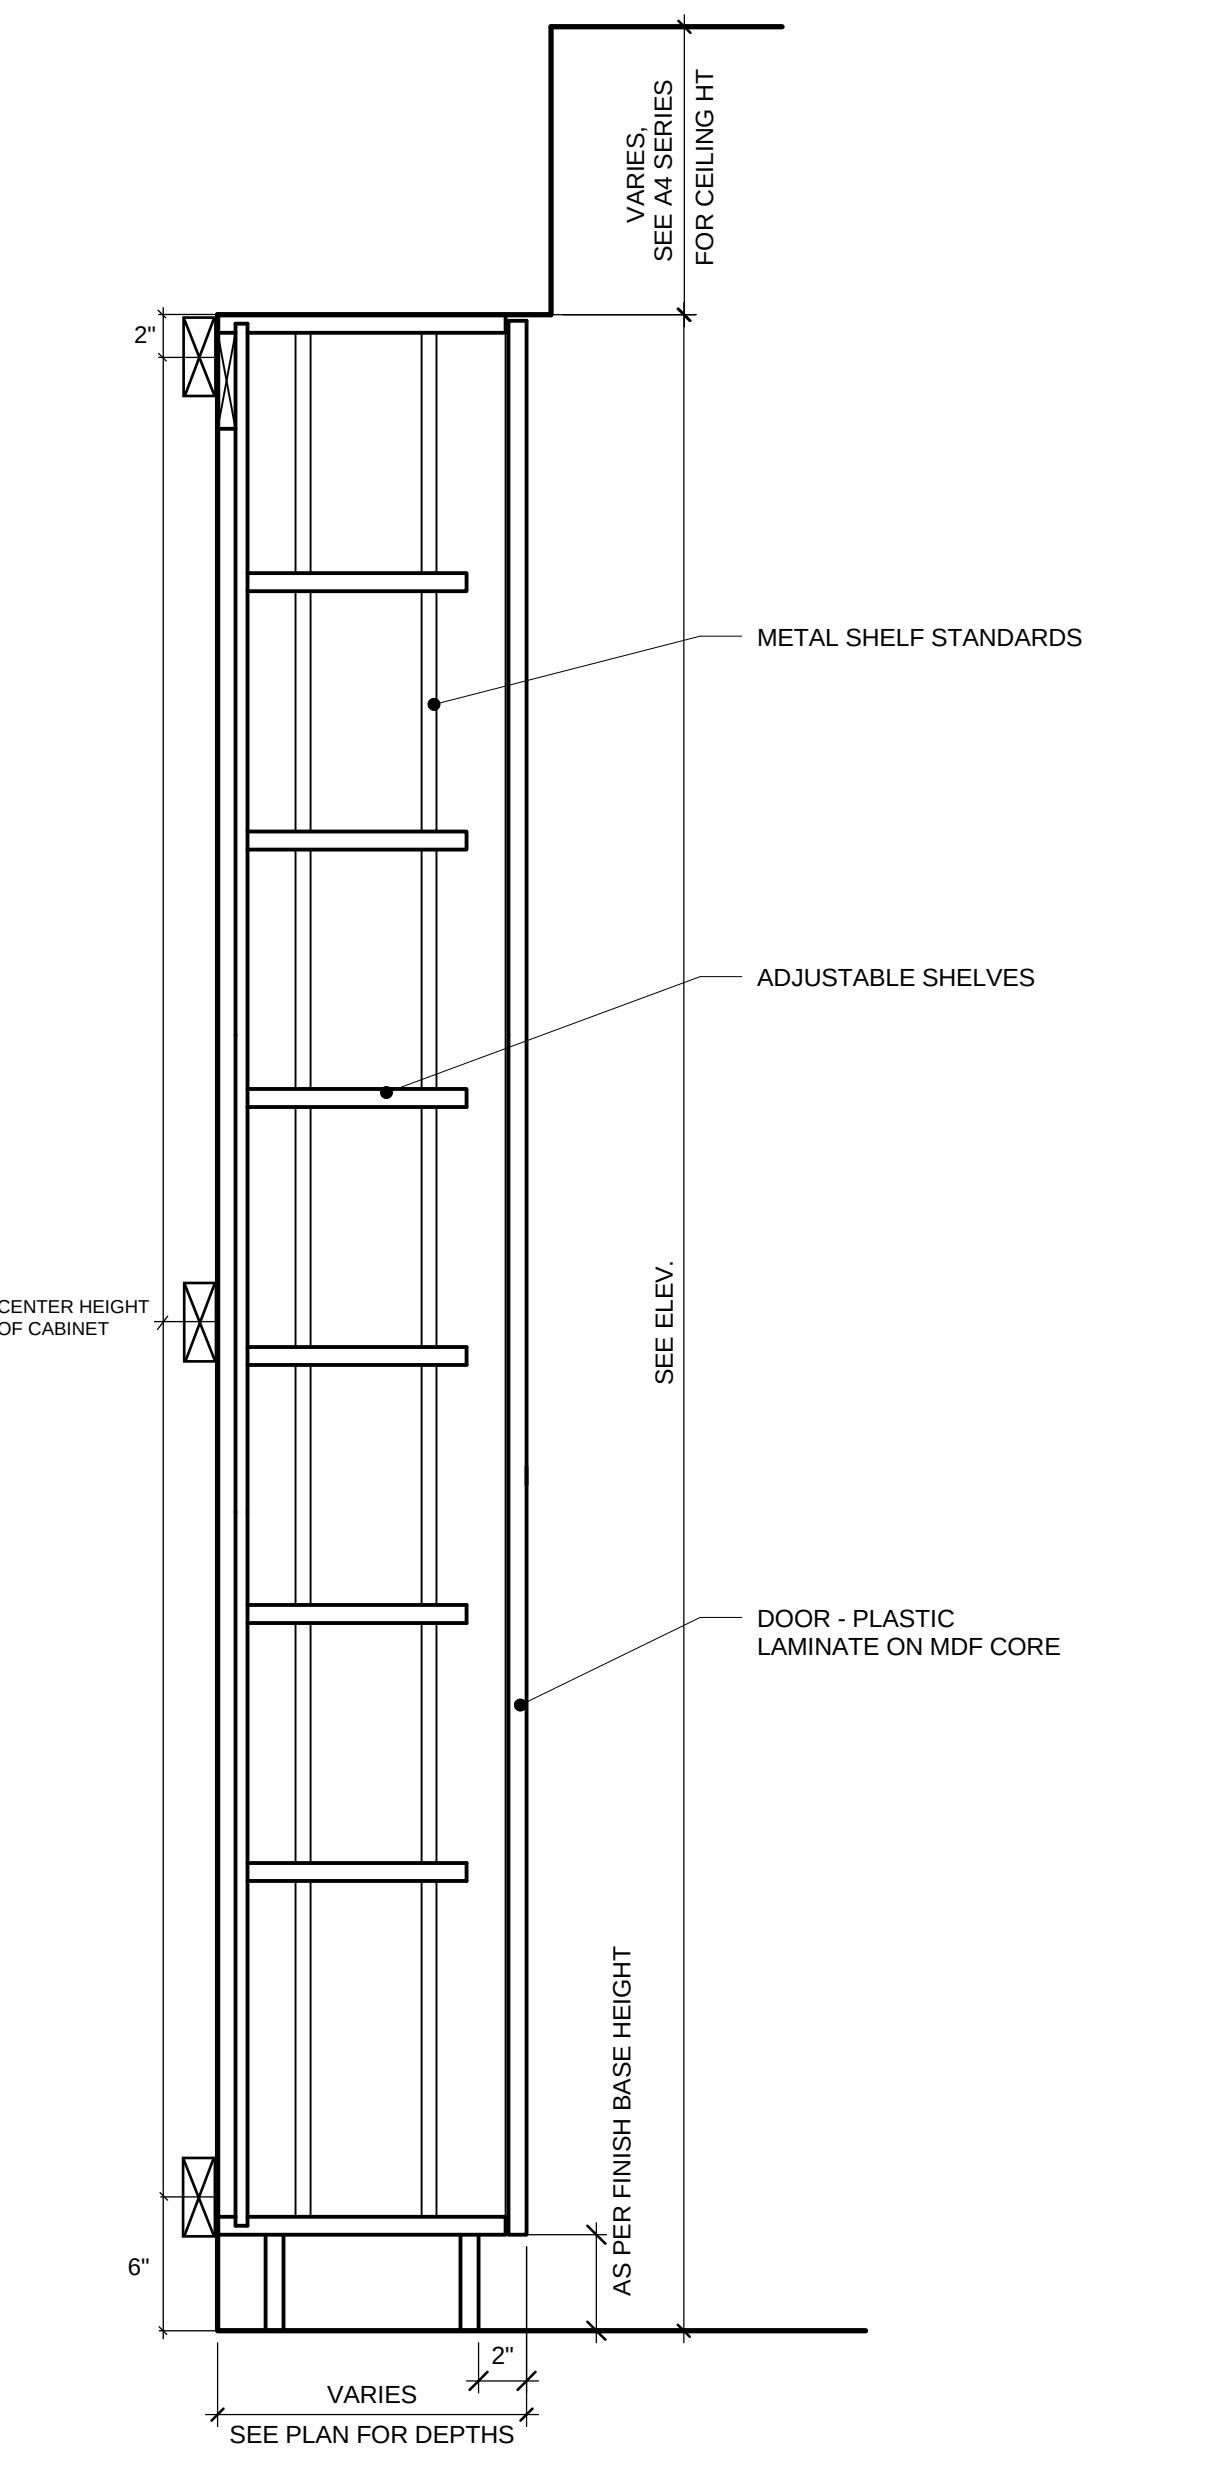


4 CASEWORK FULL HEIGHT CABINET

SCALE 1-1/2"=1'-0" CODE
NUMBER 123500-XX-X SPEC
DATE 08/28/03

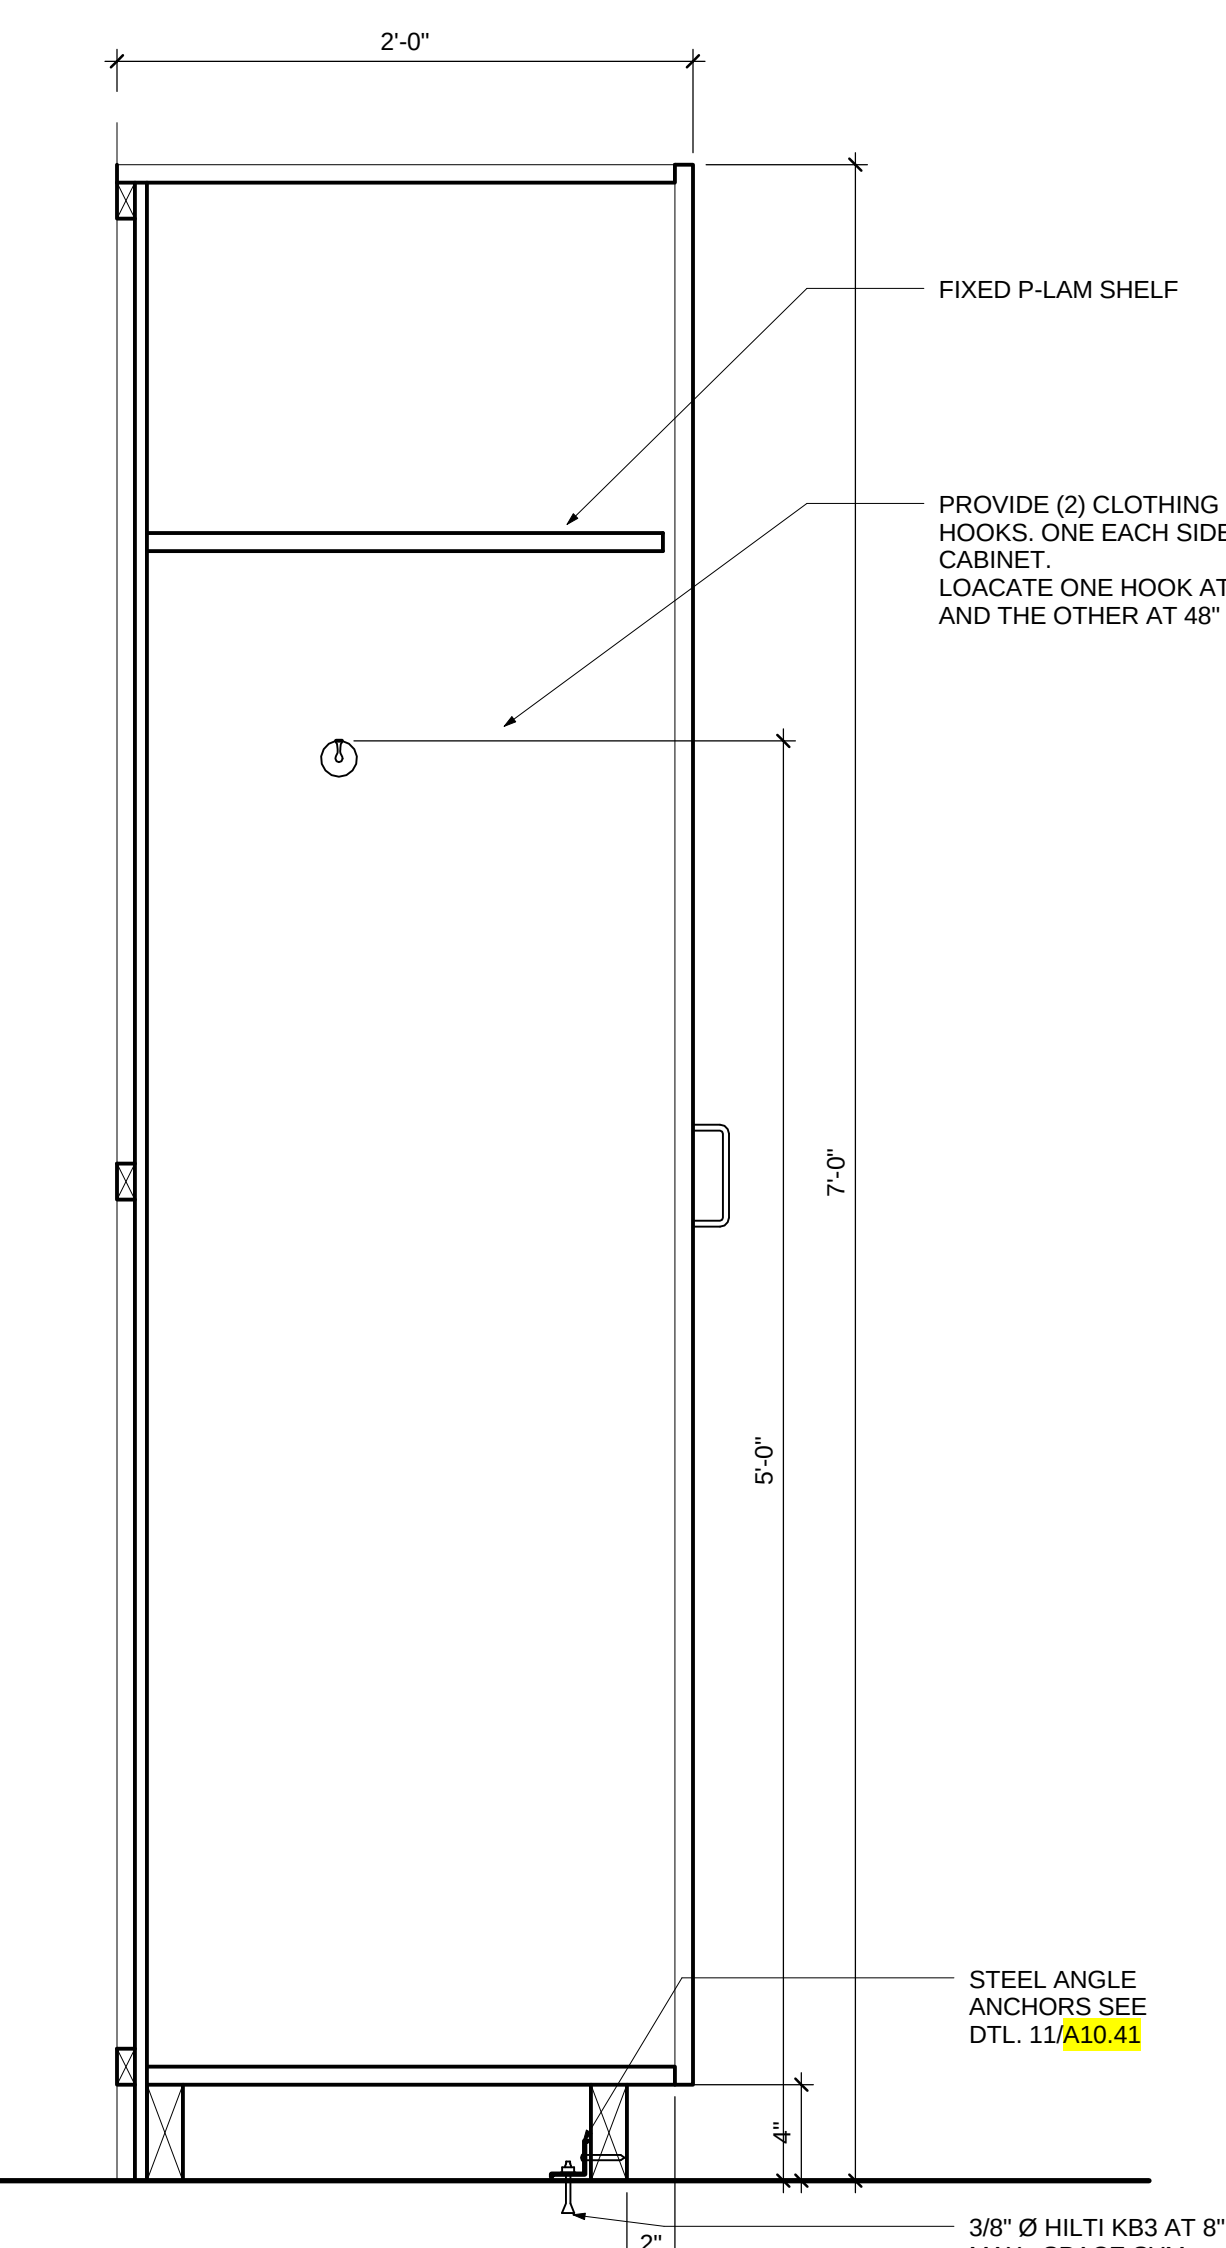


1 WARDROBE CABINET

SCALE 1-1/2"=1'-0" CODE
NUMBER 123500-XX-X SPEC
DATE 08/28/03

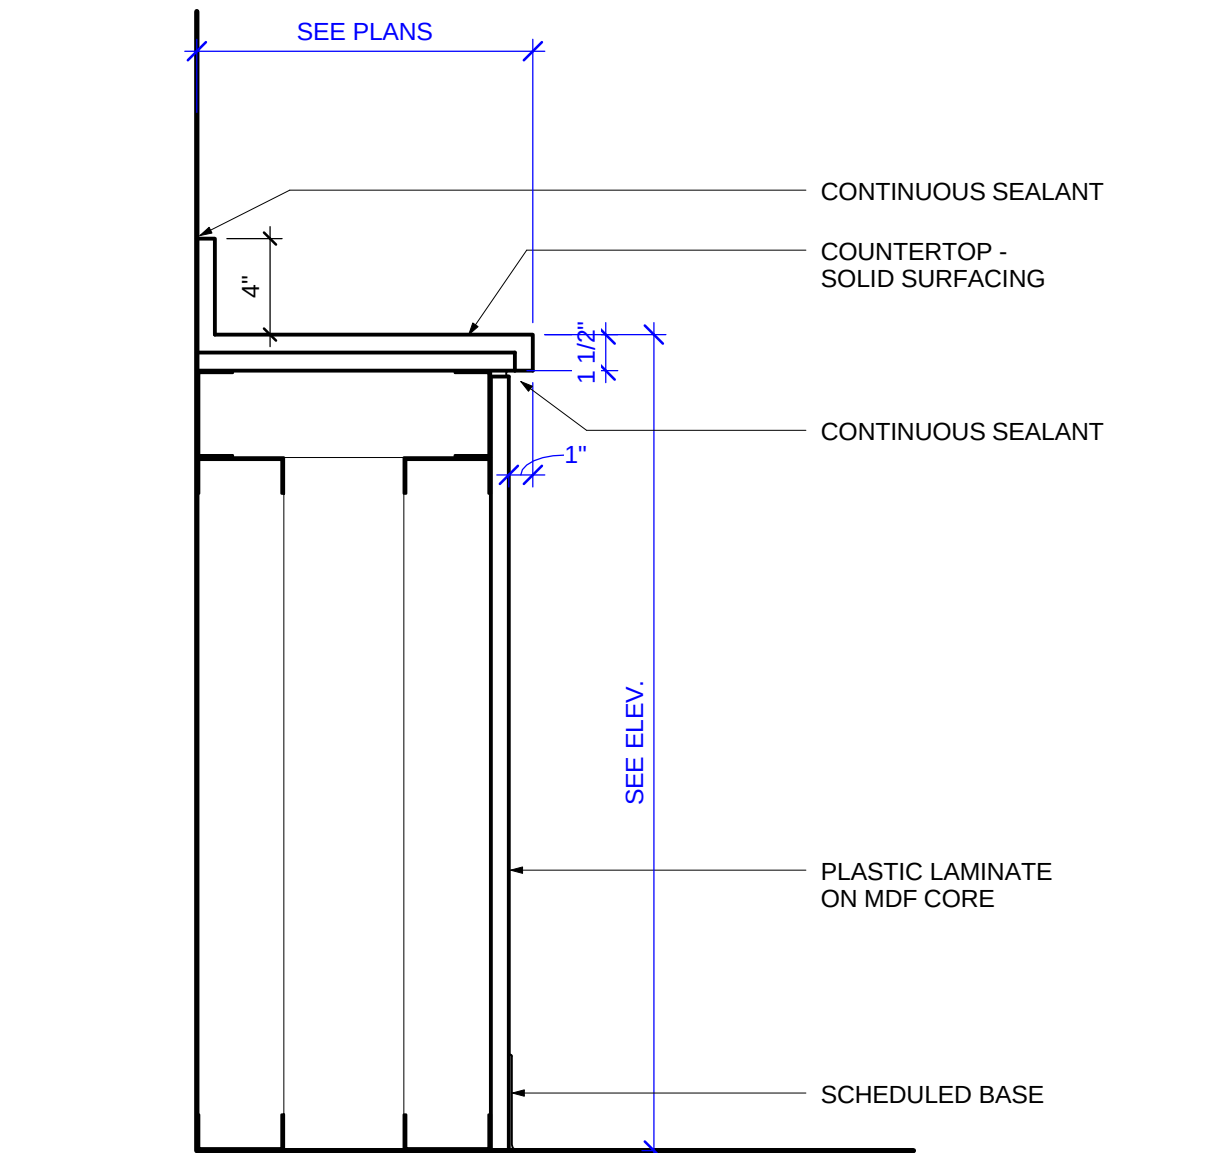


10 SOLID SURFACE STILL COUNTERTOP


SCALE 1 1/2" = 1'-0"

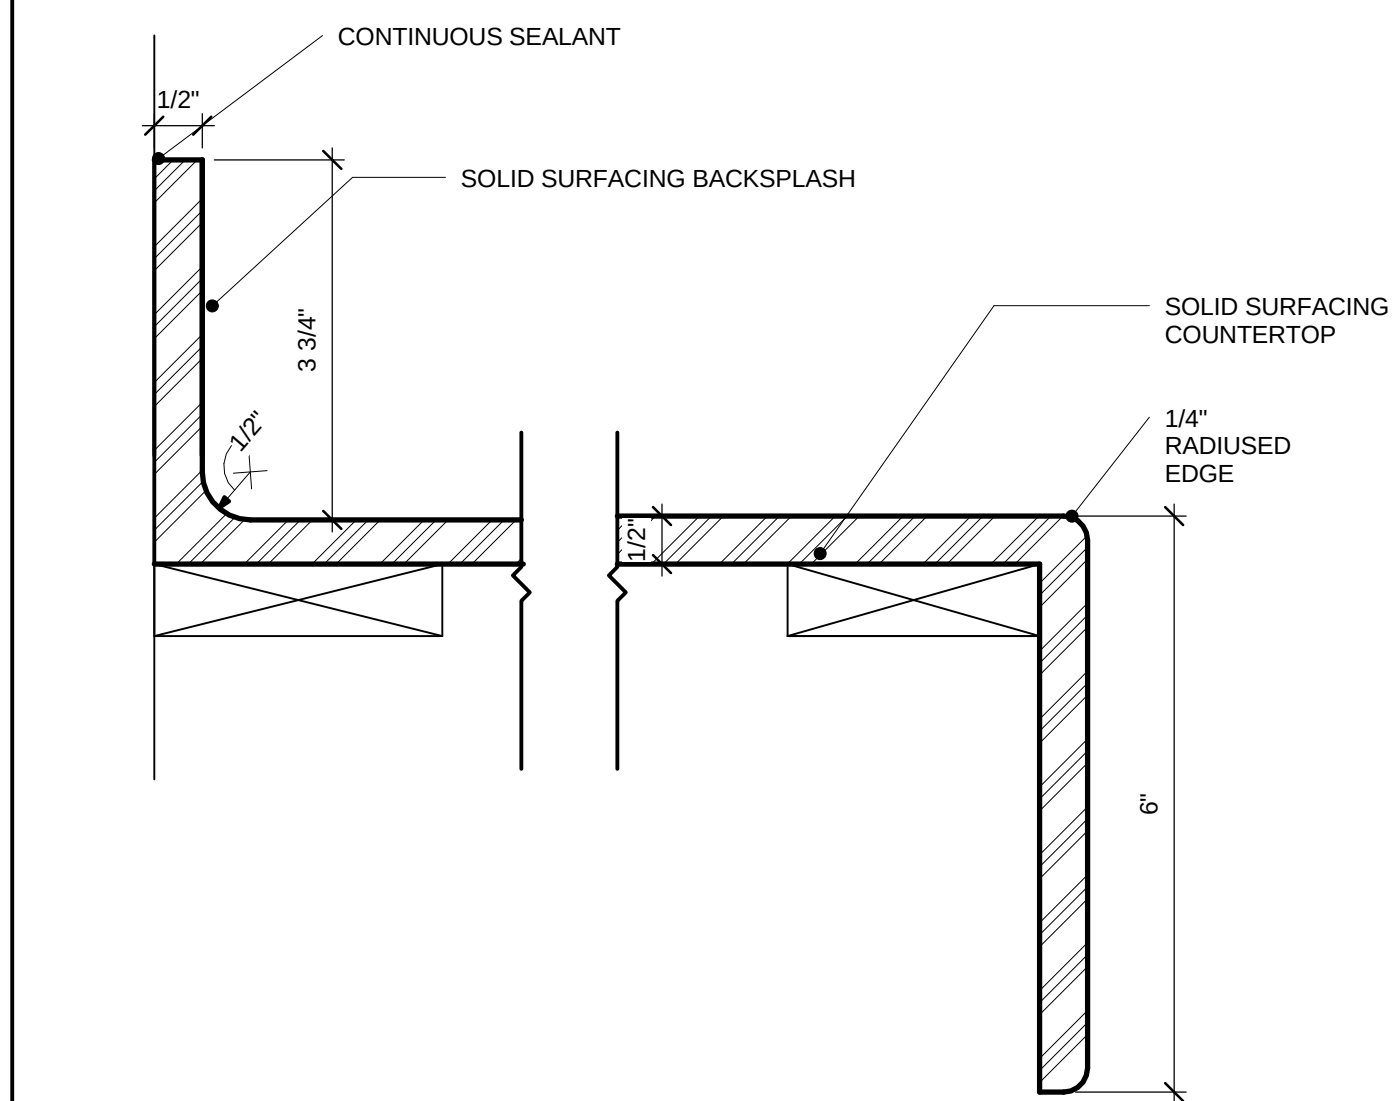


15 SOLID SURFACE COUNTERTOP DETAIL
SCALE 6"=1'-0"

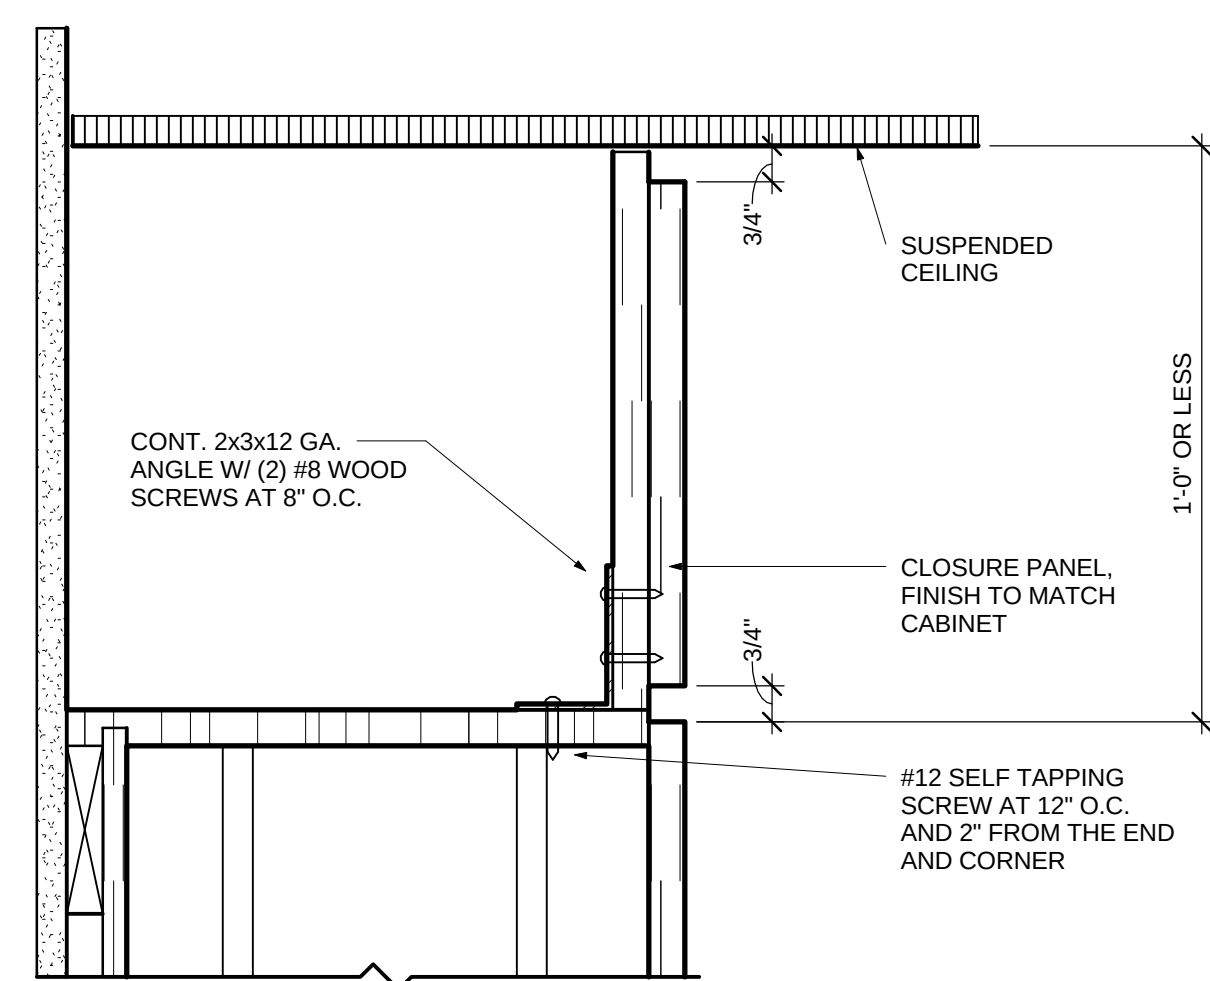


12 PANEL CLOSURE - 1'-0" OR LESS
SCALE 3"=1'-0"
NUMBER 123500-40-GS
DATE 08/28/03
CODE SPEC

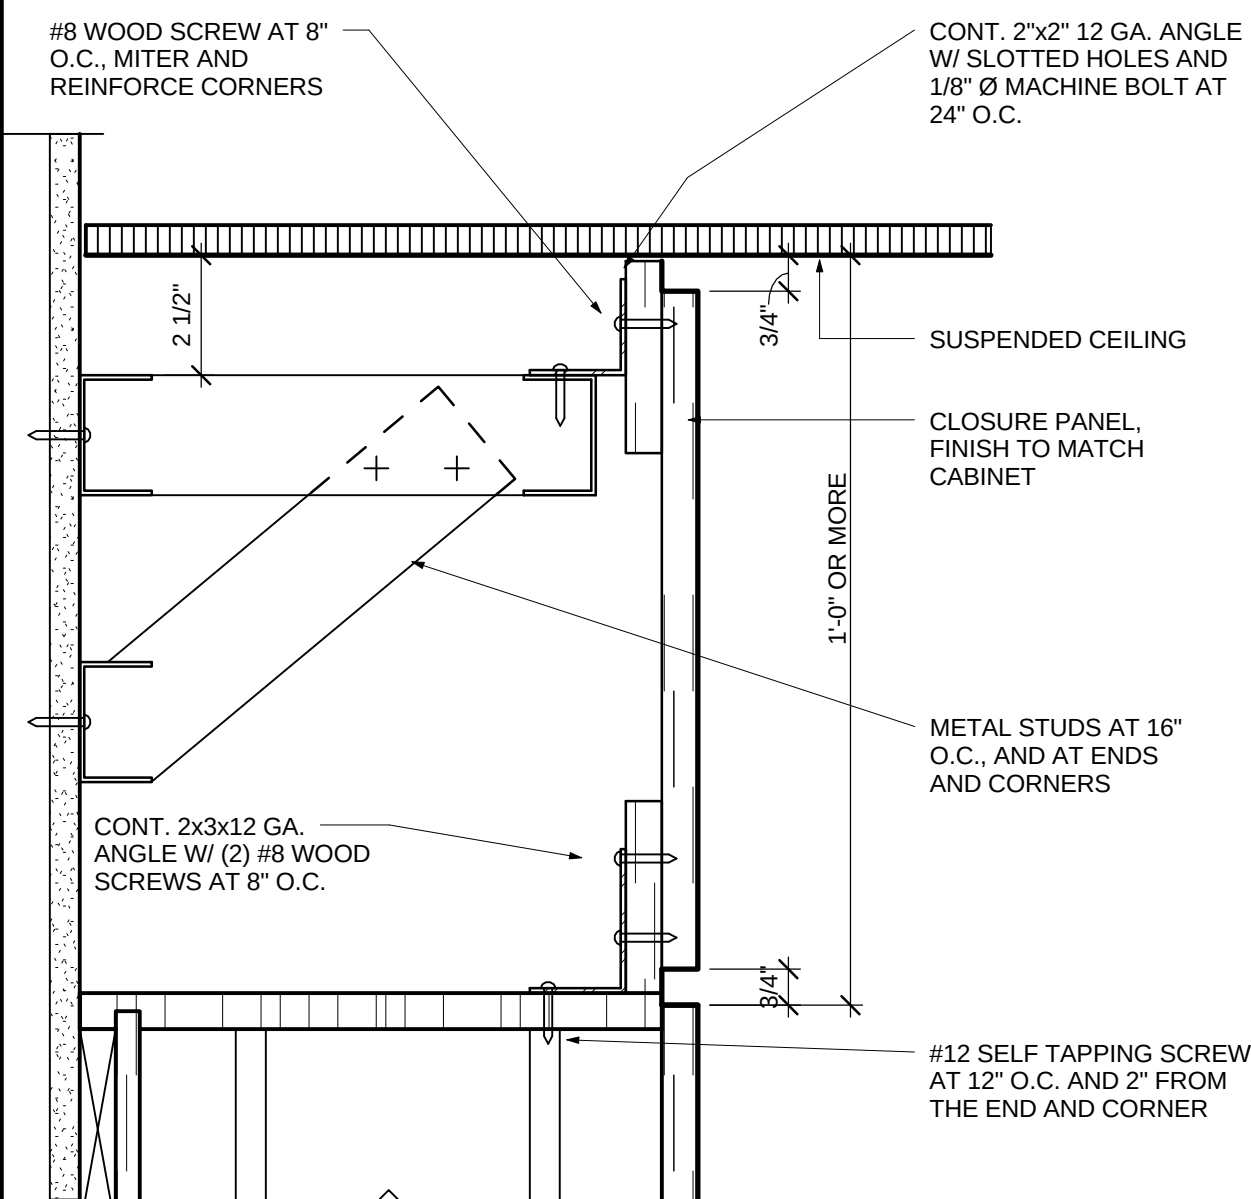


9 PANEL CLOSURE - GREATER THAN 1'-0"
SCALE 3"=1'-0"
NUMBER 123500-41-GS
DATE 08/28/03
CODE SPEC

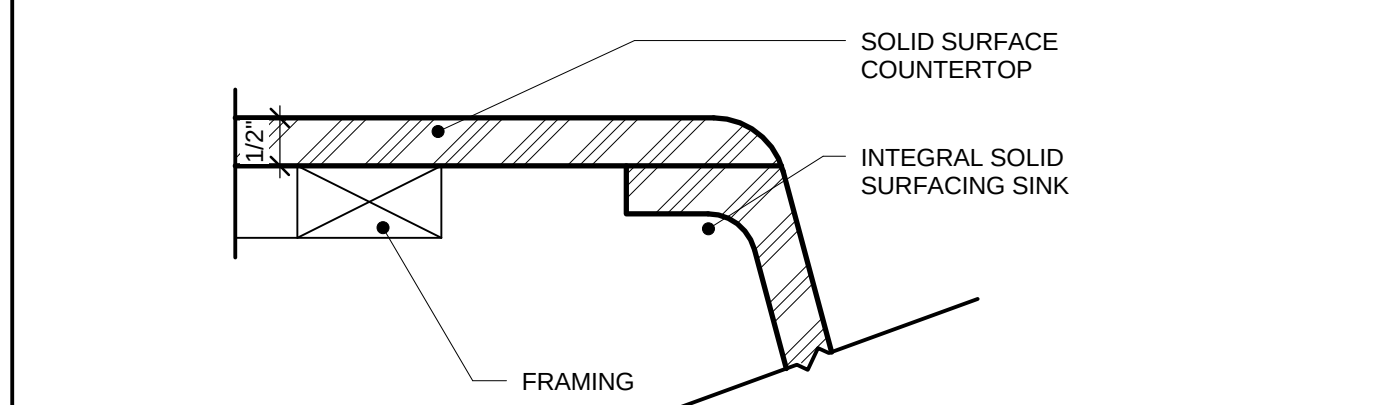


14B SOLID SURFACE COUNTERTOP W SINK
SCALE 6"=1'-0"

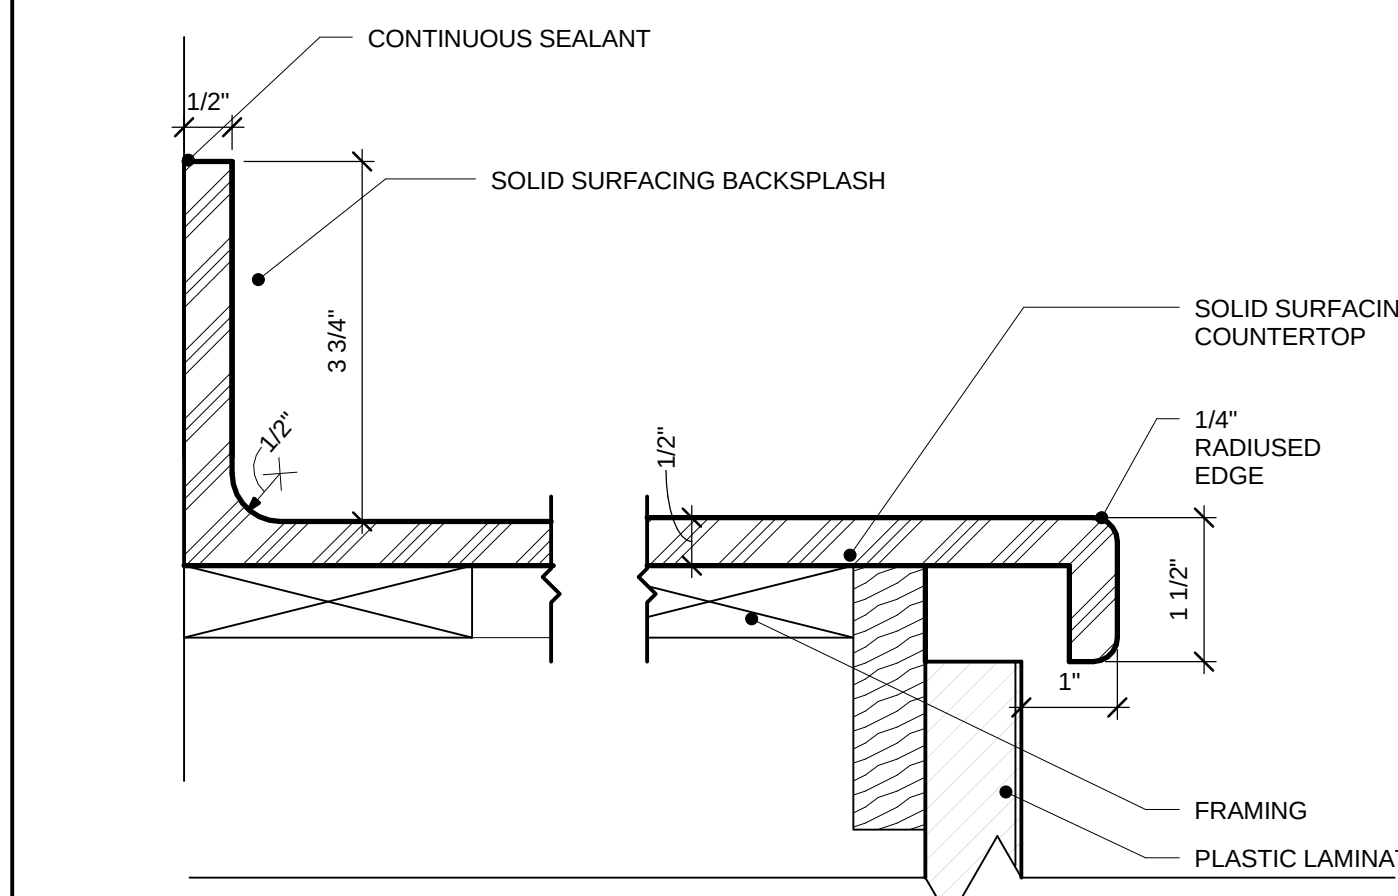


14A SOLID SURFACE COUNTERTOP
SCALE 6"=1'-0"
CS-1080-1

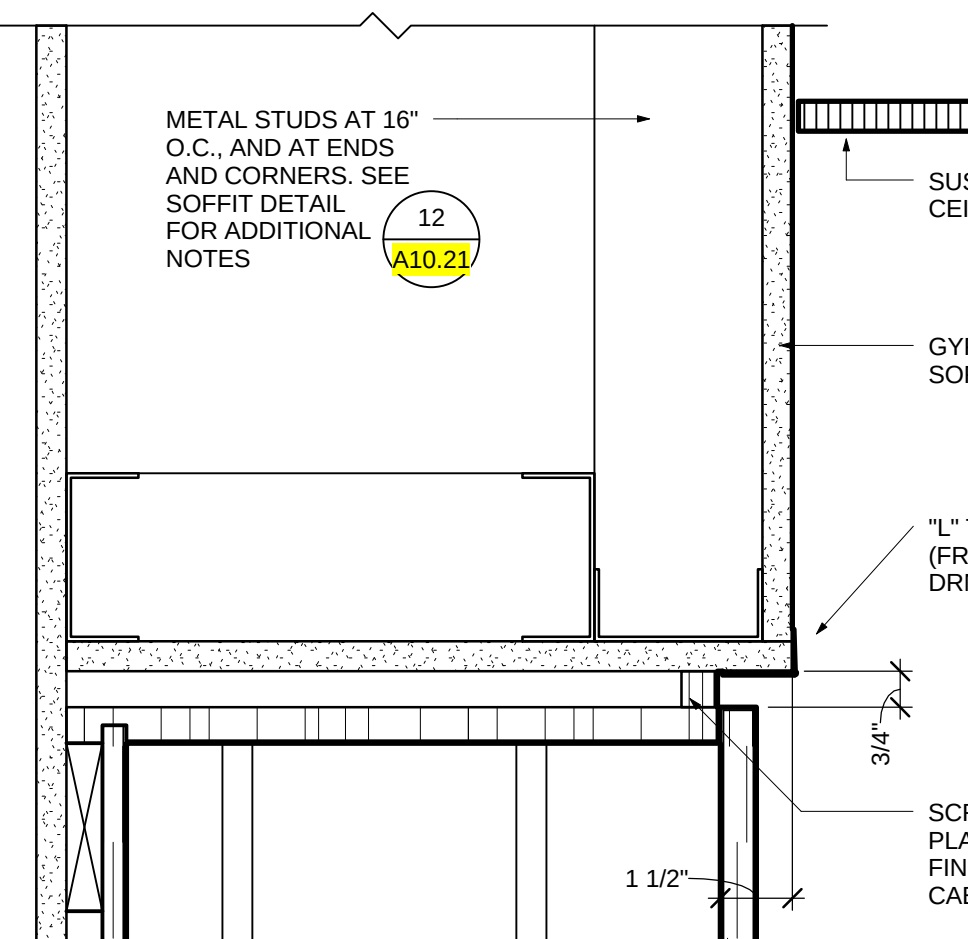


11 WALL CABINET AT SOFFIT
SCALE 3"=1'-0"
NUMBER 123500-43-GS
DATE 08/28/03
CODE SPEC

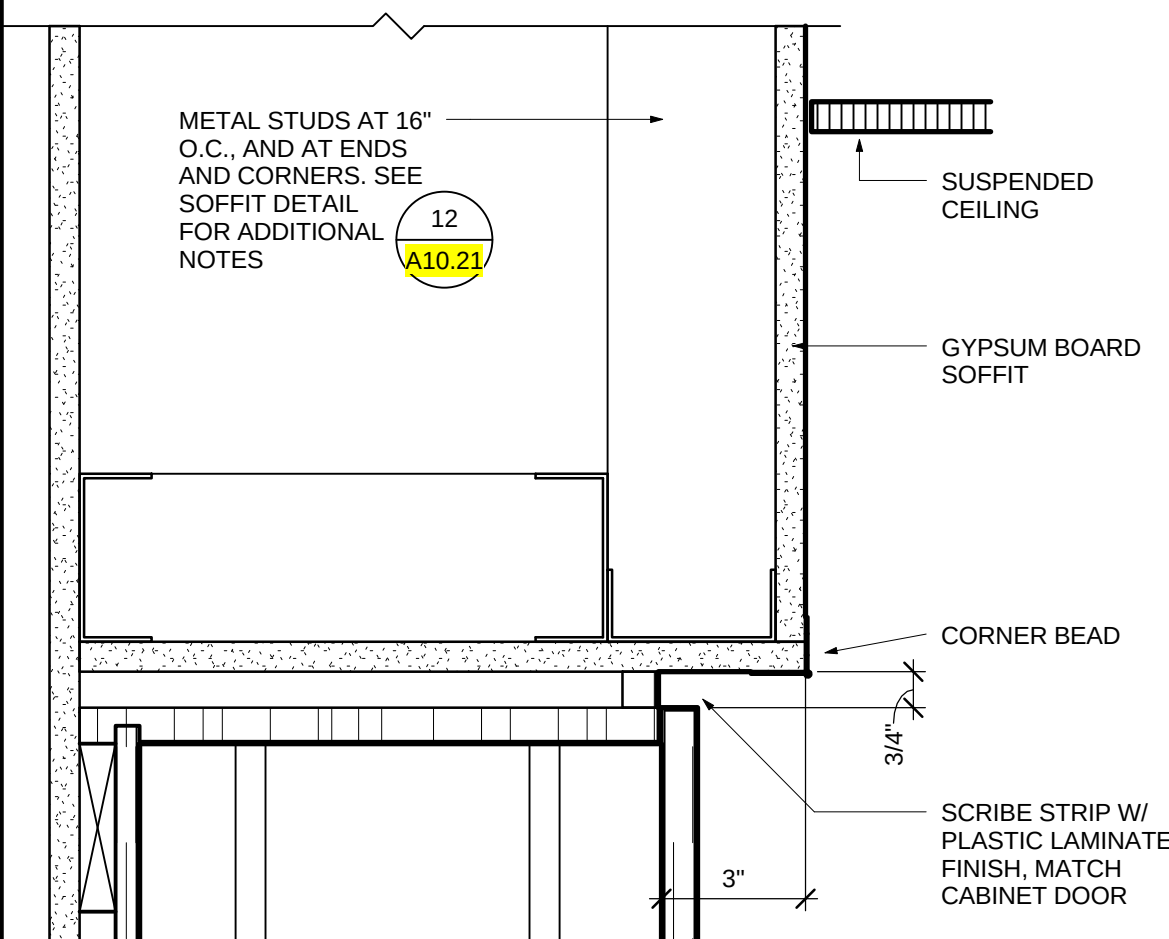


8 WALL CABINET AT SOFFIT
SCALE 3"=1'-0"
NUMBER 123500-42-GS
DATE 08/28/03
CODE SPEC

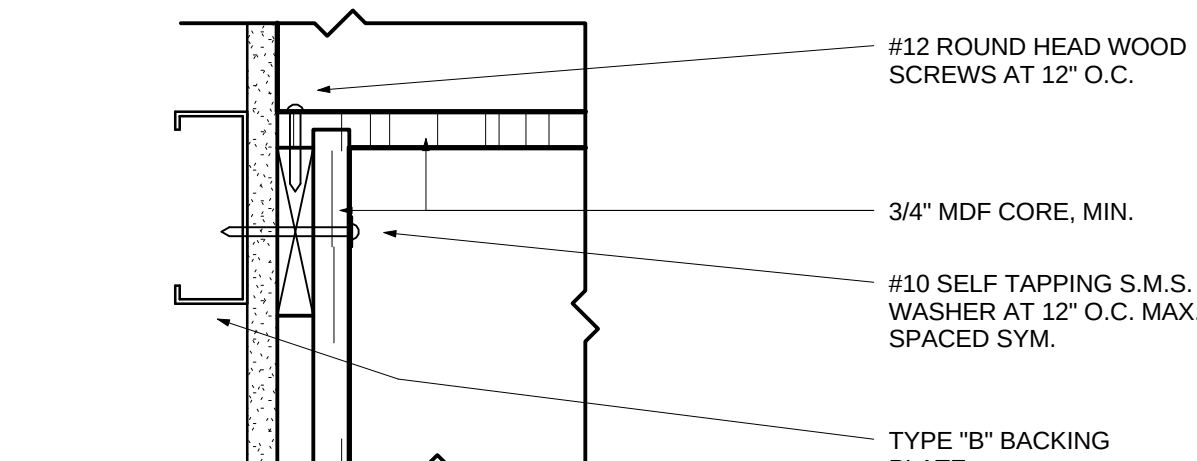


5 UPPER CASEWORK SEISMIC ANCHORAGE (OSHPD)
SCALE 3"=1'-0"
NUMBER 123500-04-GS
DATE 08/28/03
CODE SPEC

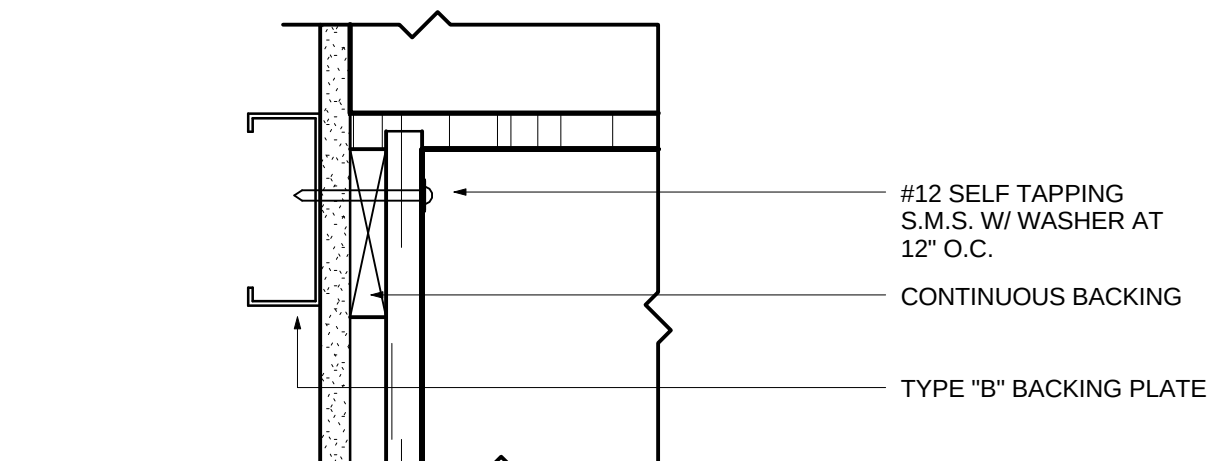


2 UPPER CASEWORK ANCHORAGE
SCALE 3"=1'-0"
NUMBER 123500-02-GS
DATE 08/28/03
CODE SPEC

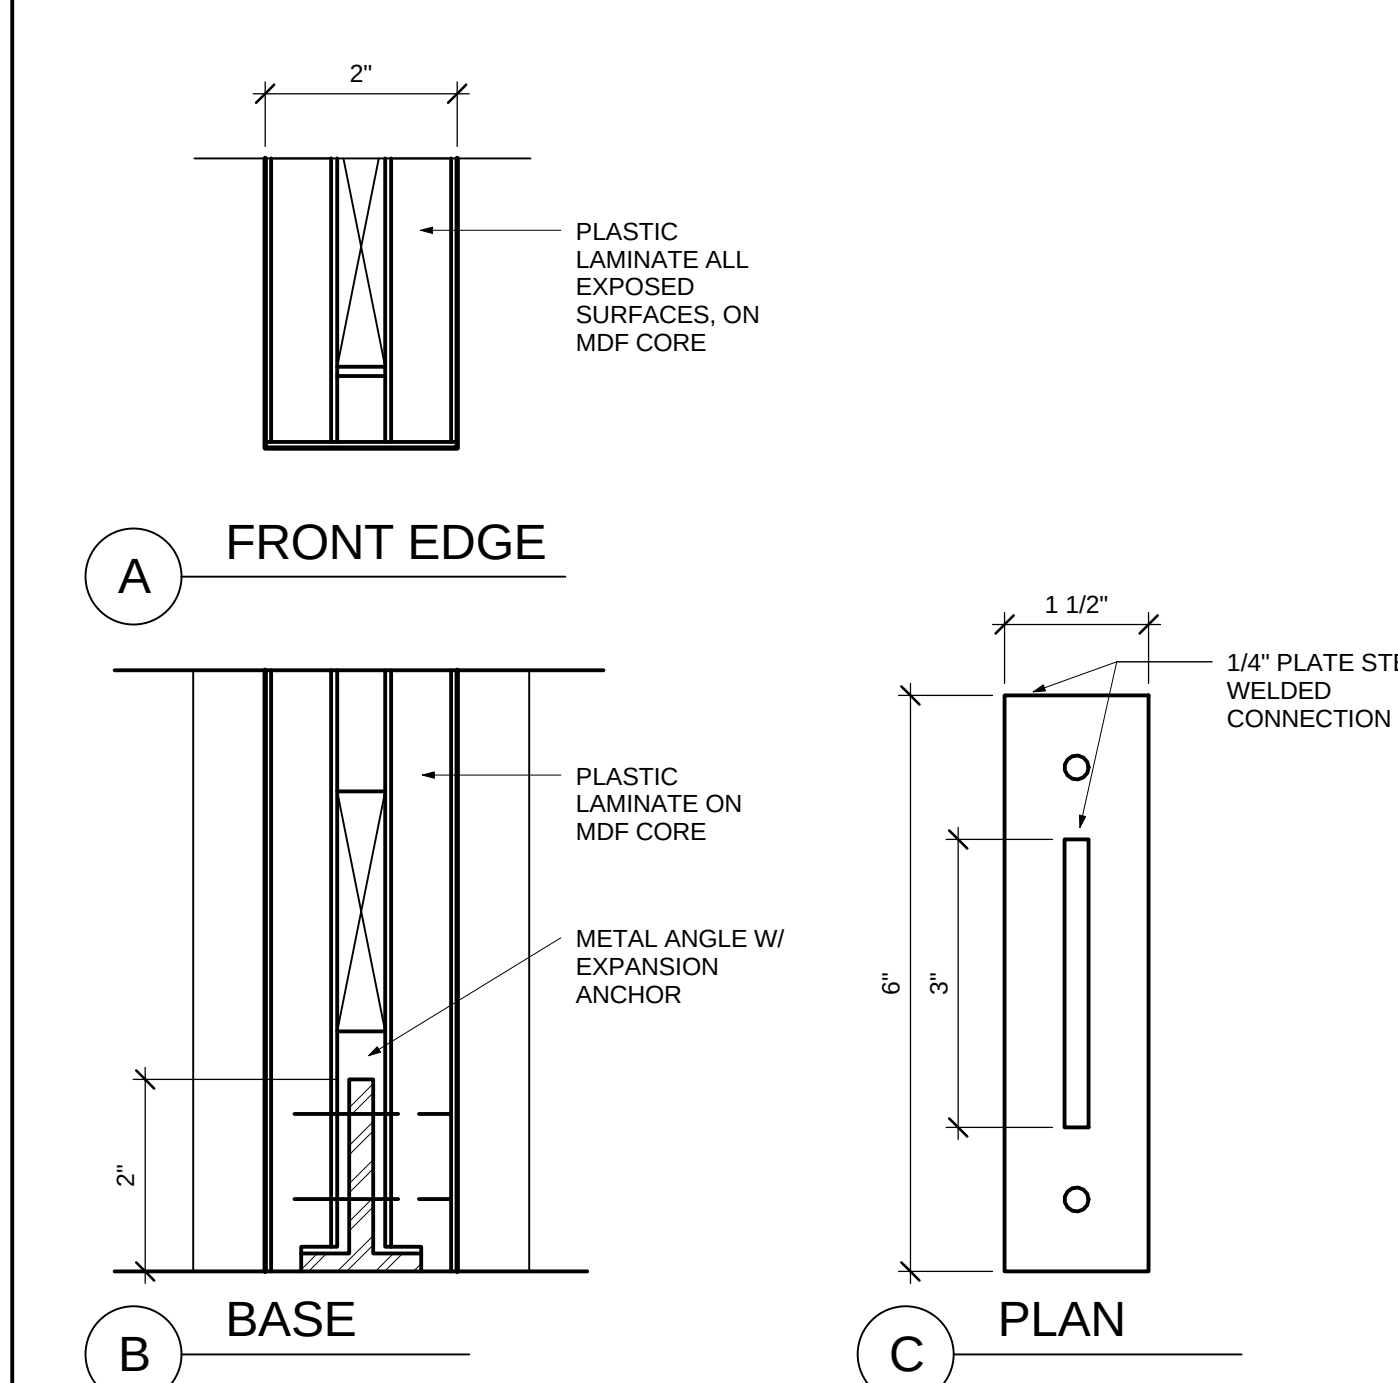


13 DETAIL AT SUPPORT PANEL
SCALE 6"=1'-0"
NUMBER 123500-44-GS
DATE 08/28/03
CODE SPEC

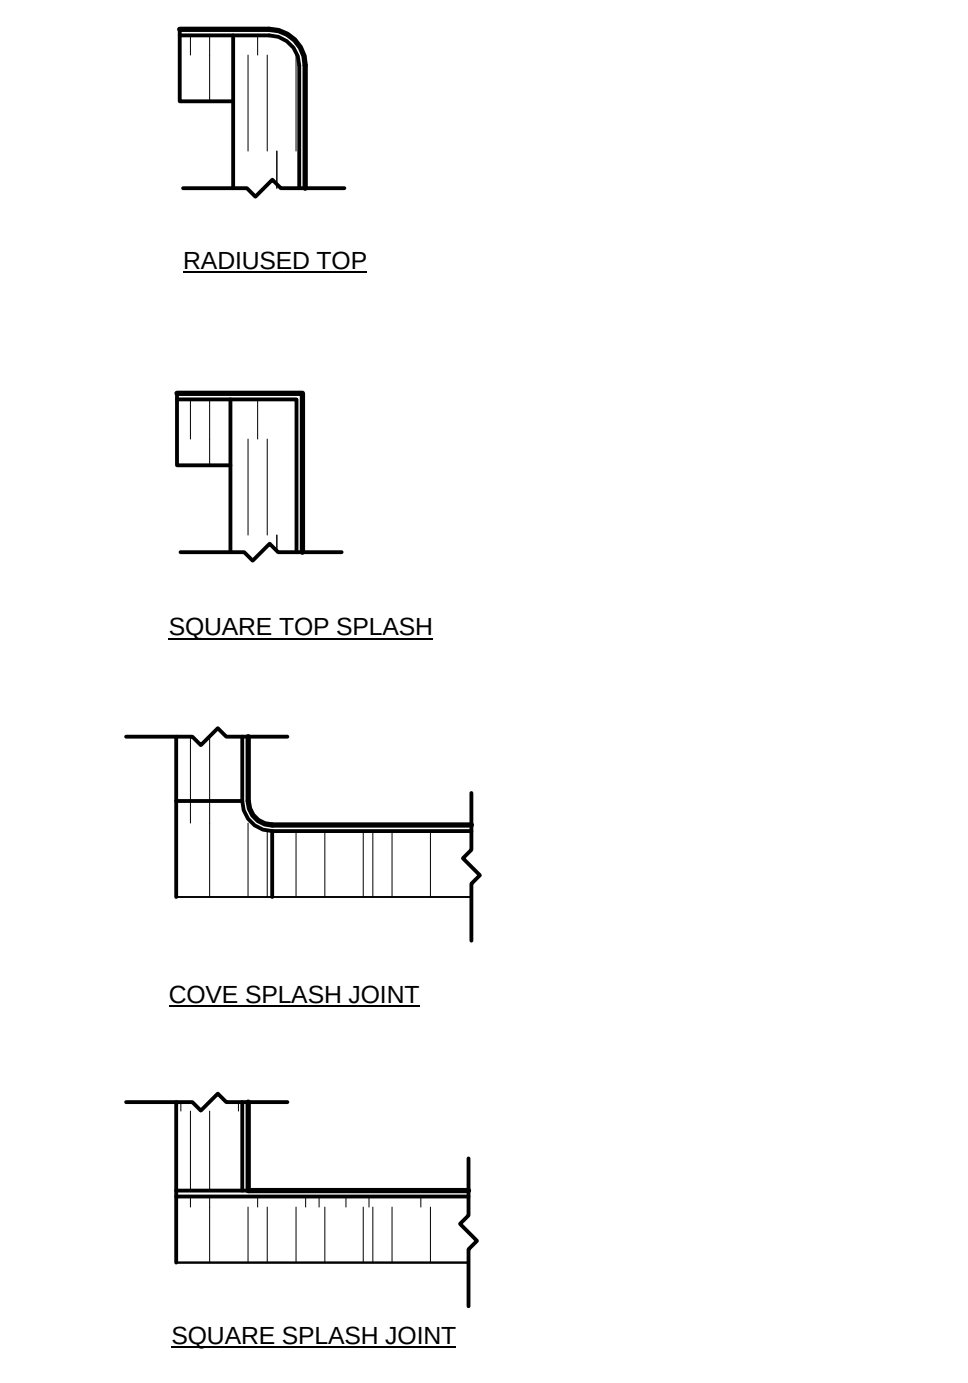


10 P. LAM. COUNTERTOP SPLASH OPTIONS
SCALE 6"=1'-0"
NUMBER 123500-51-GS
DATE 08/28/03
CODE SPEC

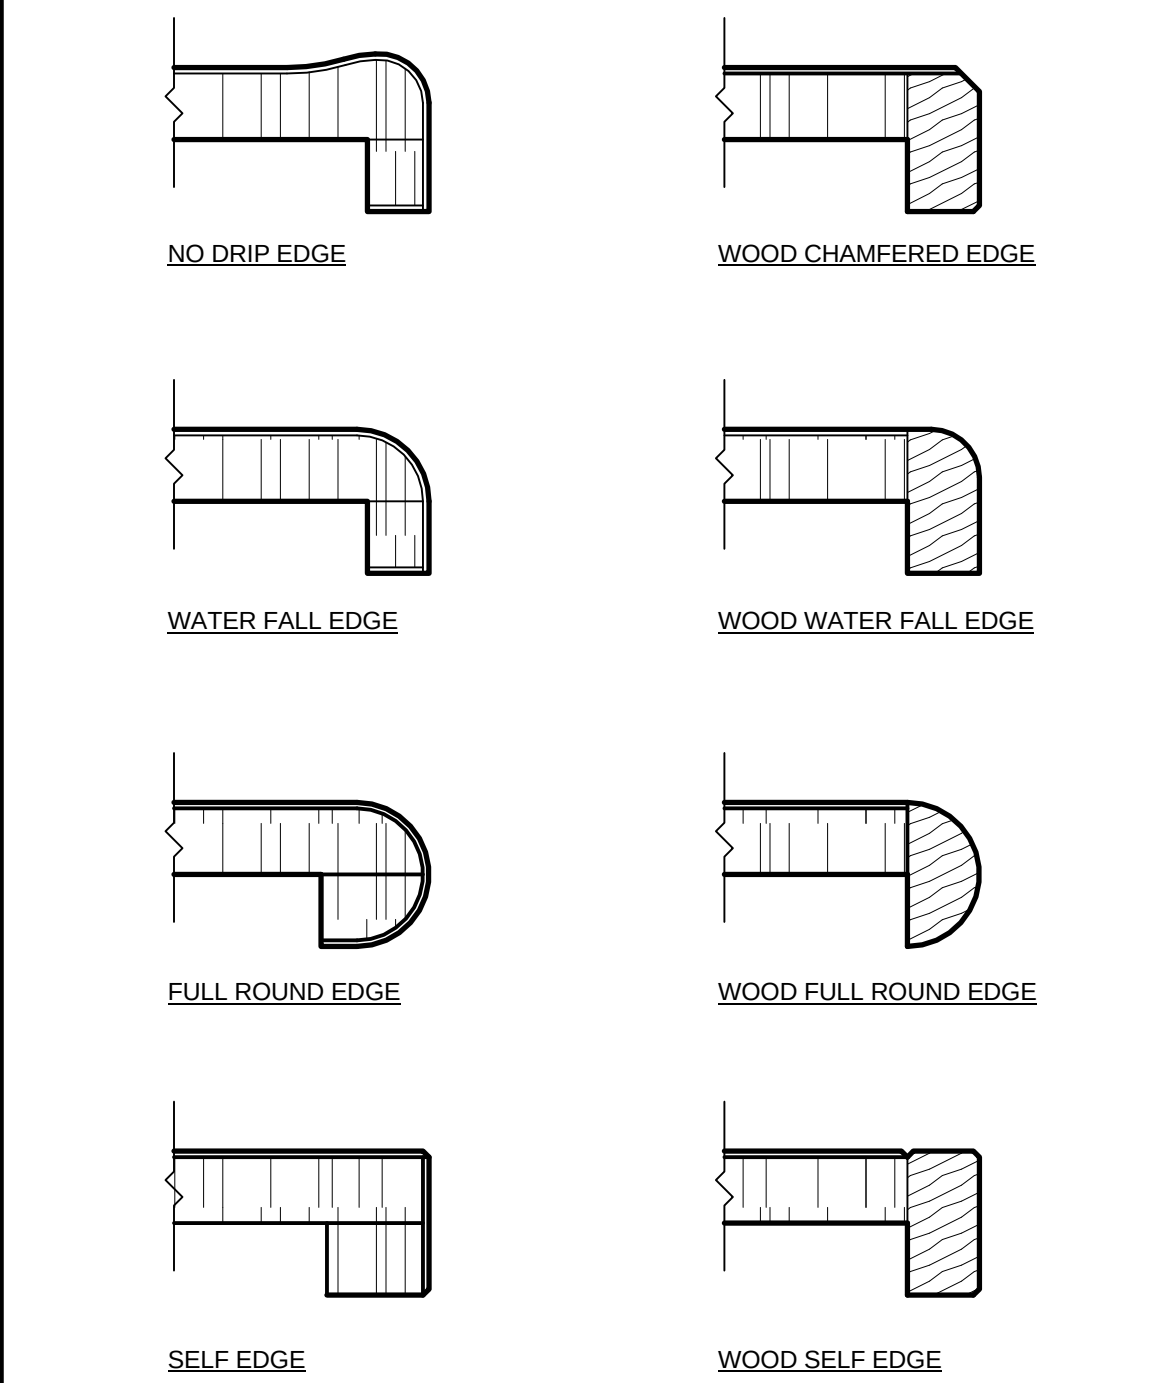

7 P. LAM. COUNTERTOP NOSING OPTIONS
SCALE 6"=1'-0"
NUMBER 123500-05-GS
DATE 08/28/03
CODE SPEC

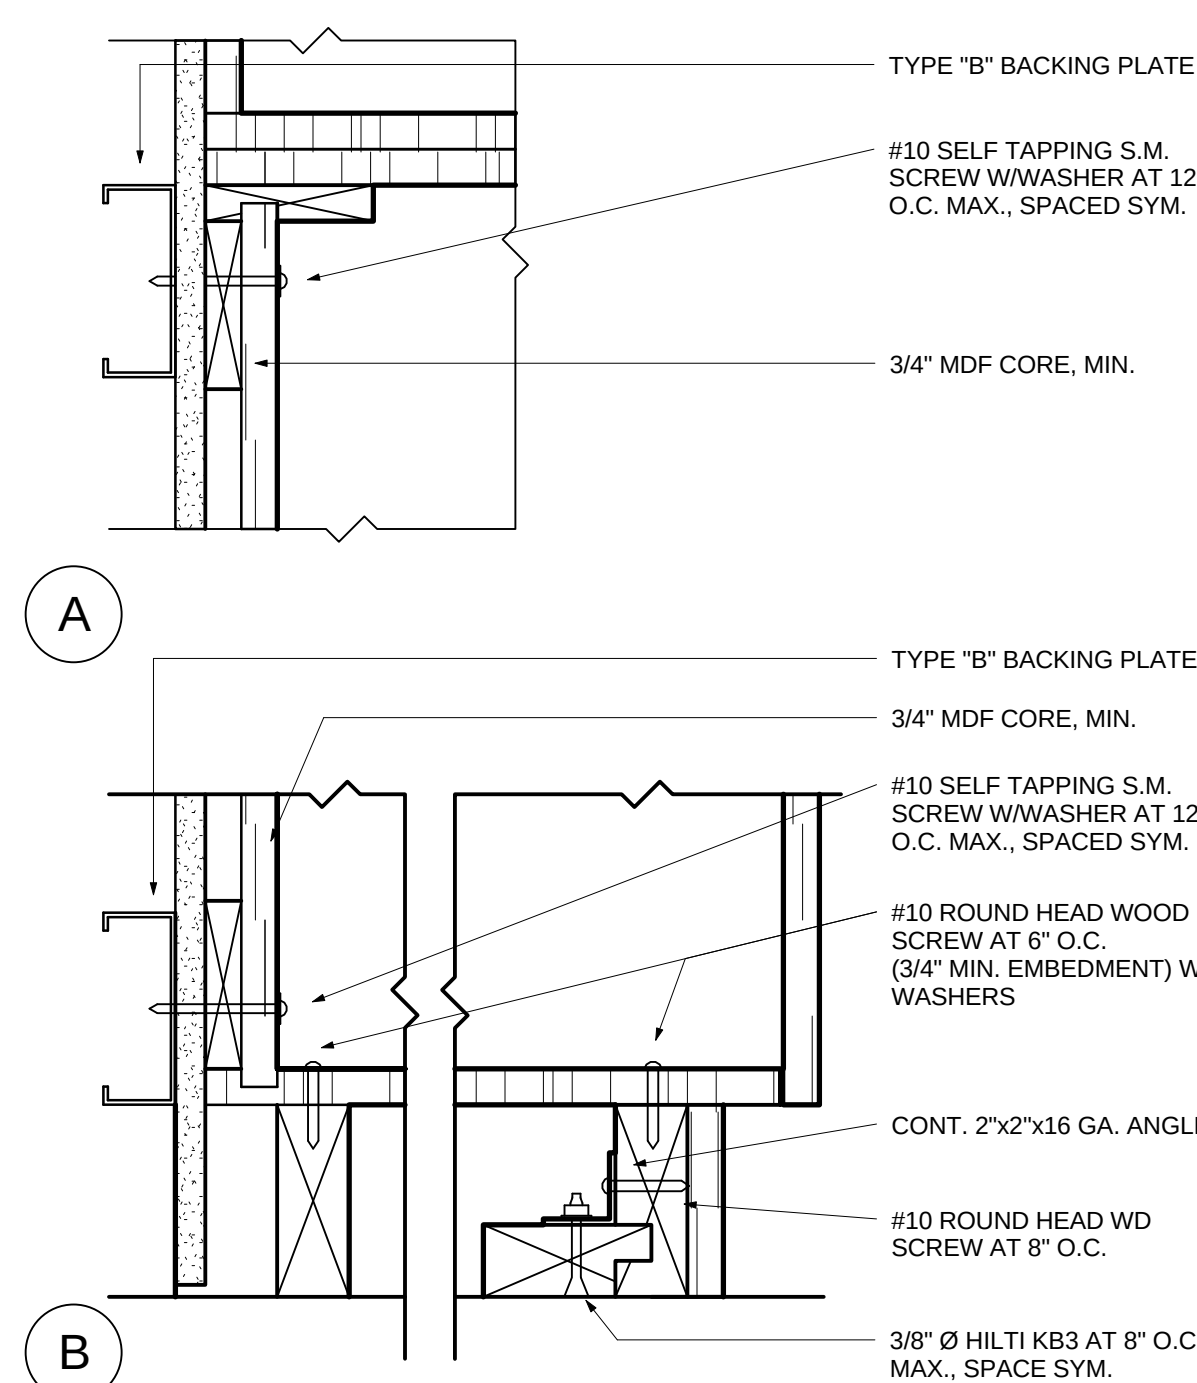

4 LOWER CASEWORK SEISMIC ANCHORAGE (OSHPD)
SCALE 3"=1'-0"
NUMBER 123500-05-GS
DATE 08/28/03
CODE SPEC

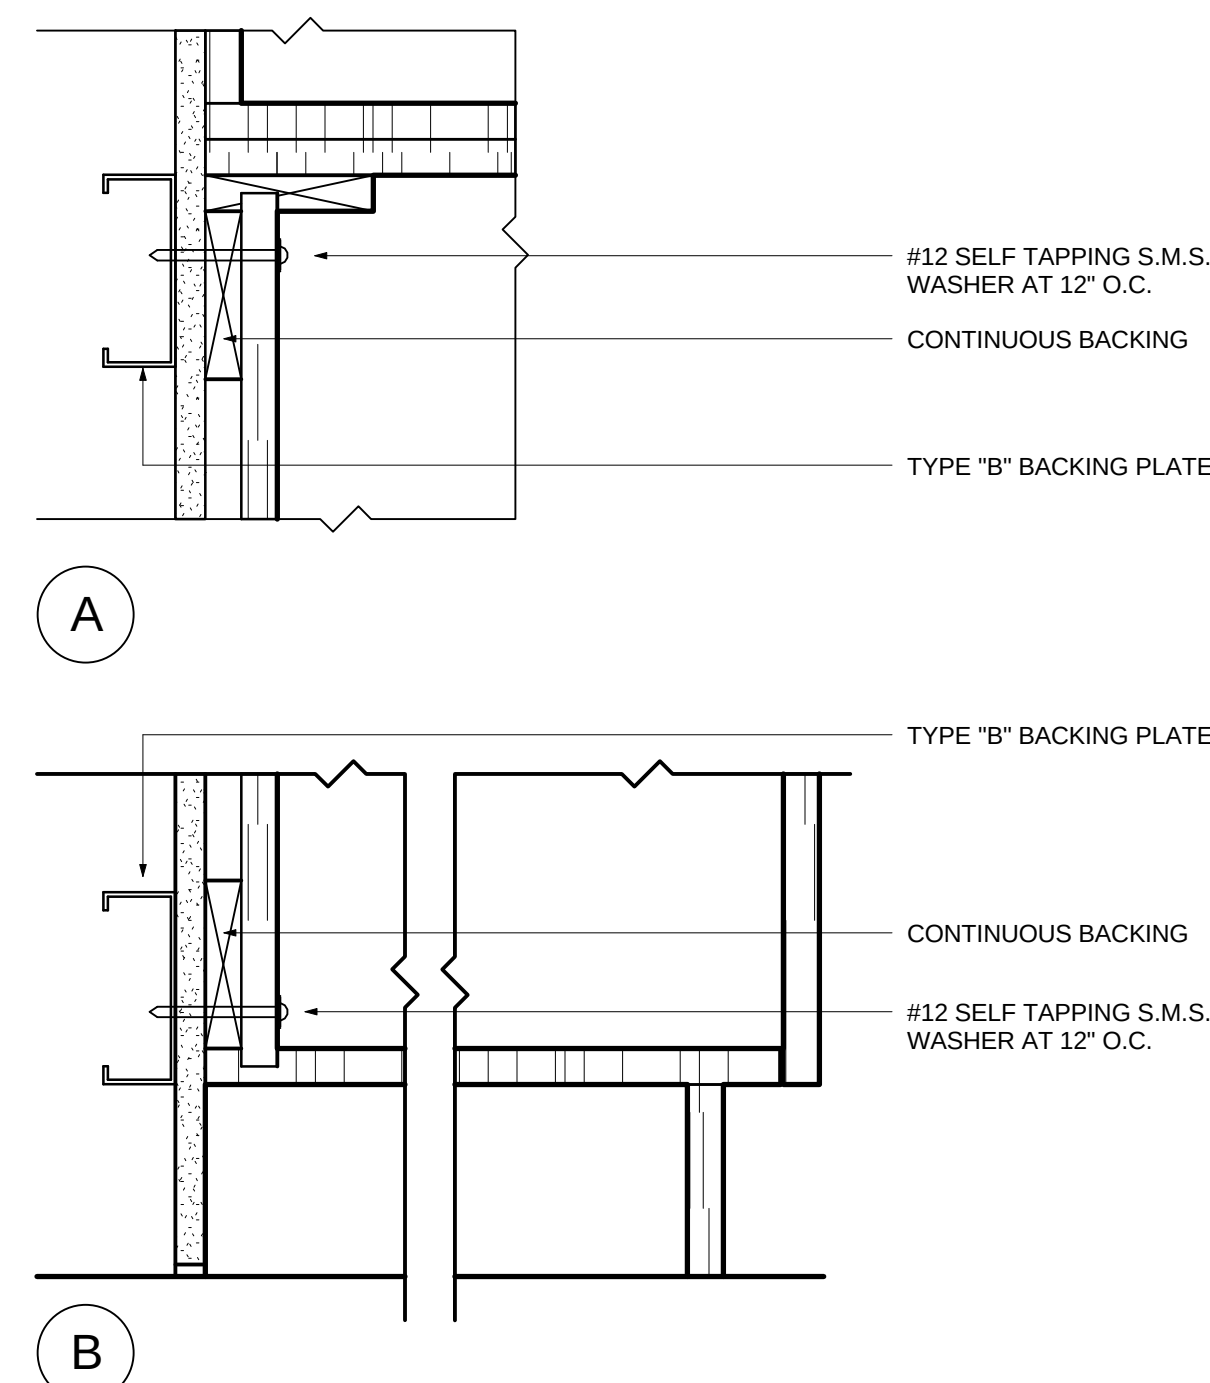

1 LOWER CASEWORK ANCHORAGE
SCALE 3"=1'-0"
NUMBER 123500-03-GS
DATE 08/28/03
CODE SPEC

