



Multidisciplinary
Research Building 1
Project No. 950528



50 SOUTH HOPE STREET
SUITE 1950
LOS ANGELES, CA 90071
310.228.6900
www.smithgroupjjr.com

- A. REFER TO THE A0 X SERIES SHEETS FOR ARCHITECTURAL GENERAL NOTES, DRAWING, REFERENCE AND MATERIAL SYMBOLS, OBSERVATIONS, AS WELL AS DIMENSIONING CONVENTIONS USED ON THIS SHEET.
- B. REFER TO AND COORDINATE WITH STRUCTURAL, MECHANICAL, AND ELECTRICAL DRAWINGS FOR ADDITIONAL INFORMATION NOT SHOWN ON THIS SHEET.
- C. FOR BASIC LIFE SAFETY AND CODE INFORMATION APPLYING TO THIS PROJECT, REFER TO THE G2 X SERIES SHEETS LOCATED PER THE PROJECT SHEET INDEX.
- D. REFER TO THE "REFERENCE/ELEVATION DEFINITIONS" LOCATED IN THE A0 X SERIES SHEETS FOR ROOF ELEVATION DEFINITIONS.
- E. REFER TO THE A5 X SERIES SHEETS FOR ROOFING DETAILS.
- F. ROOF ASSEMBLIES SHALL BE MINIMUM OF CLASS B FIRE CLASSIFICATION, OR AS SPECIFIED IN THE PROJECT MANUAL.
- G. ALL SLOPES TO BE 1/4" PER FOOT MIN. U. N. O.
- H. ROOF INSULATION TO BE R-30 (R-25 AT DRAINS)

1. CALLOUTS TO EXTERIOR INFORMATION IS PROVIDED ON THE OVERALL PLANS. CALLOUTS TO INTERIOR INFORMATION IS LOCATED ON THE 1/8" PLANS. SEE A4.2.3 FOR CALLOUTS TO BELOW GRADE SECTIONS.
2. MEDICAL GAS STORAGE TO MEET CFC CH. 53-5306 REQUIREMENTS (TYPICAL)
3. BARRIER SUITE BOUNDARY LINE; THE AREA TRANSITION FROM LAB TO PUBLIC.

ISSUED FOR	REV	DATE
BULLETIN 10	10	05 OCT 2017
BULLETIN 9	9	24 AUG 2017
SP3 - IFC		27 JUN 2017
SP3 - CD 95%		25 APR 2017
OSA RECORD SET		28 MAR 2017
SP3 - CD 75%		14 FEB 2017
SP3 - CD 65%		09 NOV 2016
DESIGN DEVELOPMENT 100%		19 AUG 2016



SHEET TITLE

ROOF - OVERALL PLAN


21377.000

PROJECT NUMBER






SHEET NUMBER _____



Plot Date: 10/5/2017 5:02:29 PM Author

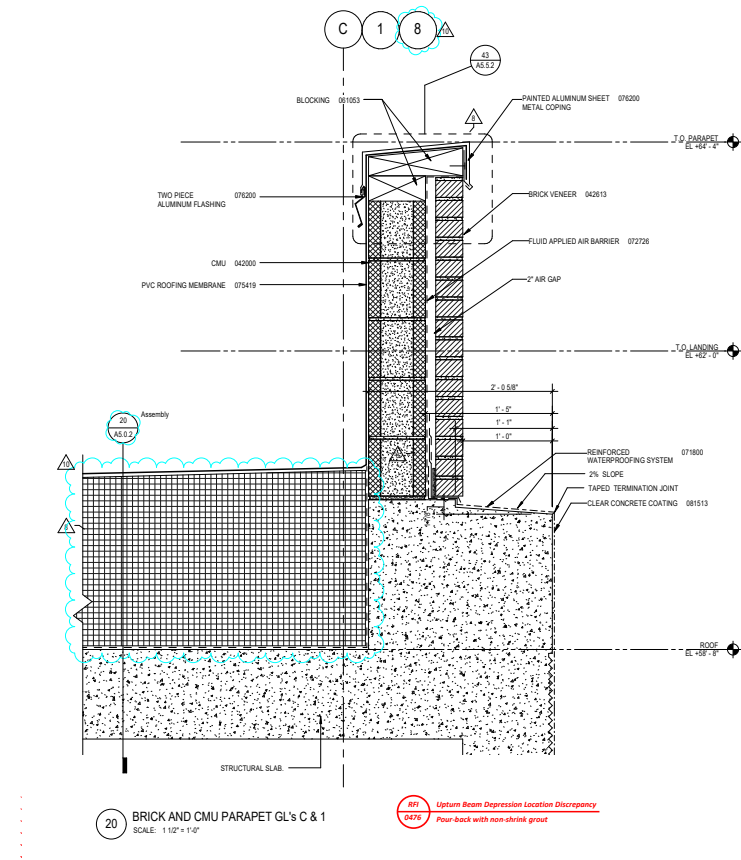


34 BRICK PARAPET - 1
SCALE: 1 1/2" = 1'-0"

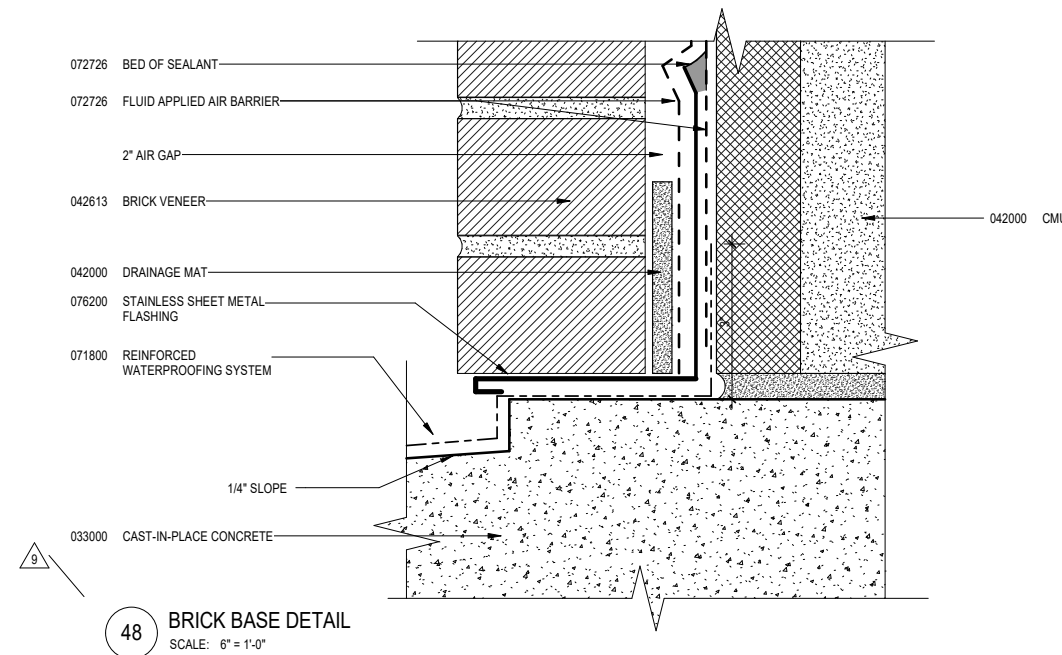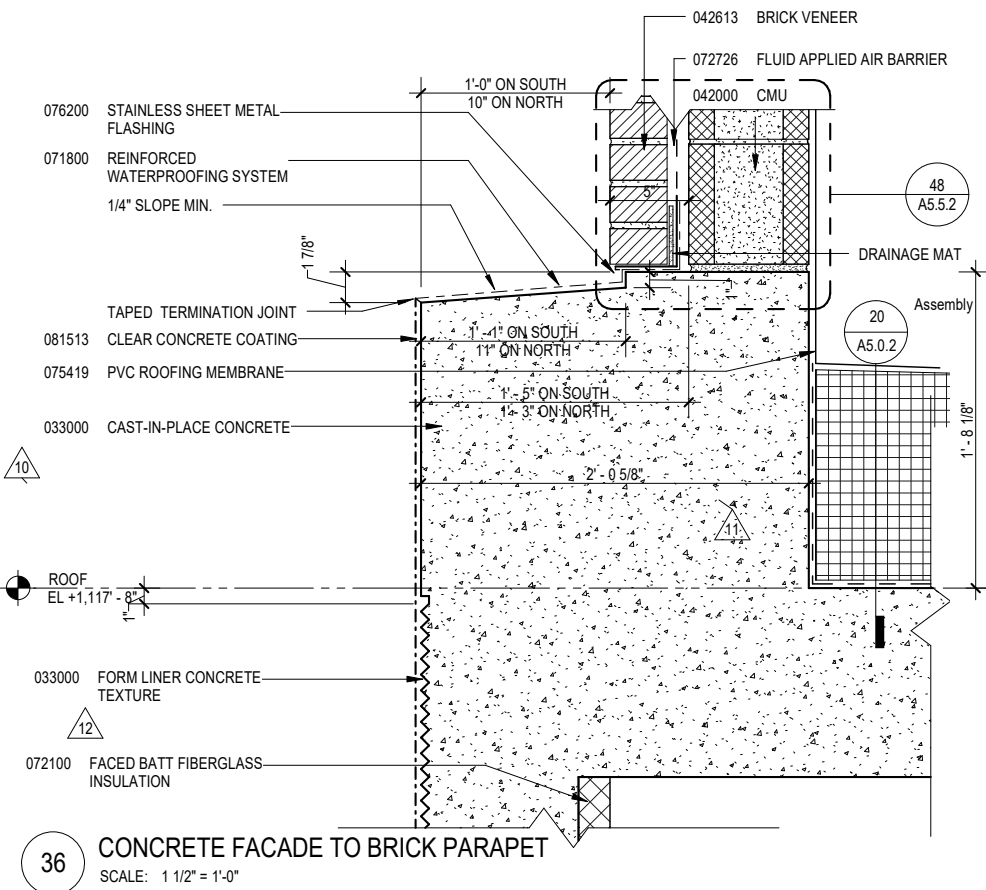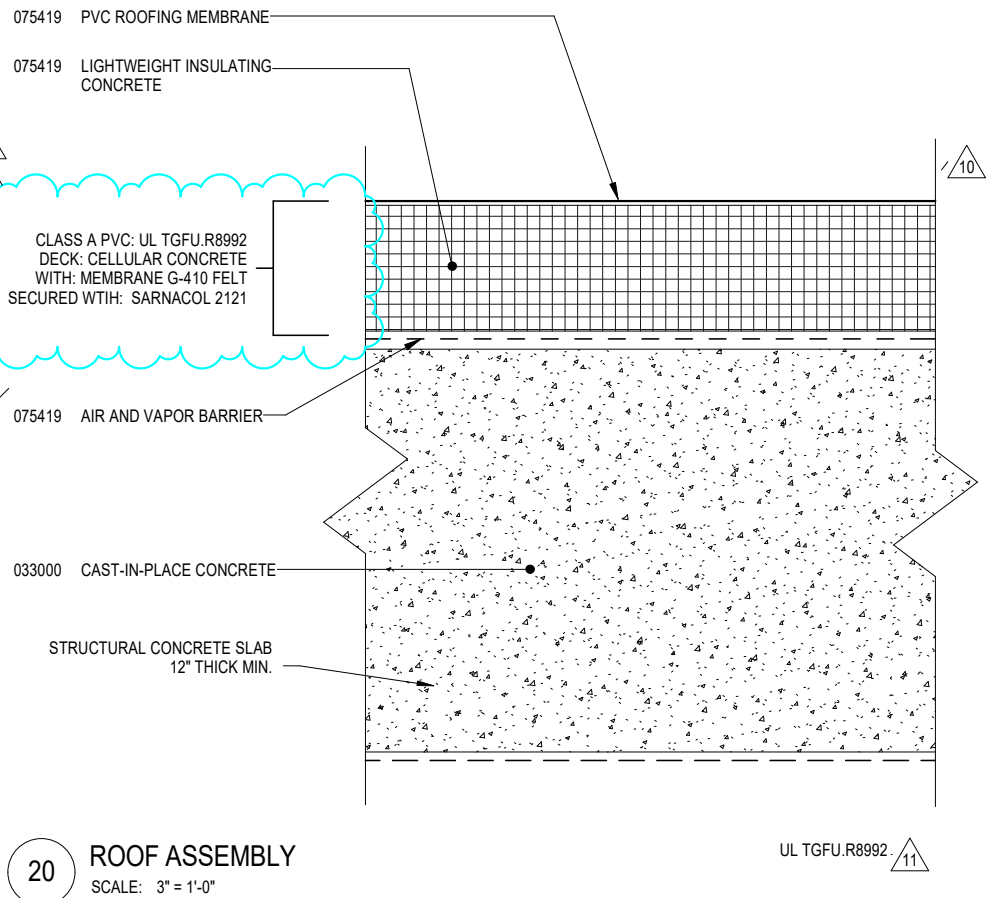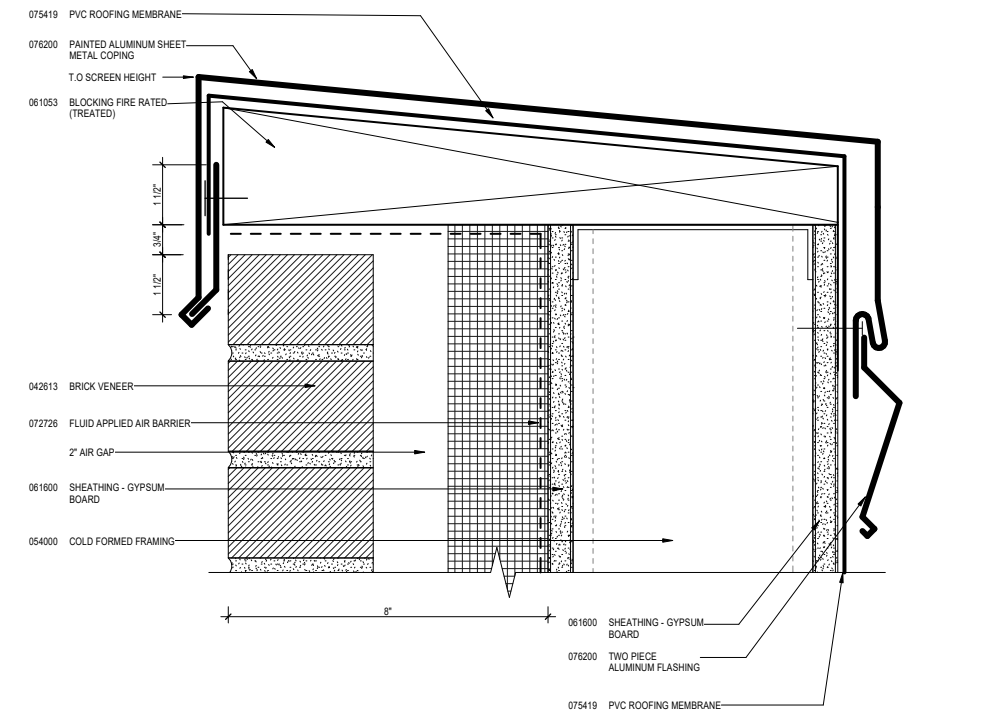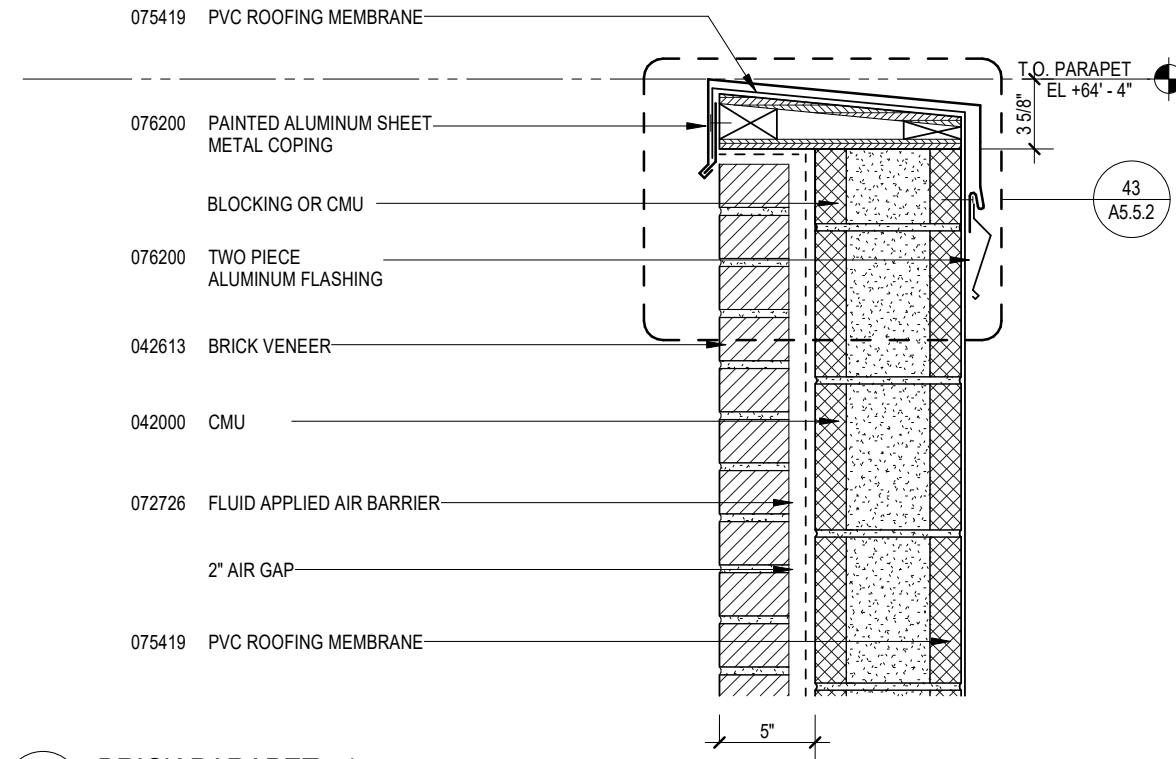


GL C-J.1



Detail 20/A5.9.1, 34/A5.3.1, 43/A5.5.2, 36/A5.3.1, 48/A5.5.2, 20/A5.0.2

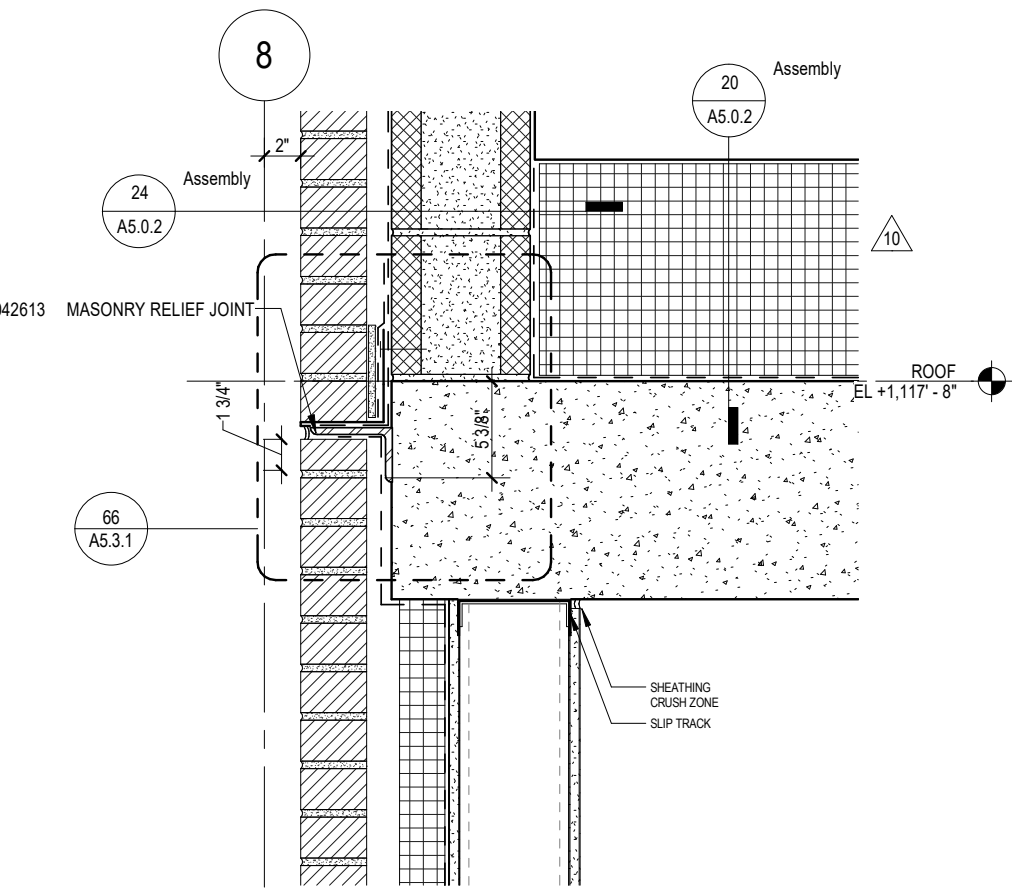


11 BRICK PARAPET AT ROOF SLAB
SCALE: 1 1/2" = 1'-0"

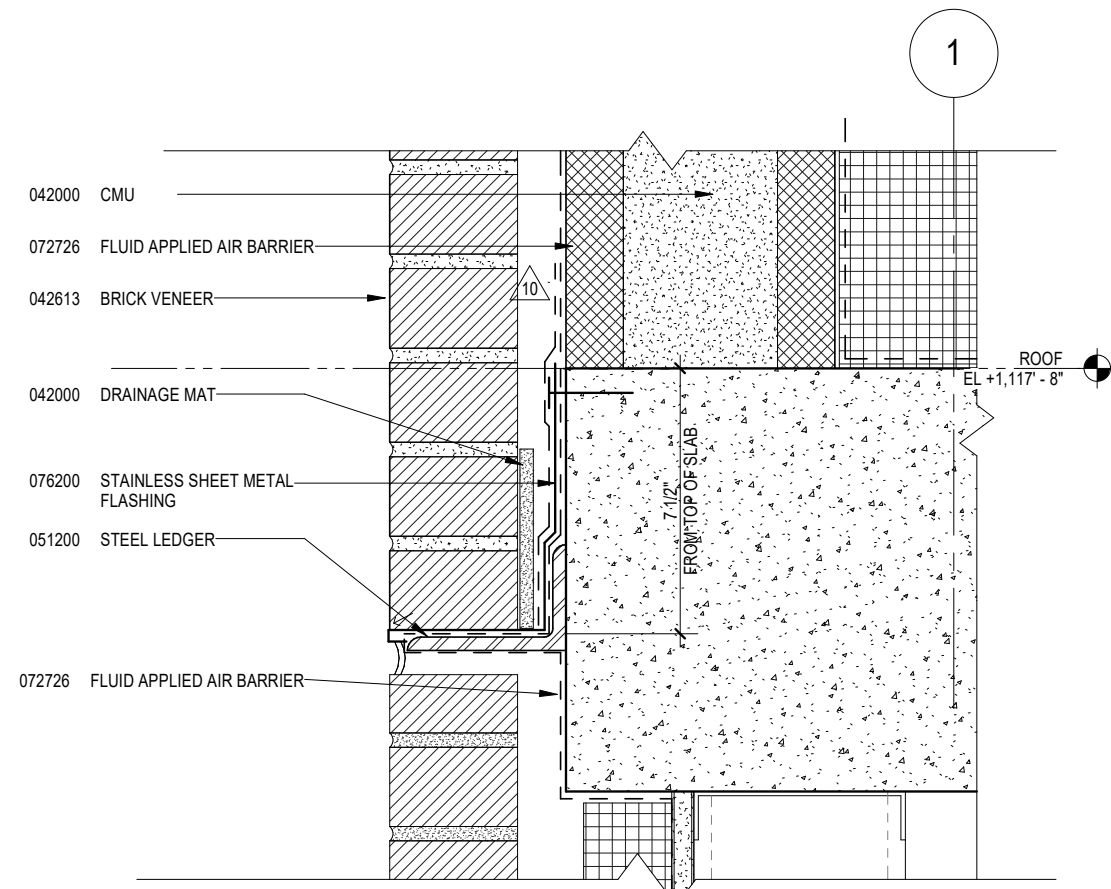


66 BRICK PARAPET AT NORTH OFFICE
SCALE: 3" = 1'-0"

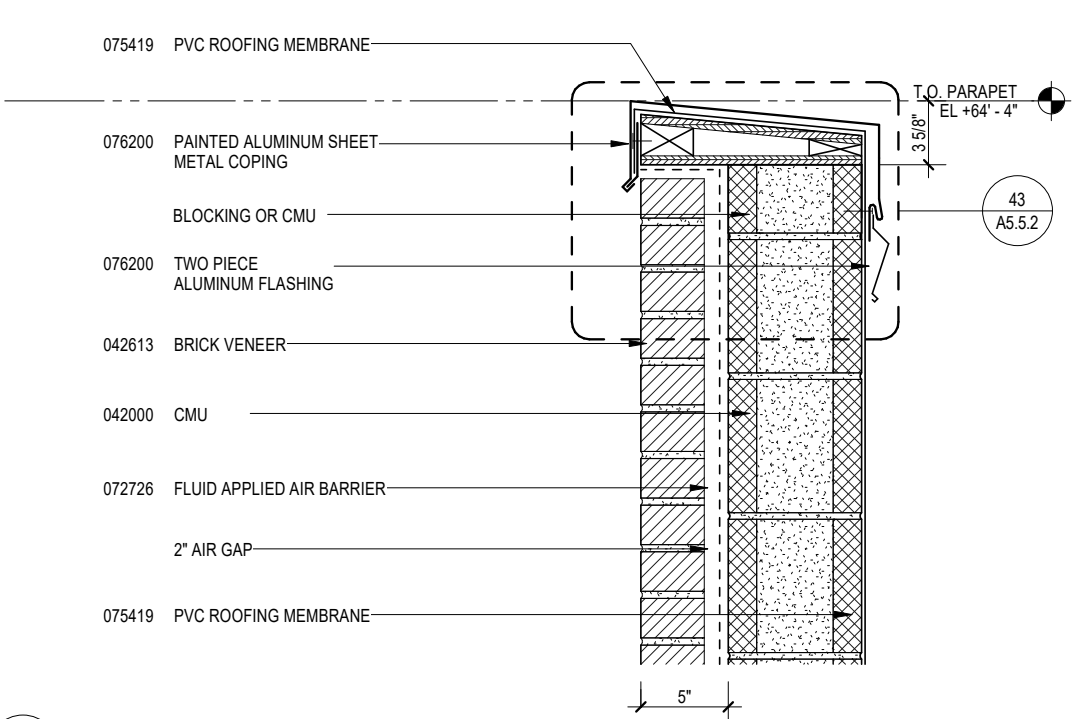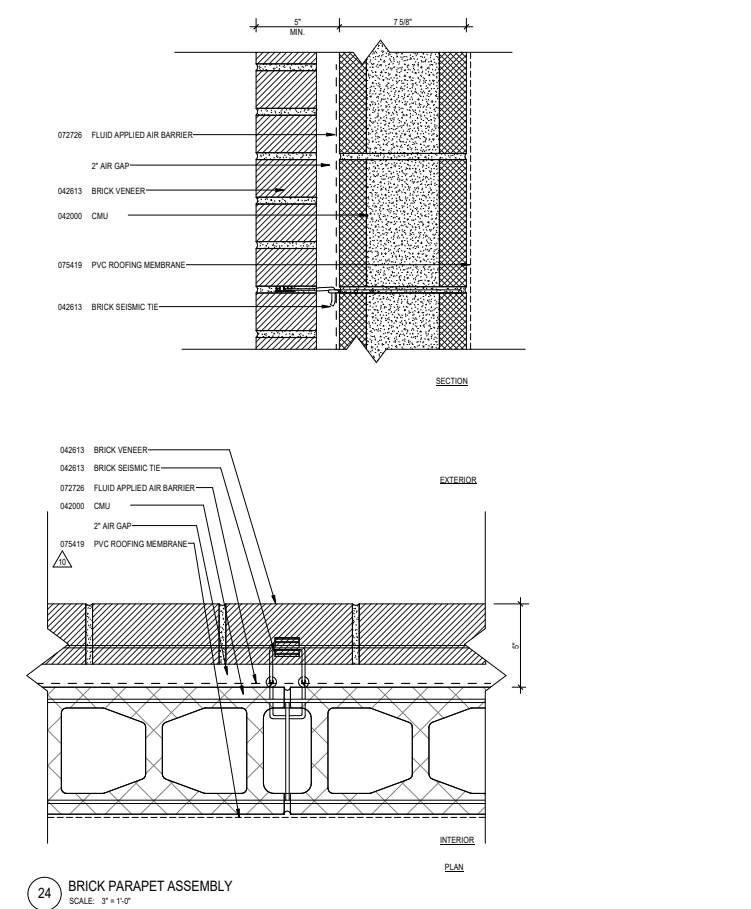


34 BRICK PARAPET - 1
SCALE: 1 1/2" = 1'-0"

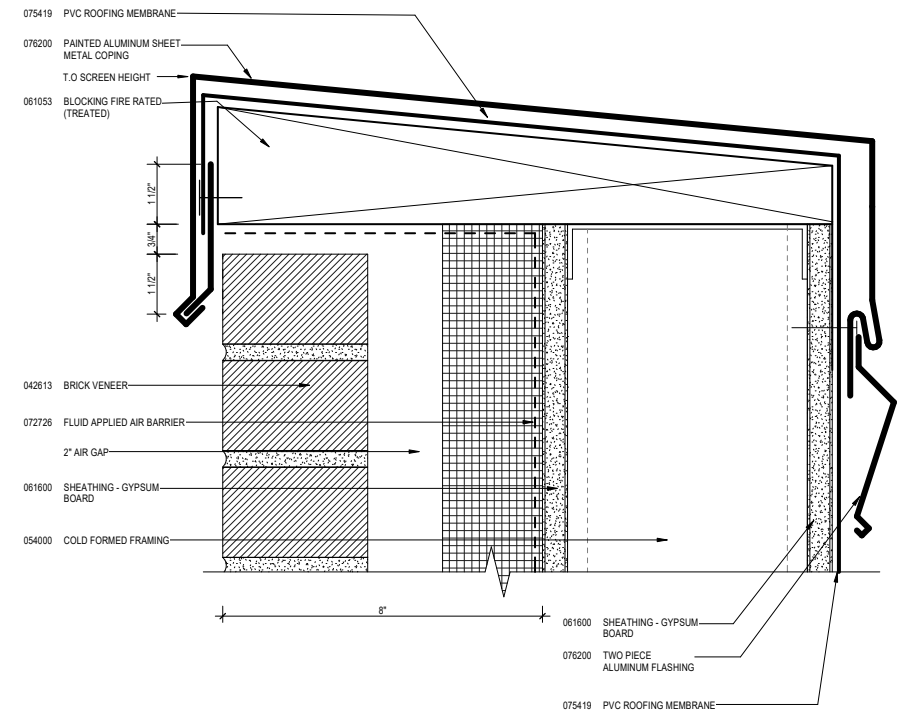


43 COPING DETAIL 2
SCALE: 6" = 1'-0"

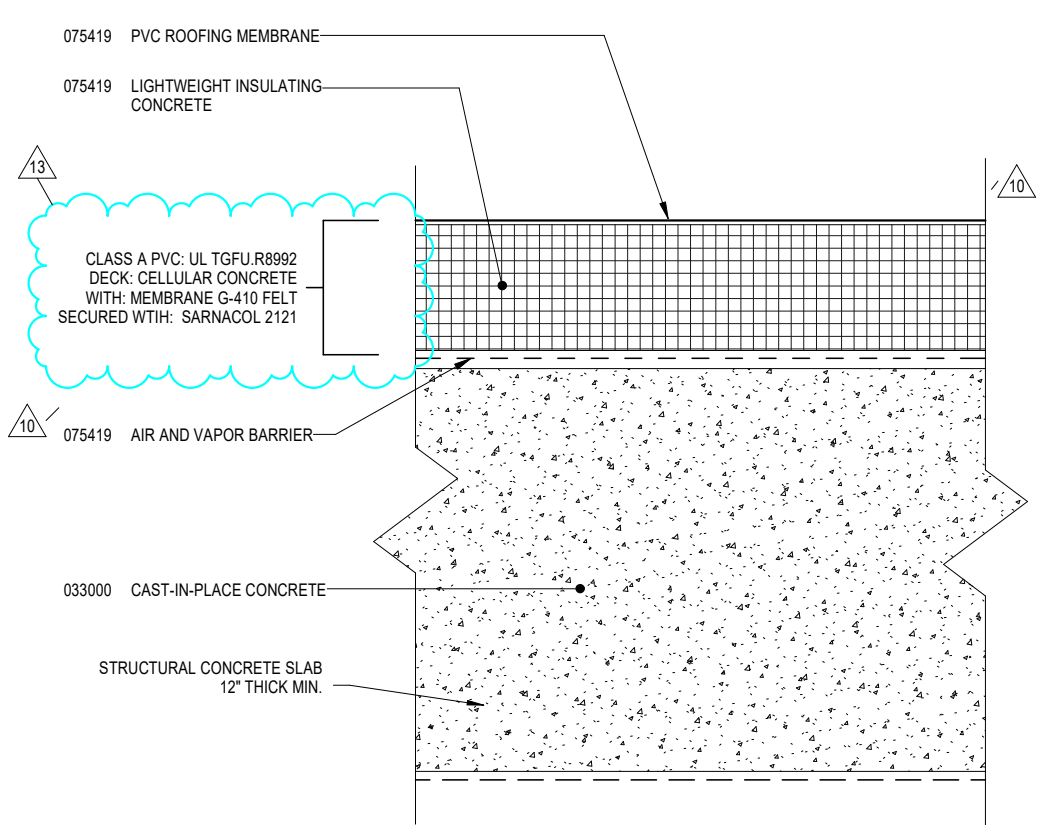


20 ROOF ASSEMBLY
SCALE: 3" = 1'-0"

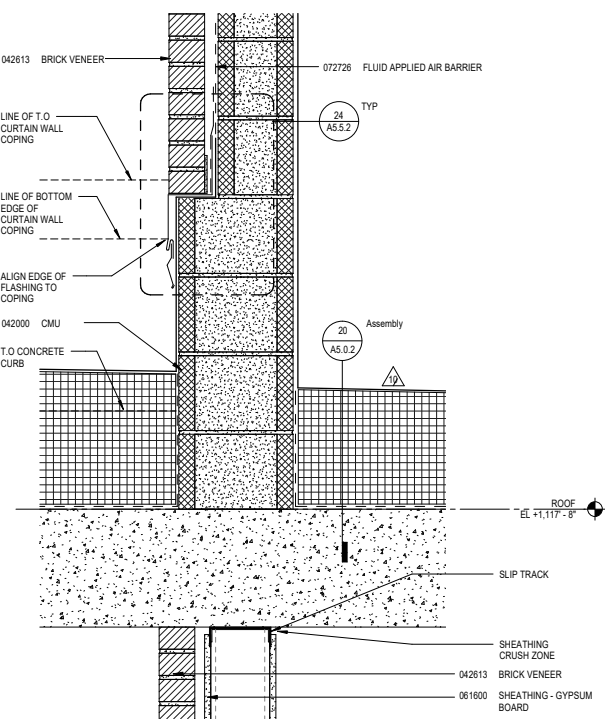


14 INTERIOR BRICK TO BRICK PARAPET
SCALE: 1 1/2" = 1'-0"

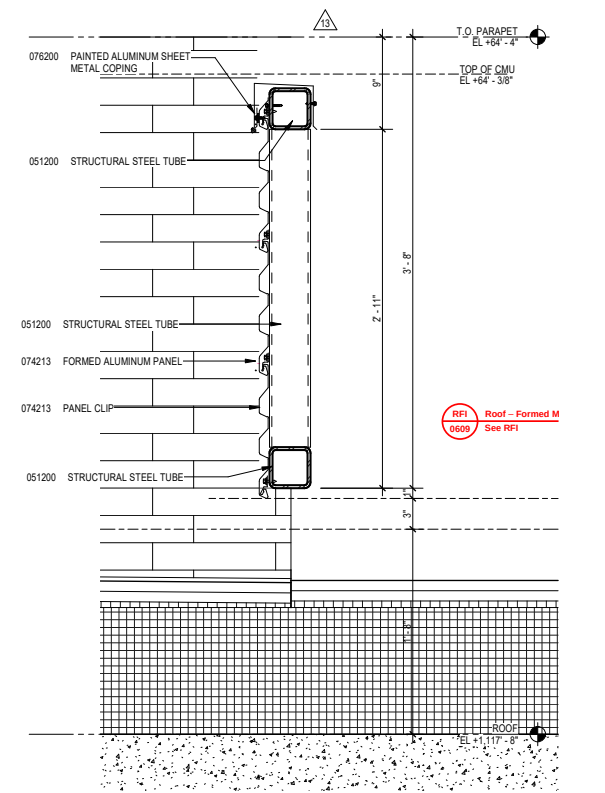


19 LOW METAL SCREEN Copy 1
SCALE: 1 1/2" = 1'-0"

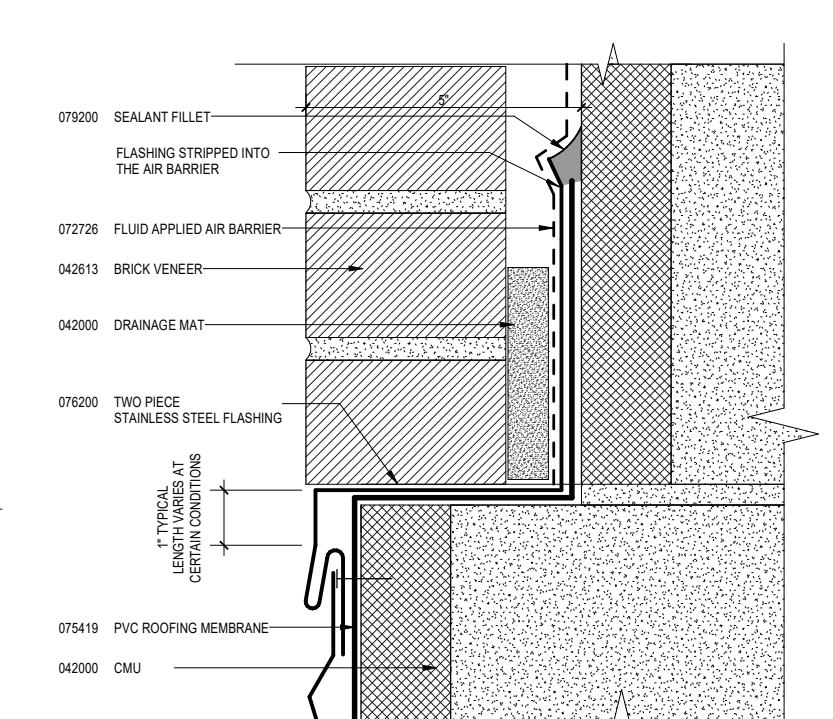


24 BRICK MASONRY WALL BASE TYP.
SCALE: 6" = 1'-0"

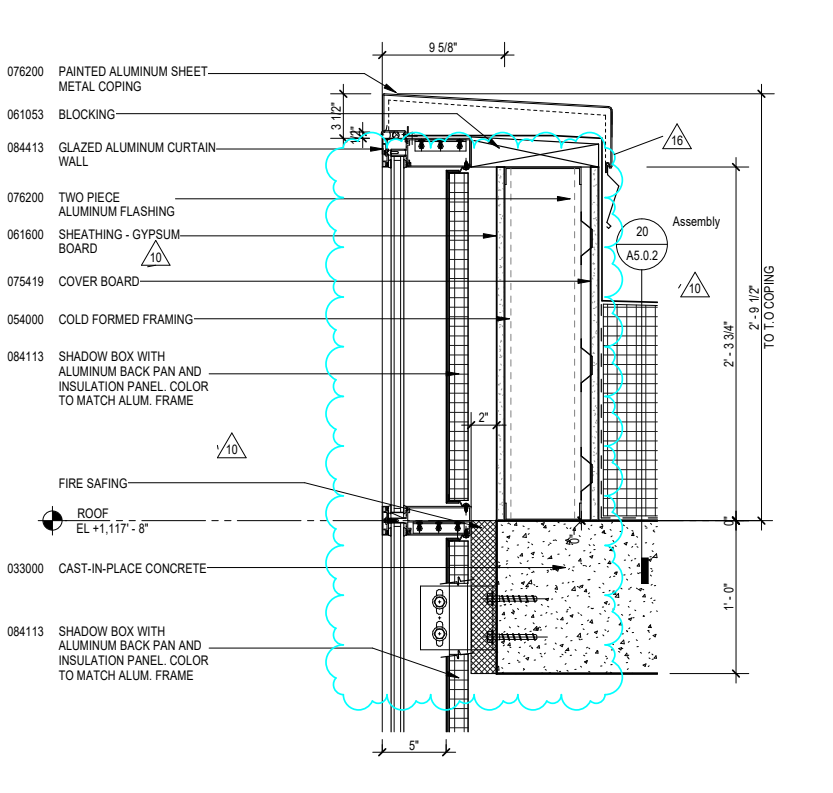


11 CURTAIN WALL PARAPET
SCALE: 1 1/2" = 1'-0"

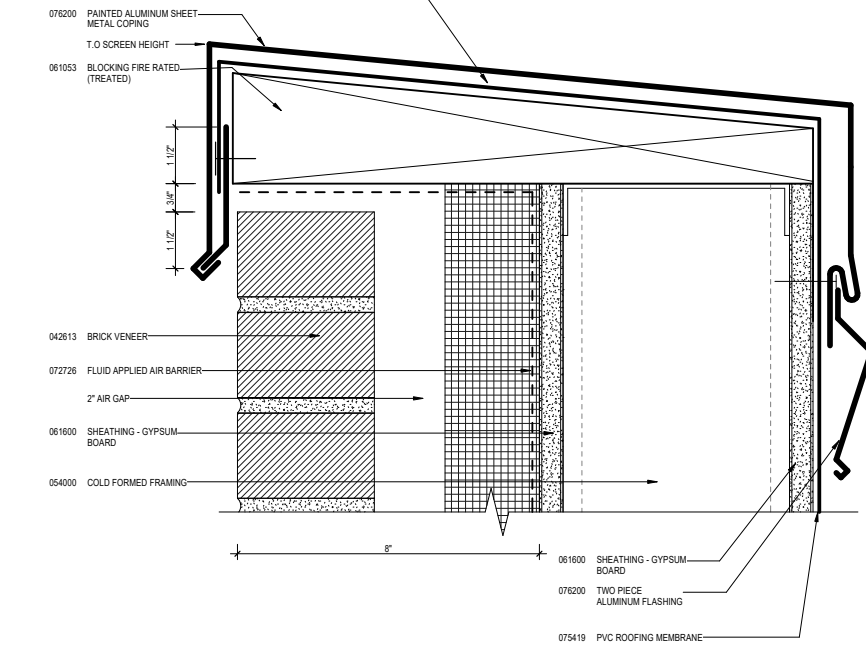

43 COPING DETAIL 2
SCALE: 6" = 1'-0"

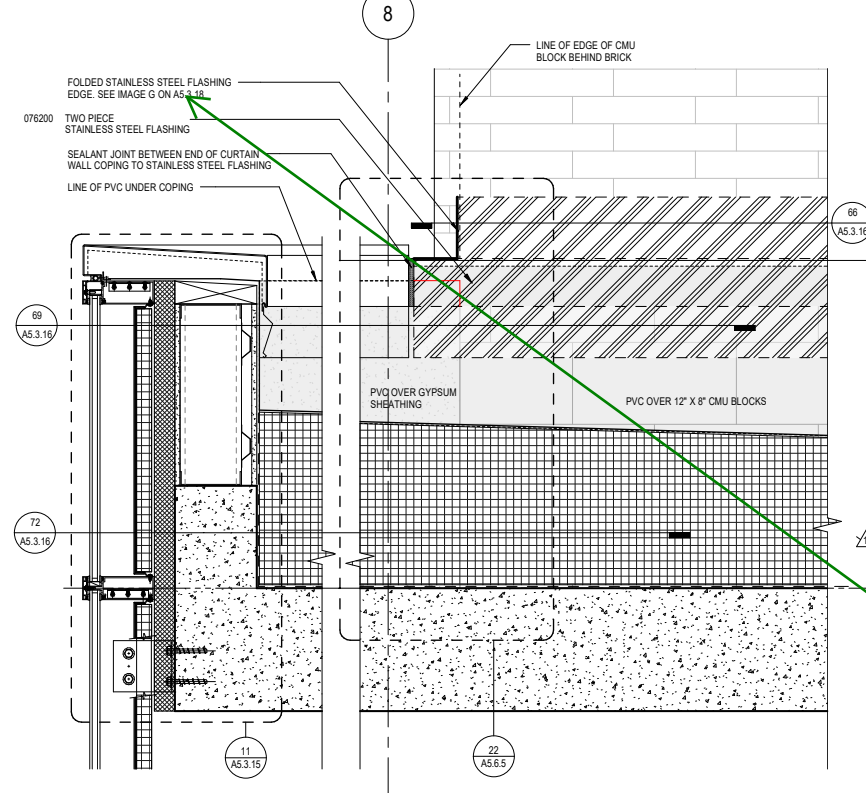



38 CURTAIN WALL TO BRICK MASONRY WALL
SCALE: 1 1/2" = 1'-0"

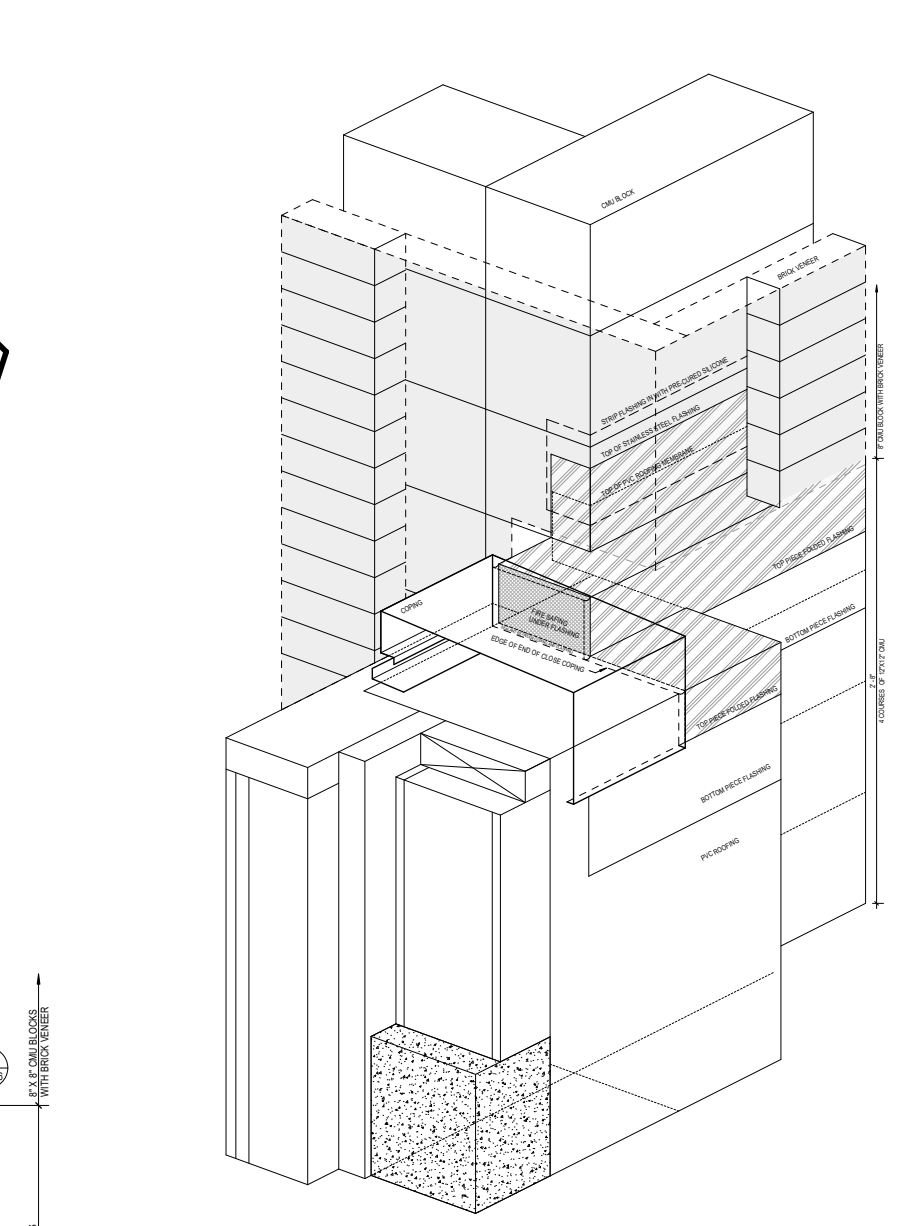

22 CURTAIN WALL TO BRICK MASONRY TERMINATION
SCALE: 7" = 1'-0"

See continuation of details on next page (A5.3.18)

GLJ.4-K
Detail 14/A5.3.16, 24/A5.5.2, 43/A5.5.2, 20/A5.0.2, 19/A5.3.5, 11/A5.3.15, 38/A5.3.16, 22/A5.6.5, A5.3.18

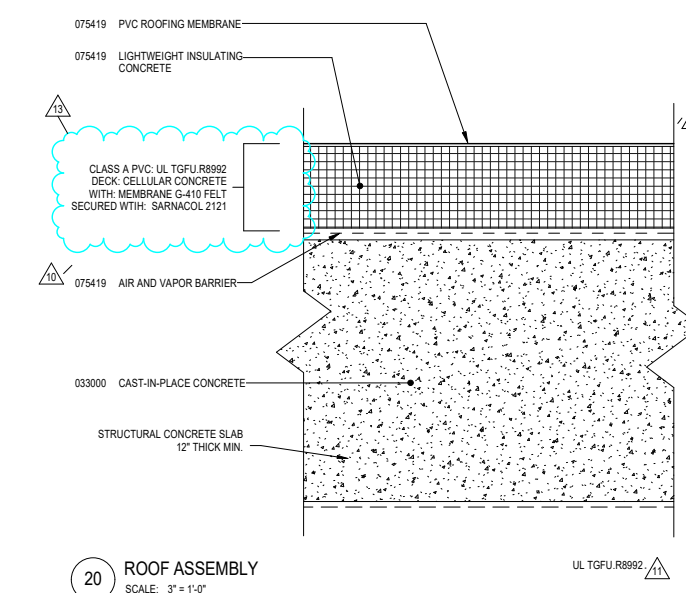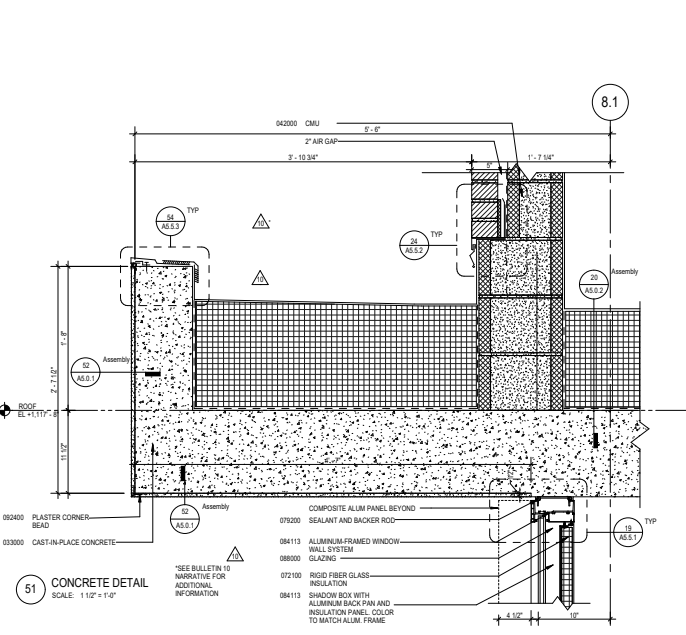

GL K-R

Detail 51/A5.3.20, 50/A5.3.3, 54/A5.5.3, 52/A5.0.1, 20/A5.0.2, 24/A5.5.2, 34/A5.3.1, 43/A5.2.2, 26/A5.3.11, 30/A5.3.11

