
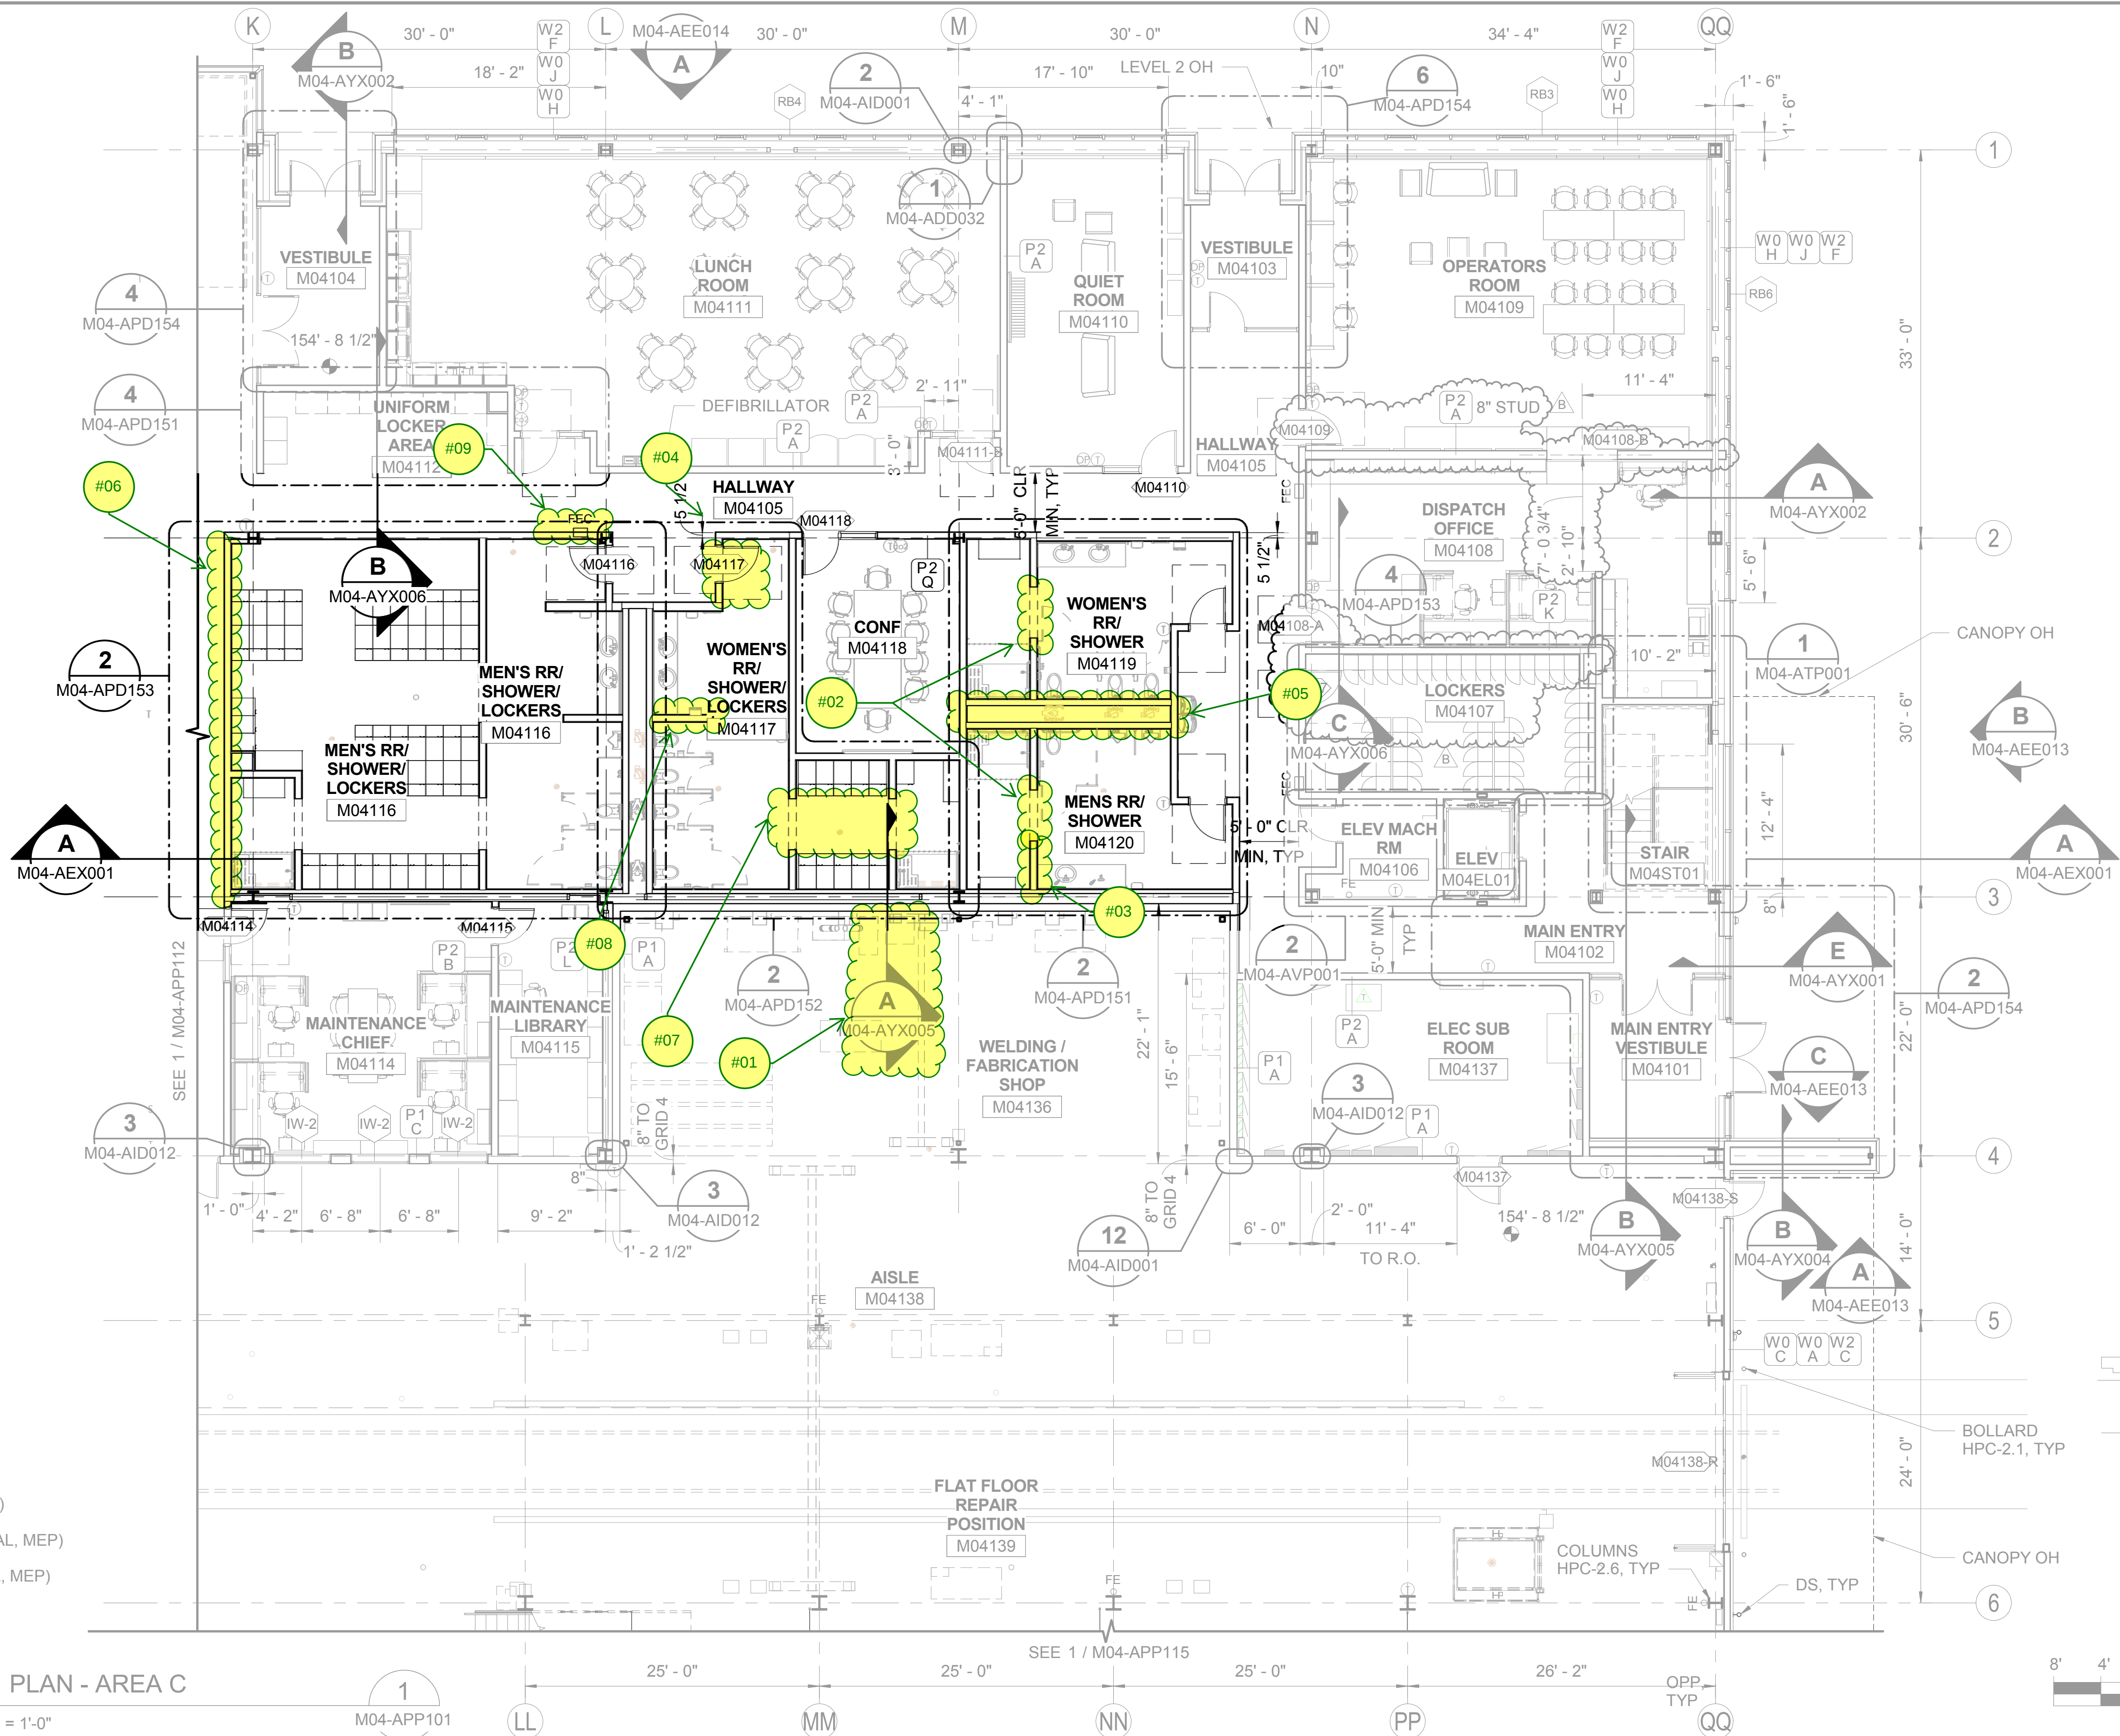
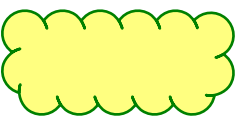


MARK UP TOOLS

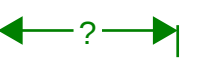

GRAPHIC

- MOVEABLE EQUIPMENT (SEE INDUSTRIAL)
- STATIONARY EQUIPMENT (SEE INDUSTRIAL, MEP)
- EQUIPMENT OVERHEAD (SEE INDUSTRIAL, MEP)
- PIT / OPEN TO BELOW
- CANOPY ABOVE

LEVEL 1 PLAN - AREA C

SCALE: 1/8" = 1'-0"

NOTE: ALL CMU OUTSIDE CORNERS TO BE BULLNOSE UNO

DP4A - IFC

No.	DATE	DSN	CHK	APP	REVISION
B	2019.08.02	BP	SM	JY	CB#034
A	2019.05.03	BP	SM	JY	CB#025
0	2018.09.19	BP	SM	JY	ISSUED FOR CONSTRUCTION

DESIGNED BY:
B. PETERSON
DRAWN BY:
T. WEST
CHECKED BY:
S. McDONALD
APPROVED BY:
J. YOUNG



SUBMITTED BY:
RICHARD LEWIS



DATE:
2018.07.10



REVIEWED BY:
BILL FERRIS



DATE:
2018.07.10



DATE:
2018.07.10



DATE:
2018.07.10

SCALE:
1/8" = 1'-0"
FILENAME:
M200-Y02e-A-v2017
CONTRACT No.:
RTA/CN 0020-16
SUBMITTAL DATE:
2018.07.10

LINK OPERATIONS & MAINTENANCE FACILITY: EAST
CONTRACT M200

OMF EAST

OMF EAST BUILDING
FIRST FLOOR - AREA C PLAN

DRAWING NO.:
M04-APP113

FACILITY ID:
M04

SHEET No.:
REV:
H