


MARK UP TOOLS




= FLATSTRAP BACKING LOCATION

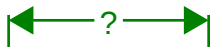

= BACKING DIMENSIONS



















= ROUGH OPENING LOCATION

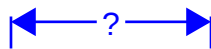

= ROUGH OPENING DIMENSION

10/17/2018 6:51:53 AM
C:\Users\bpeterson\Documents\M200-M04-A-v2017_bpeterson.rvt

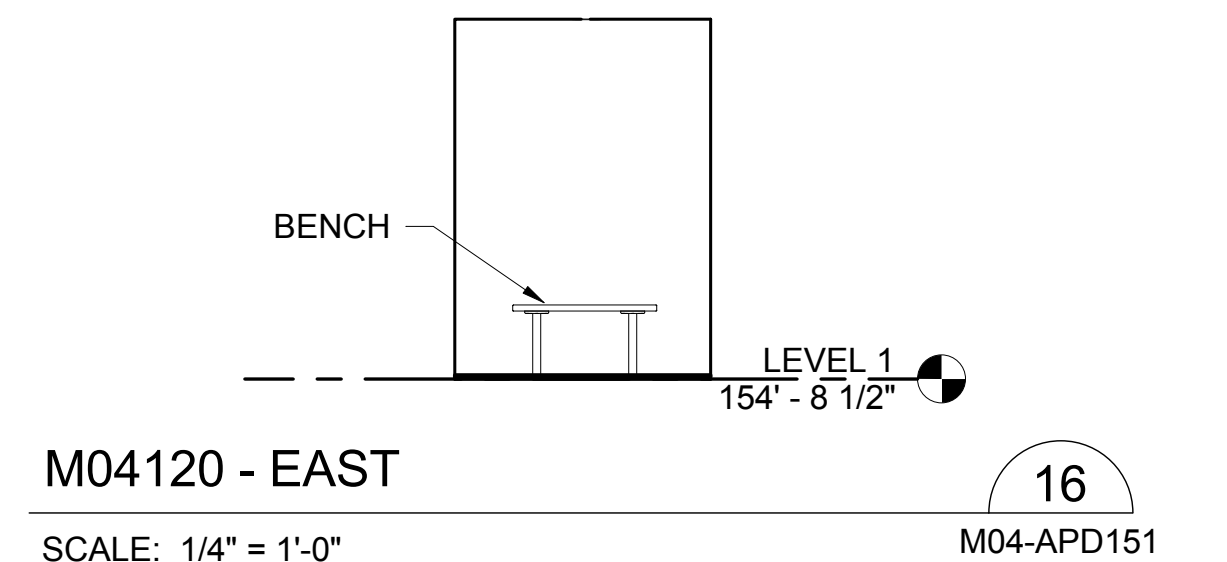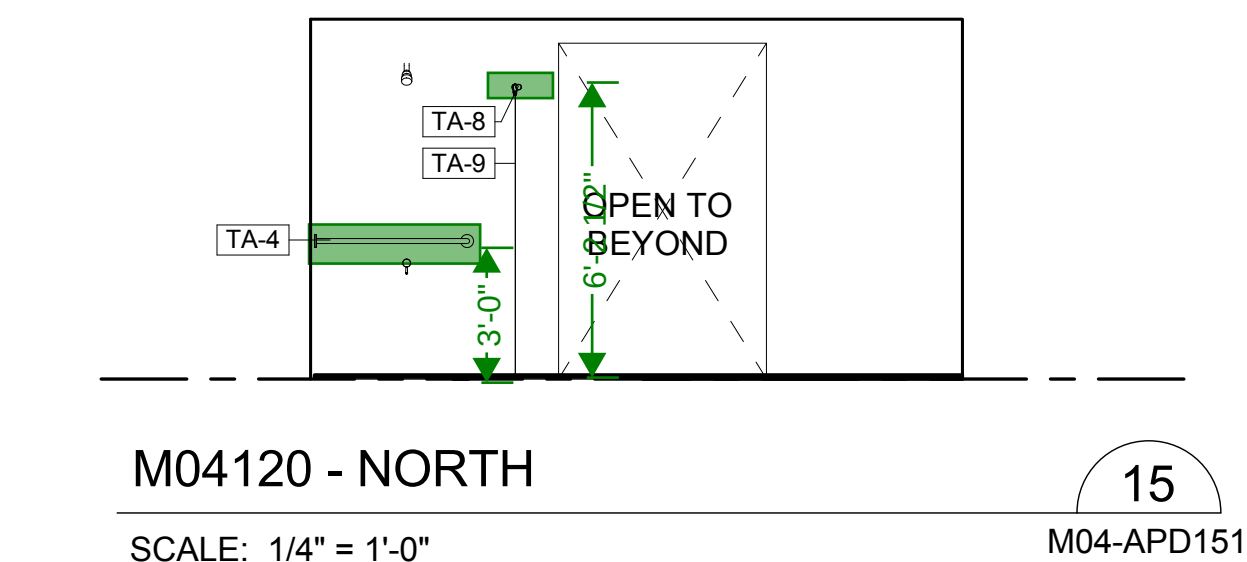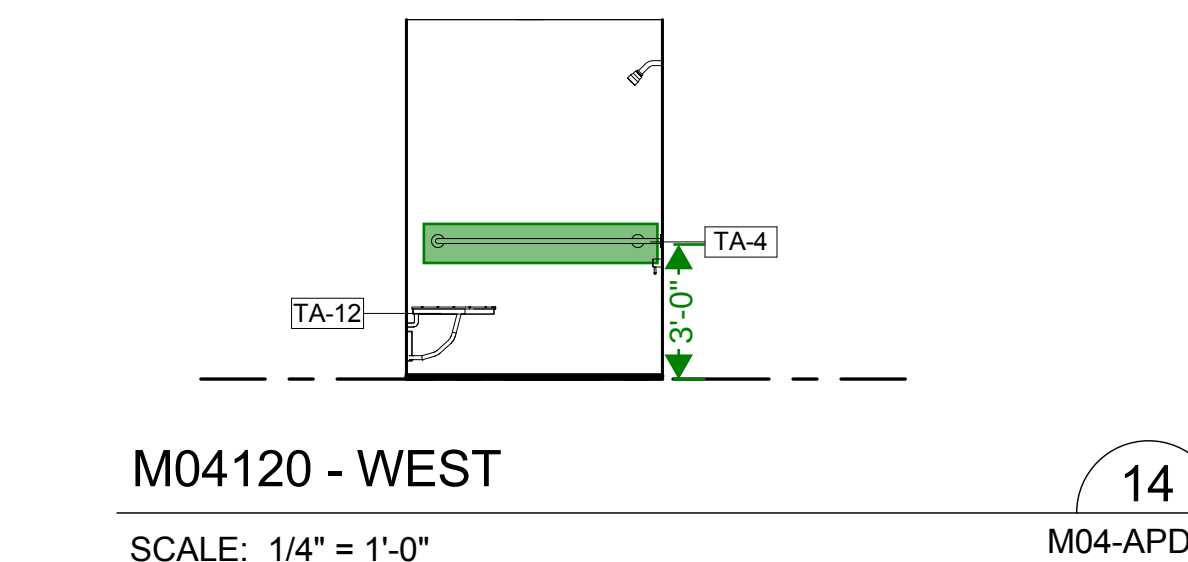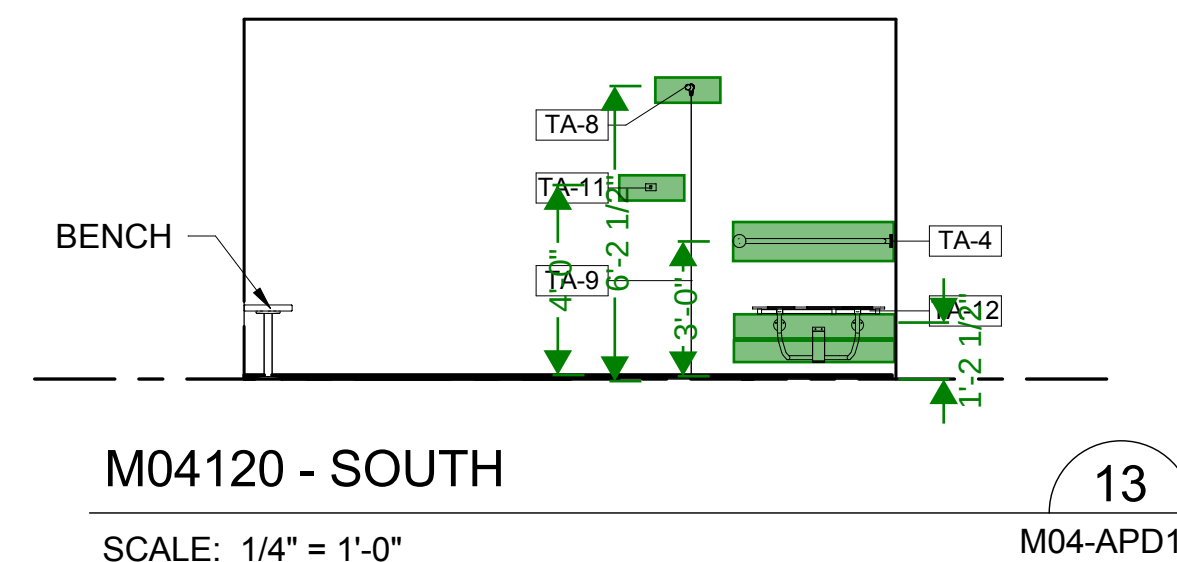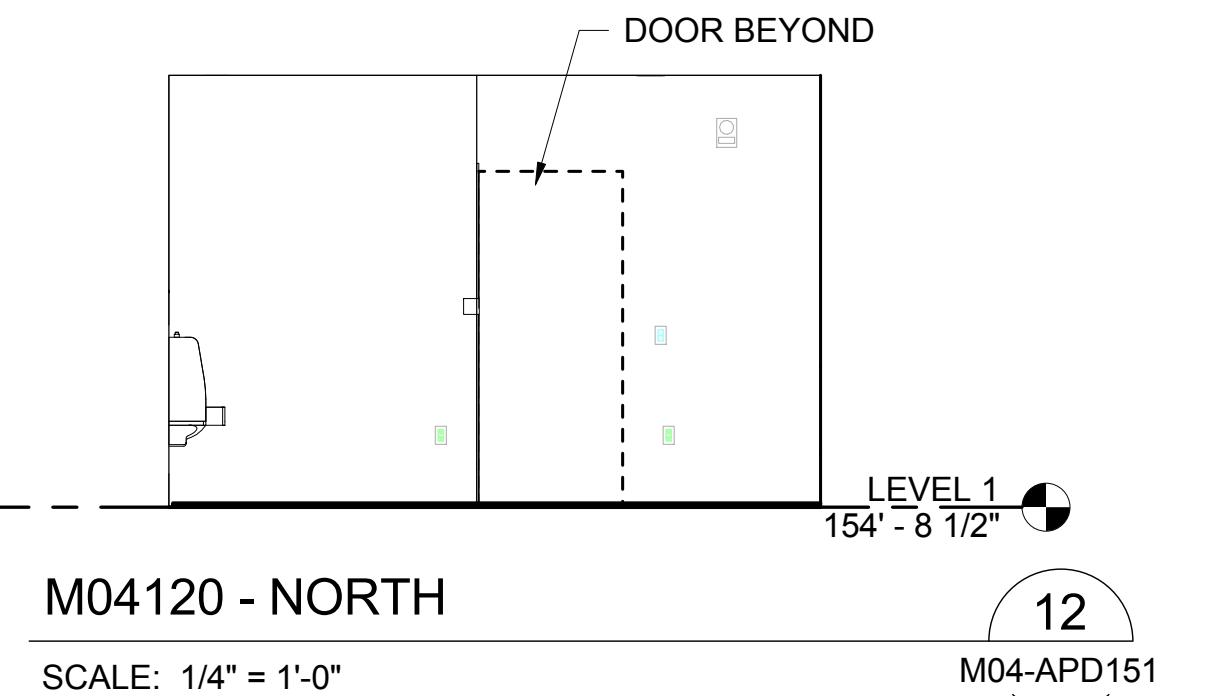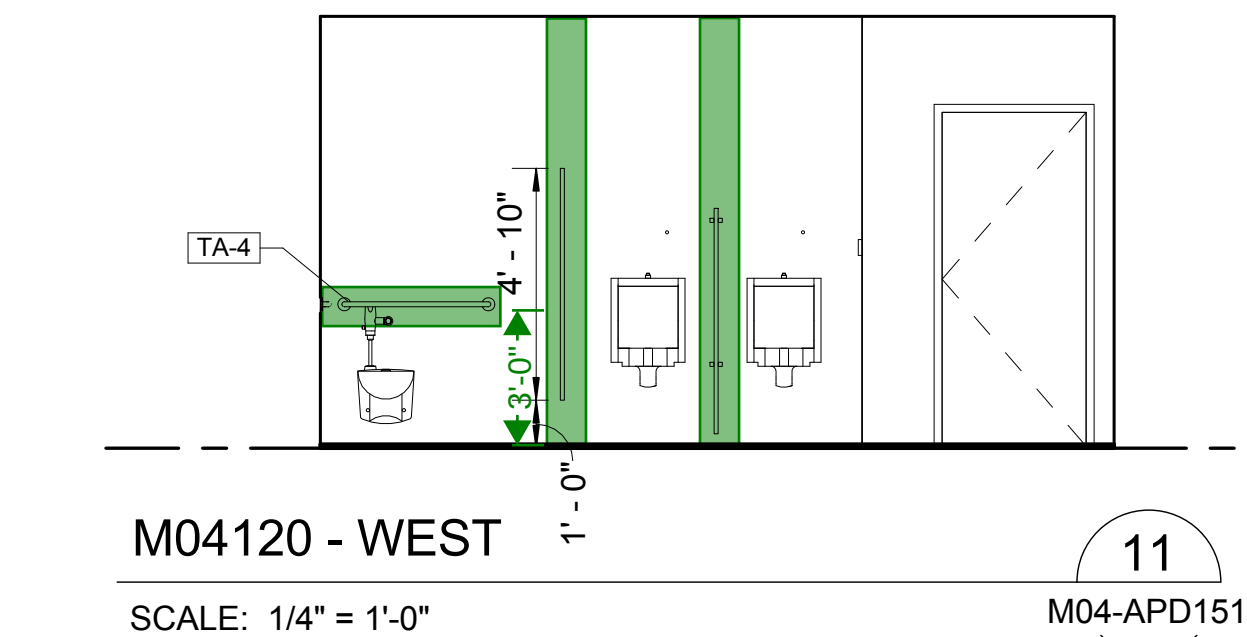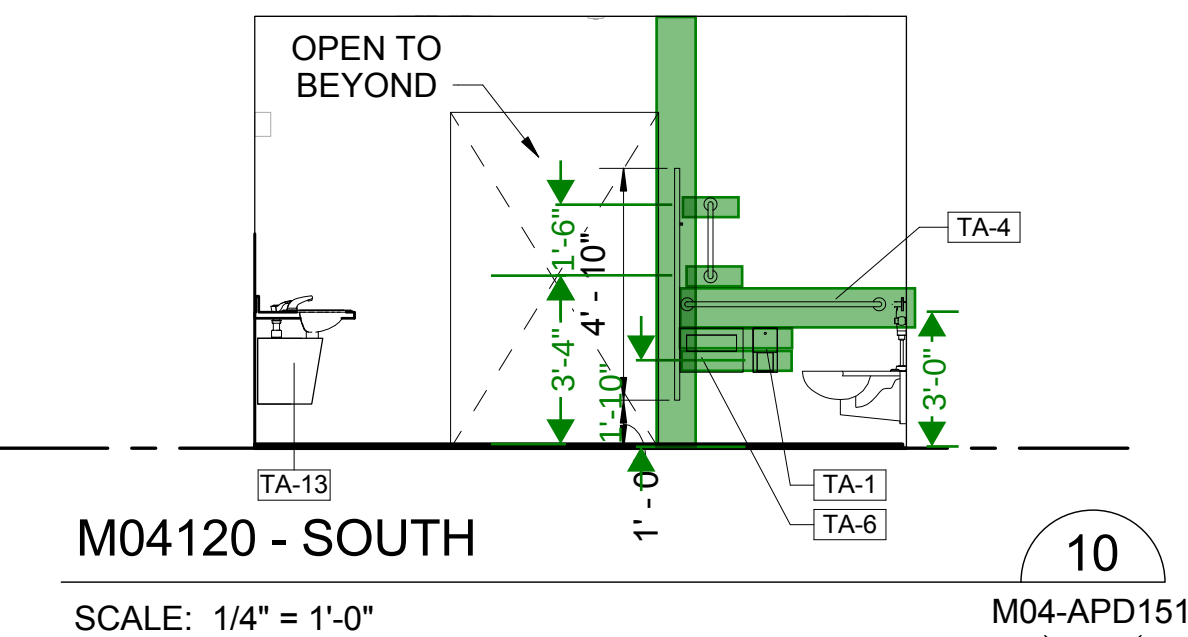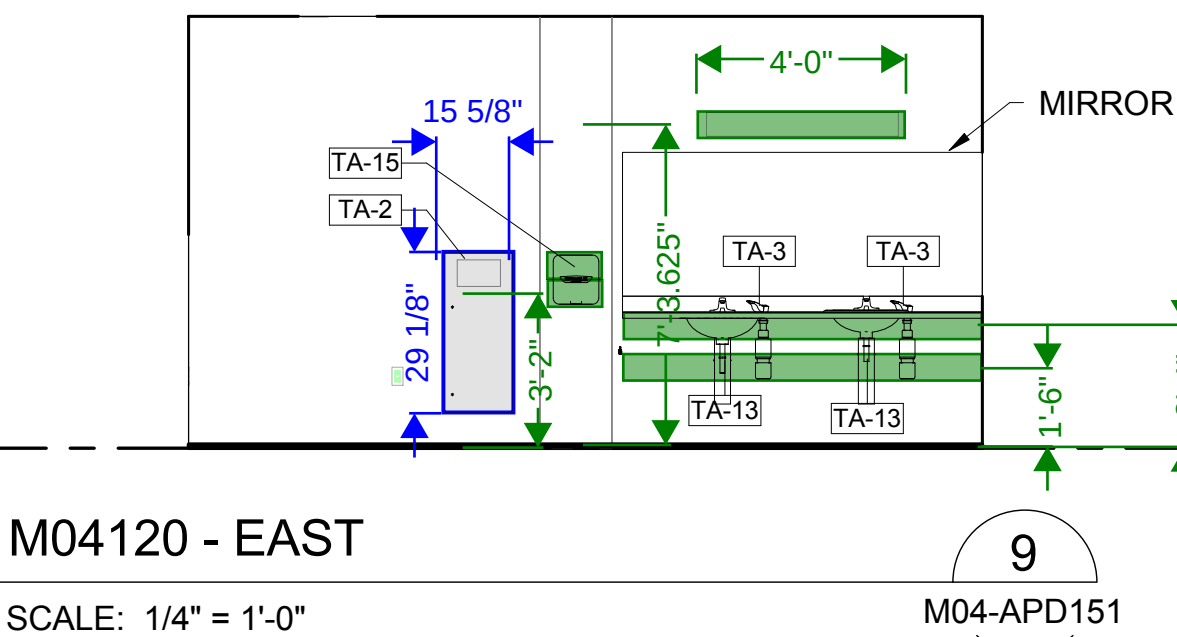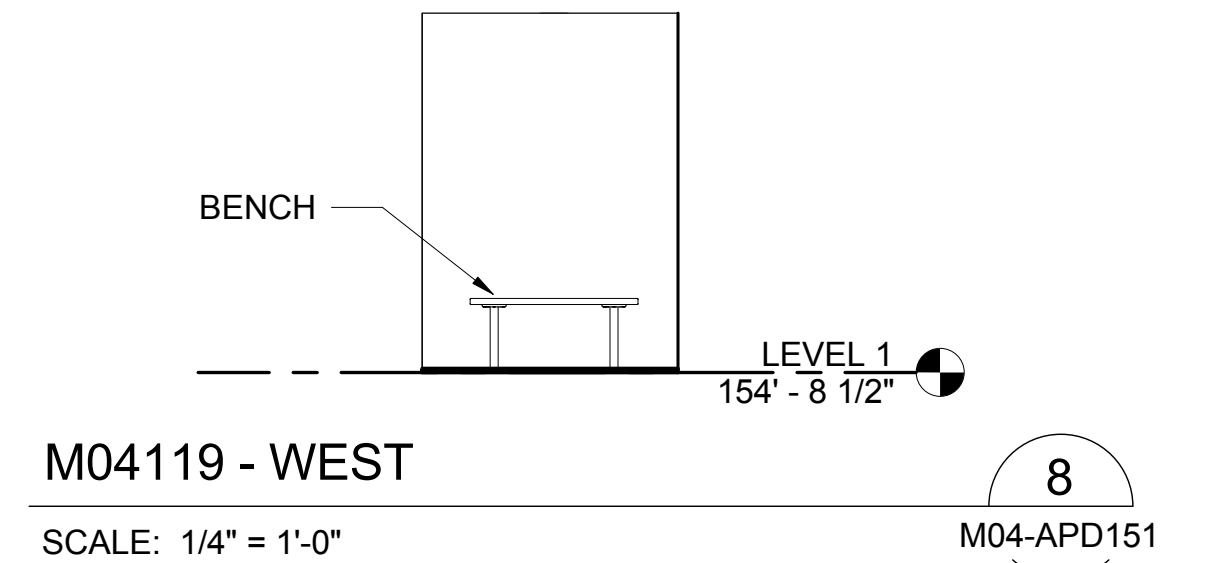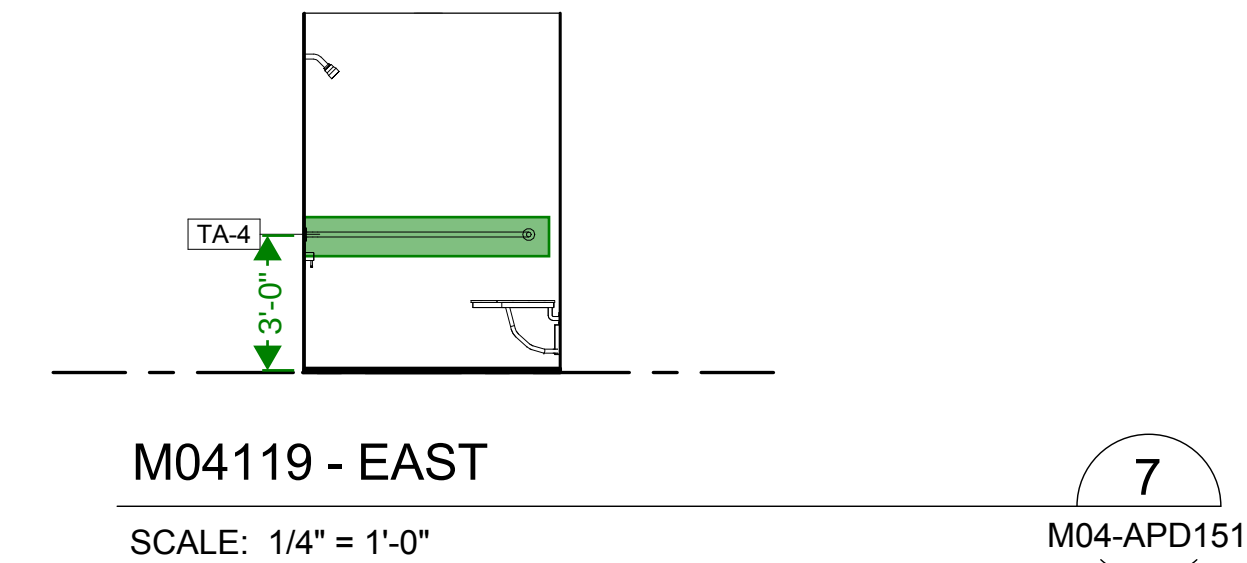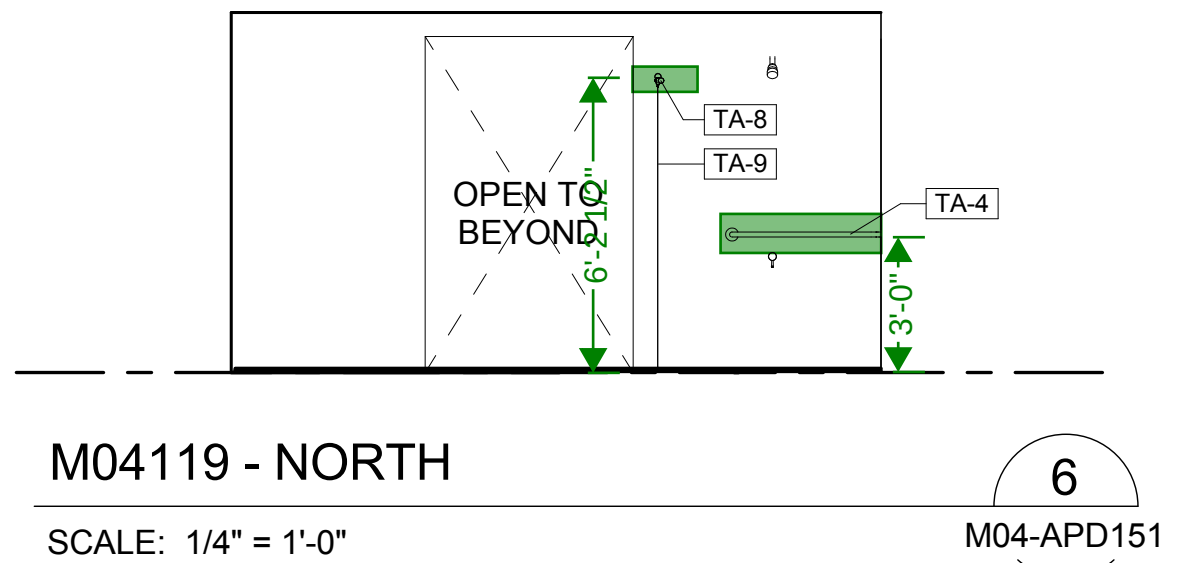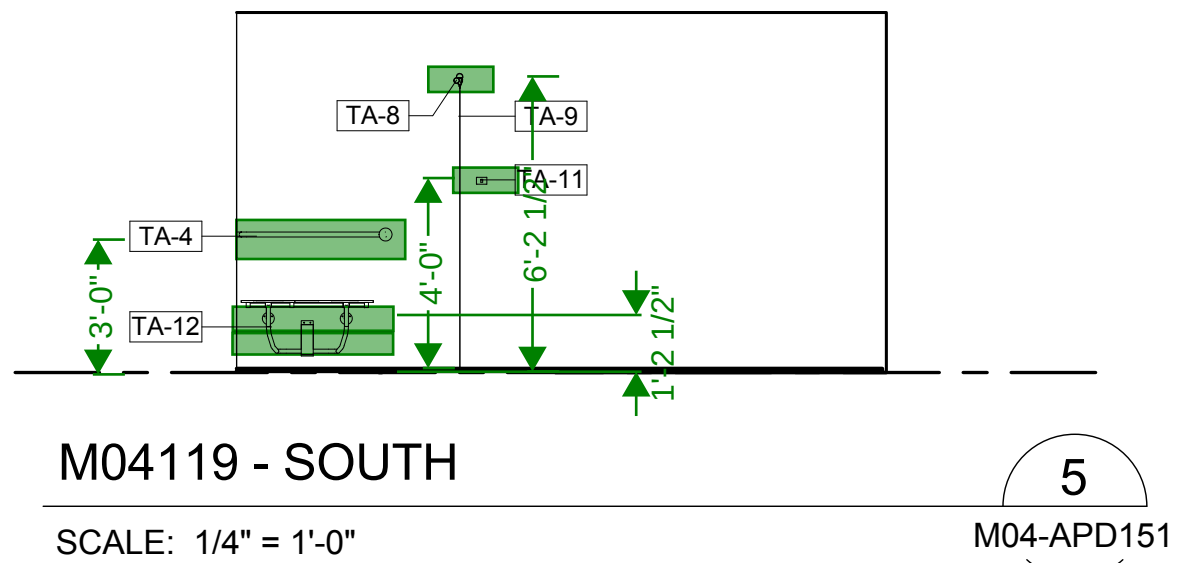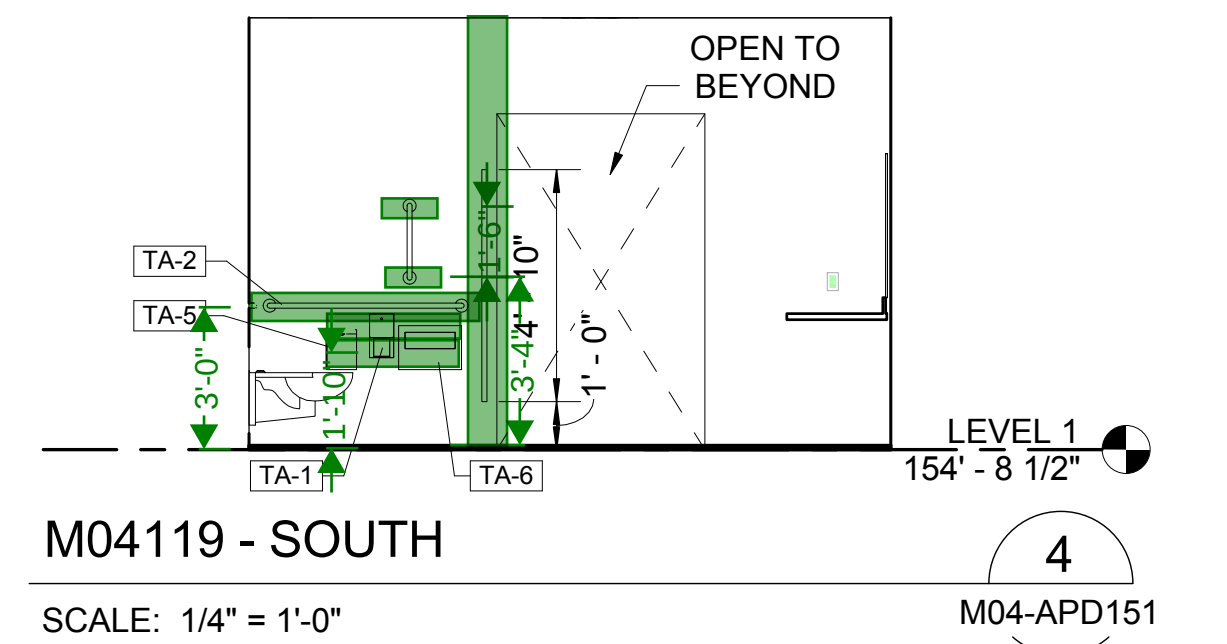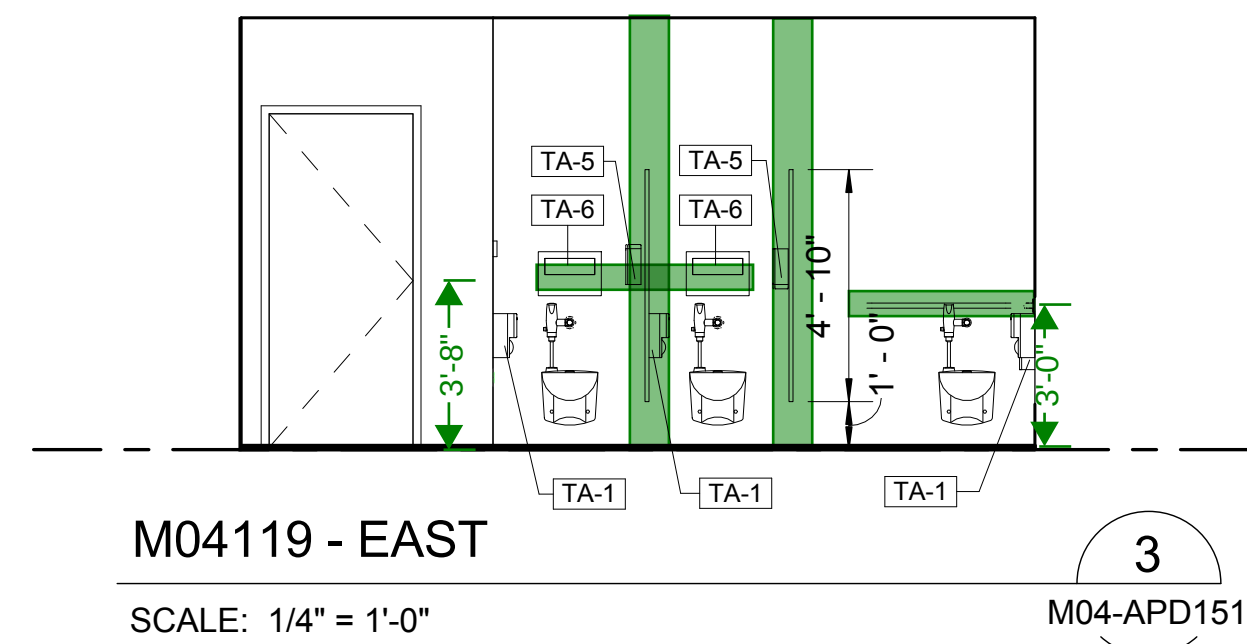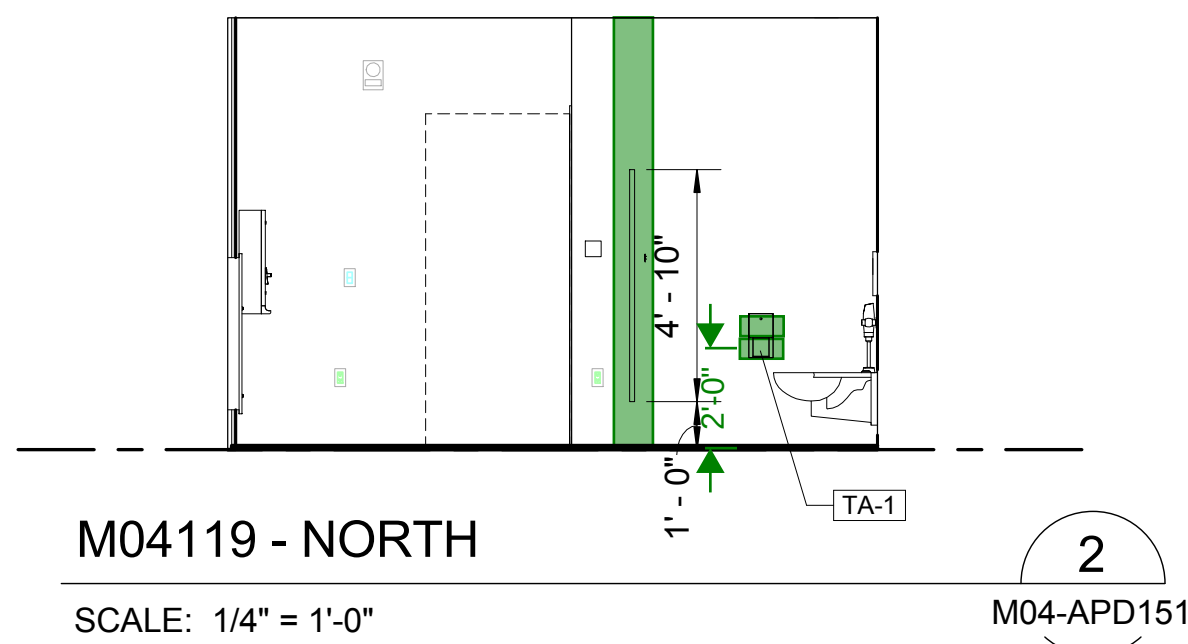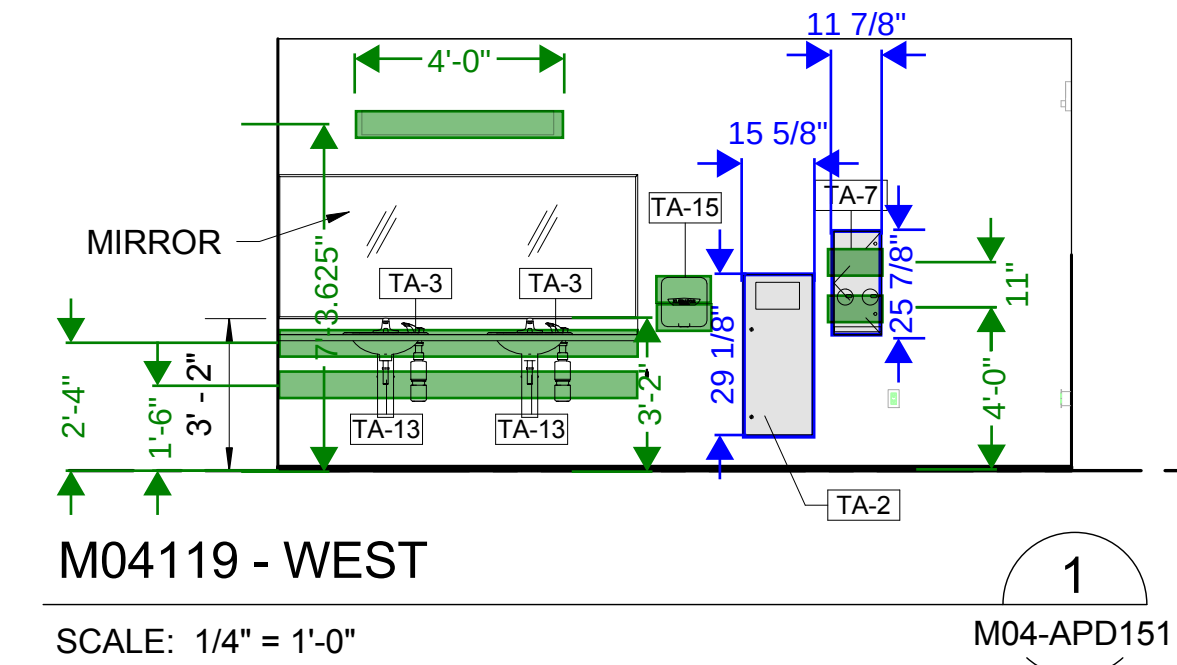

- GENERAL NOTES**
1. SEE GEN-AIE001 FOR MOUNTING HEIGHTS.
 2. SEE GEN-AZN002 FOR TECHNICAL NOMENCLATURE & TOILET ACCESSORIES SCHEDULE.
 3. SEE INTERIORS FOR WALL, FLOOR AND CEILING FINISHES.

DP4A-IFC

DESIGNED BY:
B. PETERSON
DRAWN BY:
T. WEST
CHECKED BY:
S. McDONALD
APPROVED BY:
J. YOUNG



HENSEL PHELPS
Plan. Build. Manage.

Stantec **VIA**

SUBMITTED BY:
RICHARD LEWIS

coterra
ENGINEERING

kpff

DATE:
2018.09.19

rolluda architects
architecture planning interior design

ELCON ASSOCIATES, INC.
ENGINEERS-CONSULTANTS

REVIEWED BY:
BILL FERRIS

rolluda architects
architecture planning interior design

ELCON ASSOCIATES, INC.
ENGINEERS-CONSULTANTS

DATE:
2018.09.19

rolluda architects
architecture planning interior design

ELCON ASSOCIATES, INC.
ENGINEERS-CONSULTANTS

DATE:
2018.09.19

SOUNDTRANSIT

DATE:
2018.09.19

SCALE:
1/4" = 1'-0"

FILENAME:
M200-M04-A-v2017

CONTRACT No.:
RTA/CN 0020-16

LINK OPERATIONS & MAINTENANCE FACILITY: EAST
CONTRACT M200

OMF EAST

OMF EAST BUILDING
LEVEL 1 INTERIOR ELEVATIONS


DRAWING NO.:
M04-AIE001

FACILITY ID:
M04

SHEET No.:
109

REV:
0

10/17/2018 6:52:07 AM
C:\Users\bpeterson\Documents\M200-M04-A-v2017_bpeterson.rvt

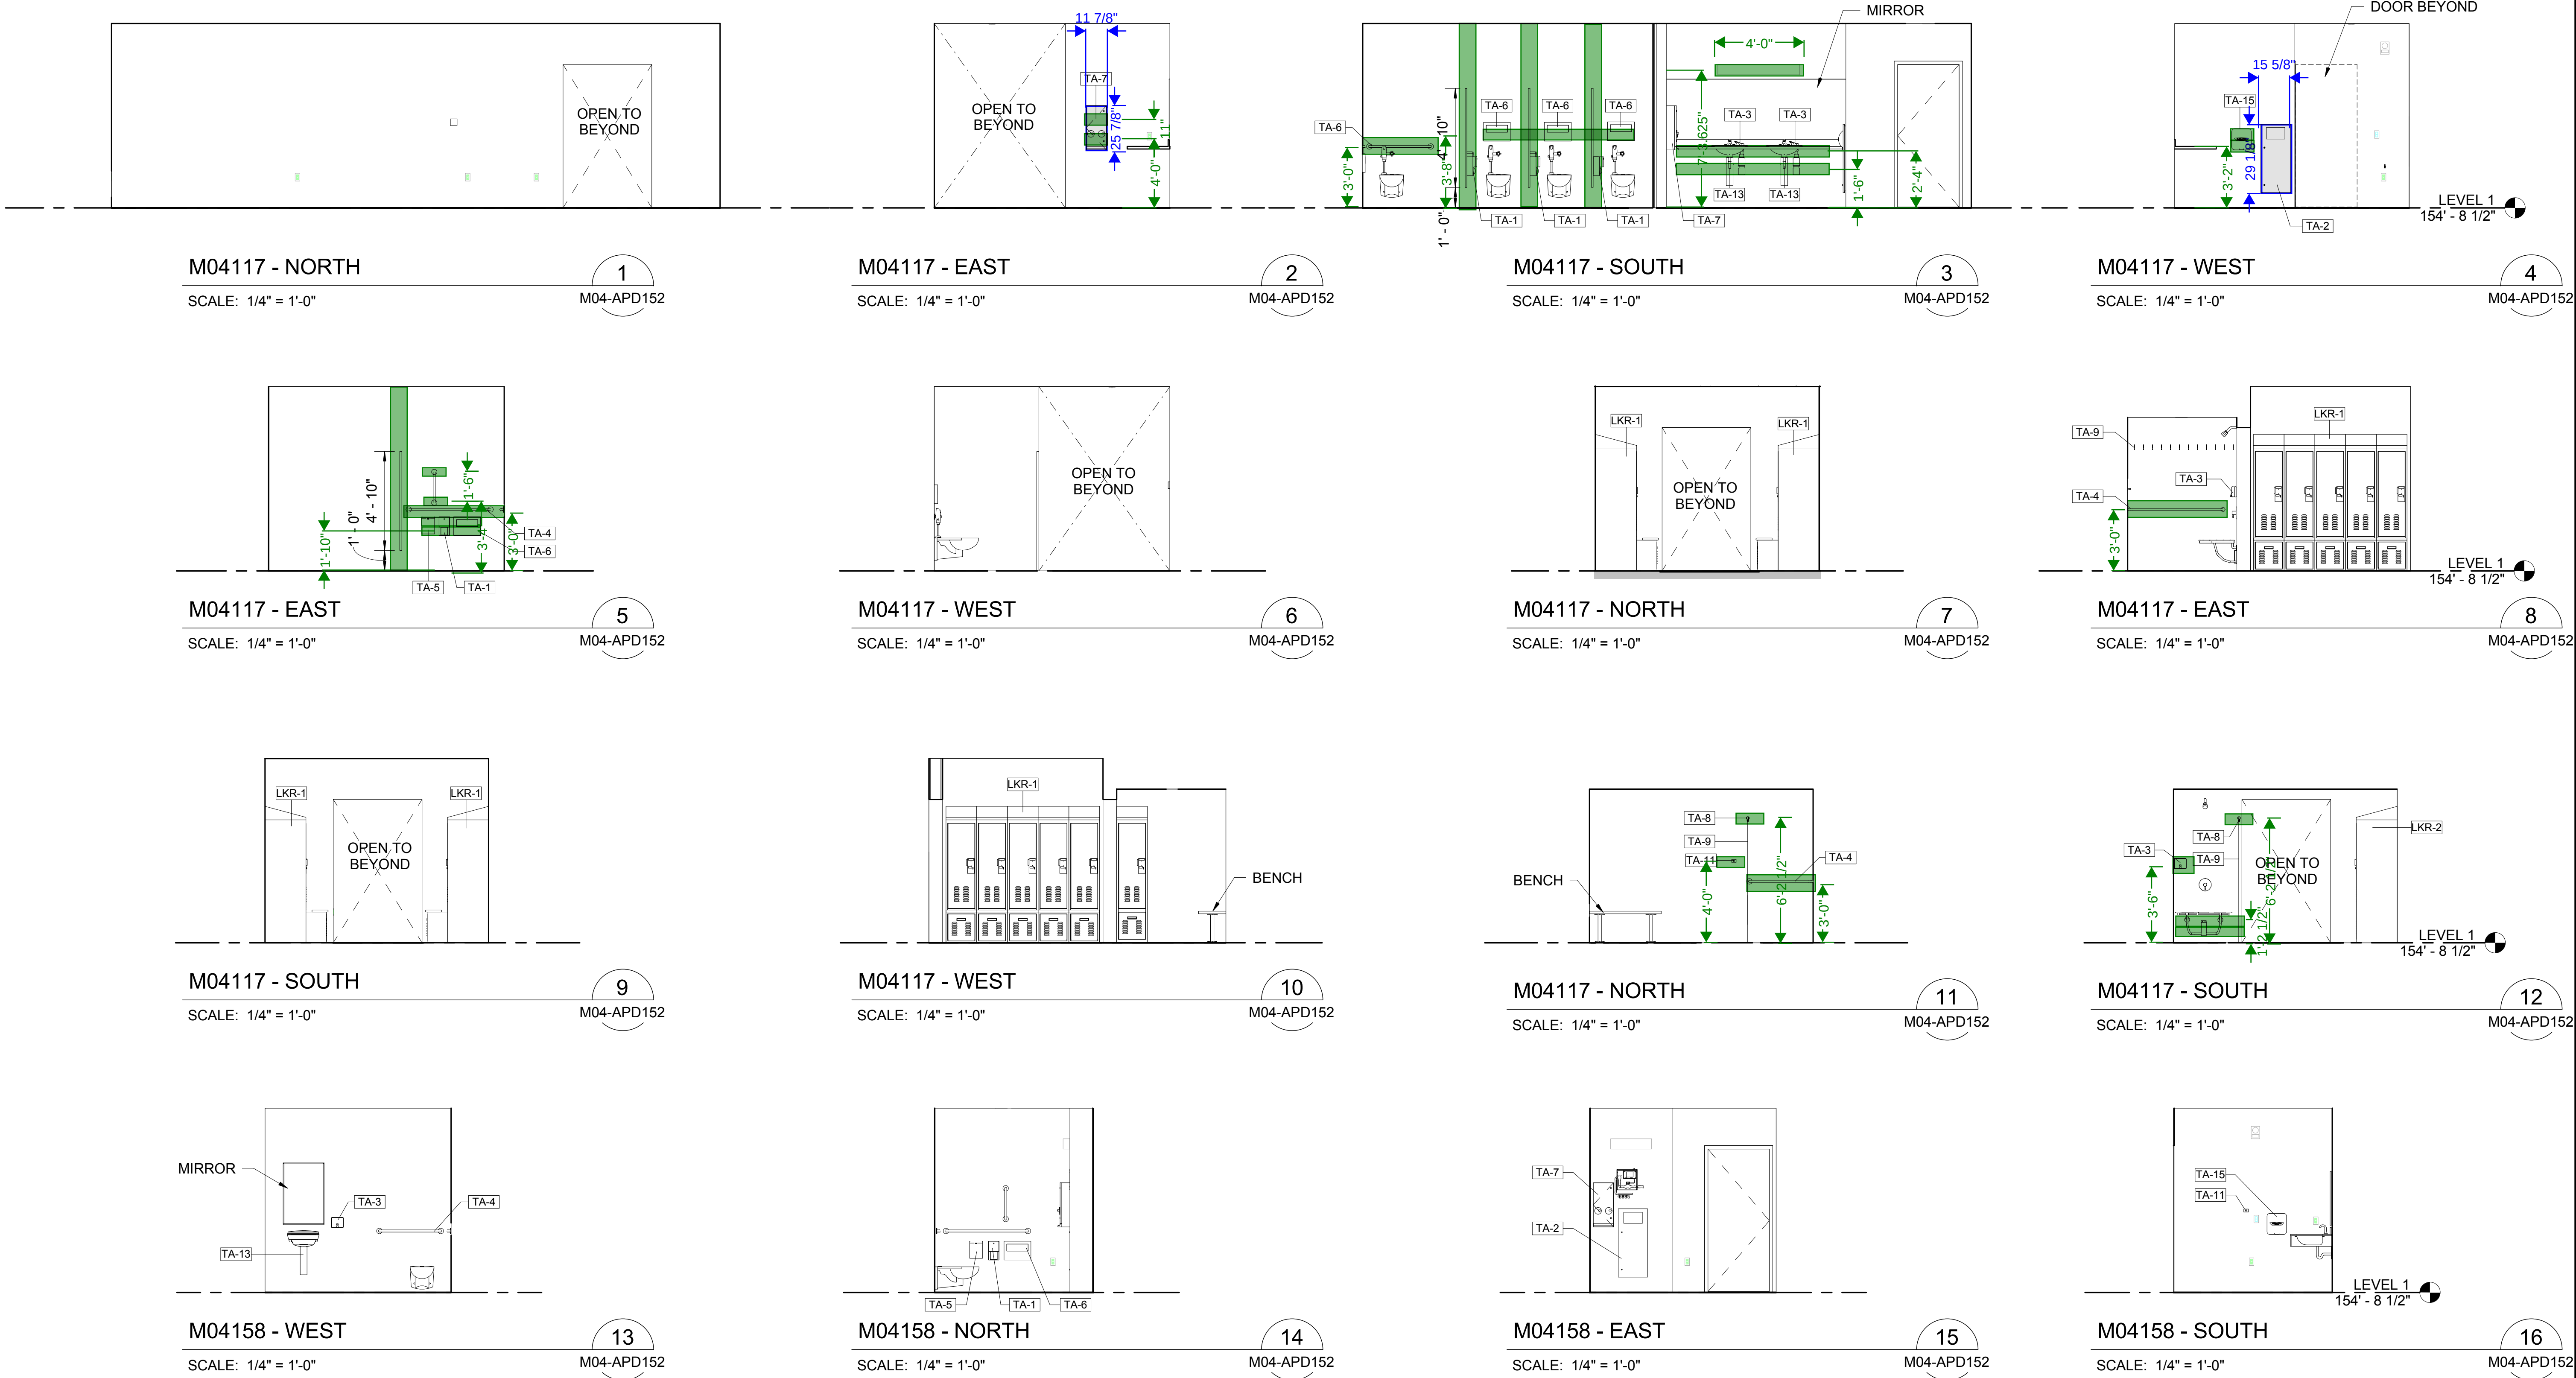


GENERAL NOTES

1. SEE GEN-AIE001 FOR MOUNTING HEIGHTS.
2. SEE GEN-AZN002 FOR TECHNICAL NOMENCLATURE & TOILET ACCESSORIES SCHEDULE.
3. SEE INTERIORS FOR WALL, FLOOR AND CEILING FINISHES.


DP4A-IFC						DESIGNED BY: B. PETERSON		7888 REGISTERED ARCHITECT <i>Alan Hart</i> Alan Hart STATE OF WASHINGTON 09/19/2018	HENSEL PHELPS Plan. Build. Manage. Stantec		coterra ENGINEERING rolluda architects architecture planning interior design ELCON ASSOCIATES, INC. ENGINEERS-CONSULTANTS		SOUNDTRANSIT		SCALE: 1/4" = 1'-0"		LINK OPERATIONS & MAINTENANCE FACILITY: EAST CONTRACT M200 OMF EAST OMF EAST BUILDING LEVEL 1 INTERIOR ELEVATIONS				DRAWING NO.: M04-AIE002	
						DRAWN BY: T. WEST			FACILITY ID: M04													
						CHECKED BY: S. McDONALD			SHEET No: 110													
						APPROVED BY: J. YOUNG			REV: 0													
0	2018.09.19	BP	SM	JY	ISSUED FOR CONSTRUCTION		SUBMITTED BY: RICHARD LEWIS		DATE: 2018.09.19		REVIEWED BY: BILL FERRIS		DATE: 2018.09.19		SUBMITTAL DATE: 2018.09.19							
No.	DATE	DSN	CHK	APP	REVISION																	

10/17/2018 6:52:21 AM
C:\Users\bpeterson\Documents\M200-M04-A-v2017_bpeterson.rvt

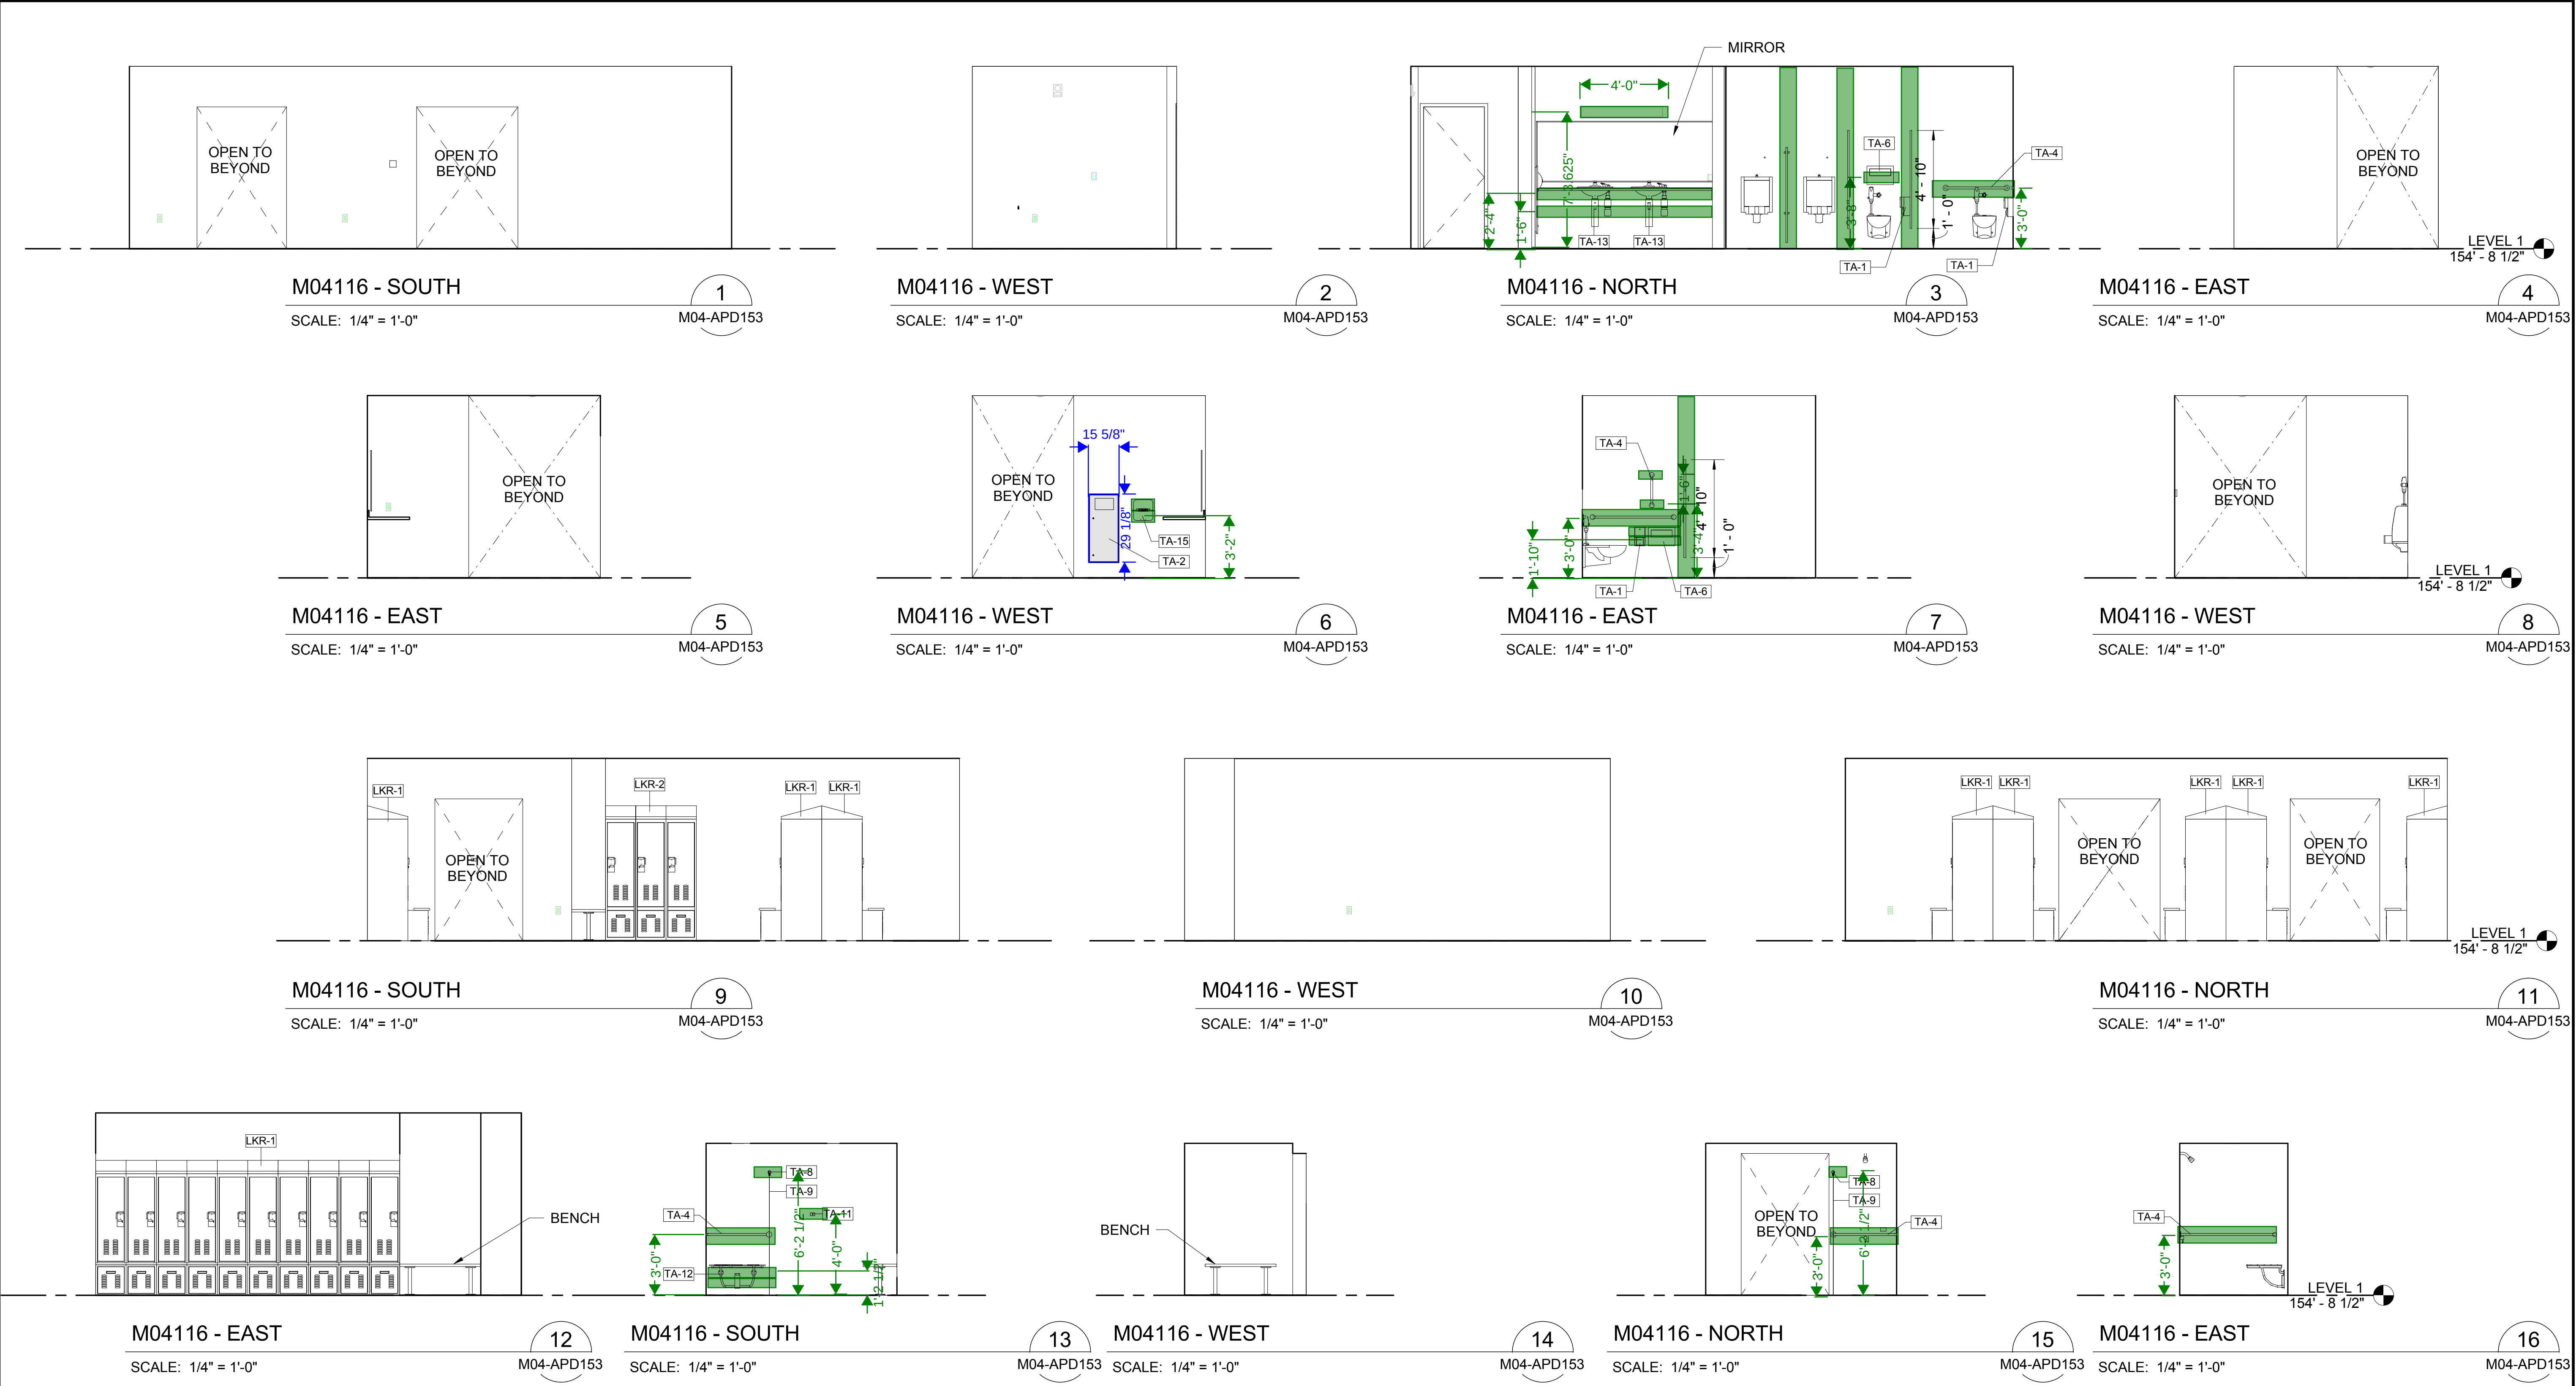

- GENERAL NOTES**
1. SEE GEN-AIE001 FOR MOUNTING HEIGHTS.
 2. SEE GEN-AZN002 FOR TECHNICAL NOMENCLATURE & TOILET ACCESSORIES SCHEDULE.
 3. SEE INTERIORS FOR WALL, FLOOR AND CEILING FINISHES.


DP4A-IFC						DESIGNED BY: B. PETERSON		7888 REGISTERED ARCHITECT	HENSEL PHELPS Plan. Build. Manage. coterra ENGINEERING rolluda architects architecture planning interior design ELCON ASSOCIATES, INC. ENGINEERS—CONSULTANTS Koren Kiest Landscape Architects Stantec VIA kpff				LINK OPERATIONS & MAINTENANCE FACILITY: EAST CONTRACT M200 OMF EAST OMF EAST BUILDING LEVEL 1 INTERIOR ELEVATIONS				DRAWING NO.: M04-AIE003	
						DRAWN BY: T. WEST			FACILITY ID: M04				SHEET No.: 111					
						CHECKED BY: S. McDONALD			CONTRACT No.: RTA/CN 0020-16				REV: 0					
						APPROVED BY: J. YOUNG			SUBMITTED BY: RICHARD LEWIS				DATE: 2018.09.19					
									REVIEWED BY: BILL FERRIS				DATE: 2018.09.19					
									DATE: 2018.09.19				SUBMITTAL DATE: 2018.09.19					
								LINE IS 1" AT FULL SCALE										

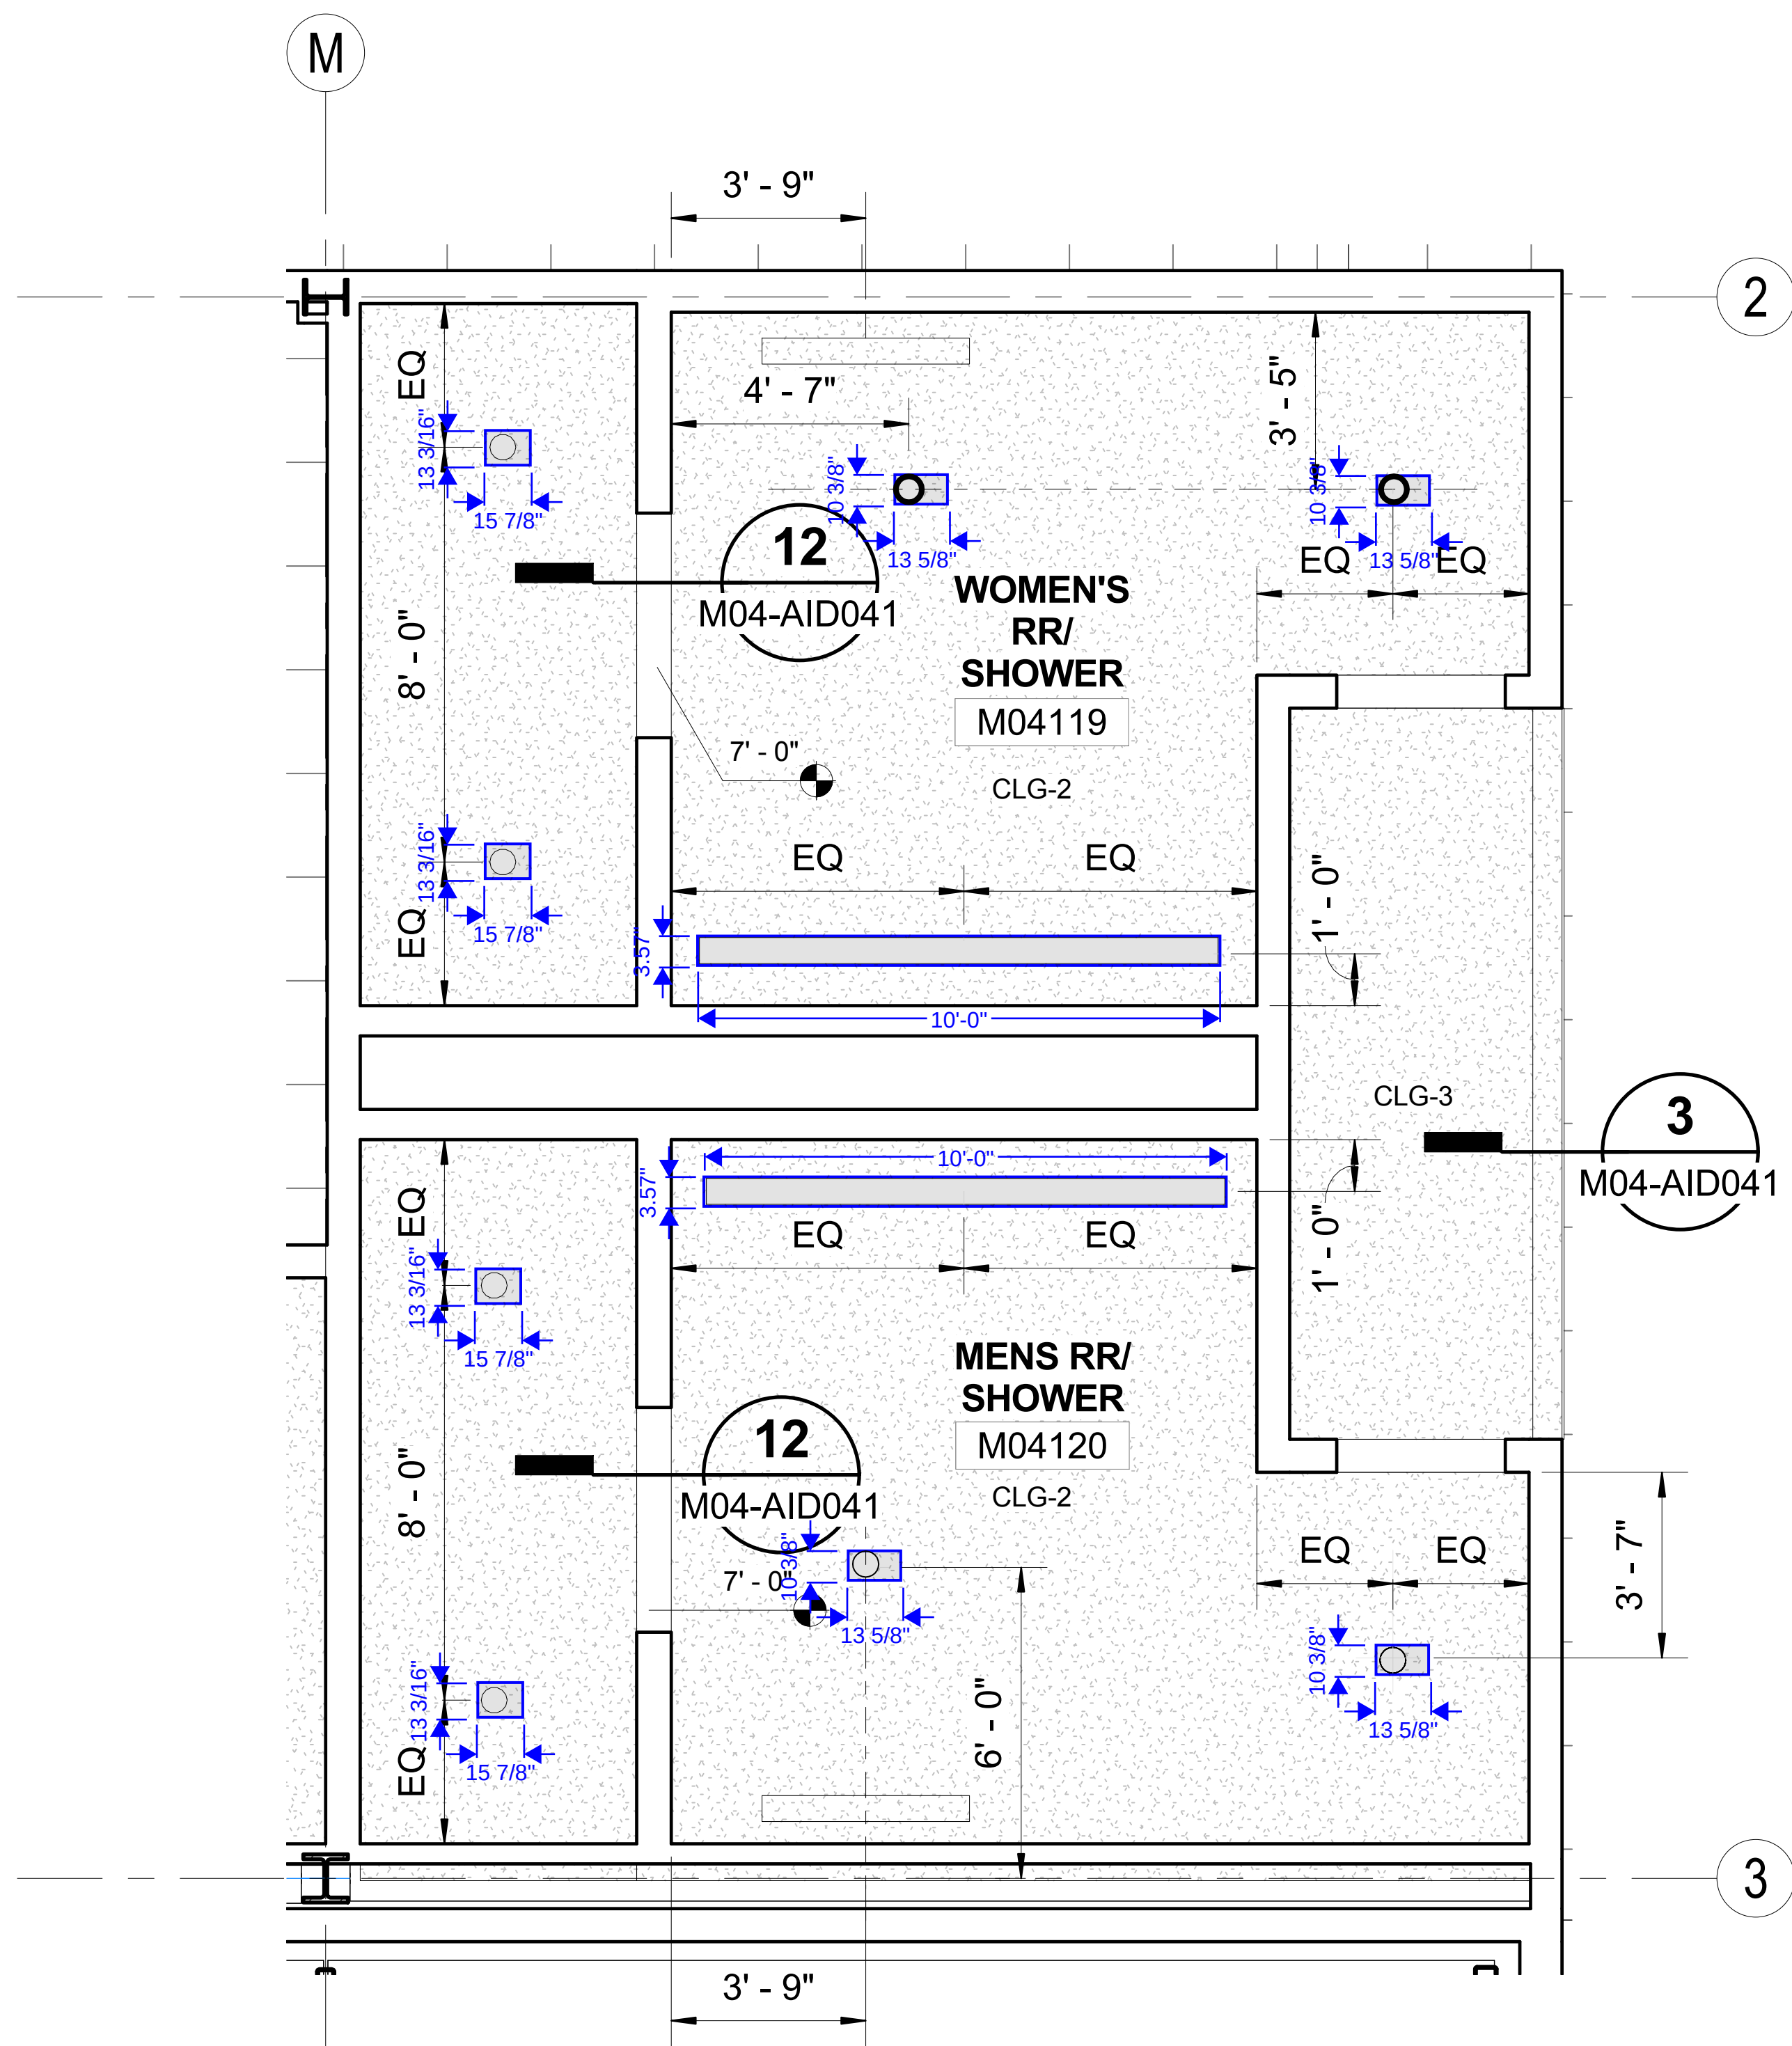

LEVEL 1 RCP - M04119 / M04120

SCALE: 1/4" = 1'-0"

1
M04-ACP113

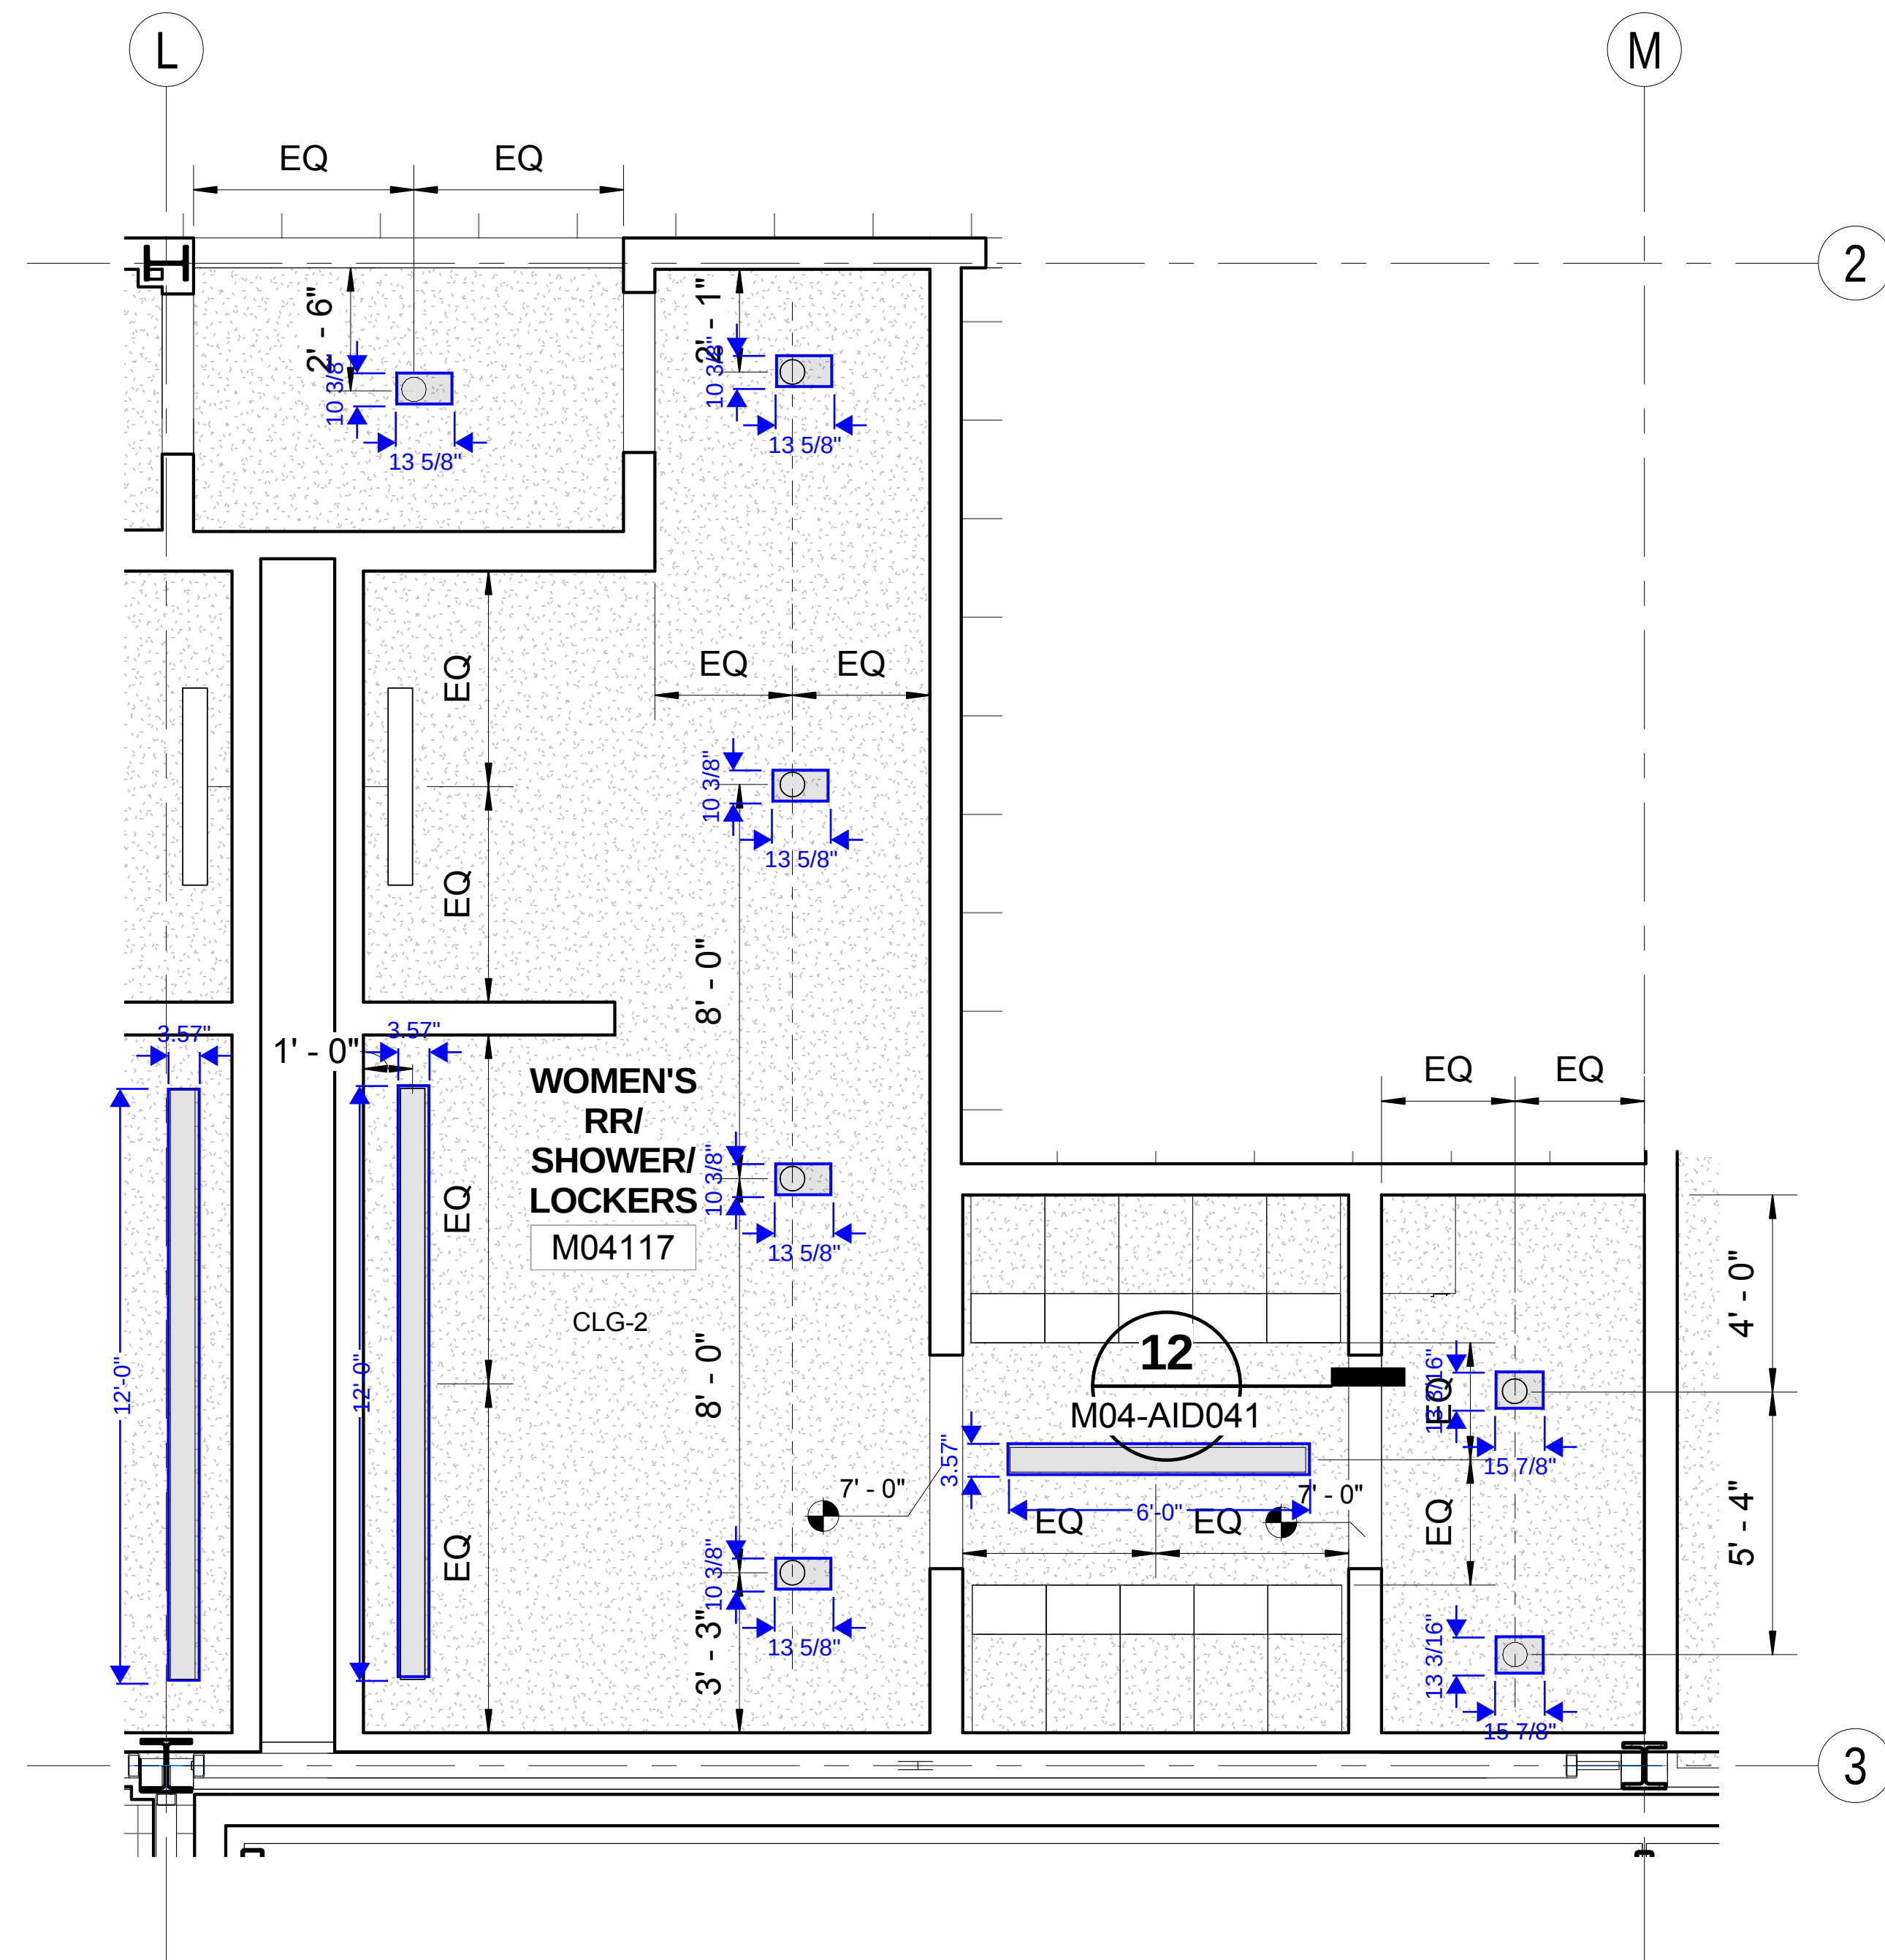

LEVEL 1 - RCP - M04117

SCALE: 1/4" = 1'-0"

1
M04-ACP113

