


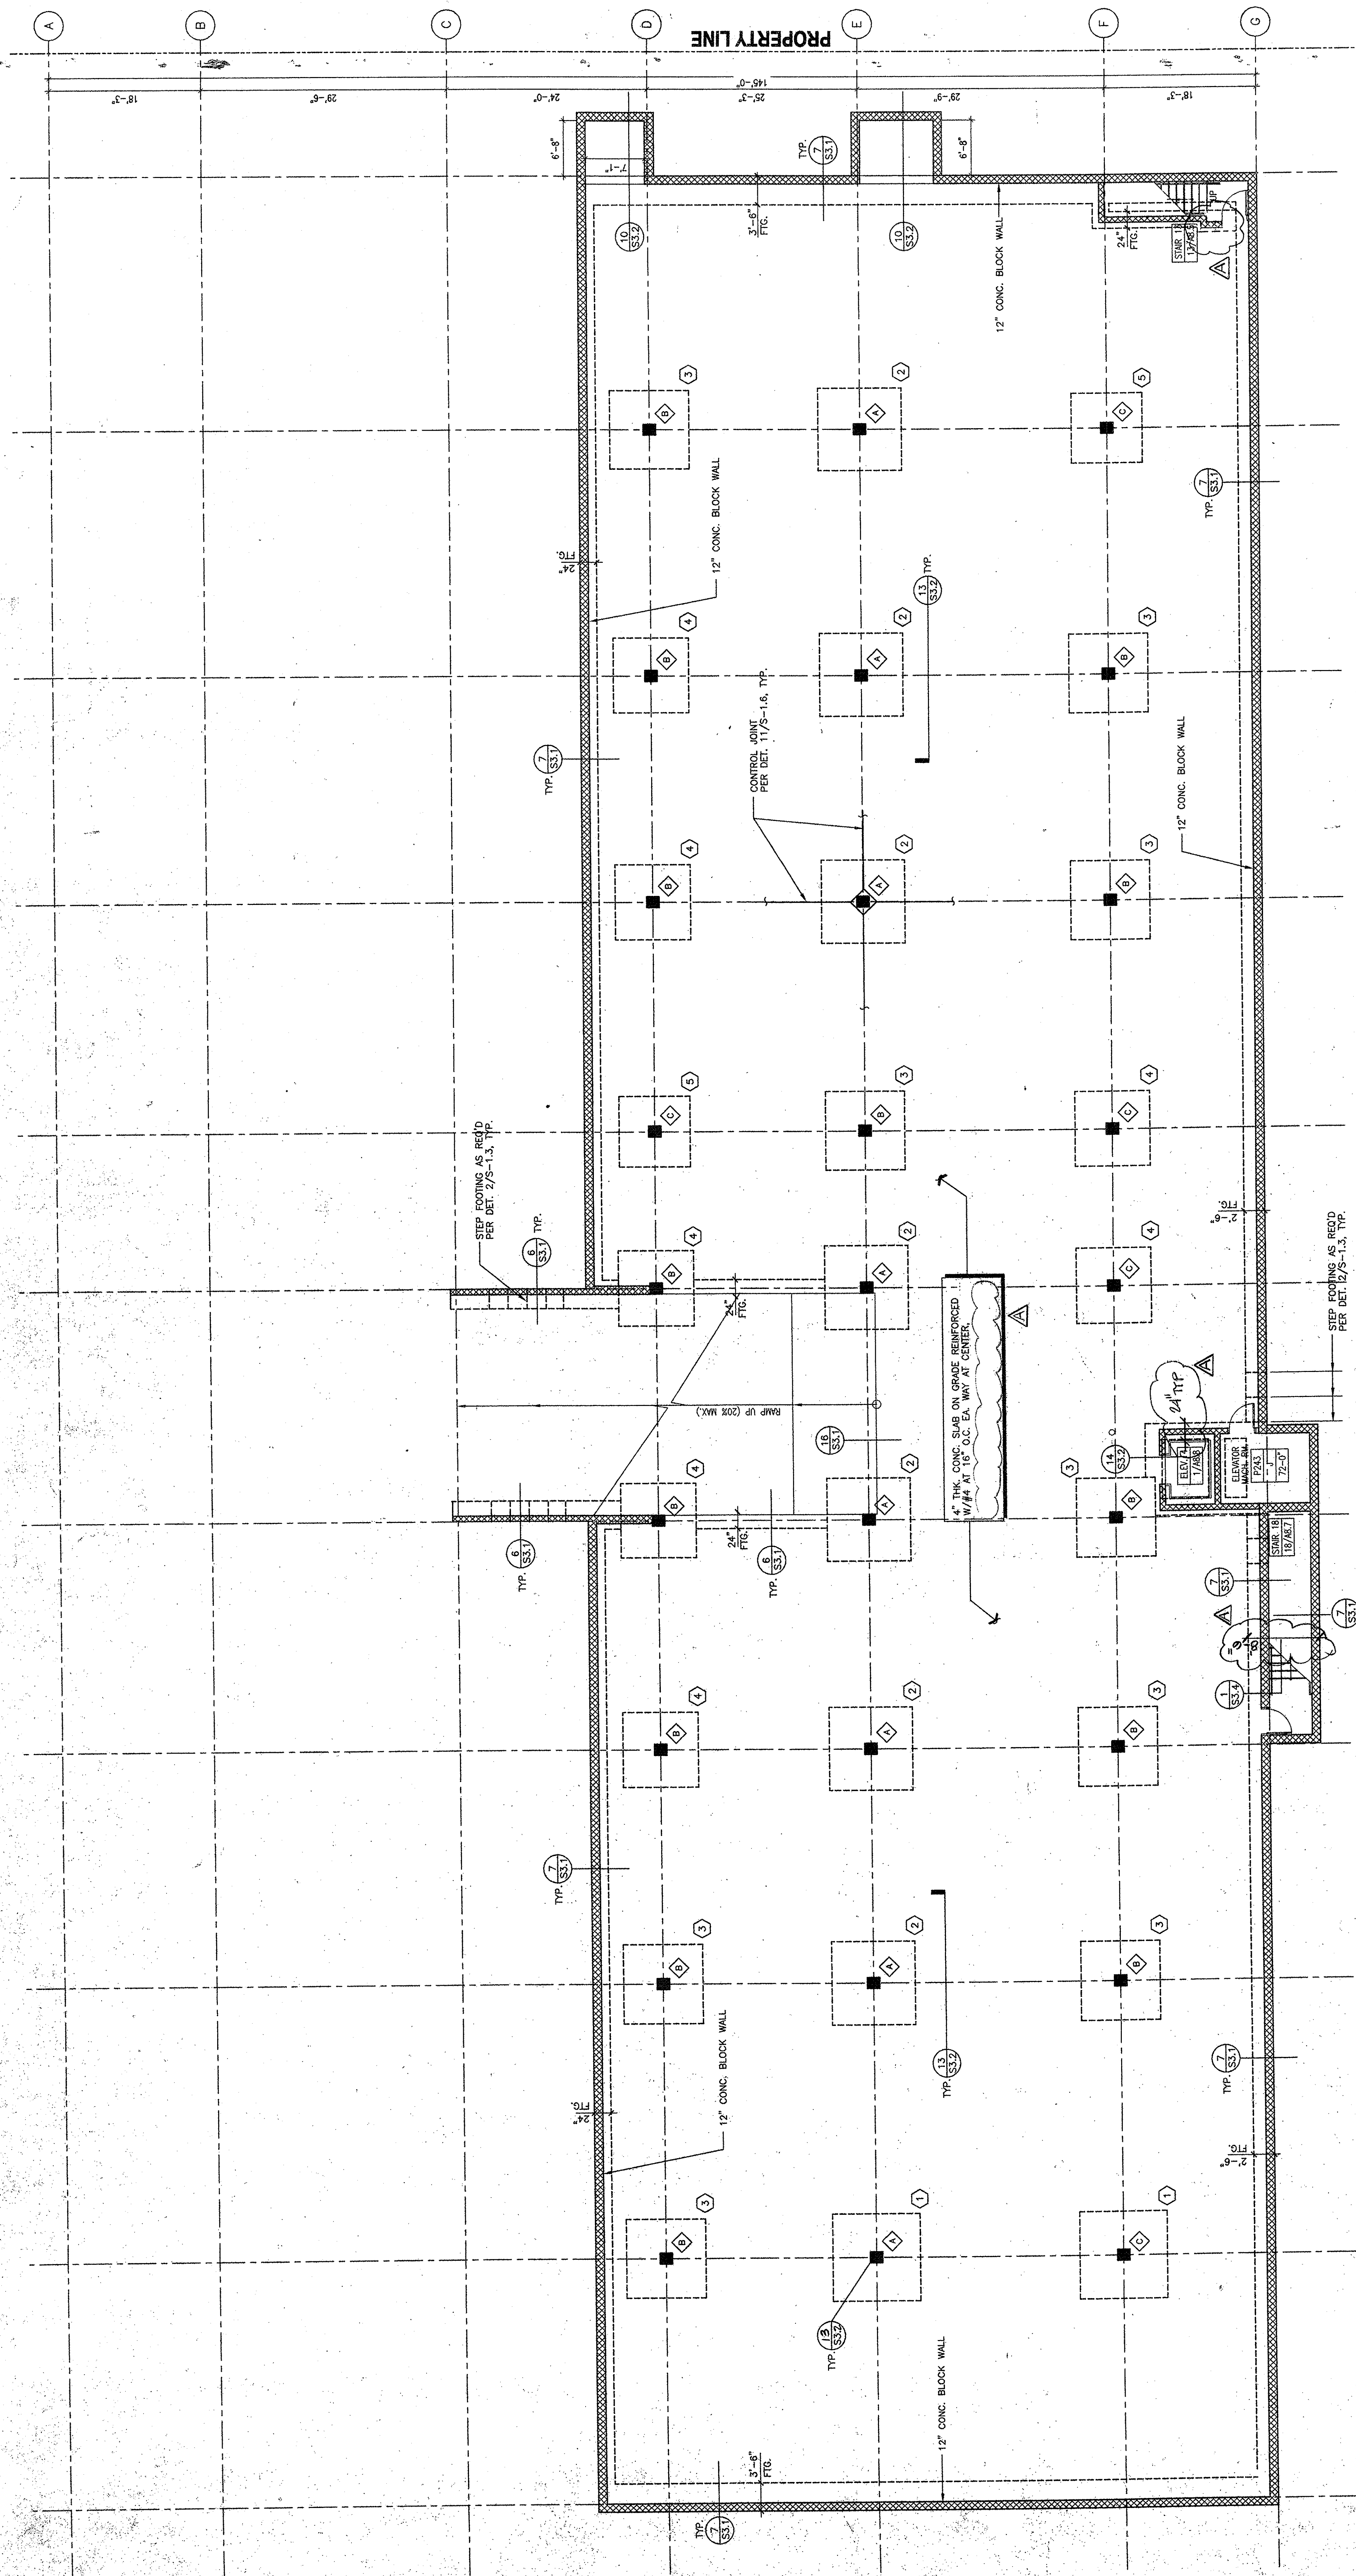

FOUNDATION PLAN - NORTHEAST GARAGE (LEVEL P2)

SCALE: 1/8" = 1'-0"

1


| SPREAD FOOTING SCHEDULE |                 |             |
|-------------------------|-----------------|-------------|
| FOOTING TYPE            | FTG. SIZE       | THICK. (in) |
| 1                       | 10'-6" x 10'-6" | 30"         |
| 2                       | 10'-0" x 10'-0" | 30"         |
| 3                       | 9'-6" x 9'-6"   | 28"         |
| 4                       | 9'-0" x 9'-0"   | 26"         |
| 5                       | 8'-6" x 8'-6"   | 25"         |
| 6                       | 8'-0" x 8'-0"   | 24"         |
| 7                       | 7'-6" x 7'-6"   | 23"         |
| 8                       | 7'-0" x 7'-0"   | 21"         |

- FOUNDATION NOTES:
- FOR TOP OF CONCRETE SLAB ELEVATION, SEE ARCH'L DRAWINGS. VERIFY ALL DIMENSIONS AND ELEV. WITH ARCH'L DWGS.
  - DENOTES FOOTING TYPE, FOR SIZE AND REINFORCING SEE FOOTING SCHEDULE.
  - TOP OF FOOTING ELEVATION IS 24" MINIMUM BELOW FINISH GRADE UNLESS NOTED OTHERWISE ON PLAN.
  - DENOTES COLUMNS TYPE, FOR SIZE AND REINF. SEE S-3.1.
  - FOR SLAB ON GRADE DETAILS SEE S-3.1.3.
  - FOR STEP FOOTING DETAILS SEE S-3.1.3.
  - FOR STEPS ON GRADE DETAILS SEE S-3.1.3.
  - VERIFY LOCATION AND DEPTH OF ALL SLAB DEPRESSIONS WITH ARCHITECTURAL DRAWINGS.
  - FOR STAIR DETAILS SEE S-3.3.



WALLS SHALL NOT BE BACKFILLED UNTIL THE STRUCTURAL SLAB ACHIEVE ITS REQ'D. STRENGTH.

**PLAYA DEL REY**  
8700 PERSHING DRIVE  
PLAYA VISTA, CALIFORNIA 90293

**ARCHSTONE COMMUNITIES TRUST**  
8801 Wall Street, Suite 800  
Austin, Texas 78754

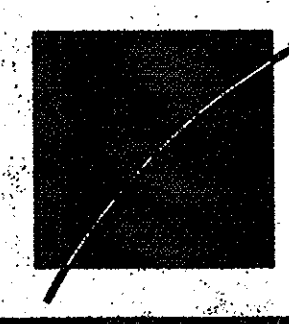

**VAN TILBURG, BANVARD & SODERBERGH, AIA**  
ARCHITECTURE • PLANNING • INTERIORS

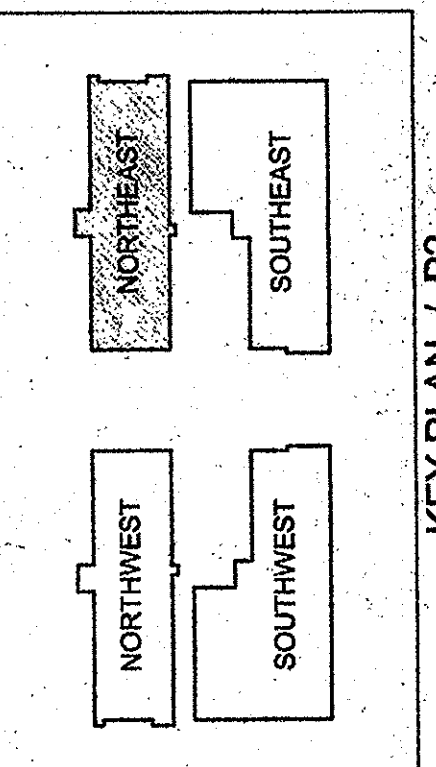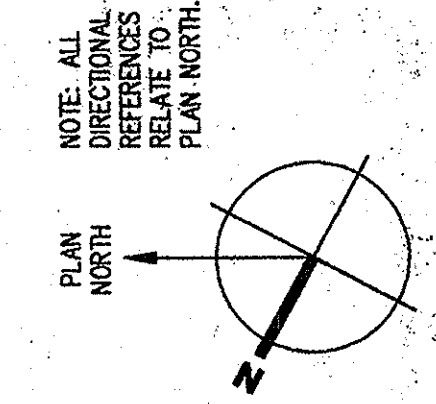

KEY PLAN / P2

**BRIAN L. COCHRAN ASSOCIATES, INC.**  
CONSULTING STRUCTURAL ENGINEERS  
2040 ARMADEO AVE. ANGELES CA 90025  
(310) 207-6638 FAX (310) 207-6188

| ISSUE    | DATE | DESCRIPTION                |
|----------|------|----------------------------|
| 08.15.00 |      | PROGRESS & REVIEW SET      |
| 09.05.00 |      | DESIGN DEVELOPMENT SET     |
| 10.17.00 |      | SIZE CD.                   |
| 11.10.00 |      | BLOC. DEPARTMENT SUBMITTAL |
| 05.05.01 |      | PLAN CHECK RESUBMITTAL     |
| 07.22.01 |      | PLAN SET                   |

|          |      |
|----------|------|
| PROJECT: | 8885 |
| DRAWN:   | G.C. |
| CHECKED: | B.E. |

FOUNDATION PLAN  
LEVEL P2  
NORTHEAST GARAGE

5S-1