

**Los Angeles Lakers Headquarters**

2275 East Mariposa Avenue  
El Segundo, California 90245

RA Rec'd 012816  
Returned 020216  
RFI Code A0



**Request for Information**

---

**RFI 152 - Low Roof Steel Connection**

---

<i>Date Submitted</i>	1/28/2016	<i>To</i>	Fred Hofmann	<i>From</i>	Ethan Beaver
<i>Date Required</i>	2/4/2016		Rossetti		Morley Construction Company
<i>Discipline</i>	Structural		Tel: (313) 463-5151		Tel: 310-399-1600
<i>Author RFI Ref.</i>	OCE RFI-23		fhofmann@rossetti.com		ebeaver@morleybuilders.com

---

<i>Document Ref.</i>	<i>Number</i>	<i>Title</i>	<i>Revision</i>
	S-115	LOWER ROOF FRAMING PLAN - NORTH	Nov 20, 2015 - No: 4

---

**Question**

---

*Attachments*      None

Please provide a connection for the W12x19's below gridline G on lines 2 and 5 (see attached MCC-SK-RFI 152-1). The W12x19 is at an elevation of 132'-10-1/2" and the W16x40 is at an elevation of 134'-2-1/2".

**Answer**

---



*Date Answered* \_\_\_\_\_ *Answered By* \_\_\_\_\_

See comments on attached sheets, and see SK-152.1 for offset beam connection.

KM / JLA 2/1/16

This clarification is interpreted to be within the scope of referenced contracts issued in accordance with the Contract Documents, and without change in Contract Sum or Contract Time, and, as such, is not an authorization for work beyond the scope of the contract.



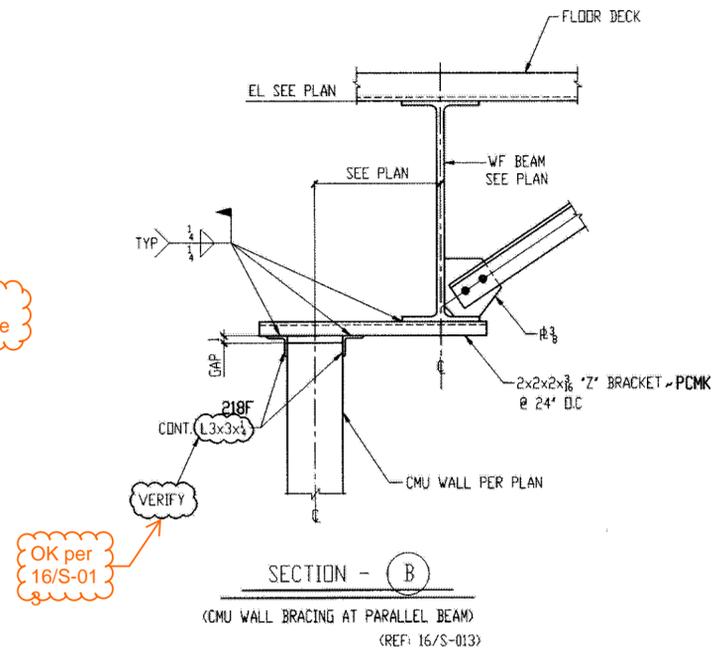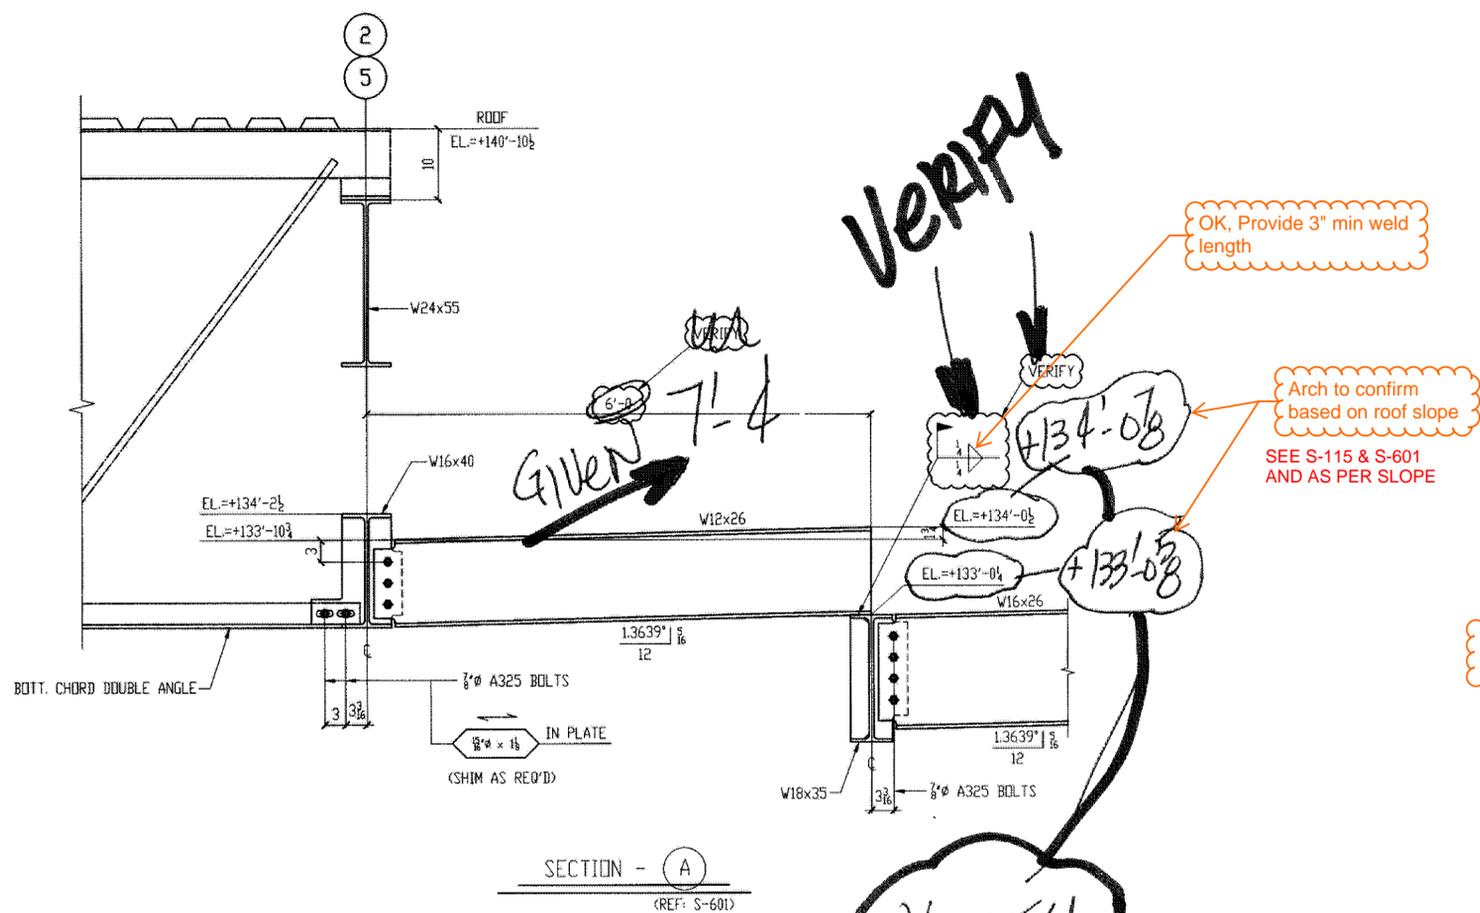

VERIFY

OK, Provide 3" min weld length

Arch to confirm based on roof slope


SEE S-115 & S-601 AND AS PER SLOPE

OK per 16/S-01

VERIFY

DRAWING LOG	
DATE	
SUBMIT FOR APPR.	▲ ▲ ▲ ▲ ▲ ▲ ▲
RECORD SET	
PURCHASING	
FABRICATION	
SHIPPING	
FIELD	
CONTRACTOR	
 <b>Orange County Erectors, Inc.</b>	
<small>517 E. LA PALMA AVENUE ANAHEIM, CALIFORNIA 92801 PHONE: (714) 502-8455 FAX: (714) 502-0034 E-MAIL: DETAILING@OCERECTORS.COM</small>	
<small>CA STATE CONTRACTOR'S LICENSE #0347098 NV STATE CONTRACTOR'S LICENSE #0035424</small>	
JOB:	LOS ANGELES LAKERS HEADQUARTERS
CONTRACTOR:	MORLEY CONSTRUCTION COMPANY
SITE ADDRESS:	2275 MARIPOSA, EI SEGUNDO, CA.
DRAWN BY:	ANN
CHECKED BY:	MF
DATE:	REF
SCOPE ITEM:	DETAILS
ERECTED	<input checked="" type="checkbox"/>
F.O.B.	15-019
RELEASE NO.	E20
JOB NO.	15-019

Record Print

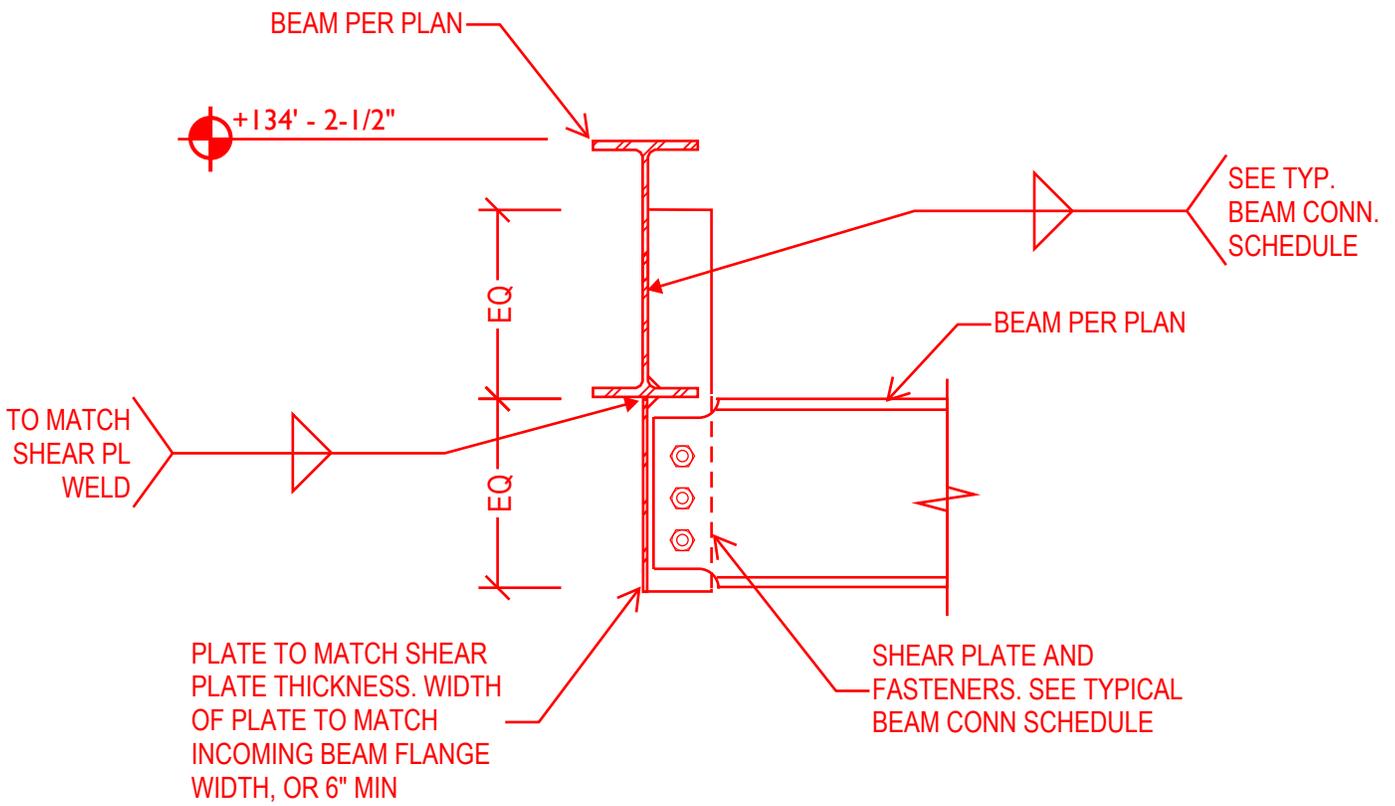

1  
-

## OFFSET BEAM DETAIL

SCALE: N.T.S

SK-152.1  
JLA / KM 2/1/16