

Los Angeles Lakers Headquarters

2275 East Mariposa Avenue
El Segundo, California 90245

RA Rec'd 012515
Returned 012516
RFI Code A0



Request for Information

RFI 151 - Storefront Door Widths

<i>Date Submitted</i>	1/23/2016	<i>To</i>	Fred Hofmann	<i>From</i>	Ethan Beaver
<i>Date Required</i>	1/30/2016		Rossetti		Morley Construction Company
<i>Discipline</i>	Architectural		Tel: (313) 463-5151		Tel: 310-399-1600
<i>Author RFI Ref.</i>	None		fhofmann@rossetti.com		ebeaver@morleybuilders.com

<i>Document Ref.</i>	<i>Number</i>	<i>Title</i>	<i>Revision</i>
	A-101.1	North (Envelope) - Level 01	Nov 20, 2015 - No: 2
	A-101.2	South (Envelope) - Level 01	Nov 20, 2015 - No: 2
	A-641	Door Schedule - Exterior Doors	Nov 20, 2015 - No: 1

Question

Attachments None

The door schedule on A-641 calls for all ground floor storefront pairs to have 72" wide openings and singles to have 36" wide openings. Based on the architectural plan layouts and the dimension of the curtainwall system (2-1/2"), with door sub frames, the door opening widths are 2" to 4-3/8" smaller than what is called out on the plans. Per the attached MCC-SK-RFI 151-1 through MCC-SK-RFI 151-5 please advise if adjustments need to be made for the doors clouded on the schedule.

Note door 1084.1 will not meet ADA based on the 32-3/4" door opening.


Answer

Date Answered _____ *Answered By* _____

All door need to remain at 72" or 36" wide openings. Adjust storefronts to accommodate. 1/25/16 FJH

This clarification is interpreted to be within the scope of referenced contracts issued in accordance with the Contract Documents, and without change in Contract Sum or Contract Time, and, as such, is not an authorization for work beyond the scope of the contract.

Door Schedule																			
Opng. No.	Opening Size		Door						Detail/Sheet			Frame				Hdwe Set	Fire Rating	Remarks	
	Width	Height	Type	Mat'l	Thr'h Type	Finish		Glass Type	Head	Jamb	Sill	Mat'l	Elev. Type	Glass Type	Finish				
						Mat'l	Code								Mat'l				Code
EX1001.1	6' - 0"	9' - 11"	FG	GL	AL	GL	GT00	03S	4 A-641	1+5 A-641	3 A-641	AL	2	-	AA	00	03	#1, #2, #6	
EX1020.59	40' - 6"	12' - 0"	BP	GL	-	-	-	-				-	-	-	-	-	-	-	#9
EX1037.1	6' - 0"	10' - 0"	FG	GL	AL	GL	GT	03S	4 A-641	4+5 A-351	3 A-641	AL	2	-	AA	00	01	#1	
EX1037.2	6' - 0"	8' - 0"	FG	GL	AL	GL	GT	03S	2 A-641	1 A-641	3 A-641	AL	2	-	AA	00	01		
EX1038.1	6' - 0"	7' - 10 3/4"	FG	GL	AL	GL	GT	03S	6 A-341.1	3 A-341.1	5 A-341.1	AL	2	-	AA	00	04	#1	
EX1053.1	6' - 0"	8' - 0"	FG	GL	AL	GL	GT	03S	4 A-641	1+5 A-641	3 A-641	AL	2	-	AA	00		#1	
EX1053.2	6' - 0"	8' - 0"	FG	GL	AL	GL	GT	03S	4 A-641	5+6 A-641	3 A-641	AL	2	-	AA	00			
EX1053.3	6' - 0"	8' - 0"	FG	GL	AL	GL	GT	03S	4 A-641	5+6 A-641	3 A-641	AL	2	-	AA	00			
EX1053.4	6' - 0"	8' - 0"	FG	GL	AL	GL	GT	03S	4 A-641	5+6 A-641	3 A-641	AL	2	-	AA	00			
EX1054.1	10' - 0"	12' - 0"	RD	STL	STL	PNT	00	-	4 A-321.1	3 A-321.1	4 A-321.1	STL	-	-	PNT	00	09		
EX1060.5	6' - 0"	9' - 10"	FG	GL	AL	GL	GT	03S	2 A-641	1+6 A-641	3 A-641		2	-			02		
EX1060.6	6' - 0"	9' - 10"	FG	GL	AL	GL	GT	03S	2 A-641	6 A-641	3 A-641	AL	2	-	AA	00	02	#6	
EX1060.7	6' - 0"	9' - 10"	FG	GL	AL	GL	GT	03S	2 A-641	6 A-641	3 A-641	AL	2	-	AA	00	02	#6	
EX1060.8	6' - 0"	9' - 10"	FG	GL	AL	GL	GT	03S	2 A-641	1+6 A-641	3 A-641	AL	2	-	AA	00	02	#6	
EX1061.1	3' - 0"	8' - 0"	N	HM	AL	PNT	00	-	2 A-641	1 A-641	3 A-641	HM	1		PNT	00		-	#2, #10
EX1063.1	3' - 0"	8' - 0"	F	HM	AL	PNT	00	-	2 A-641	1 A-641	3 A-641	HM	1	-	PNT	00		-	#2
EX1066.1	3' - 0"	8' - 0"	F	HM	AL	PNT	00	-	2 A-641	1 A-641	3 A-641	HM	1	-	PNT	00	06	-	#7
EX1067.1	3' - 0"	8' - 0"	N	HM	AL	PNT	00	-	2 A-641	1 A-641	3 A-641	HM	1		PNT	00	07	-	#7, #2
EX1067.2	10' - 0"	12' - 0"	RD	STL	STL	PNT	00	-	4 A-321.1	3 A-321.1	4 A-321.1	STL	-	-	PNT	00	09		
EX1070.1	3' - 0"	8' - 0"	N	HM	AL	PNT	00	-	2 A-641	1 A-641	3 A-641	HM	2		PNT	00	08	-	#2
EX1071.1	3' - 0"	8' - 0"	F	HM	AL	PNT	00	-	2 A-641	1 A-641	3 A-641	HM	1	-	PNT	00	05	-	#7, #2
EX1074.1	3' - 0"	8' - 0"	F	HM	AL	PNT	00	-	2 A-641	1 A-641	3 A-641	HM	1	-	PNT	00	05	-	#7, #2
EX1083.1	6' - 0"	9' - 10"	FG	GL	AL	GL	GT	03S	4 A-641	15 A-313 + 5 A-641	3 A-641	AL	2	-	AA	00			
EX1084.1	3' - 0"	10' - 0"	FG	GL	AL	GL	GT	03S	4 A-641	15 A-313	3 A-641	AL	1	-	AA	00	05	#2	
EX2119.1	3' - 0"	9' - 0"	N	HM	AL	PNT	00	-	1 A-383	1 A-641	1 A-383	HM	1		PNT	00		-	
EX3000.1	2' - 8"	8' - 0"	RF	HM	AL	PNT	00	-	8 A-641	7 A-641	8 A-641	STL	1		PNT	00		-	

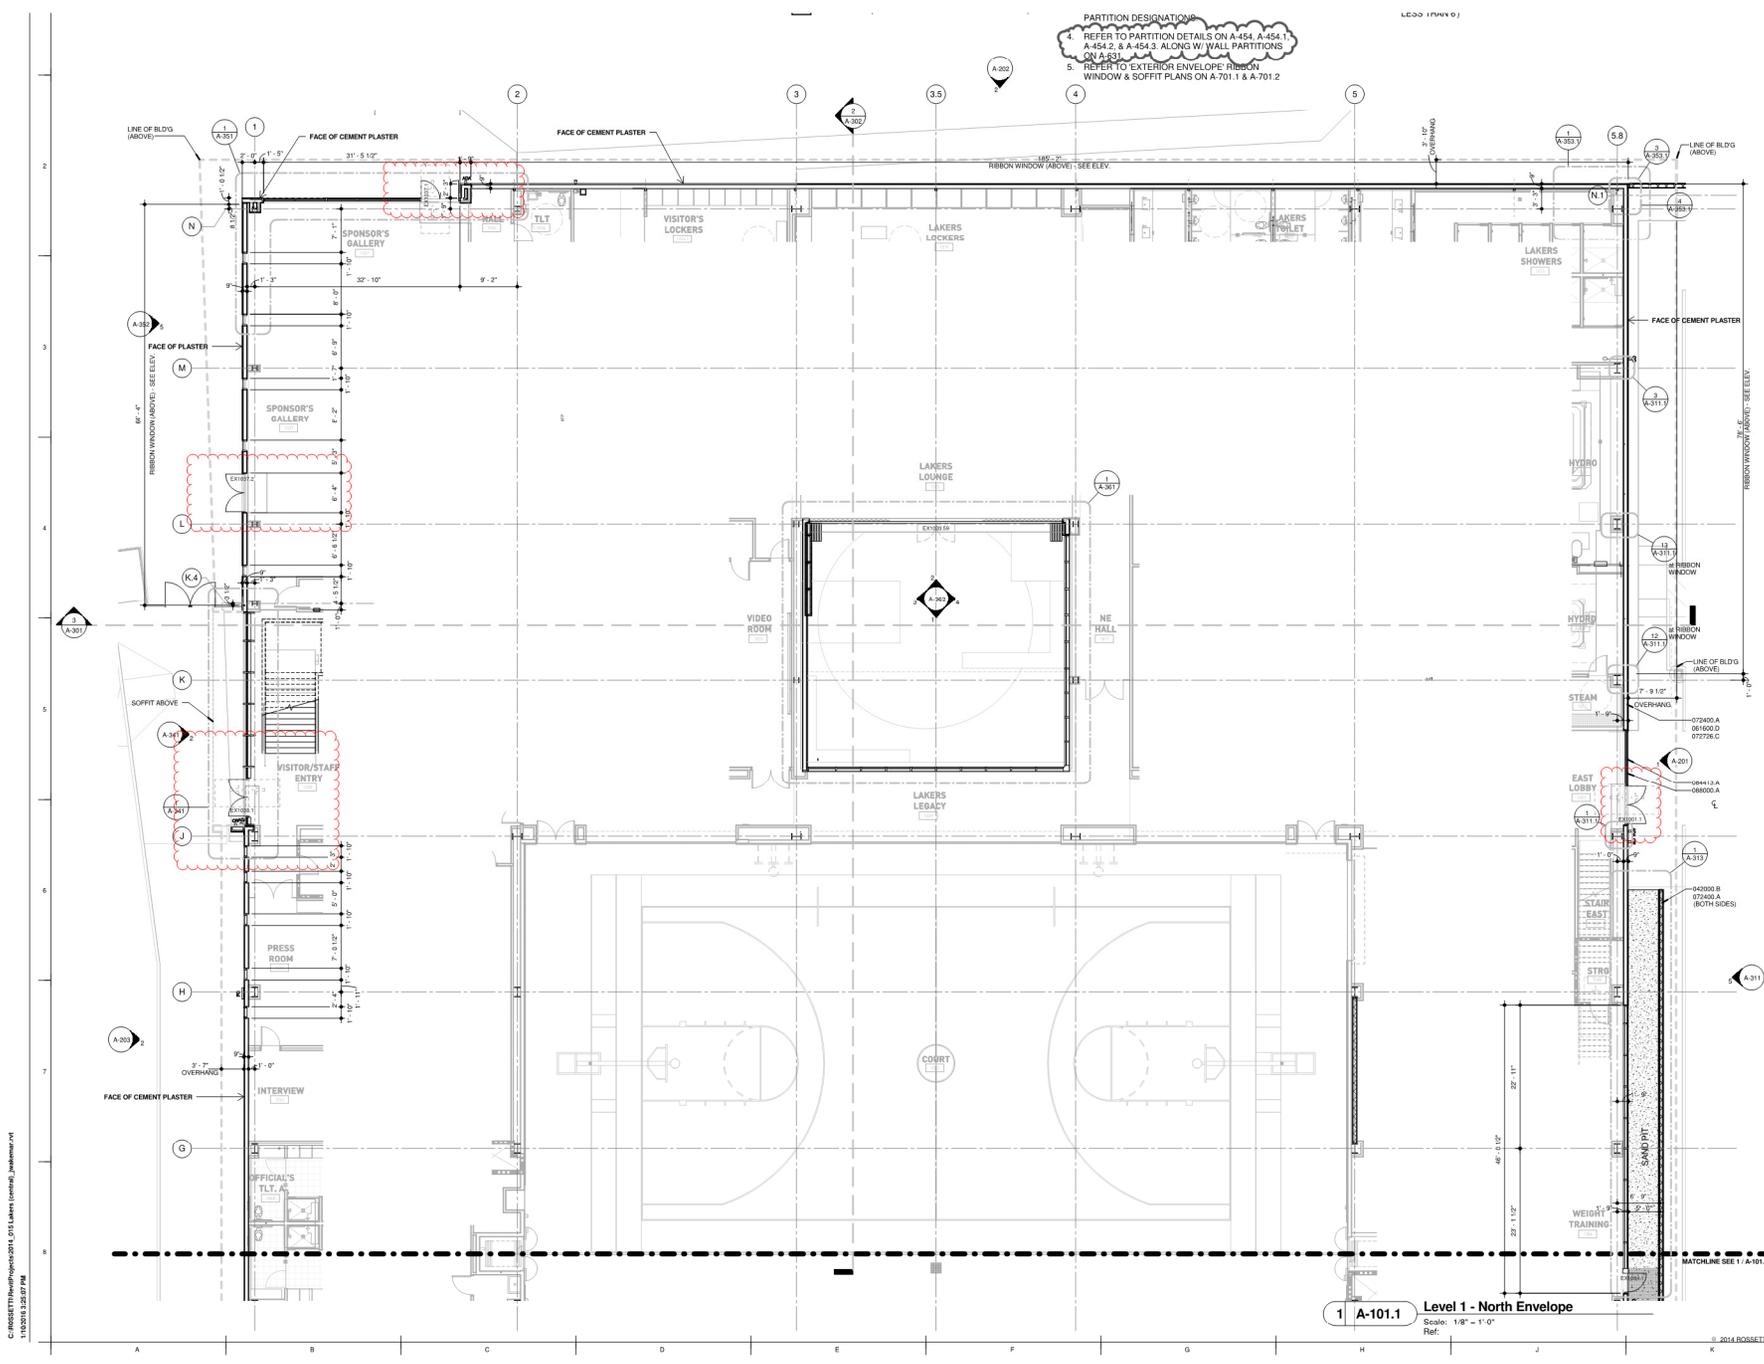

PARTITION DESIGNATION
 4. REFER TO PARTITION DETAILS ON A-454, A-454-A-454.2, & A-454.3, ALONG W/ WALL PARTITIONS ON A-453.
 5. REFER TO EXTERIOR ENVELOPE, RIBBON WINDOW & SOFFIT PLANS ON A-701.1 & A-701.2

All parties are advised that construction bids secured as a result of contents of documents which are incomplete must carry an adequate amount for financial and time contingency to cover completion of design and construction, including items that are customarily required but are not shown. Completed documents will be

Los Angeles Lakers Headquarters


2276 Mariposa
 El Segundo, California 90245

Consultant:

Professional Seal



No.	Description	Date
1	50% CDs for Pricing	08/07/15
2	Plan Check	09/18/15
3	Back-Check #1	11/20/15
4	Back-Check #2 - ASI 008	01/08/16

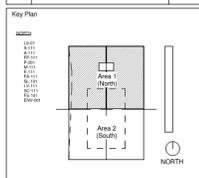


Sheet Title
North (Envelope) - Level 01

Project Number: 2014-015
 Sheet number

A-101.1

C:\PROJECTS\Bids\2014\2014_015 Lakers [locked]_bakshar.rvt
 1/16/2015 3:25:07 PM

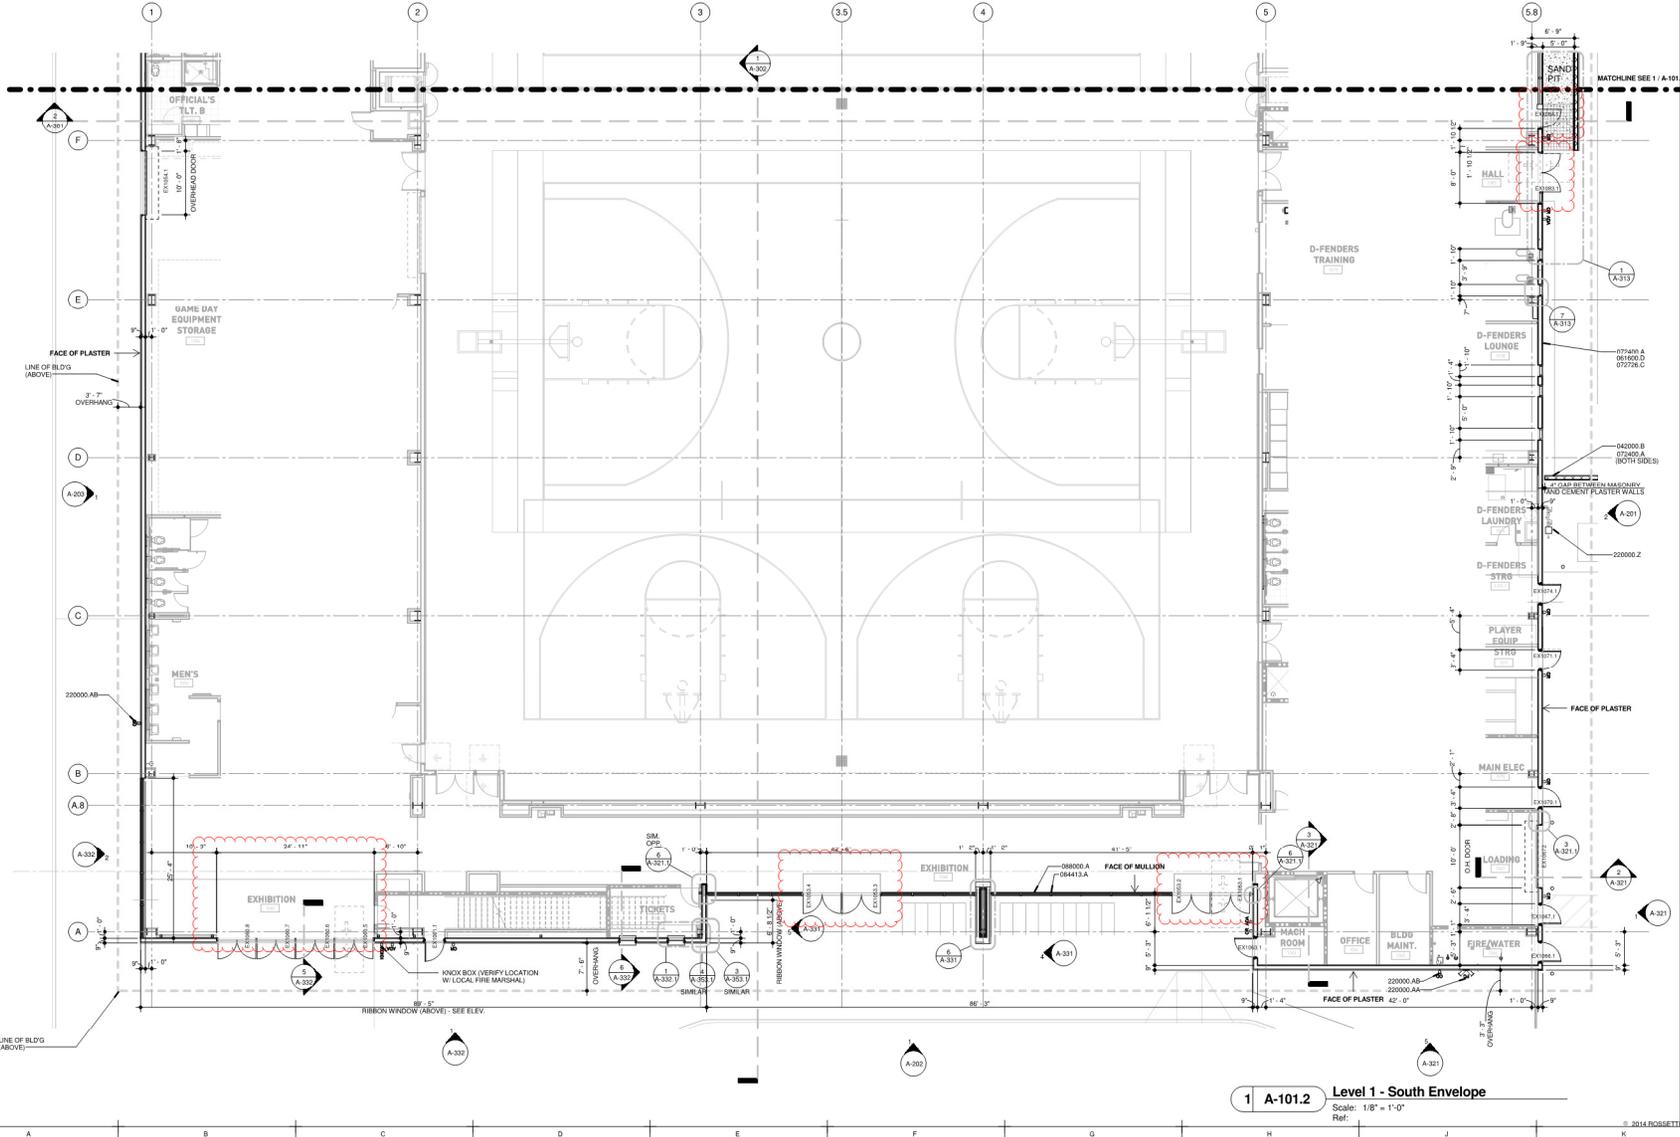


All parties are advised that construction bids secured as a result of contents of documents which are incomplete must carry an adequate amount of financial and time contingency to cover completion of design and construction, including items that are customarily required.

2275 Mariposa
El Segundo, California 90245

Consultant



No.	Description	Date
1	50% CDs for Pricing	08/07/15
2	Plan Check	09/18/15
3	Back-Check #1	11/20/15
4	Back-Check #2 - ASI 008	01/08/16

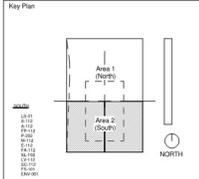

Sheet Title
South (Envelope) - Level 01

Project Number
2014-015

Sheet Number
A-101.2

1 A-101.2 Level 1 - South Envelope
Scale: 1/8" = 1'-0"
Ref:

C:\PROJECTS\151\RFI\151-RFI-151-3.dwg (L:\151\151-3.dwg) - 11/20/15 12:52 PM

GLAZING TYPES

	GT-1
	GT-2
	GT-3
	GT-4
	GT-5

arcadia
ARCADIA, INC.
 7830 195th Street
 Kent, Washington 98032
 Ph: (425) 884-7300
 Fx: (253) 395-4234

OWNER/CLIENT
LAL PROPERTY, LLC
 A CALIFORNIA LIMITED LIABILITY COMPANY
 885 NORTH WASH STREET
 EL SEGUNDO, CA 90245

ARCHITECT:
ROSSETTI
 160 WEST FORT SUITE 400
 DETROIT, MI 48226

ASSOCIATE ARCHITECT:
PERKINS & WILL
 817 WEST 7TH STREET SUITE 1200
 LOS ANGELES, CA 90017

MORLEY BUILDERS
 3380 OCEAN PARK BLVD
 SANTA MONICA, CA 90405

GLAZING CONTRACTOR:

 AGA
 Industrial Glass & Insulation
 15281 ALTON PARKWAY
 BRIDGE, CA 92618

PROJECT:
**LOS ANGELES
 LAKERS HEAD
 QUARTERS**
 2275 MARIPOSA
 EL SEGUNDO, CA 90245

PROJECT # 2014-015

ENGINEER STAMP:

LEGEND:

- ▲ = WINDLOAD ANCHOR
- △ = DEADLOAD ANCHOR


ISSUES

NO.	DATE	DESCRIPTION
1	-	-
2		
3		
4		

DRAWN BY	CHECKED BY
WDL	
DATE: 11.13.15	SCALE: (IF DIFF. FROM SHEET) 1/4" = 1'

SHEET TITLE
ELEVATIONS

SHEET NUMBER
2.00

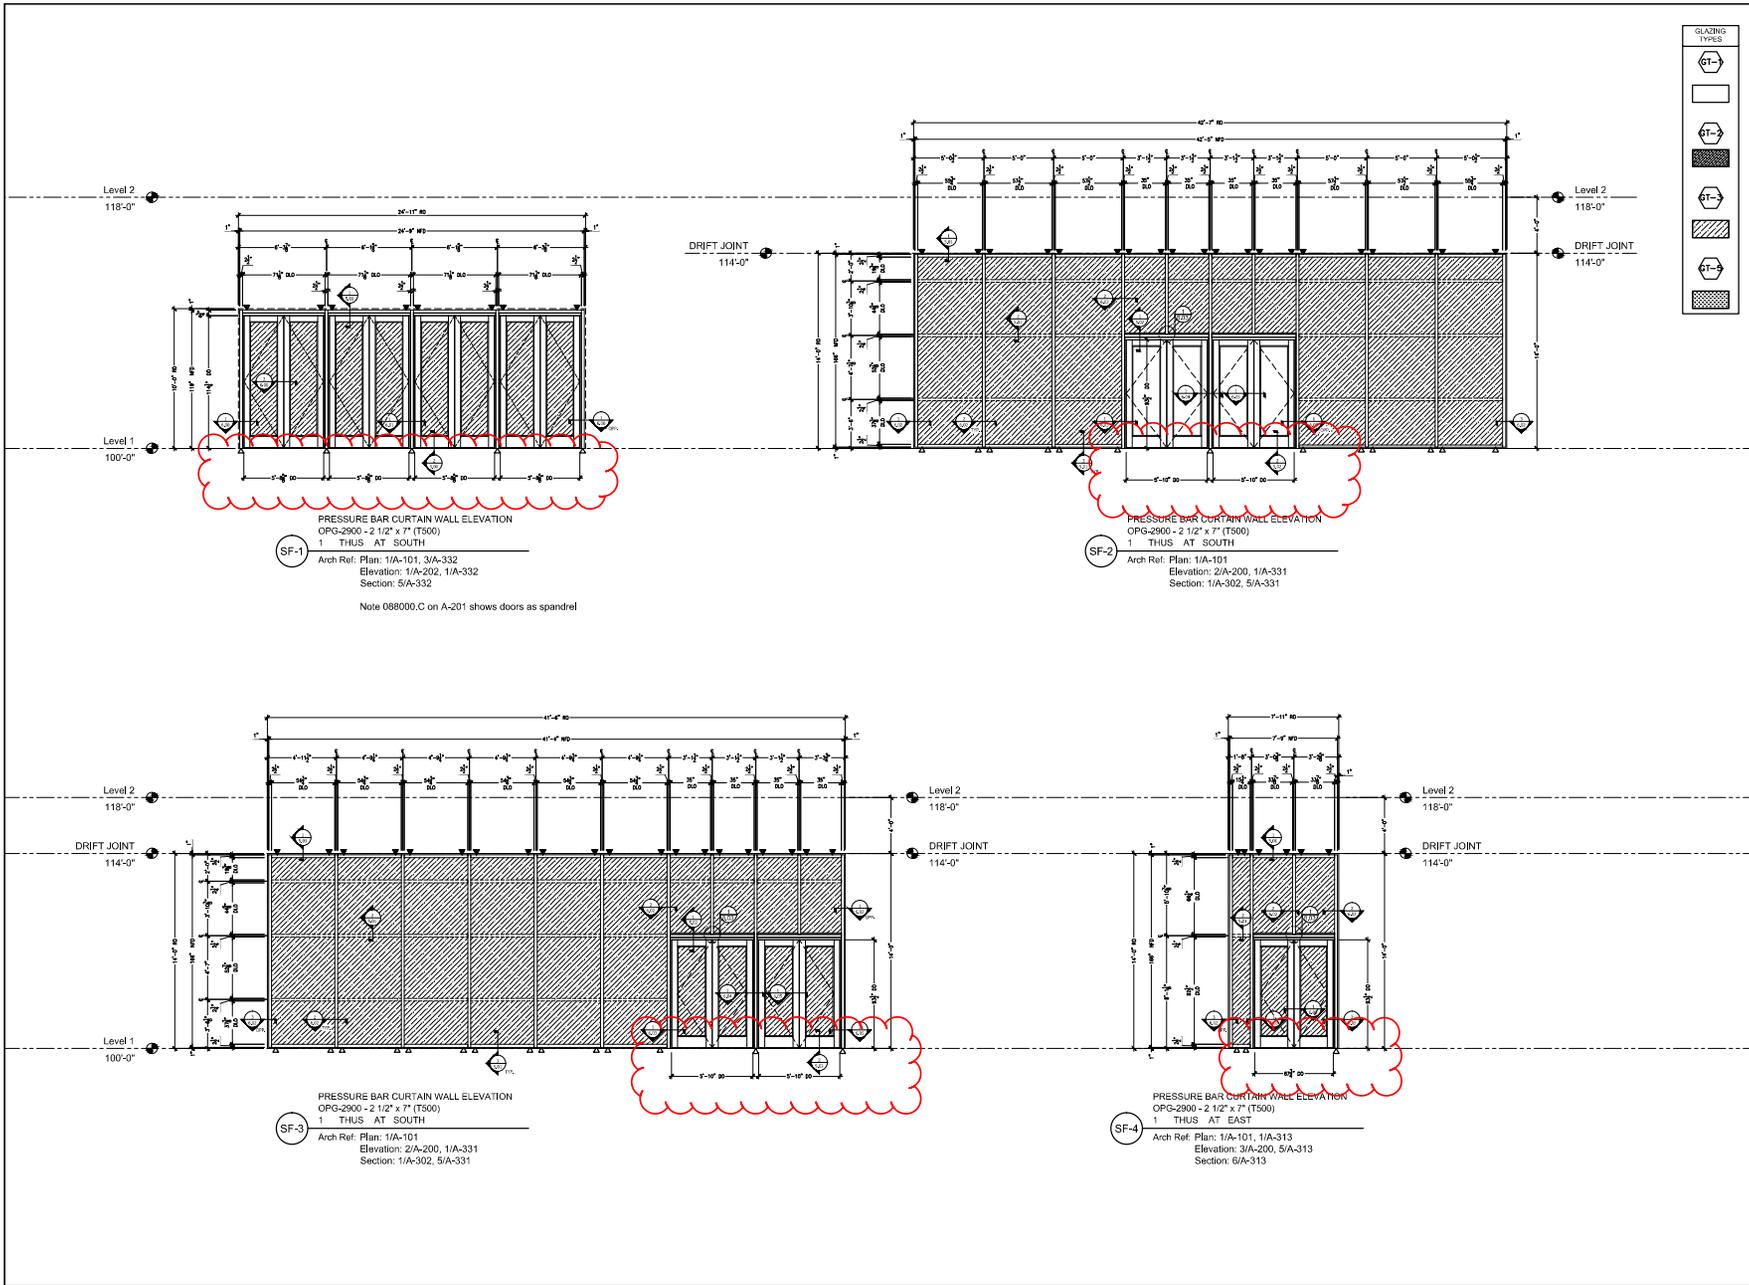


SF-1
 PRESSURE BAR CURTAIN WALL ELEVATION
 OPG-2900 - 2 1/2" x 7" (T500)
 1 THUS AT SOUTH
 Arch Ref: Plan: 1/A-101, 3/A-332
 Elevation: 1/A-202, 1/A-332
 Section: 5/A-332
 Note 088000.C on A-201 shows doors as spandrel

SF-2
 PRESSURE BAR CURTAIN WALL ELEVATION
 OPG-2900 - 2 1/2" x 7" (T500)
 1 THUS AT SOUTH
 Arch Ref: Plan: 2/A-101
 Elevation: 2/A-200, 1/A-331
 Section: 1/A-302, 5/A-331

SF-3
 PRESSURE BAR CURTAIN WALL ELEVATION
 OPG-2900 - 2 1/2" x 7" (T500)
 1 THUS AT SOUTH
 Arch Ref: Plan: 1/A-101
 Elevation: 2/A-200, 1/A-331
 Section: 1/A-302, 5/A-331

SF-4
 PRESSURE BAR CURTAIN WALL ELEVATION
 OPG-2900 - 2 1/2" x 7" (T500)
 1 THUS AT EAST
 Arch Ref: Plan: 1/A-101, 1/A-313
 Elevation: 3/A-200, 5/A-313
 Section: 6/A-313

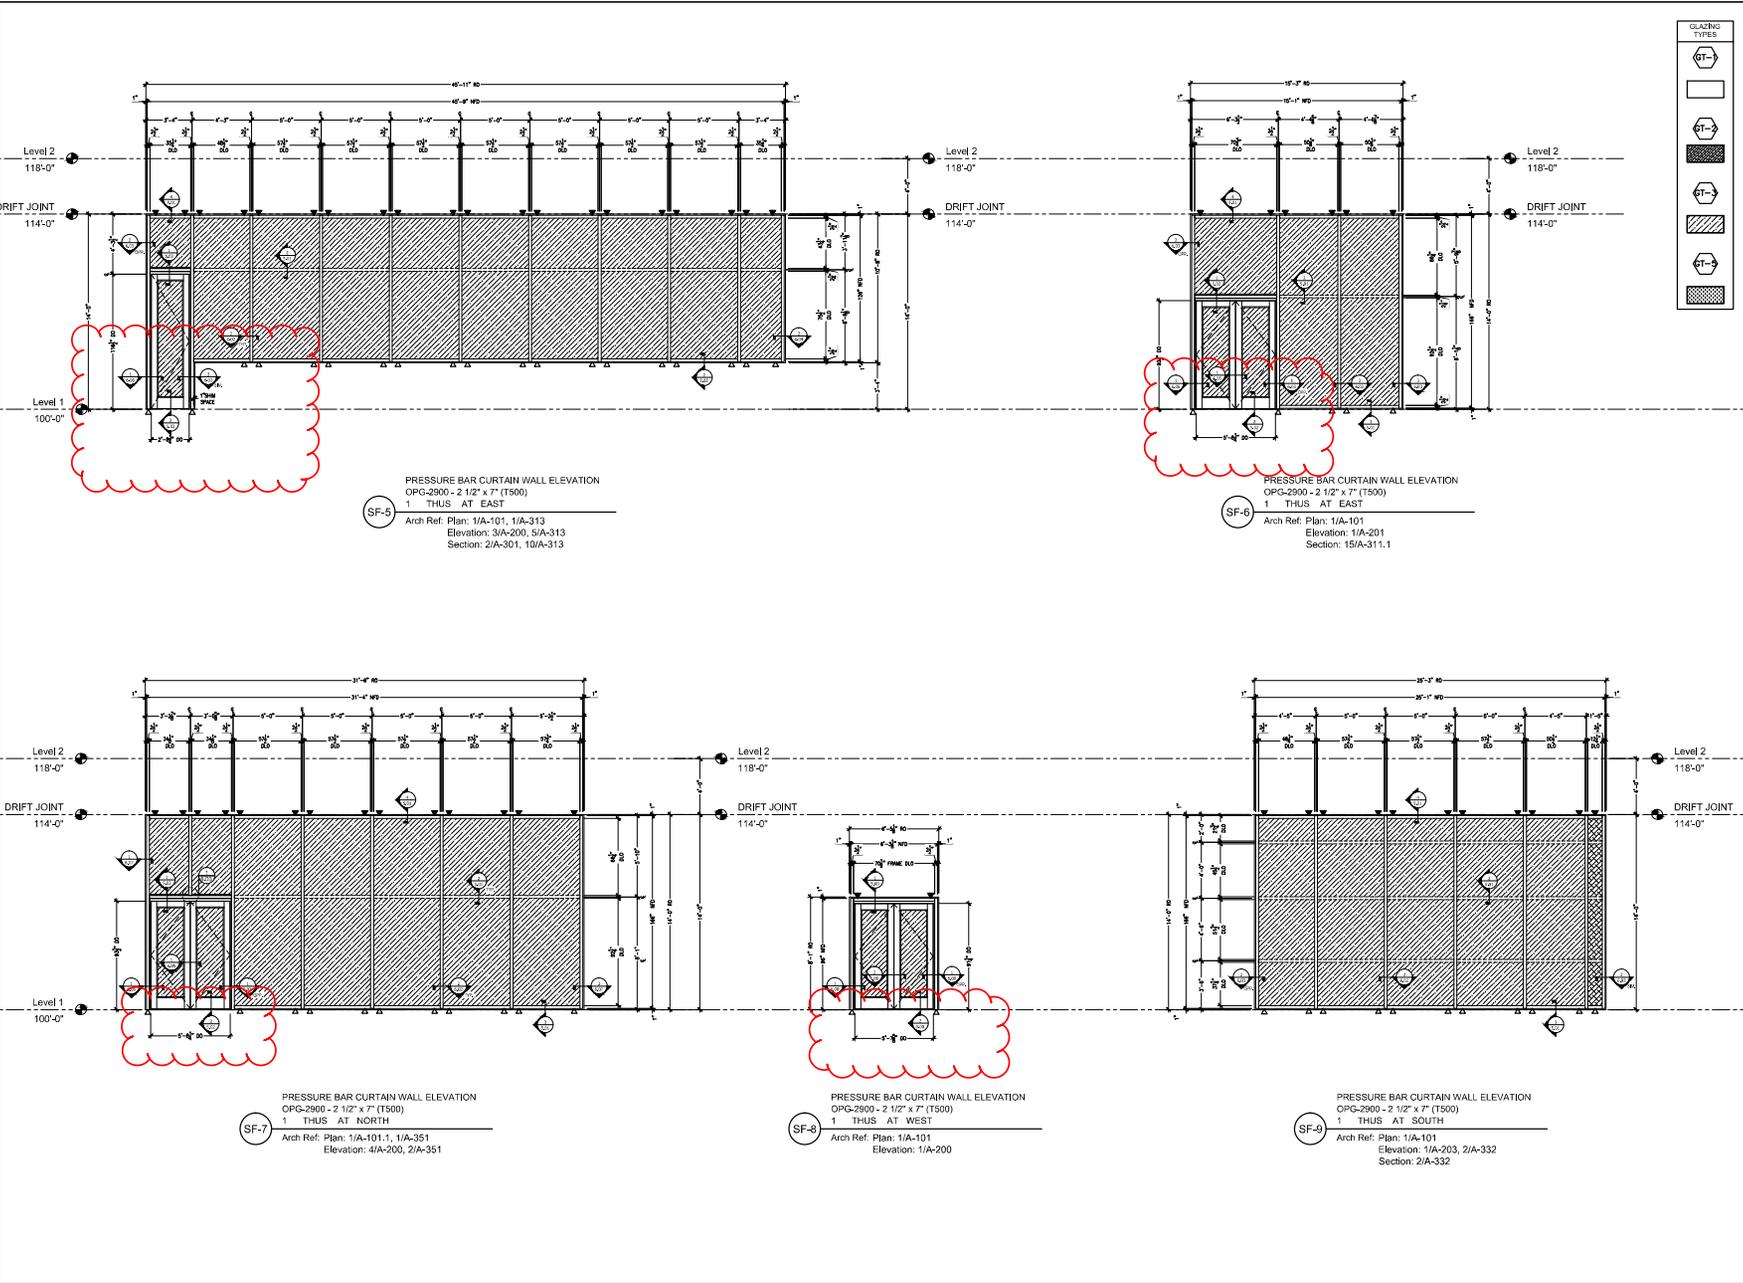

GLAZING TYPES:

GT-1	[Symbol]
GT-2	[Symbol]
GT-3	[Symbol]
GT-4	[Symbol]
GT-5	[Symbol]
GT-6	[Symbol]

arcadia
ARCADIA, INC.
 7830 159th Street
 Kent, Washington 98032
 PH: (425) 884-7300
 FX: (253) 395-4234

OWNER/CLIENT:
LAL PROPERTY, LLC
 A CALIFORNIA LIMITED LIABILITY COMPANY
 885 NORTH WASH STREET
 EL SEGUNDO, CA 90245

ARCHITECT:
ROSSETTI
 160 WEST FORT SUITE 400
 DETROIT, MI 48226

ASSOCIATE ARCHITECT:
PERKINS & WILL
 817 WEST 7TH STREET SUITE 1200
 LOS ANGELES, CA 90017

MORLEY BUILDERS
 3300 OCEAN PARK BLVD
 SANTA MONICA, CA 90405

GLAZING CONTRACTOR:
AGA
 International Glass & Business
 15281 ALTON PARKWAY
 BIRMGING, CA 92618

PROJECT:
LOS ANGELES LAKERS HEAD QUARTERS
 2275 MARIPOSA
 EL SEGUNDO, CA 90245

PROJECT # 2014-015

ENGINEER STAMP:

LEGEND:

▲	= WINDLOAD ANCHOR
△	= DEADLOAD ANCHOR

REVISIONS

NO.	DATE	DESCRIPTION
1	-	-
2		
3		
4		

DRAWN BY: [] CHECKED BY: []
 DATE: 11.13.15 SCALE: 1/8" = 1'-0"
 SHEET TITLE: **ELEVATIONS**
 SHEET NUMBER: **2.01**