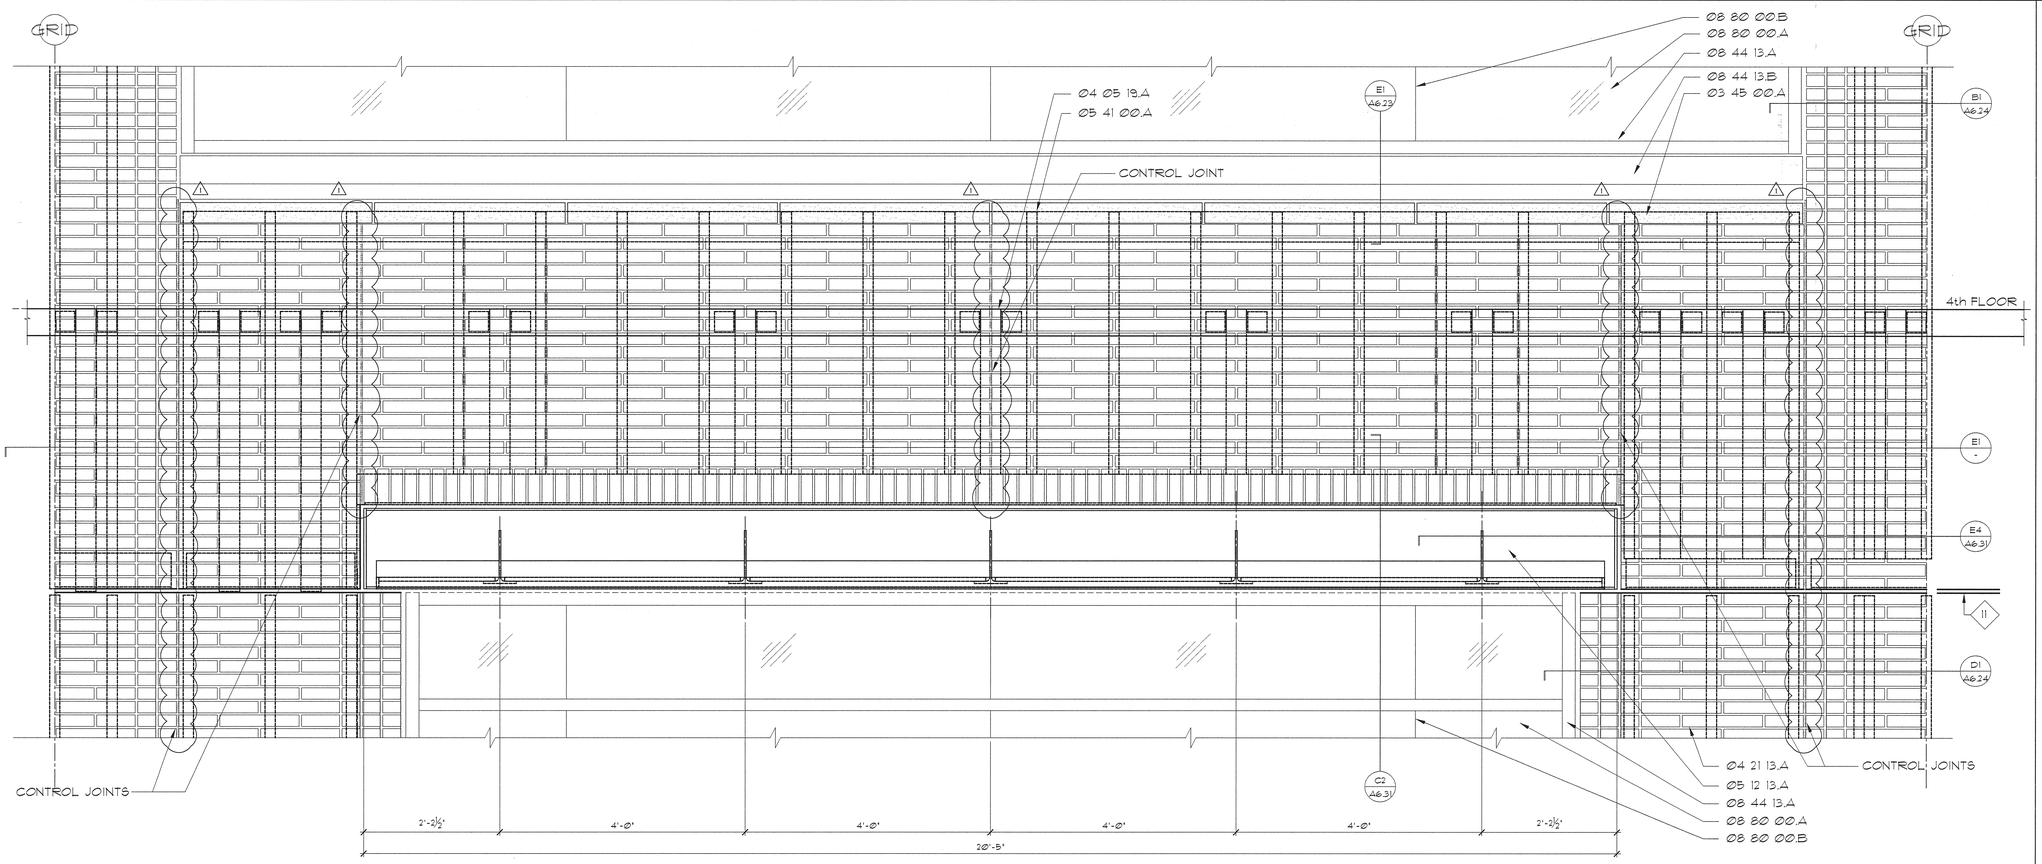

C1 CANOPY ELEVATION @ 3RD FLOOR - WEST ELEV.
1" = 1'-0"

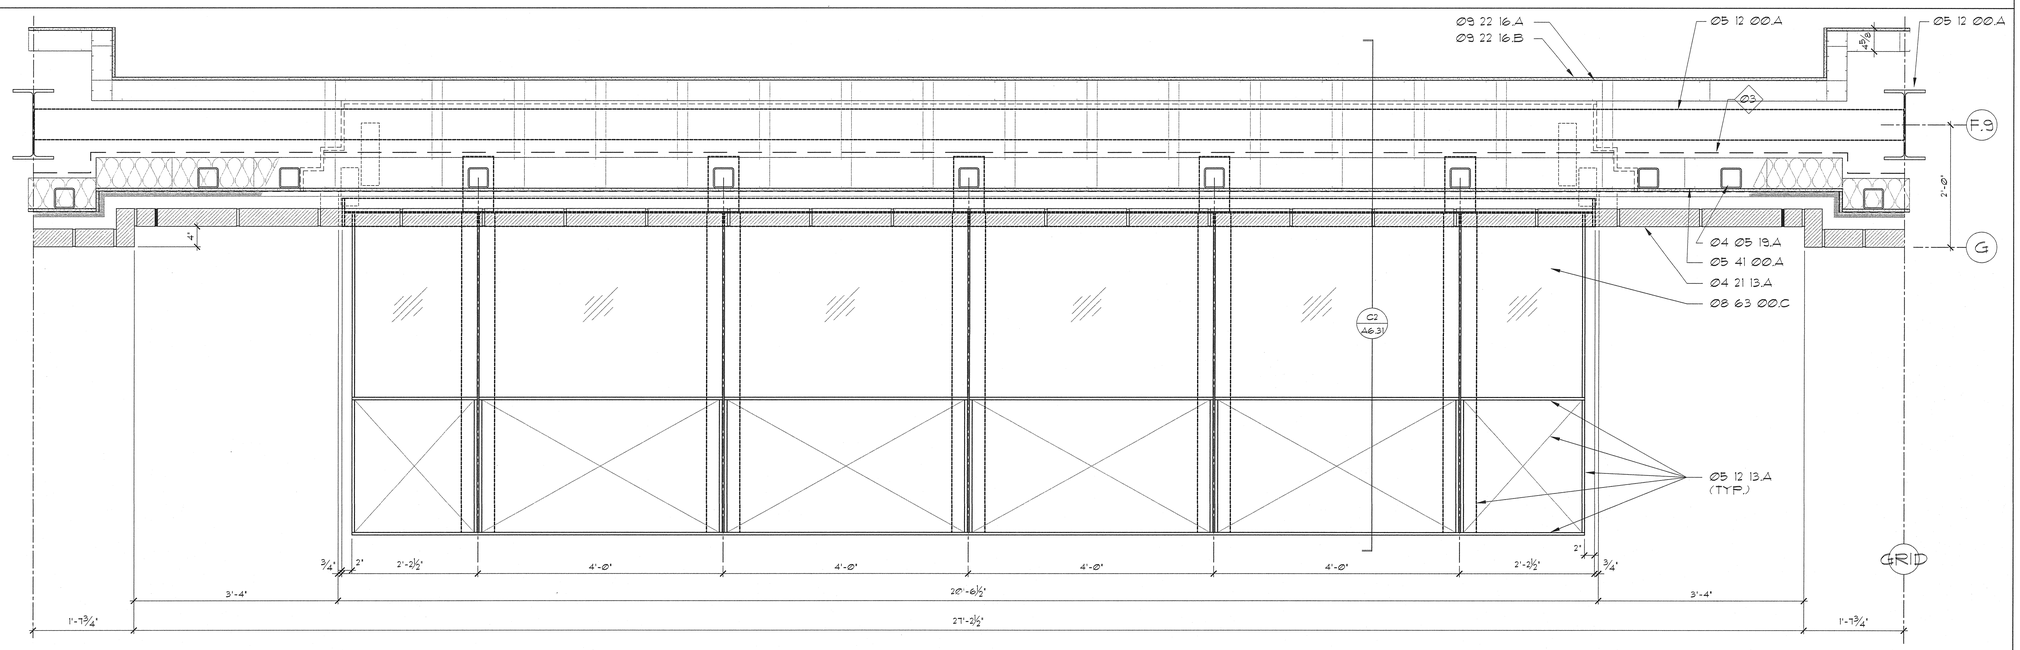

E1 CANOPY PLAN CUT THRU W SHAPE, WEST ELEVATION, 3rd FLOOR
1" = 1'-0"

MATERIAL LEGEND

Division 03 CONCRETE

03 45 00.A ARCHITECTURAL PRECAST CONCRETE

Division 04 Masonry

04 05 19.A MASONRY ANCHORAGE AND REINFORCING
04 21 13.A BRICK MASONRY

Division 05 Metals

05 12 00.A STRUCTURAL STEEL
05 12 13.A ARCHITECTURALLY EXPOSED STEEL
05 41 00.A STRUCTURAL METAL STUD FRAMING

Division 06 Wood & Plastics

Division 07 Thermal & Moisture Protection

Division 08 Doors & Windows

08 44 13.A CURTAIN WALL SYSTEM
B FORMED ALUMINUM PANELS

08 63 00.C METAL FRAME SKYLIGHTS - LAMINATED GLASS
08 80 00.A THERMAL GLAZING - SEE CURTAIN WALL / METAL PANEL ELEVATIONS FOR SPECIFIC TYPE
B STRUCTURAL SILICONE GLAZING

Division 09 FINISHES

09 22 16.A NON-STRUCTURAL METAL FRAMING
B GYPSUM WALLBOARD OVER METAL FURRING

GENERAL NOTES

- 01 JOINT ALLOWS FOR LIVE LOAD DEFLECTION
- 02 LINE OF UNDER SILL FLASHING
- 03 EDGE OF SLAB
- 04 NOT USED
- 05 BLIND POCKET
- 06 LINE OF CEILING
- 07 SEE FLOOR PLANS FOR INTERIOR PARTITION LAYOUT AND CONSTRUCTION
- 08 CANOPY STRUCTURE AND FASCIA
- 09 MASONRY CONTROL JOINT
- 10 SEAL TRANSITIONS AT SHEATHING TO MAINTAIN PROTECTION BARRIERS (SEE SHEET A6.19 FOR TYPICAL NOTES)
- 11 ISOLATION / DRIFT JOINT

GIFFIN • BOLTE • JURGENS p.c.
ARCHITECTS
815 S.W. SECOND AVENUE · PORTLAND, OREGON 97204
(503) 223-0992 www.gbjarch.com FAX (503) 294-3961

4297 REGISTERED ARCHITECT
TERRY FITZPATRICK
STATE OF WASHINGTON

MultiCare

EMERGENCY DEPARTMENT & CANCER CENTER EXPANSION

TACOMA, WASHINGTON

1 CCD #04	12-17-2008	

Date	09-26-2008
Scale	SHOWN
Drawn By	TFG
Job No.	4034

EXTERIOR WALL DETAILS

A6
30

Oct 16, 2008 - 10:00am - Cad File: W:\PROJECTS\4034 MultiCare Health System\MAIN Multicare Market\CAD\MAIN MKT DESIGN CD\REDLINES\CD\REDLINES\A6.30.dwg