


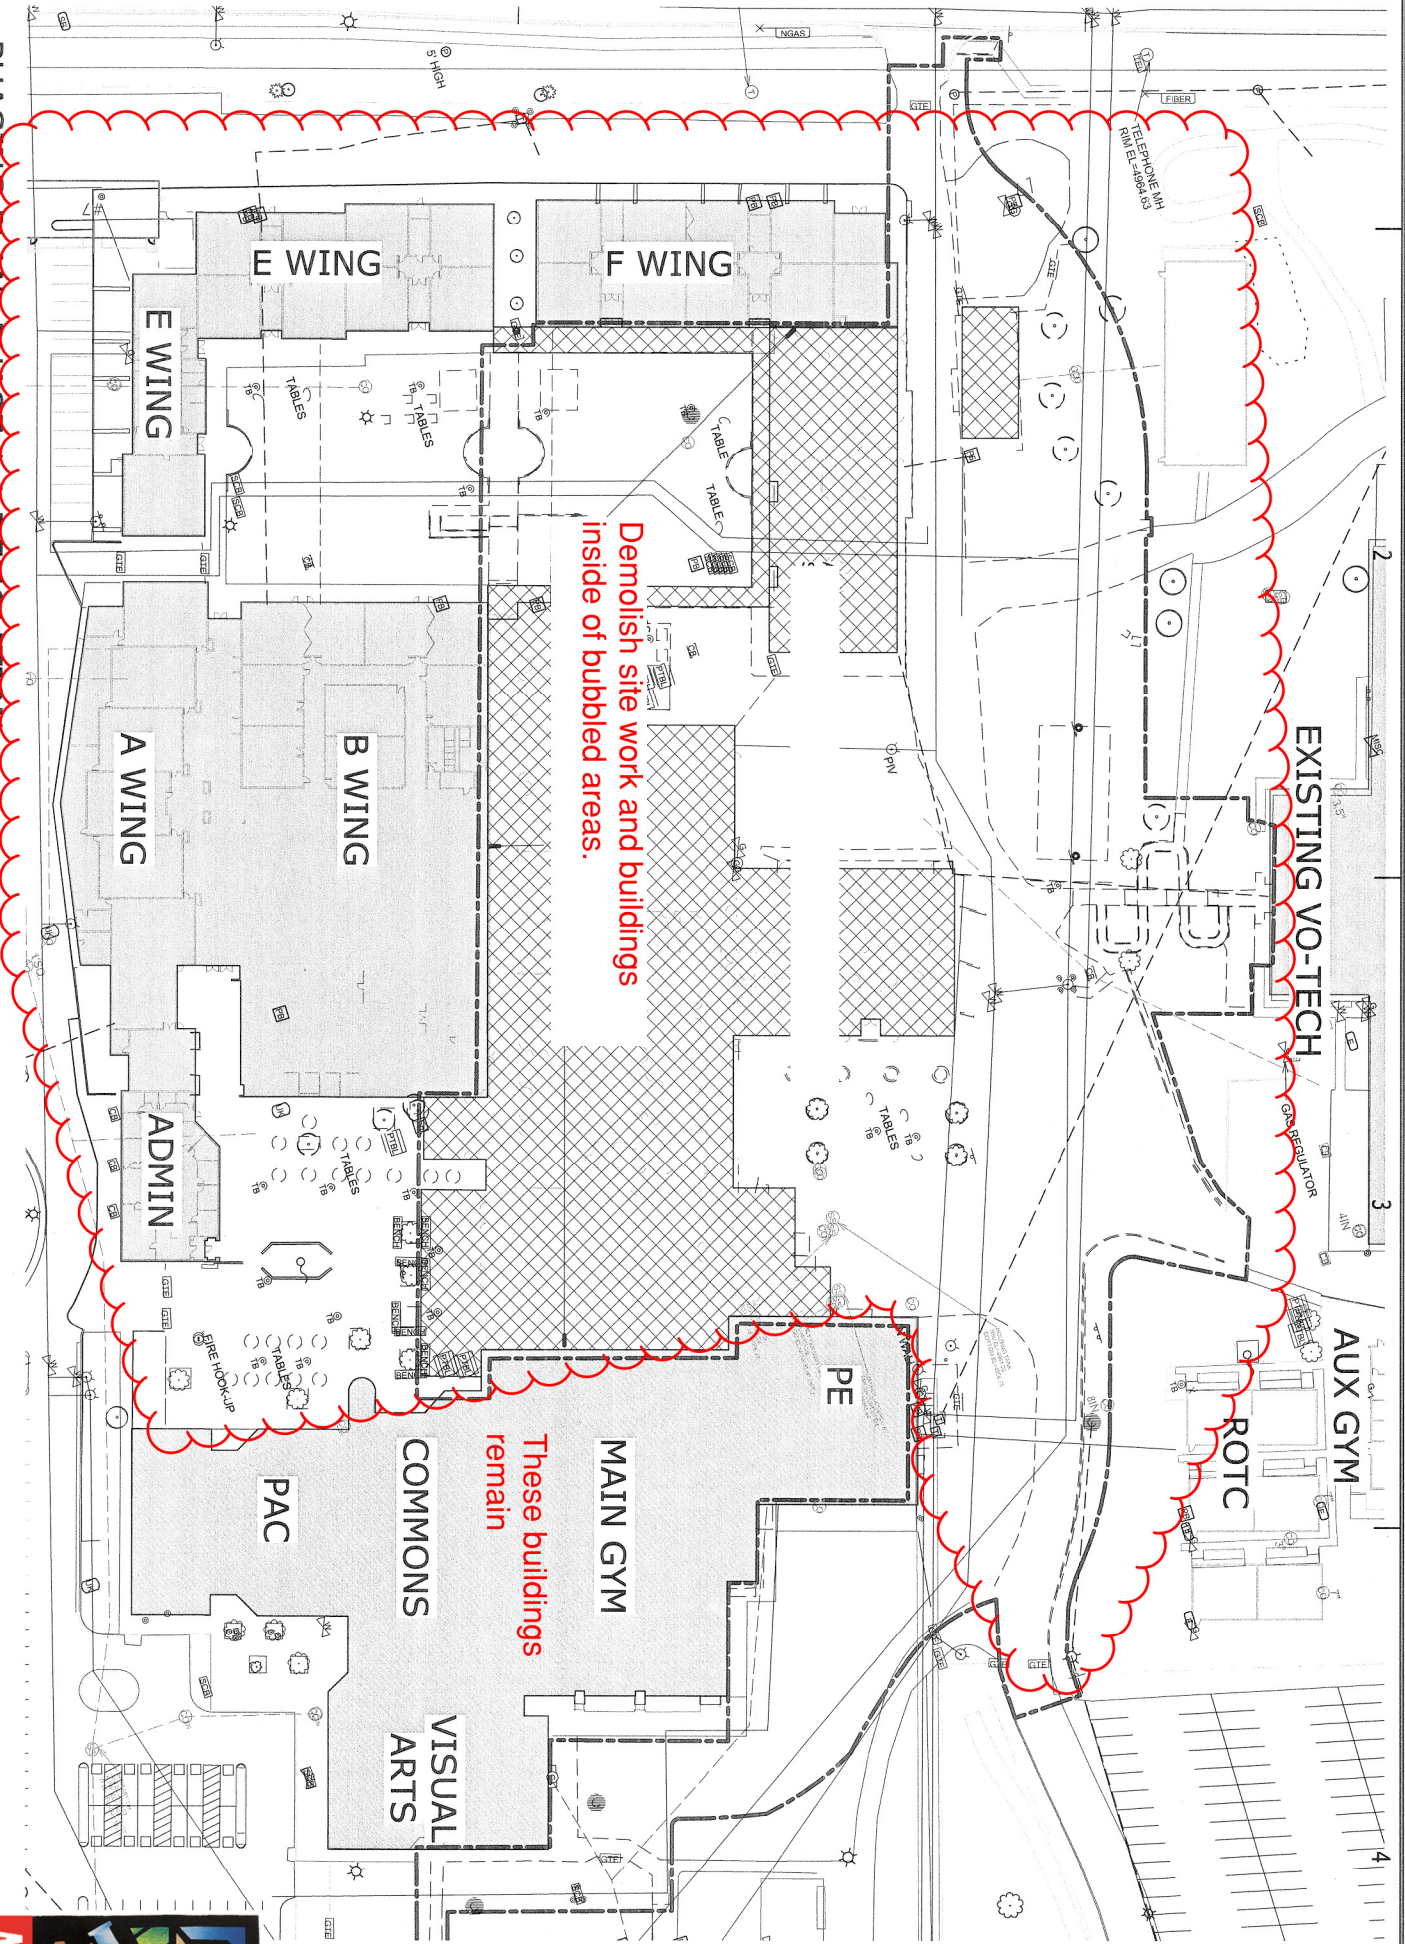

Demolish site work and buildings
inside of bubbled areas.

These buildings
remain

AS-102

