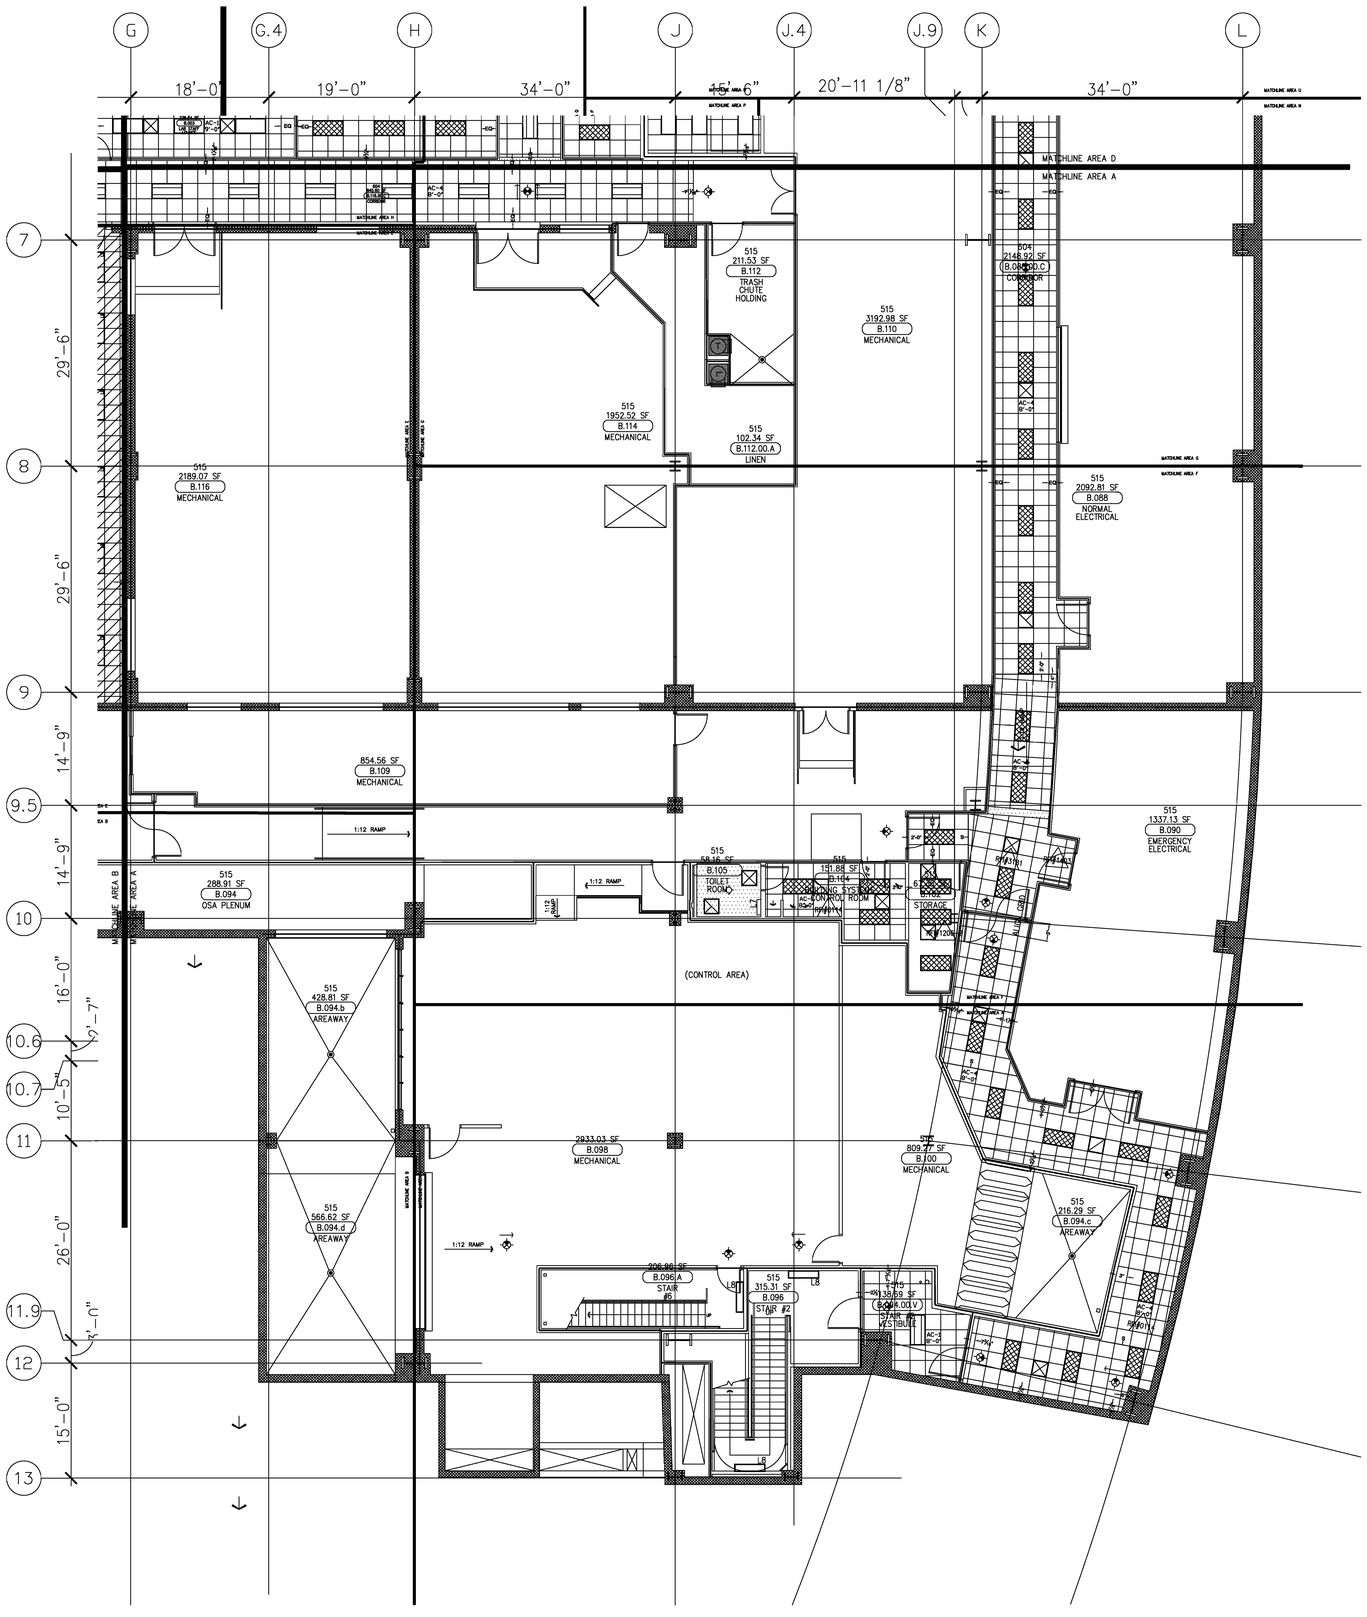

S—SLIP JOINT

AC-1 ARMSTRONG 3251 OPTIMA OPEN PLAN 2x2 CEILING TILE.
INSTALLED IN ARMSTRONG SUPRAFINE 9/16" GRID.

AC-2 ARMSTRONG 1720 CLEAN ROOM MYLAR 2x2 CEILING TILE.
INSTALLED IN ARMSTRONG CLEAN ROOM 15/16" GRID.

AC-4 ARMSTRONG 589 CIRRUS 2x2 CEILING TILE.
INSTALLED IN ARMSTRONG SUPRAFINE 9/16" GRID.

AC-5 ARMSTRONG 1935 HEALTHZONE ULTIMA 2x2 CEILING TILE.
INSTALLED IN ARMSTRONG PRELUDE 15/16" GRID.

AC-6 DECOUSTICS CLARD 4x4 CEILING TILE.
INSTALLED IN CEILENCIO TORSION SPRING GRID.

AC-7 DECOUSTICS CLARD CEILING TILE (CUSTOM SIZE).
INSTALLED IN CEILENCIO TORSION SPRING GRID.

AC-8 ARMSTRONG 3152 OPTIMA OPEN PLAN 2x2 CEILING TILE.
INSTALLED IN ARMSTRONG PRELUDE 15/16" GRID.

AC-9 ARMSTRONG 869 CLEAN ROOM VL PERFORATED 2x2 CEILING TILE.
INSTALLED IN ARMSTRONG PRELUDE 15/16" GRID.

Issue Date:

Revisions		
No.	Date	Description
	08-05-10	FOR SUBMITTAL
1	02-22-11	ADDED DIMENSIONS FOR GRID LOCATIONS
		APPLIED NEW ARCH. BACKGROUND
2	06-09-11	REVISED FINISH SCHEDULE
3	07-16-12	ADDED SLIP JOINT LOCATIONS FOR RECORD

Architect's Approval

Contractor's Approval

Key Plan

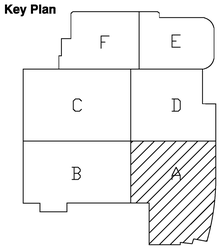

CHILDREN'S HOSPITAL OF ORANGE COUNTY TOWER II PROJECT

455 S. MAIN St. ORANGE, CA 92868

MARTIN INTEGRATED
2330 N. Pacific Street, Orange, CA. 92865
Phone 714.998.9100 Fax 714.998.1414
Lic. # 566629
www.martinintegrated.com

Project Number: **MIS#7874/MCCARTHY#7453**

Sheet Title: **LOWER LEVEL/AREA A REFLECTIVE CEILING PLAN**

Scale: **1/8" = 1' 0"**

Reference Sheet Number: **INCREMENT #7 A4.0A**

Building:

Sheet Number: **MIS-4.0A**

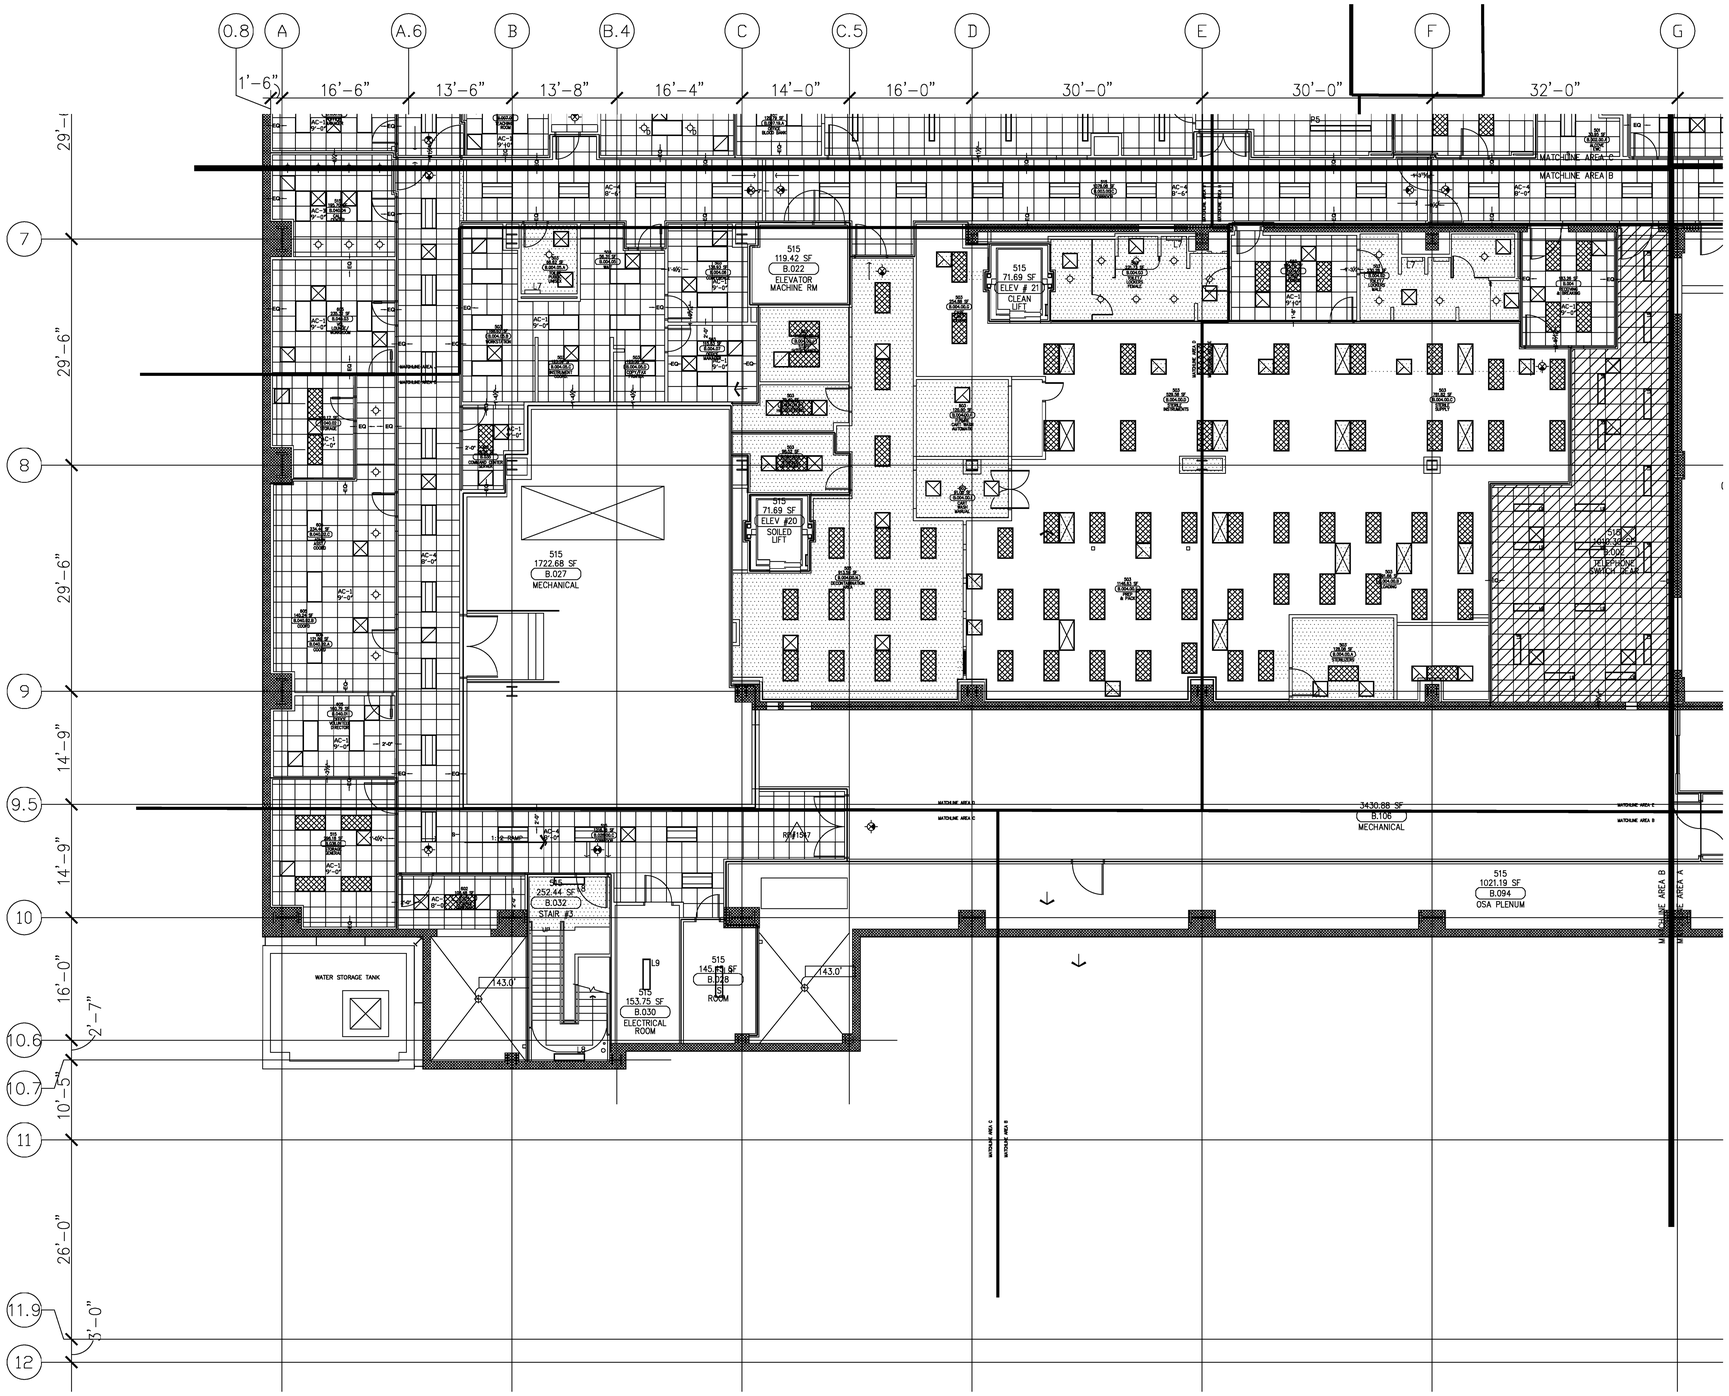

S–SLIP JOINT

AC-1 ARMSTRONG 3251 OPTIMA OPEN PLAN 2x2 CEILING TILE.
INSTALLED IN ARMSTRONG SUPRAFINE 9/16" GRID.

AC-2 ARMSTRONG 1720 CLEAN ROOM MYLAR 2x2 CEILING TILE.
INSTALLED IN ARMSTRONG CLEAN ROOM 15/16" GRID.

AC-4 ARMSTRONG 589 CIRRUS 2x2 CEILING TILE.
INSTALLED IN ARMSTRONG SUPRAFINE 9/16" GRID.

AC-5 ARMSTRONG 1935 HEALTHZONE ULTIMA 2x2 CEILING TILE.
INSTALLED IN ARMSTRONG PRELUDE 15/16" GRID.

AC-6 DECOUSTICS CLARO 4x4 CEILING TILE.
INSTALLED IN CEILENCIO TORSION SPRING GRID.

AC-7 DECOUSTICS CLARO CEILING TILE (CUSTOM SIZE).
INSTALLED IN CEILENCIO TORSION SPRING GRID.

AC-8 ARMSTRONG 3152 OPTIMA OPEN PLAN 2x2 CEILING TILE.
INSTALLED IN ARMSTRONG PRELUDE 15/16" GRID.

AC-9 ARMSTRONG 869 CLEAN ROOM VL PERFORATED 2x2 CEILING TILE.
INSTALLED IN ARMSTRONG PRELUDE 15/16" GRID.

Issue Date:		
Revisions		
No.	Date	Description
	08-05-10	FOR SUBMITTAL
1	02-22-11	ADDED DIMENSIONS FOR GRID LOCATIONS
		APPLIED NEW ARCH. BACKGROUND
2	06-09-11	REVISED FINISH SCHEDULE
3	07-16-12	ADDED SLIP JOINT LOCATIONS FOR RECORD

Architect's Approval

Contractor's Approval

Key Plan

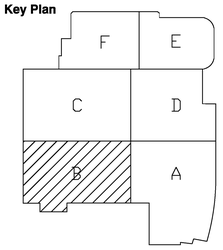

CHILDREN'S HOSPITAL OF ORANGE COUNTY TOWER II PROJECT

455 S. MAIN St. ORANGE, CA 92868

MARTIN INTEGRATED
2330 N. Pacific Street, Orange, CA. 92865
Phone 714.998.9100 Fax 714.998.1414
Lic. # 566629
www.martinintegrated.com

Project Number: MIS#7874/MCCARTHY#7453

Sheet Title:

LOWER LEVEL/AREA B REFLECTIVE CEILING PLAN

Scale: 1/8" = 1' 0"

Reference Sheet Number: INCREMENT #7 A4.0B

Building:

Sheet Number: MIS-4.0B

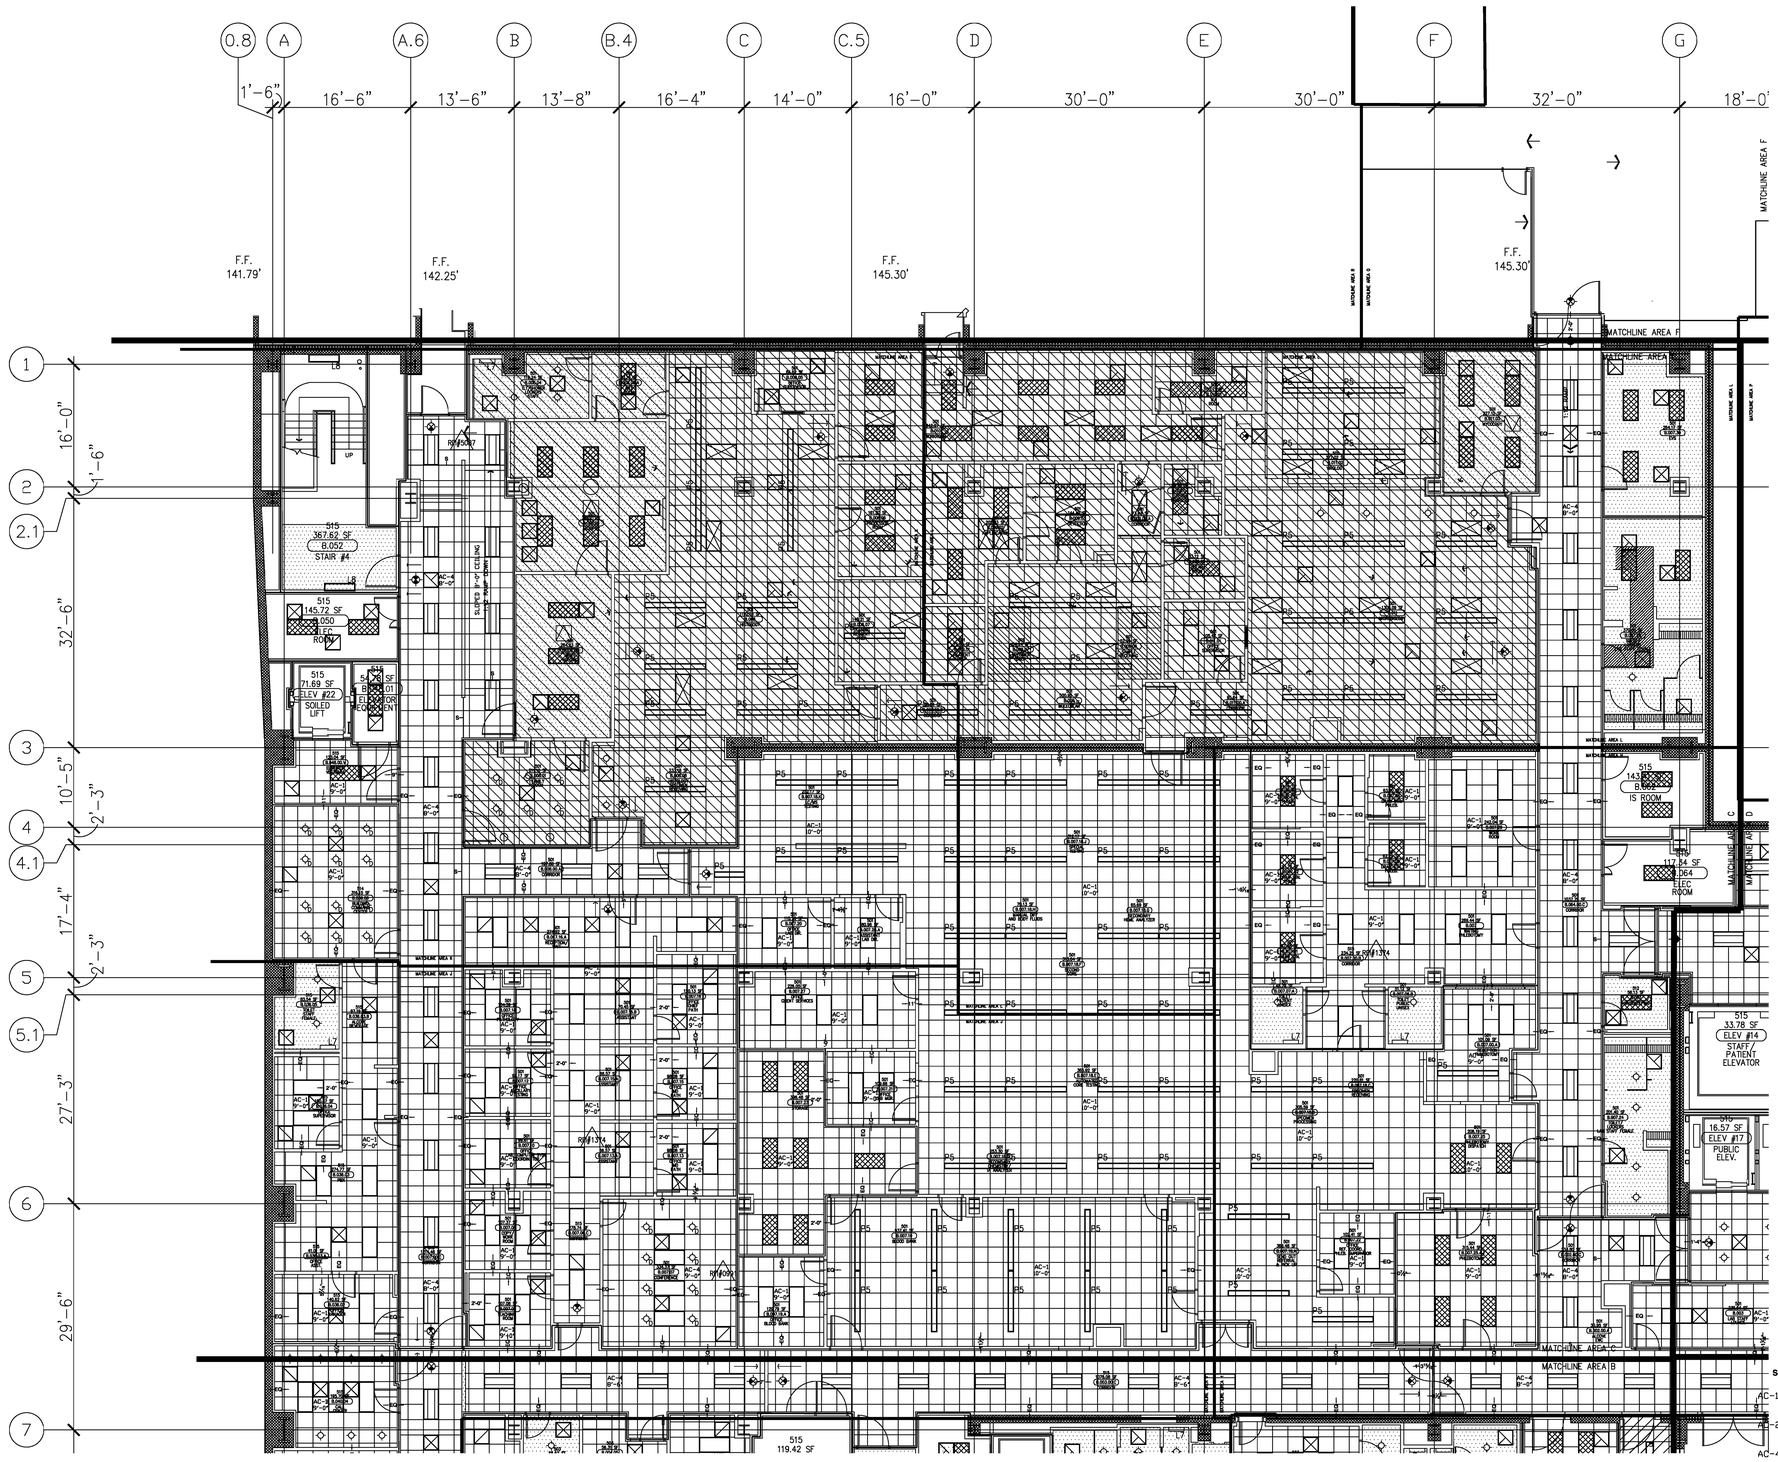

S—SLIP JOINT

AC-1 ARMSTRONG 3251 OPTIMA OPEN PLAN 2x2 CEILING TILE.
INSTALLED IN ARMSTRONG SUPRAFINE 15/16" GRID.

AC-2 ARMSTRONG 1720 CLEAN ROOM MYLAR 2x2 CEILING TILE.
INSTALLED IN ARMSTRONG CLEAN ROOM 15/16" GRID.

AC-4 ARMSTRONG 589 CIRRUS 2x2 CEILING TILE.
INSTALLED IN ARMSTRONG SUPRAFINE 15/16" GRID.

AC-5 ARMSTRONG 1935 HEALTHZONE ULTIMA 2x2 CEILING TILE.
INSTALLED IN ARMSTRONG PRELUDE 15/16" GRID.

AC-6 DECOUSTICS CLARO 4x4 CEILING TILE.
INSTALLED IN CEILENCIO TORSION SPRING GRID.

AC-7 DECOUSTICS CLARO CEILING TILE (CUSTOM SIZE).
INSTALLED IN CEILENCIO TORSION SPRING GRID.

AC-8 ARMSTRONG 3152 OPTIMA OPEN PLAN 2x2 CEILING TILE.
INSTALLED IN ARMSTRONG PRELUDE 15/16" GRID.

AC-9 ARMSTRONG 869 CLEAN ROOM VL PERFORATED 2x2 CEILING TILE.
INSTALLED IN ARMSTRONG PRELUDE 15/16" GRID.

Issue Date:		
Revisions		
No.	Date	Description
	08-05-10	FOR SUBMITTAL
1	02-22-11	ADDED DIMENSIONS FOR GRID LOCATIONS
		APPLIED NEW ARCH. BACKGROUND
2	06-09-11	REVISED FINISH SCHEDULE
3	07-16-12	ADDED SLIP JOINT LOCATIONS FOR RECORD

Architect's Approval

Contractor's Approval

Key Plan

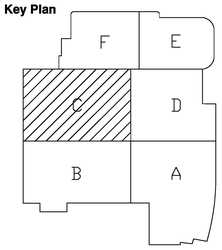

CHILDREN'S HOSPITAL OF ORANGE COUNTY TOWER II PROJECT

455 S. MAIN St. ORANGE, CA 92868

MARTIN INTEGRATED
2330 N. Pacific Street, Orange, CA. 92865
Phone 714.998.9100 Fax 714.998.1414
Lic. # 566629
www.martinintegrated.com

Project Number: MIS#7874/MCCARTHY#7453

Sheet Title: LOWER LEVEL/AREA C REFLECTIVE CEILING PLAN

Scale: 1/8" = 1' 0"

Reference Sheet Number: INCREMENT #7 A4.0C

Building:

Sheet Number: MIS-4.0C

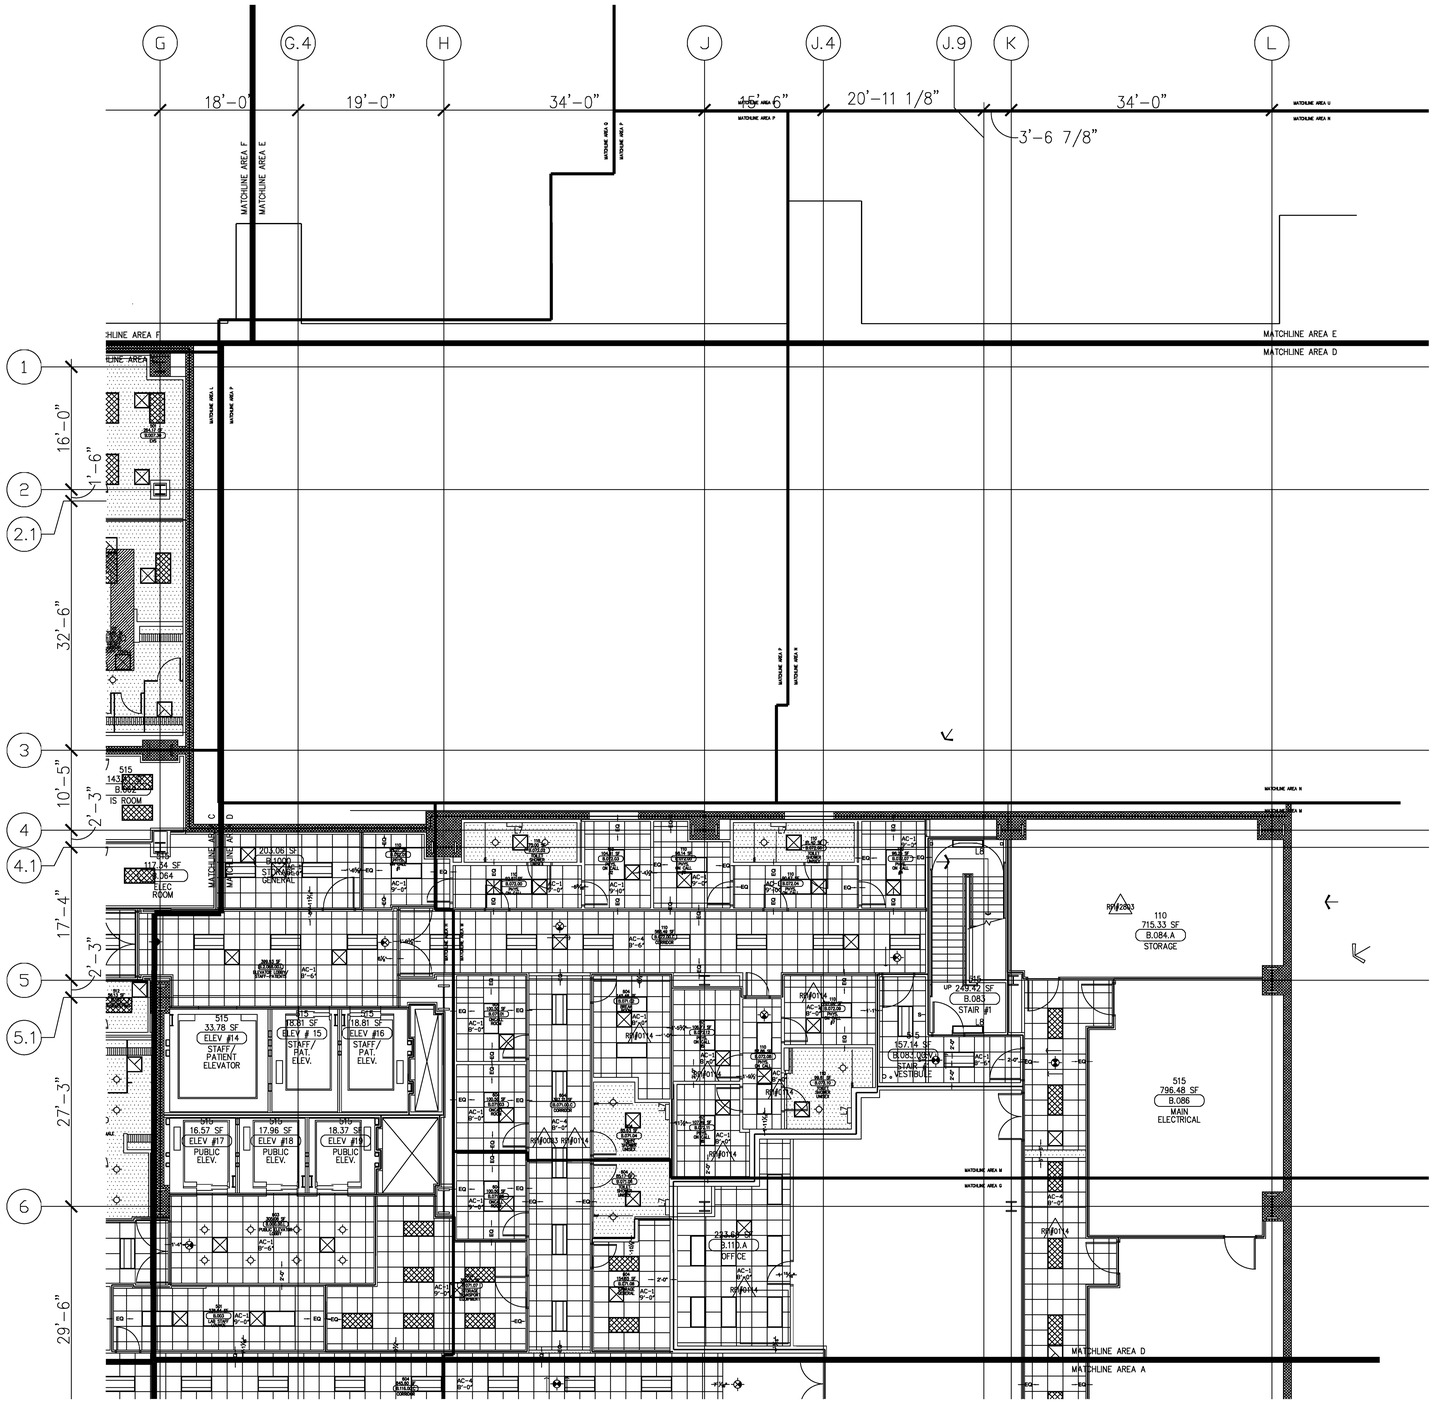

S—SLIP JOINT

AC-1 ARMSTRONG 3251 OPTIMA OPEN PLAN 2x2 CEILING TILE. INSTALLED IN ARMSTRONG SUPRAFINE 9/16" GRID.

AC-2 ARMSTRONG 1720 CLEAN ROOM MYLAR 2x2 CEILING TILE. INSTALLED IN ARMSTRONG CLEAN ROOM 15/16" GRID.

AC-4 ARMSTRONG 589 CIRRUS 2x2 CEILING TILE. INSTALLED IN ARMSTRONG SUPRAFINE 9/16" GRID.

AC-5 ARMSTRONG 1935 HEALTHZONE ULTIMA 2x2 CEILING TILE. INSTALLED IN ARMSTRONG PRELUDE 15/16" GRID.

AC-6 DECOUSTICS CLARO 4x4 CEILING TILE. INSTALLED IN CEILENCIO TORSION SPRING GRID.

AC-7 DECOUSTICS CLARO CEILING TILE (CUSTOM SIZE). INSTALLED IN CEILENCIO TORSION SPRING GRID.

AC-8 ARMSTRONG 3152 OPTIMA OPEN PLAN 2x2 CEILING TILE. INSTALLED IN ARMSTRONG PRELUDE 15/16" GRID.

AC-9 ARMSTRONG 869 CLEAN ROOM VL PERFORATED 2x2 CEILING TILE. INSTALLED IN ARMSTRONG PRELUDE 15/16" GRID.

Issue Date:

Revisions		
No.	Date	Description
	08-05-10	FOR SUBMITTAL
1	02-22-11	ADDED DIMENSIONS FOR GRID LOCATIONS
		APPLIED NEW ARCH. BACKGROUND
2	06-09-11	REVISED FINISH SCHEDULE
3	07-16-12	ADDED SLIP JOINT LOCATIONS FOR RECORD

Architect's Approval

Contractor's Approval

Key Plan

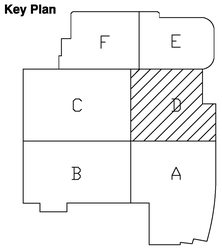

CHILDREN'S HOSPITAL OF ORANGE COUNTY TOWER II PROJECT

455 S. MAIN St. ORANGE, CA 92868

MARTIN INTEGRATED
2330 N. Pacific Street, Orange, CA. 92865
Phone 714.998.9100 Fax 714.998.1414
Lic. # 566629
www.martinintegrated.com

Project Number: MIS#7874/MCCARTHY#7453

Sheet Title:

LOWER LEVEL/AREA D REFLECTIVE CEILING PLAN

Scale: 1/8" = 1' 0"

Reference Sheet Number: INCREMENT #7 A4.0D

Building:

Sheet Number: MIS-4.0D

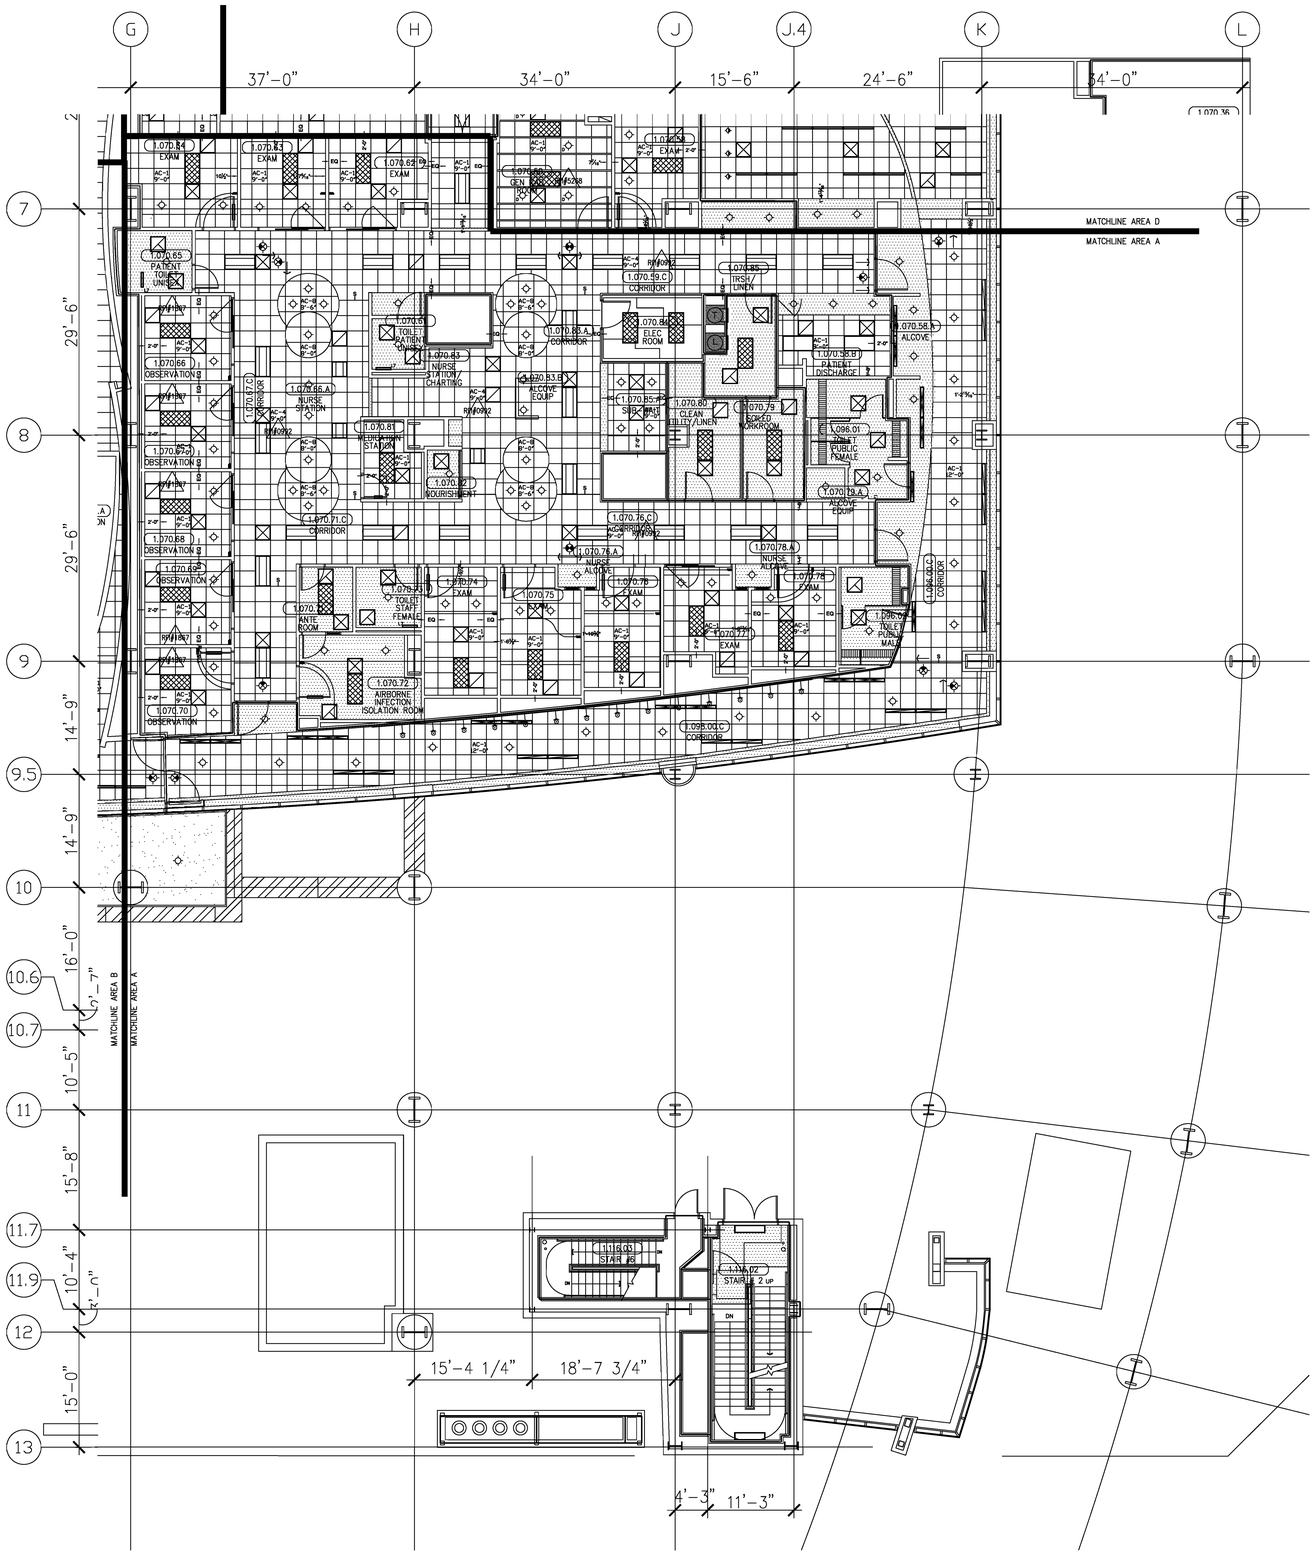

S-SLIP JOINT

AC-1 ARMSTRONG 3251 OPTIMA OPEN PLAN 2x2 CEILING TILE.
INSTALLED IN ARMSTRONG SUPRAFINE 9/16" GRID.

AC-2 ARMSTRONG 1720 CLEAN ROOM MYLAR 2x2 CEILING TILE.
INSTALLED IN ARMSTRONG CLEAN ROOM 15/16" GRID.

AC-4 ARMSTRONG 589 CIRRUS 2x2 CEILING TILE.
INSTALLED IN ARMSTRONG SUPRAFINE 9/16" GRID.

AC-5 ARMSTRONG 1935 HEALTHZONE ULTIMA 2x2 CEILING TILE.
INSTALLED IN ARMSTRONG PRELUDE 15/16" GRID.

AC-6 DECOUSTICS CLARO 4x4 CEILING TILE.
INSTALLED IN CEILENCIO TORSION SPRING GRID.

AC-7 DECOUSTICS CLARO CEILING TILE (CUSTOM SIZE).
INSTALLED IN CEILENCIO TORSION SPRING GRID.

AC-8 ARMSTRONG 3152 OPTIMA OPEN PLAN 2x2 CEILING TILE.
INSTALLED IN ARMSTRONG PRELUDE 15/16" GRID.

AC-9 ARMSTRONG 869 CLEAN ROOM VL PERFORATED 2x2 CEILING TILE.
INSTALLED IN ARMSTRONG PRELUDE 15/16" GRID.

Issue Date:

Revisions		
No.	Date	Description
	08-05-10	FOR SUBMITTAL
1	02-22-11	ADDED DIMENSIONS FOR GRID LOCATIONS
		APPLIED NEW ARCH. BACKGROUND
2	06-29-11	REVISED FINISH SCHEDULE
3	07-16-12	ADDED SLIP JOINT LOCATIONS FOR RECORD

Architect's Approval

Contractor's Approval

Key Plan

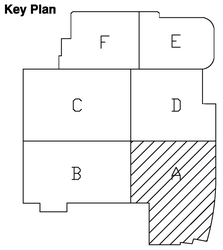

CHILDREN'S HOSPITAL OF ORANGE COUNTY TOWER II PROJECT

455 S. MAIN St. ORANGE, CA 92868

MARTIN INTEGRATED
2330 N. Pacific Street, Orange, CA. 92865
Phone 714.998.9100 Fax 714.998.1414
Lic. # 566629
www.martinintegrated.com

Project Number: MIS#7874/MCCARTHY#7453

Sheet Title: LEVEL 1/AREA A REFLECTIVE CEILING PLAN

Scale: 1/8" = 1' 0"

Reference Sheet Number: INCREMENT #7 A4.1A

Building:

Sheet Number: MIS-4.1A

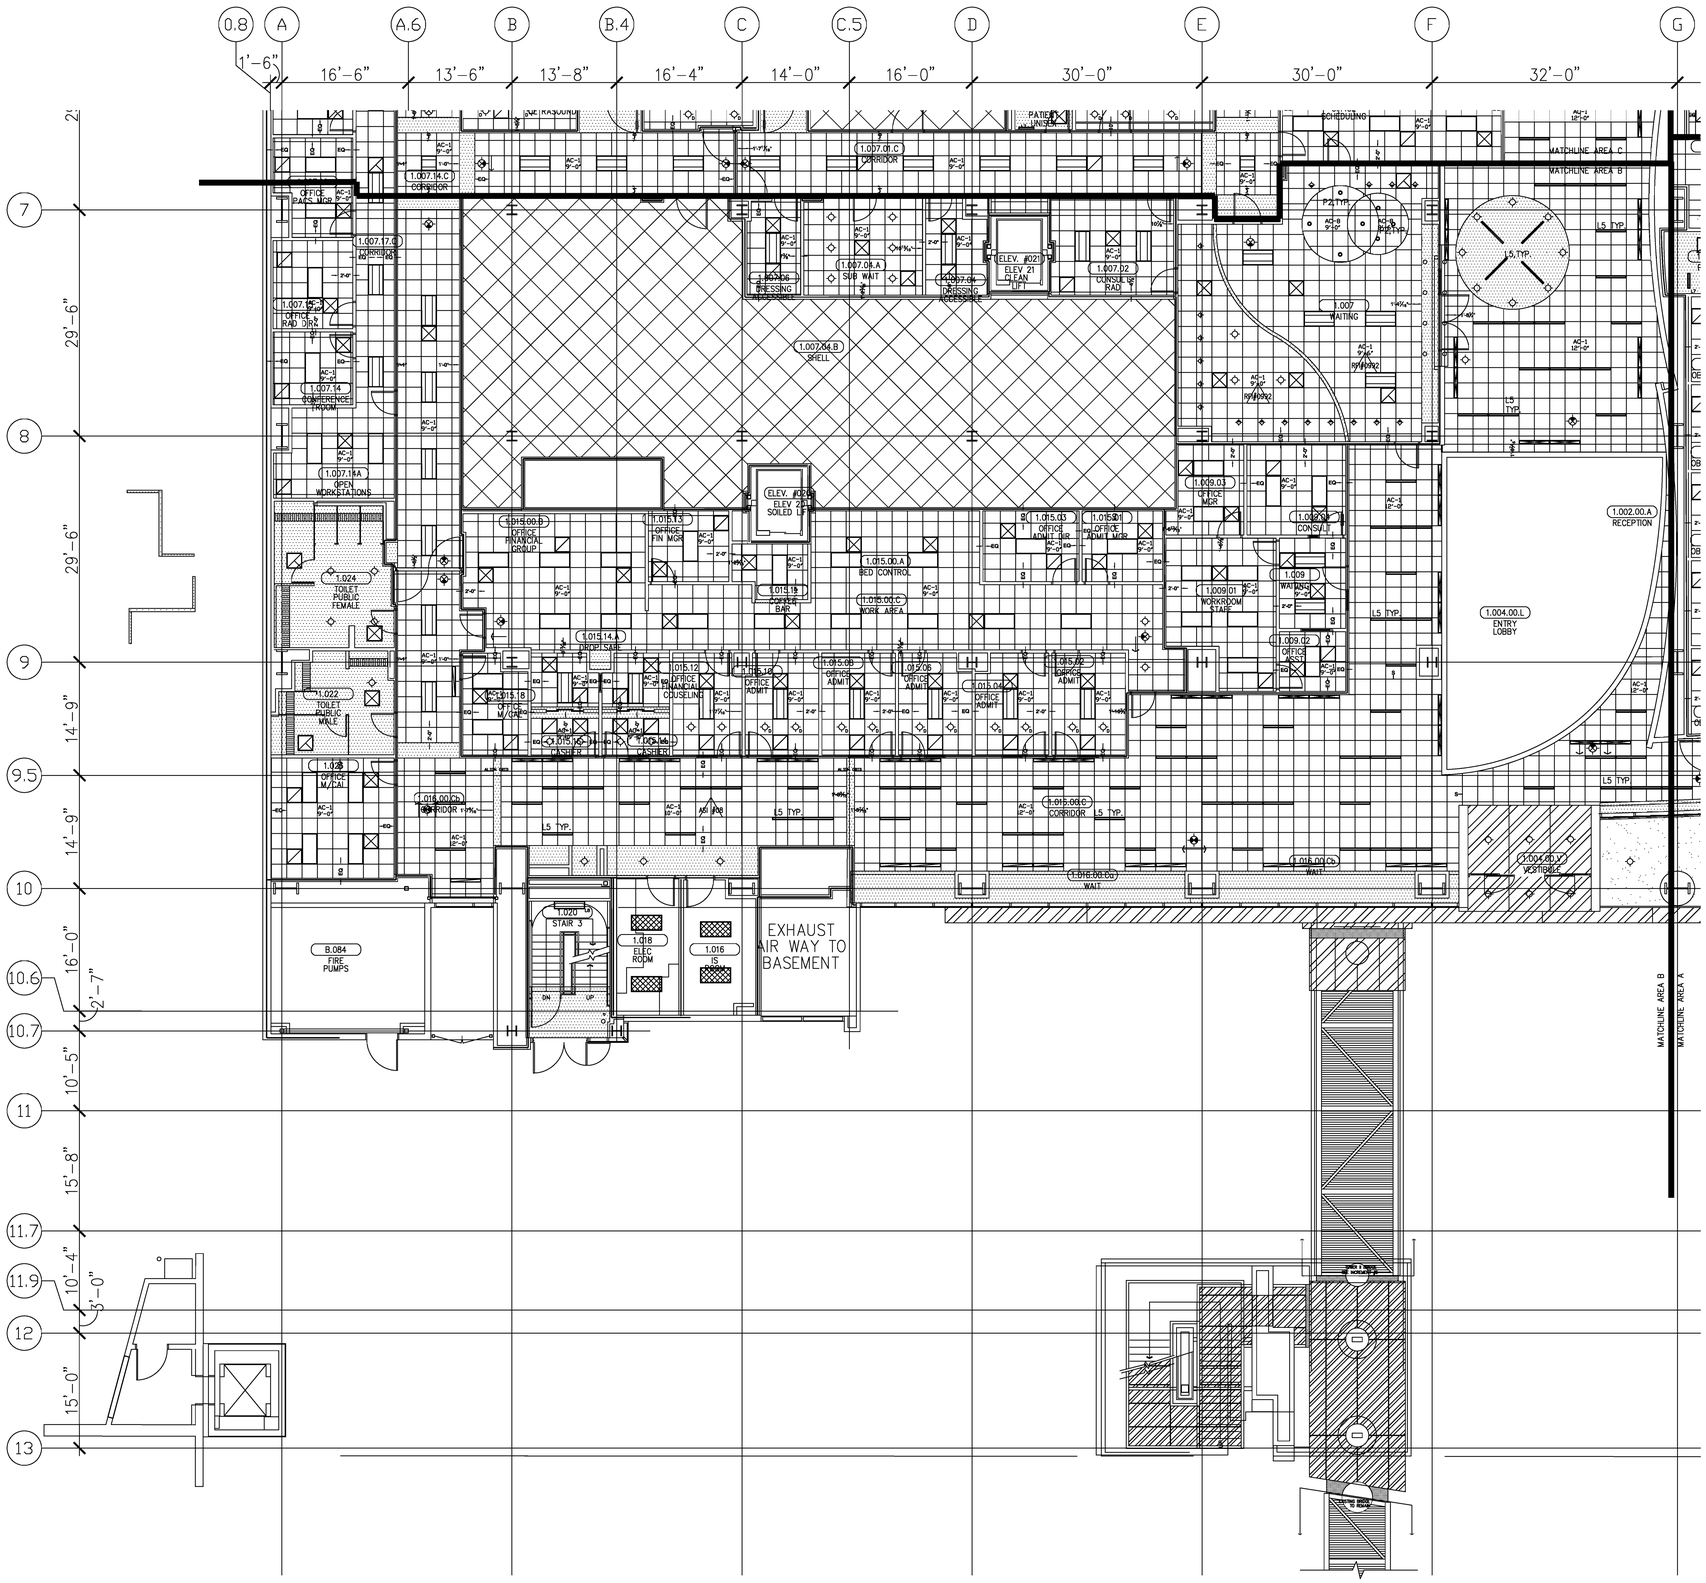

S—SLIP JOINT

AC-1 ARMSTRONG 3251 OPTIMA OPEN PLAN 2x2 CEILING TILE.
INSTALLED IN ARMSTRONG SUPRAFINE 9/16" GRID.

AC-2 ARMSTRONG 1720 CLEAN ROOM MYLAR 2x2 CEILING TILE.
INSTALLED IN ARMSTRONG CLEAN ROOM 15/16" GRID.

AC-4 ARMSTRONG 589 CIRRUS 2x2 CEILING TILE.
INSTALLED IN ARMSTRONG SUPRAFINE 9/16" GRID.

AC-5 ARMSTRONG 1935 HEALTHZONE ULTIMA 2x2 CEILING TILE.
INSTALLED IN ARMSTRONG PRELUDE 15/16" GRID.

AC-6 DECOUSTICS CLARO 4x4 CEILING TILE.
INSTALLED IN CEILENCIO TORSION SPRING GRID.

AC-7 DECOUSTICS CLARO CEILING TILE (CUSTOM SIZE).
INSTALLED IN CEILENCIO TORSION SPRING GRID.

AC-8 ARMSTRONG 3152 OPTIMA OPEN PLAN 2x2 CEILING TILE.
INSTALLED IN ARMSTRONG PRELUDE 15/16" GRID.

AC-9 ARMSTRONG 869 CLEAN ROOM VL PERFORATED 2x2 CEILING TILE.
INSTALLED IN ARMSTRONG PRELUDE 15/16" GRID.

Issue Date:

Revisions		
No.	Date	Description
	08-05-10	FOR SUBMITTAL
1	02-22-11	ADDED DIMENSIONS FOR GRID LOCATIONS
		APPLIED NEW ARCH. BACKGROUND
2	06-29-11	REVISED FINISH SCHEDULE
3	07-16-12	ADDED SLIP JOINT LOCATIONS FOR RECORD

Architect's Approval

Contractor's Approval

Key Plan

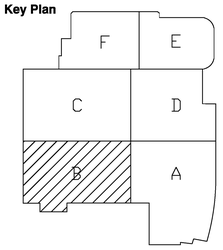

CHILDREN'S HOSPITAL OF ORANGE COUNTY TOWER II PROJECT

455 S. MAIN St. ORANGE, CA 92868

MARTIN INTEGRATED
2330 N. Pacific Street, Orange, CA. 92865
Phone 714.998.9100 Fax 714.998.1414
Lic. # 566629
www.martinintegrated.com

Project Number: **MIS#7874/MCCARTHY#7453**

Sheet Title:

LEVEL 1/AREA B REFLECTIVE CEILING PLAN

Scale: **1/8" = 1' 0"**

Reference Sheet Number: **INCREMENT #7 A4.1B**

Building:

Sheet Number: **MIS-4.1B**

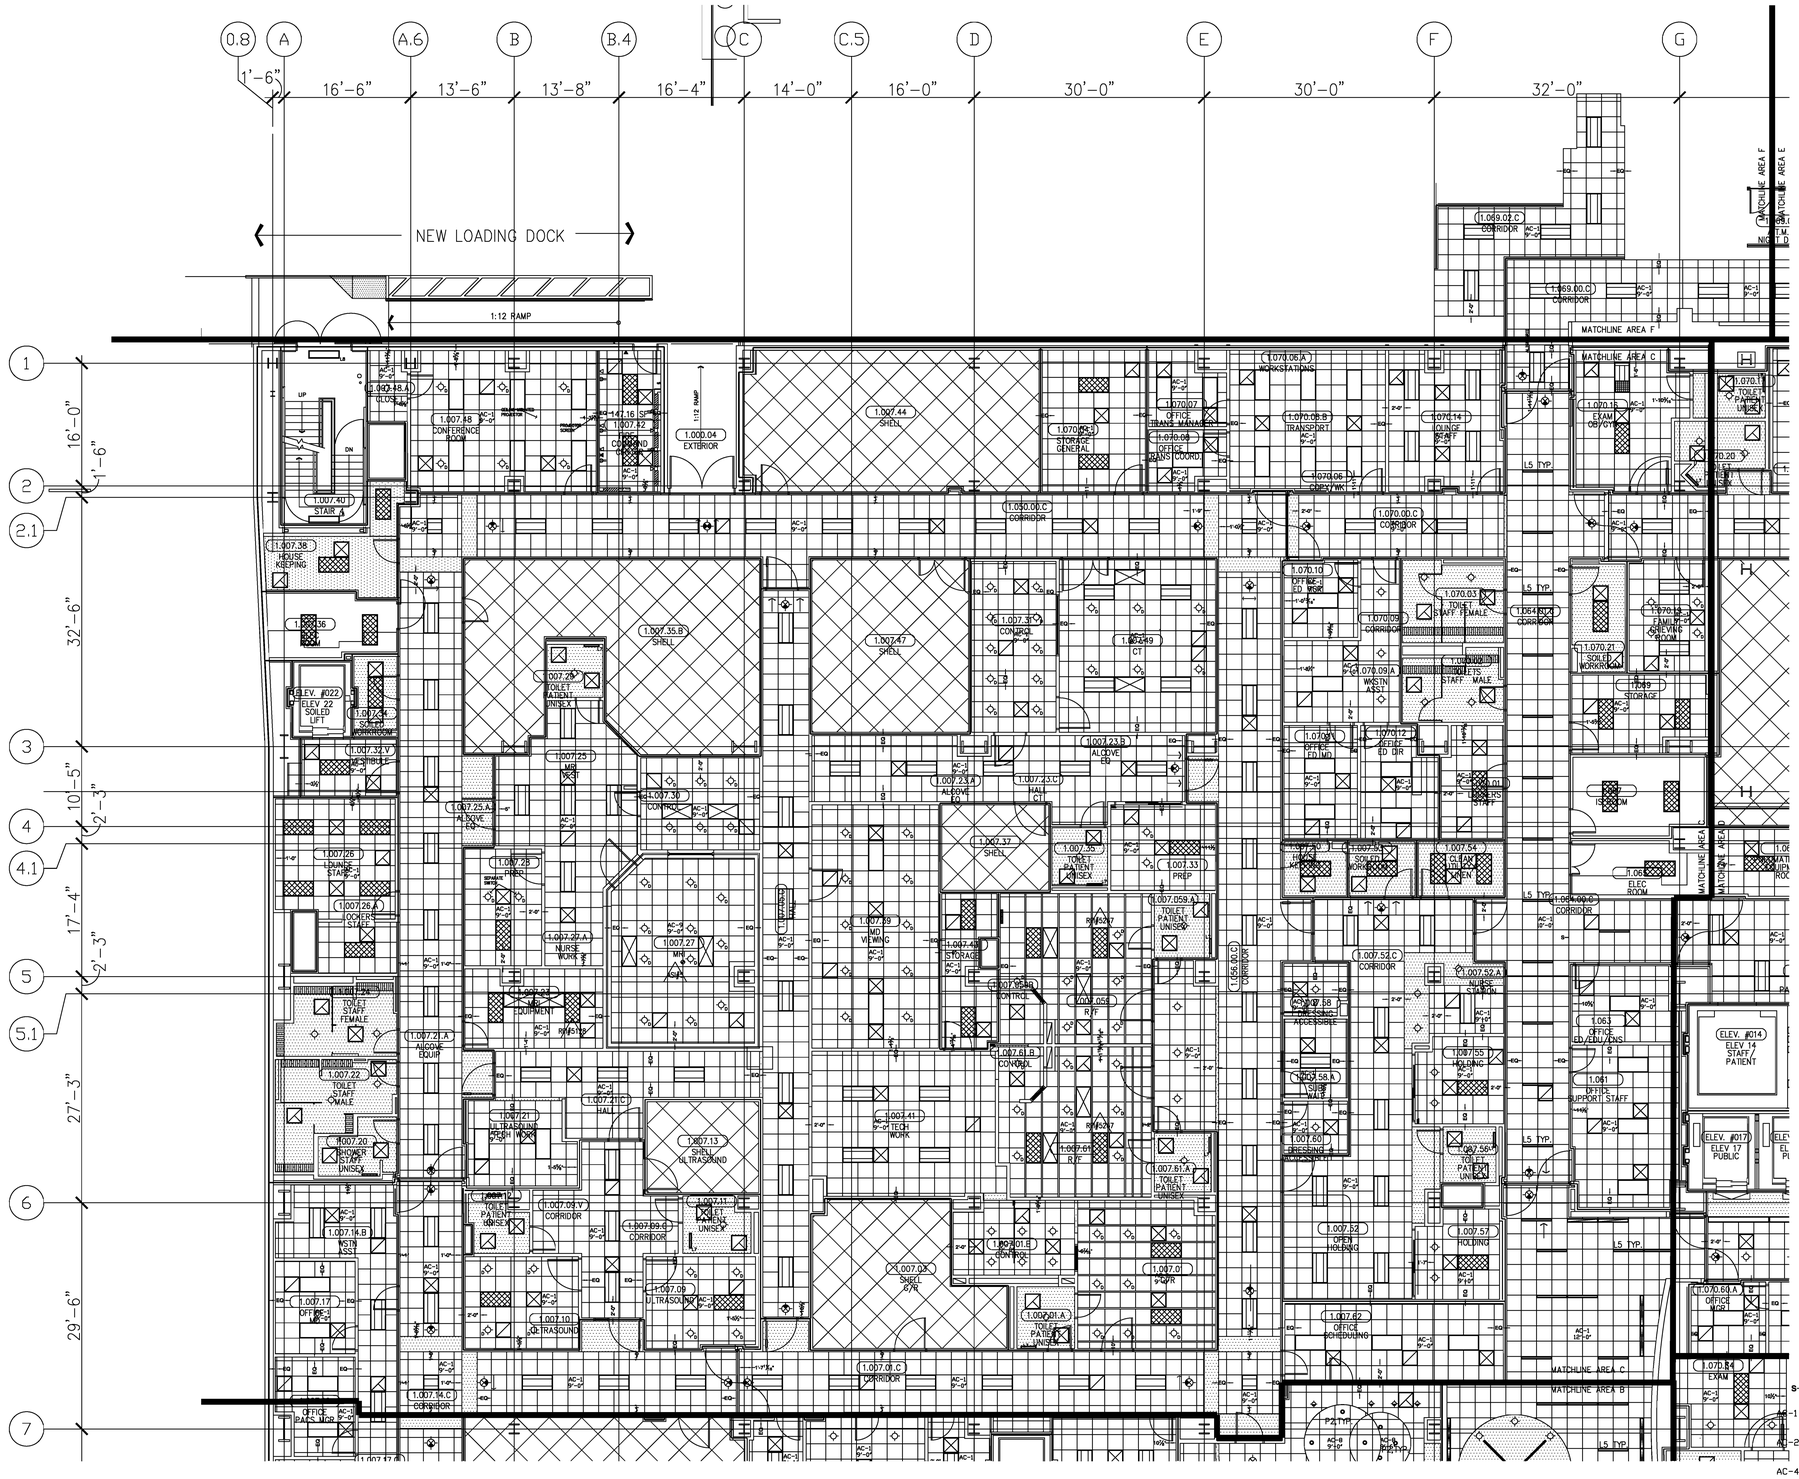

S–SLIP JOINT

AC-1 ARMSTRONG 3251 OPTIMA OPEN PLAN 2x2 CEILING TILE.
INSTALLED IN ARMSTRONG SUPRAFINE 9/16" GRID.

AC-2 ARMSTRONG 1720 CLEAN ROOM MYLAR 2x2 CEILING TILE.
INSTALLED IN ARMSTRONG CLEAN ROOM 15/16" GRID.

AC-4 ARMSTRONG 589 CIRRUS 2x2 CEILING TILE.
INSTALLED IN ARMSTRONG SUPRAFINE 9/16" GRID.

AC-5 ARMSTRONG 1935 HEALTHZONE ULTIMA 2x2 CEILING TILE.
INSTALLED IN ARMSTRONG PRELUDE 15/16" GRID.

AC-6 DECOUSTICS CLARO 4x4 CEILING TILE.
INSTALLED IN CEILENCIO TORSION SPRING GRID.

AC-7 DECOUSTICS CLARO CEILING TILE (CUSTOM SIZE).
INSTALLED IN CEILENCIO TORSION SPRING GRID.

AC-8 ARMSTRONG 3152 OPTIMA OPEN PLAN 2x2 CEILING TILE.
INSTALLED IN ARMSTRONG PRELUDE 15/16" GRID.

AC-9 ARMSTRONG 869 CLEAN ROOM VL PERFORATED 2x2 CEILING TILE.
INSTALLED IN ARMSTRONG PRELUDE 15/16" GRID.

Issue Date:

Revisions		
No.	Date	Description
	08-05-10	FOR SUBMITTAL
1	02-22-11	ADDED DIMENSIONS FOR GRID LOCATIONS
		APPLIED NEW ARCH. BACKGROUND
2	06-29-11	REVISED FINISH SCHEDULE
3	07-16-12	ADDED SLIP JOINT LOCATIONS FOR RECORD

Architect's Approval

Contractor's Approval

Key Plan

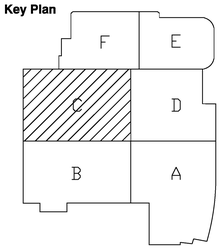

CHILDREN'S HOSPITAL OF ORANGE COUNTY TOWER II PROJECT

455 S. MAIN St. ORANGE, CA 92868

MARTIN INTEGRATED
2330 N. Pacific Street, Orange, CA. 92865
Phone 714.998.9100 Fax 714.998.1414
Lic. # 566629
www.martinintegrated.com

Project Number: MIS#7874/MCCARTHY#7453

Sheet Title:

LEVEL 1/AREA C REFLECTIVE CEILING PLAN

Scale: 1/8" = 1' 0"

Reference Sheet Number: INCREMENT #7 A4.1C

Building:

Sheet Number: MIS-4.1C

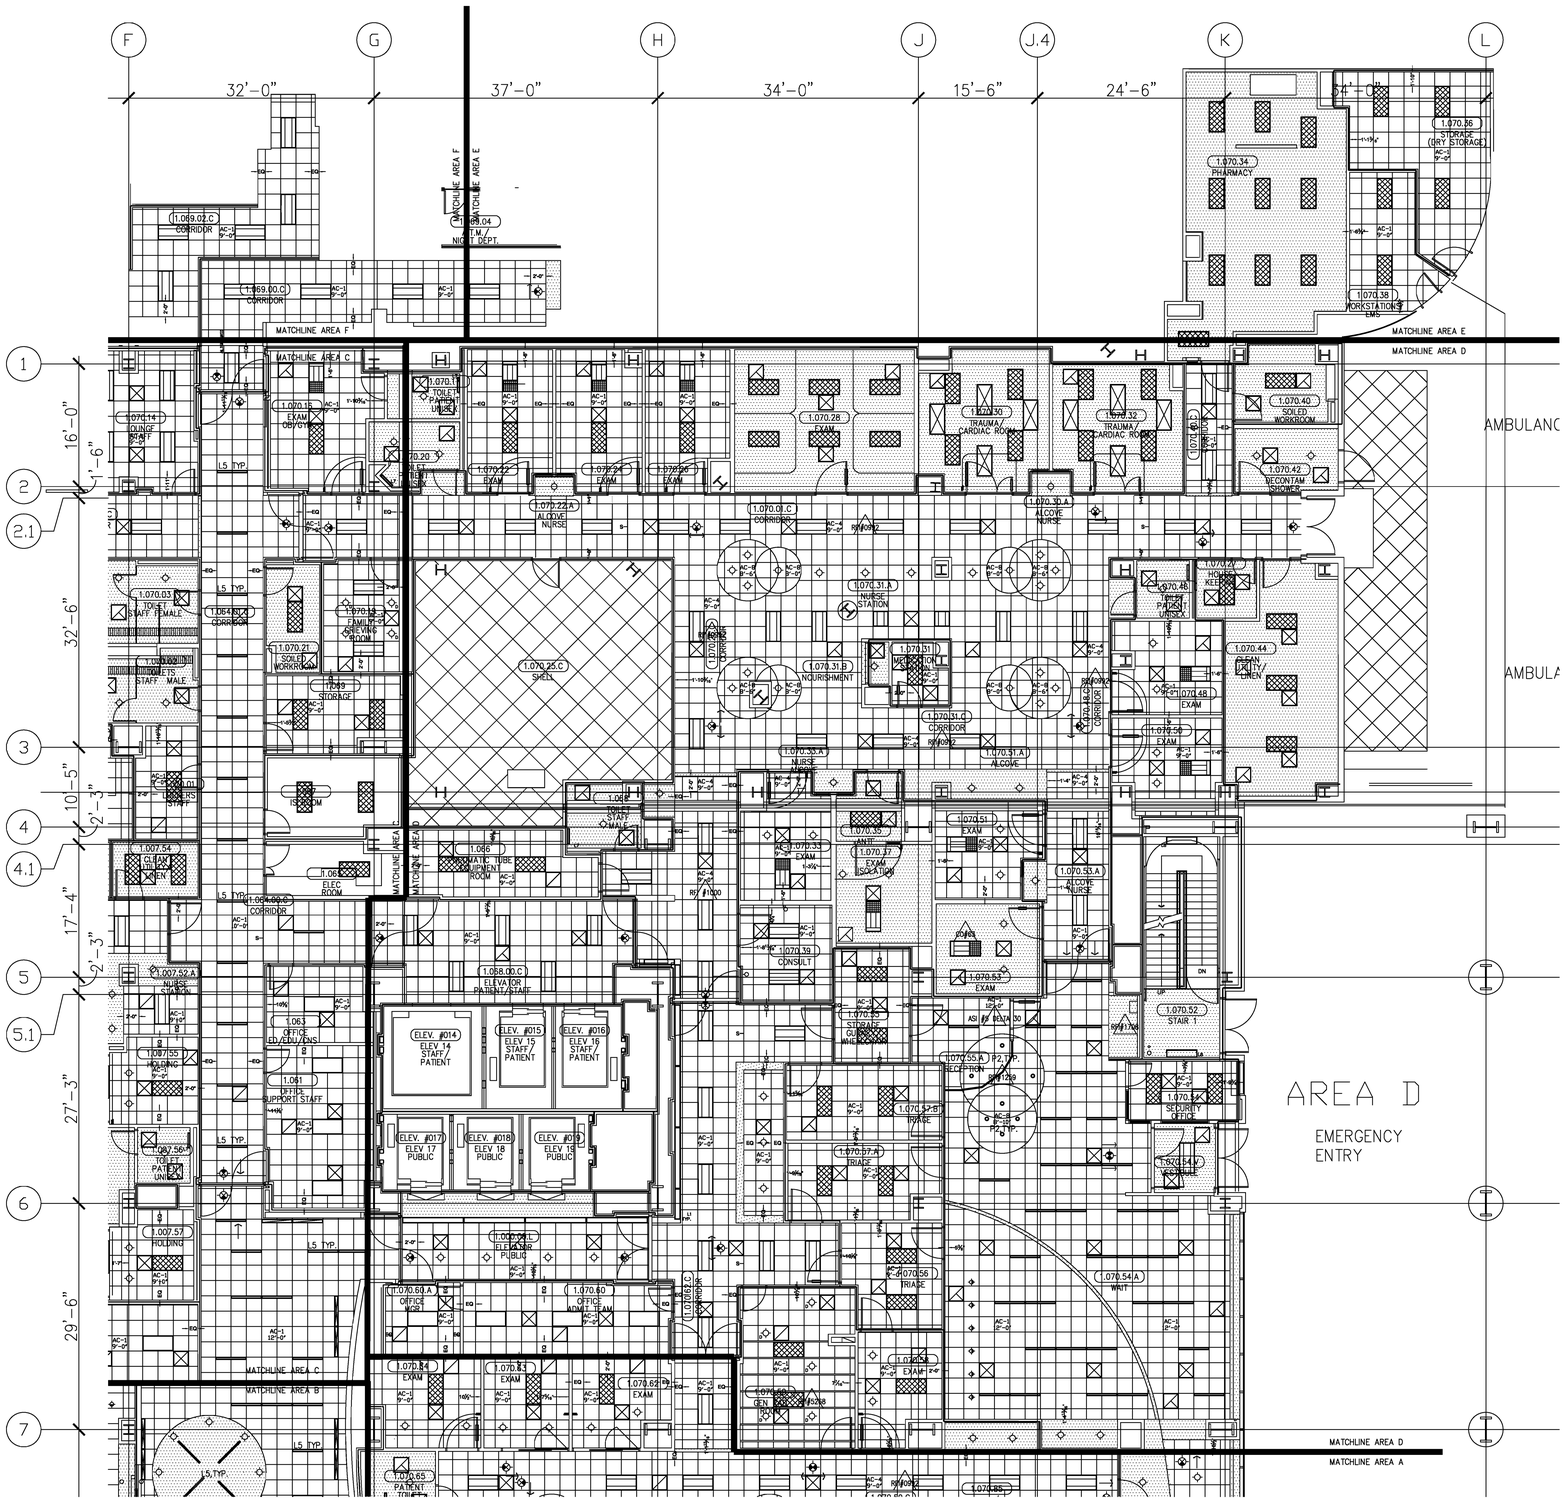
AREA F
AREA E
AREA D
EMERGENCY ENTRY
F
G
H
J
J.4
K
L
1
2
2.1
3
4
4.1
5
5.1
6
7
32'-0"
37'-0"
34'-0"
15'-6"
24'-6"
16'-0"
1'-6"
32'-6"
10'-5"
2'-3"
17'-4"
2'-3"
27'-3"
29'-6"
MATCHLINE AREA F
MATCHLINE AREA E
MATCHLINE AREA C
MATCHLINE AREA D
MATCHLINE AREA B
MATCHLINE AREA A
1.070.34 PHARMACY
1.070.36 STORAGE (DRY STORAGE)
1.070.38 WORKSTATION EMS
1.070.40 SOILED WORKROOM
1.070.44 CLEAN UTILITY/ LINEN
1.070.48 EXAM
1.070.52 STAIR 1
1.070.54 SECURITY OFFICE
1.070.54.A WAIT
1.070.56 TRIAGE
1.070.57 TRIAGE
1.070.60 OFFICE ADMIT TEAM
1.070.60.A OFFICE WOB
1.070.62 EXAM
1.070.63 EXAM
1.070.64 EXAM
1.070.65 PATIENT
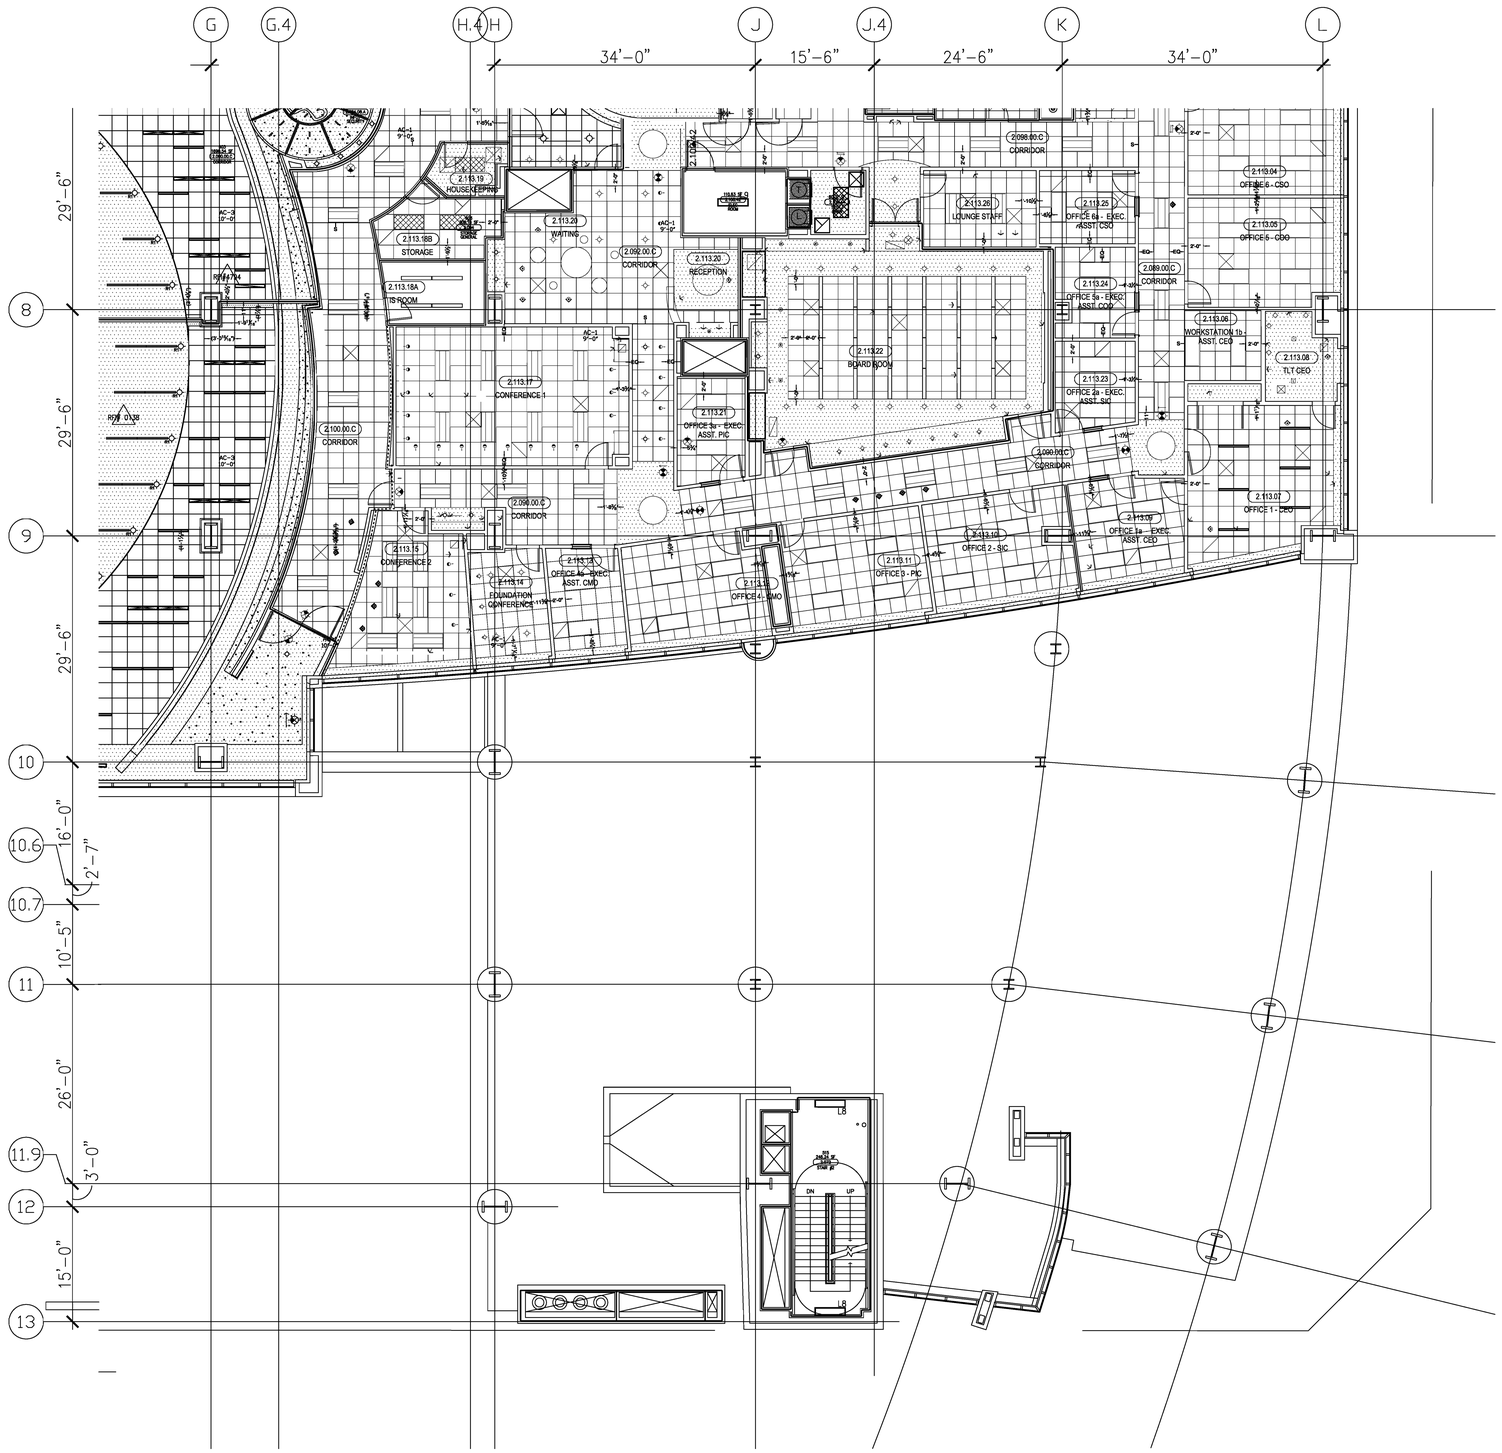

S—SLIP JOINT

AC-1 ARMSTRONG 3251 OPTIMA OPEN PLAN 2x2 CEILING TILE.
INSTALLED IN ARMSTRONG SUPRAFINE 9/16" GRID.

AC-2 ARMSTRONG 1720 CLEAN ROOM MYLAR 2x2 CEILING TILE.
INSTALLED IN ARMSTRONG CLEAN ROOM 15/16" GRID.

AC-4 ARMSTRONG 589 CIRRUS 2x2 CEILING TILE.
INSTALLED IN ARMSTRONG SUPRAFINE 9/16" GRID.

AC-5 ARMSTRONG 1935 HEALTHZONE ULTIMA 2x2 CEILING TILE.
INSTALLED IN ARMSTRONG PRELUDE 15/16" GRID.

AC-6 DECOUSTICS CLARO 4x4 CEILING TILE.
INSTALLED IN CEILENCIO TORSION SPRING GRID.

AC-7 DECOUSTICS CLARO CEILING TILE (CUSTOM SIZE).
INSTALLED IN CEILENCIO TORSION SPRING GRID.

AC-8 ARMSTRONG 3152 OPTIMA OPEN PLAN 2x2 CEILING TILE.
INSTALLED IN ARMSTRONG PRELUDE 15/16" GRID.

AC-9 ARMSTRONG 869 CLEAN ROOM VL PERFORATED 2x2 CEILING TILE.
INSTALLED IN ARMSTRONG PRELUDE 15/16" GRID.

Issue Date:

Revisions		
No.	Date	Description
	08-05-10	FOR SUBMITTAL
2	11-14-11	APPLIED NEW ARCH. BACKGROUND
		ADDED DIMENSIONS FOR GRID LOCATIONS
		REVISED FINISH SCHEDULE
3	07-16-12	ADDED SLIP JOINT LOCATIONS FOR RECORD

Architect's Approval

Contractor's Approval

Key Plan

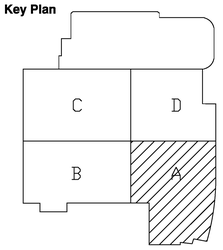

CHILDREN'S HOSPITAL OF ORANGE COUNTY TOWER II PROJECT

455 S. MAIN St. ORANGE, CA 92868

MARTIN INTEGRATED
2330 N. Pacific Street, Orange, CA. 92865
Phone 714.998.9100 Fax 714.998.1414
Lic. # 566629
www.martinintegrated.com

Project Number: MIS#7874/MCCARTHY#7453

Sheet Title:

LEVEL 2/AREA A REFLECTIVE CEILING PLAN

Scale: 1/8" = 1' 0"

Reference Sheet Number: INCREMENT #7 A4.2A

Building:

Sheet Number: MIS-4.2A

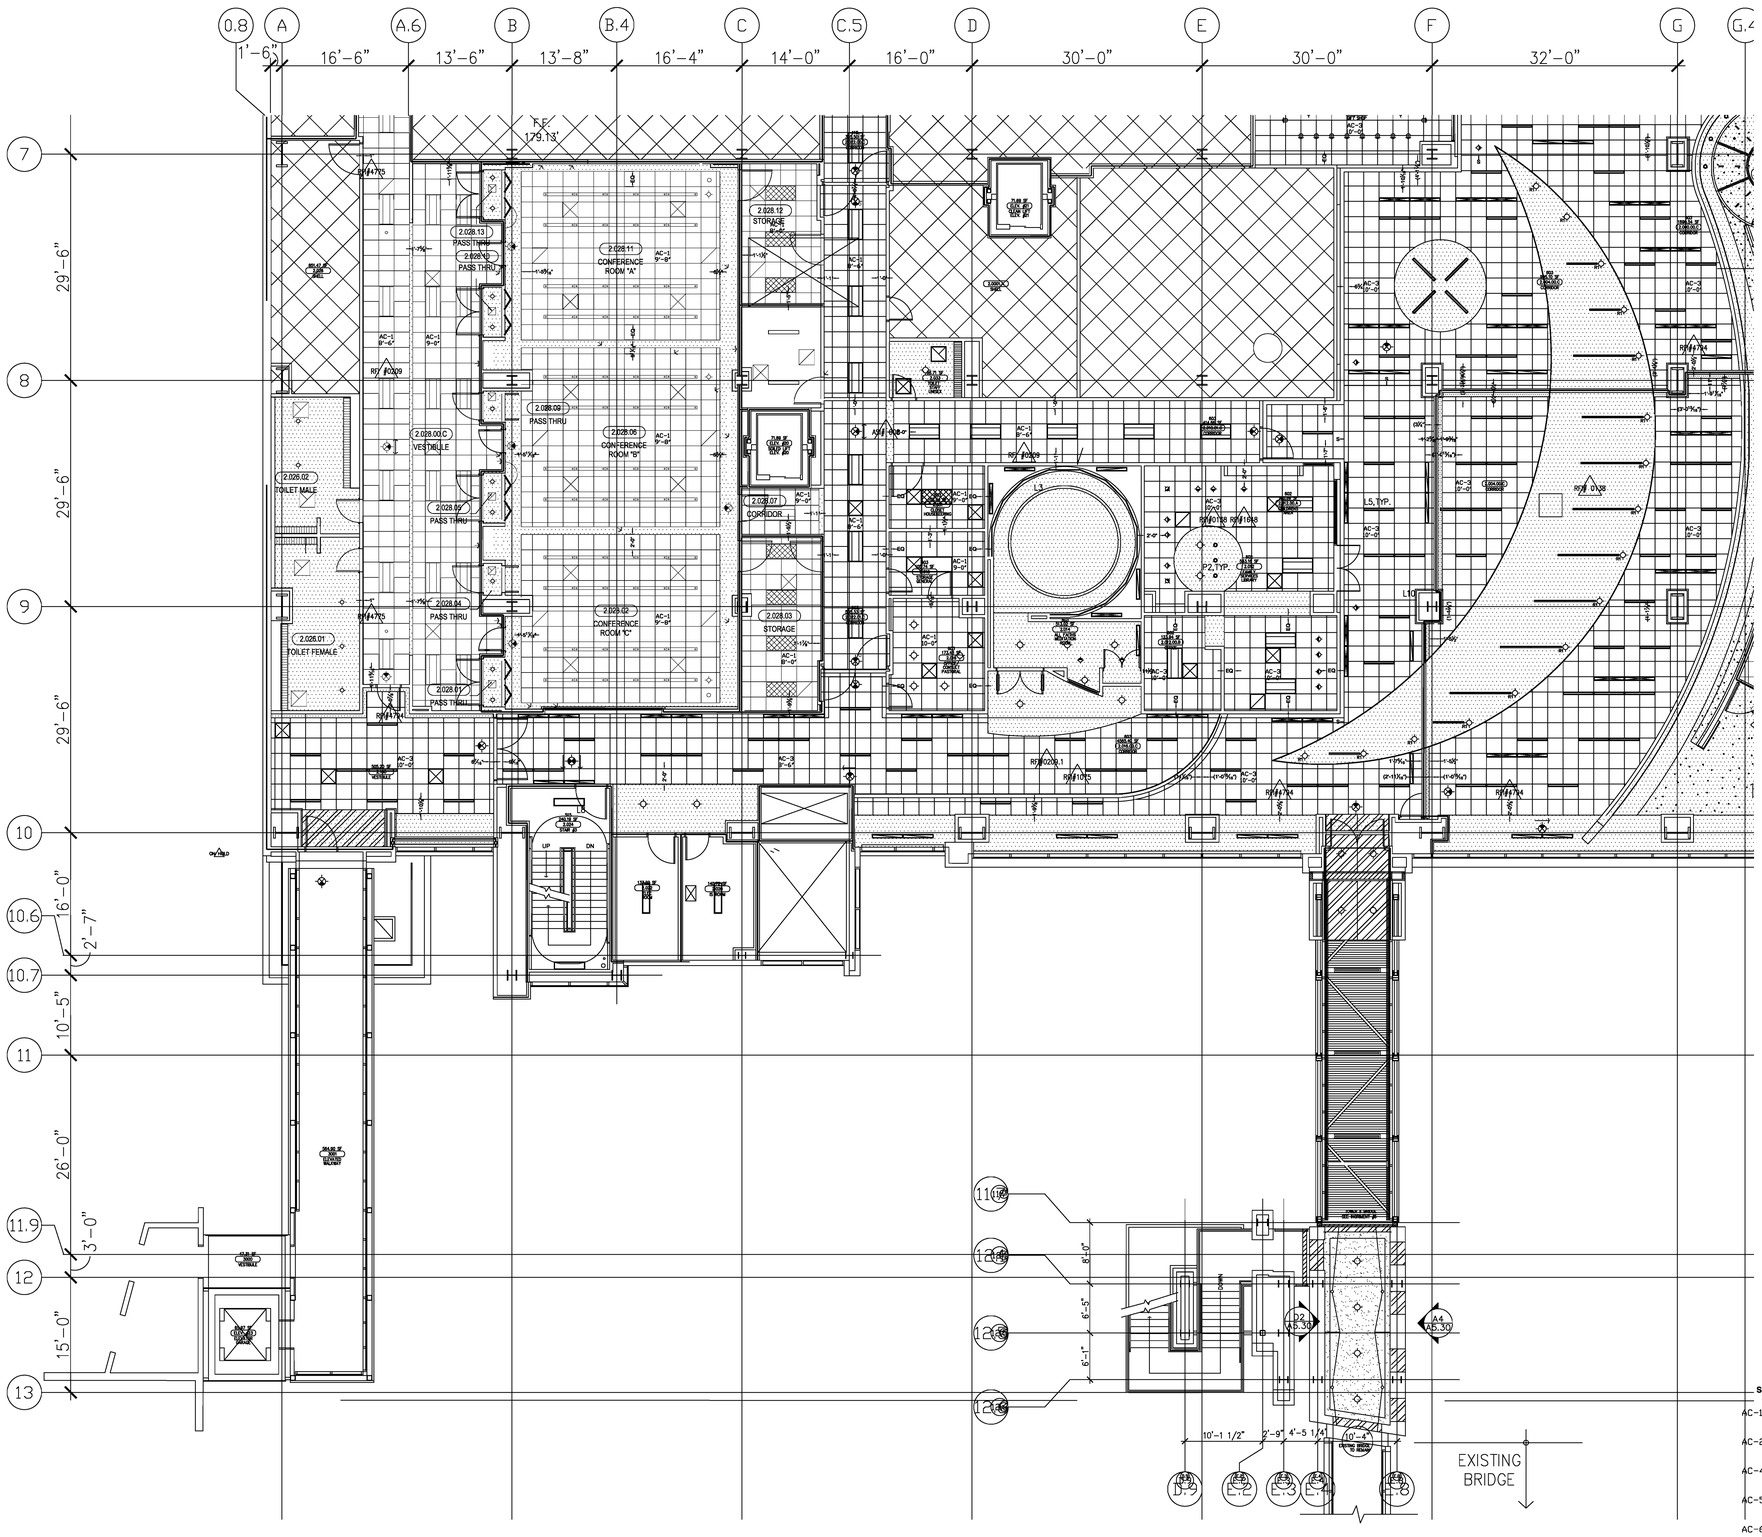
0.8
A
A.6
B
B.4
C
C.5
D
E
F
G
G.4
1'-6"
16'-6"
13'-6"
13'-8"
16'-4"
14'-0"
16'-0"
30'-0"
30'-0"
32'-0"
7
8
9
10
10.6
10.7
11
11.9
12
13
29'-6"
29'-6"
29'-6"
16'-0"
2'-7"
10'-5"
26'-0"
3'-0"
15'-0"
F.F.
179.13'
2.028.11
CONFERENCE ROOM "A"
2.028.06
CONFERENCE ROOM "B"
2.028.02
CONFERENCE ROOM "C"
2.028.12
STORAGE
2.028.13
PASS THRU
2.028.10
PASS THRU
2.028.09
PASS THRU
2.028.00.C
VESTIBULE
2.028.08
PASS THRU
2.028.07
CORRIDOR
2.028.03
STORAGE
2.028.02
TOILET MALE
2.028.01
TOILET FEMALE
2.028.04
PASS THRU
2.028.05
PASS THRU
UP
DN
L3
L5 TYP.
L10
P2 TYP.

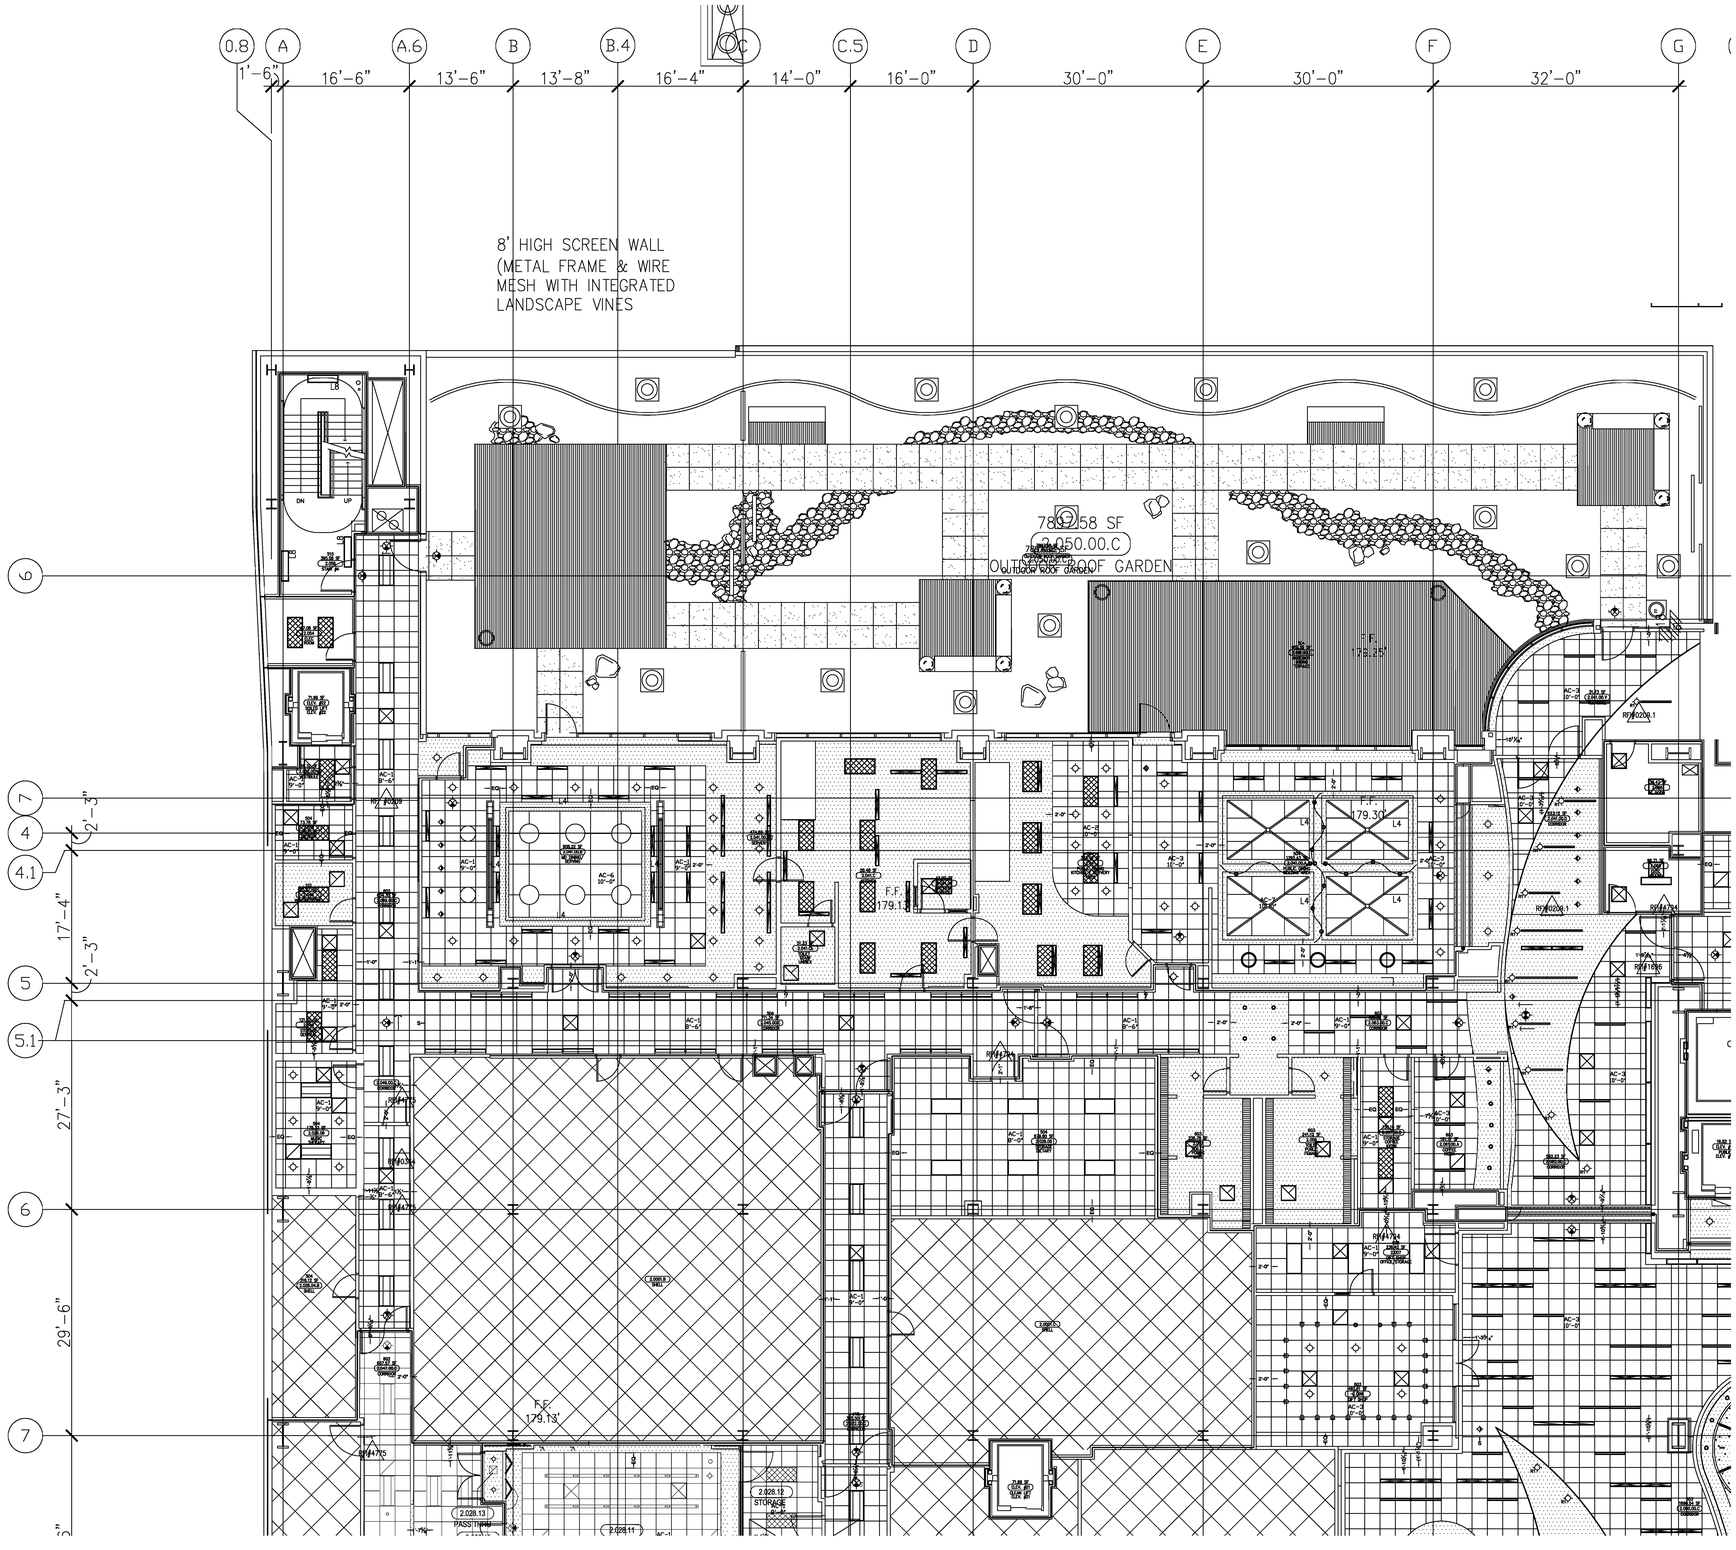

S—SLIP JOINT

AC-1 ARMSTRONG 3251 OPTIMA OPEN PLAN 2x2 CEILING TILE.
INSTALLED IN ARMSTRONG SUPRAFINE 9/16" GRID.

AC-2 ARMSTRONG 1720 CLEAN ROOM MYLAR 2x2 CEILING TILE.
INSTALLED IN ARMSTRONG CLEAN ROOM 15/16" GRID.

AC-4 ARMSTRONG 589 CIRRUS 2x2 CEILING TILE.
INSTALLED IN ARMSTRONG SUPRAFINE 9/16" GRID.

AC-5 ARMSTRONG 1935 HEALTHZONE ULTIMA 2x2 CEILING TILE.
INSTALLED IN ARMSTRONG PRELUDE 15/16" GRID.

AC-6 DECOUSTICS CLARO 4x4 CEILING TILE.
INSTALLED IN CEILENCIO TORSION SPRING GRID.

AC-7 DECOUSTICS CLARO CEILING TILE (CUSTOM SIZE).
INSTALLED IN CEILENCIO TORSION SPRING GRID.

AC-8 ARMSTRONG 3152 OPTIMA OPEN PLAN 2x2 CEILING TILE.
INSTALLED IN ARMSTRONG PRELUDE 15/16" GRID.

AC-9 ARMSTRONG 869 CLEAN ROOM VL PERFORATED 2x2 CEILING TILE.
INSTALLED IN ARMSTRONG PRELUDE 15/16" GRID.

Issue Date:

Revisions		
No.	Date	Description
	08-05-10	FOR SUBMITTAL
2	11-14-11	APPLIED NEW ARCH. BACKGROUND
		ADDED DIMENSIONS FOR GRID LOCATIONS
		REVISED FINISH SCHEDULE
3	07-16-12	ADDED SLIP JOINT LOCATIONS FOR RECORD

Architect's Approval

Contractor's Approval

Key Plan

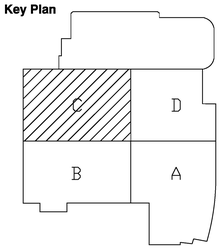

CHILDREN'S HOSPITAL OF ORANGE COUNTY TOWER II PROJECT

455 S. MAIN St. ORANGE, CA 92868

MARTIN INTEGRATED
2330 N. Pacific Street, Orange, CA. 92865
Phone 714.998.9100 Fax 714.998.1414
Lic. # 566629
www.martinintegrated.com

Project Number: MIS#7874/MCCARTHY#7453

Sheet Title: LEVEL 2/AREA C REFLECTIVE CEILING PLAN

Scale: 1/8" = 1' 0"

Reference Sheet Number: INCREMENT #7 A4.2C

Building:

Sheet Number: MIS-4.2C

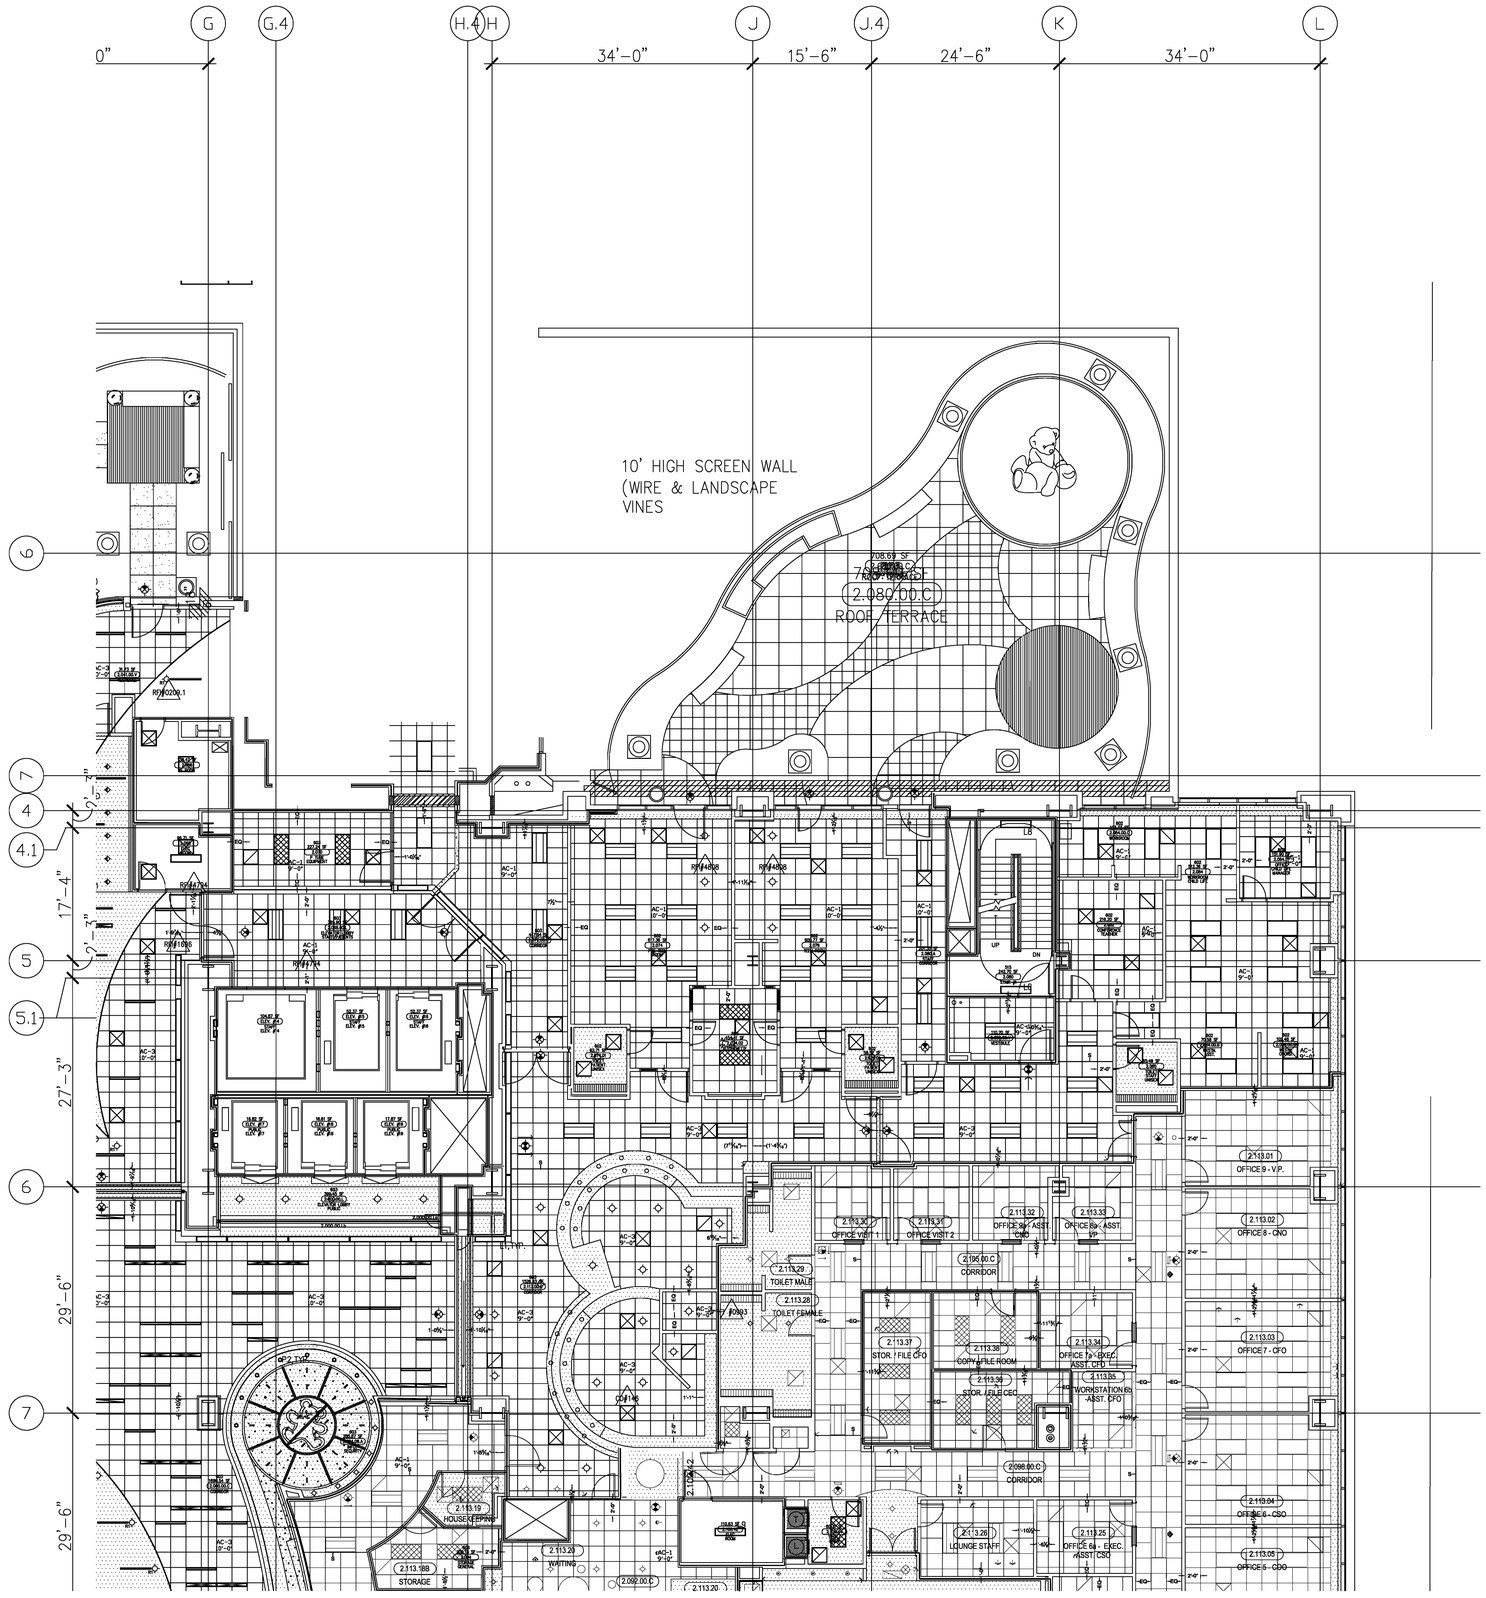

S—SLIP JOINT

AC-1 ARMSTRONG 3251 OPTIMA OPEN PLAN 2x2 CEILING TILE.
INSTALLED IN ARMSTRONG SUPRAFINE 9/16" GRID.

AC-2 ARMSTRONG 1720 CLEAN ROOM MYLAR 2x2 CEILING TILE.
INSTALLED IN ARMSTRONG CLEAN ROOM 15/16" GRID.

AC-4 ARMSTRONG 589 CIRRUS 2x2 CEILING TILE.
INSTALLED IN ARMSTRONG SUPRAFINE 9/16" GRID.

AC-5 ARMSTRONG 1935 HEALTHZONE ULTIMA 2x2 CEILING TILE.
INSTALLED IN ARMSTRONG PRELUDE 15/16" GRID.

AC-6 DECOUSTICS CLARO 4x4 CEILING TILE.
INSTALLED IN CEILENCIO TORSION SPRING GRID.

AC-7 DECOUSTICS CLARO CEILING TILE (CUSTOM SIZE).
INSTALLED IN CEILENCIO TORSION SPRING GRID.

AC-8 ARMSTRONG 3152 OPTIMA OPEN PLAN 2x2 CEILING TILE.
INSTALLED IN ARMSTRONG PRELUDE 15/16" GRID.

AC-9 ARMSTRONG 869 CLEAN ROOM VL PERFORATED 2x2 CEILING TILE.
INSTALLED IN ARMSTRONG PRELUDE 15/16" GRID.

Issue Date:		
Revisions		
No.	Date	Description
	08-05-10	FOR SUBMITTAL
2	11-14-11	APPLIED NEW ARCH. BACKGROUND
		ADDED DIMENSIONS FOR GRID LOCATIONS
		REVISED FINISH SCHEDULE
3	07-16-12	ADDED SLIP JOINT LOCATIONS FOR RECORD

Architect's Approval

Contractor's Approval

Key Plan

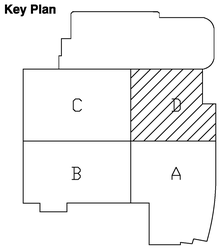

CHILDREN'S HOSPITAL OF ORANGE COUNTY TOWER II PROJECT

455 S. MAIN St. ORANGE, CA 92868

MARTIN INTEGRATED
2330 N. Pacific Street, Orange, CA. 92865
Phone 714.998.9100 Fax 714.998.1414
Lic. # 566629
www.martinintegrated.com

Project Number: MIS#7874/MCCARTHY#7453

Sheet Title: LEVEL 2/AREA D REFLECTIVE CEILING PLAN

Scale: 1/8" = 1' 0"

Reference Sheet Number: INCREMENT #7 A4.2D

Building:

Sheet Number: MIS-4.2D

S—SLIP JOINT

AC-1 ARMSTRONG 3251 OPTIMA OPEN PLAN 2x2 CEILING TILE.
INSTALLED IN ARMSTRONG SUPRAFINE 9/16" GRID.

AC-2 ARMSTRONG 1720 CLEAN ROOM MYLAR 2x2 CEILING TILE.
INSTALLED IN ARMSTRONG CLEAN ROOM 15/16" GRID.

AC-4 ARMSTRONG 589 CIRRUS 2x2 CEILING TILE.
INSTALLED IN ARMSTRONG SUPRAFINE 9/16" GRID.

AC-5 ARMSTRONG 1935 HEALTHZONE ULTIMA 2x2 CEILING TILE.
INSTALLED IN ARMSTRONG PRELUDE 15/16" GRID.

AC-6 DECOUSTICS CLARO 4x4 CEILING TILE.
INSTALLED IN CEILENCIO TORSION SPRING GRID.

AC-7 DECOUSTICS CLARO CEILING TILE (CUSTOM SIZE).
INSTALLED IN CEILENCIO TORSION SPRING GRID.

AC-8 ARMSTRONG 3152 OPTIMA OPEN PLAN 2x2 CEILING TILE.
INSTALLED IN ARMSTRONG PRELUDE 15/16" GRID.

AC-9 ARMSTRONG 869 CLEAN ROOM VL PERFORATED 2x2 CEILING TILE.
INSTALLED IN ARMSTRONG PRELUDE 15/16" GRID.

Issue Date:

Revisions		
No.	Date	Description
	08-05-10	FOR SUBMITTAL
1	02-22-11	ADDED DIMENSIONS FOR GRID LOCATIONS
		APPLIED NEW ARCH. BACKGROUND
2	06-29-11	REVISED FINISH SCHEDULE
3	07-16-12	ADDED SLIP JOINT LOCATIONS FOR RECORD

Architect's Approval

Contractor's Approval

Key Plan

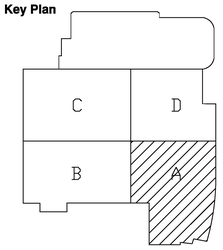

CHILDREN'S HOSPITAL OF ORANGE COUNTY TOWER II PROJECT

455 S. MAIN St. ORANGE, CA 92868

MARTIN INTEGRATED
2330 N. Pacific Street, Orange, CA. 92865
Phone 714.998.9100 Fax 714.998.1414
Lic. # 566629
www.martinintegrated.com

Project Number: MIS#7874/MCCARTHY#7453

Sheet Title:

LEVEL 3/AREA A REFLECTIVE CEILING PLAN

Scale: 1/8" = 1' 0"

Reference Sheet Number: INCREMENT #7 A4.3A

Building:

Sheet Number: MIS-4.3A

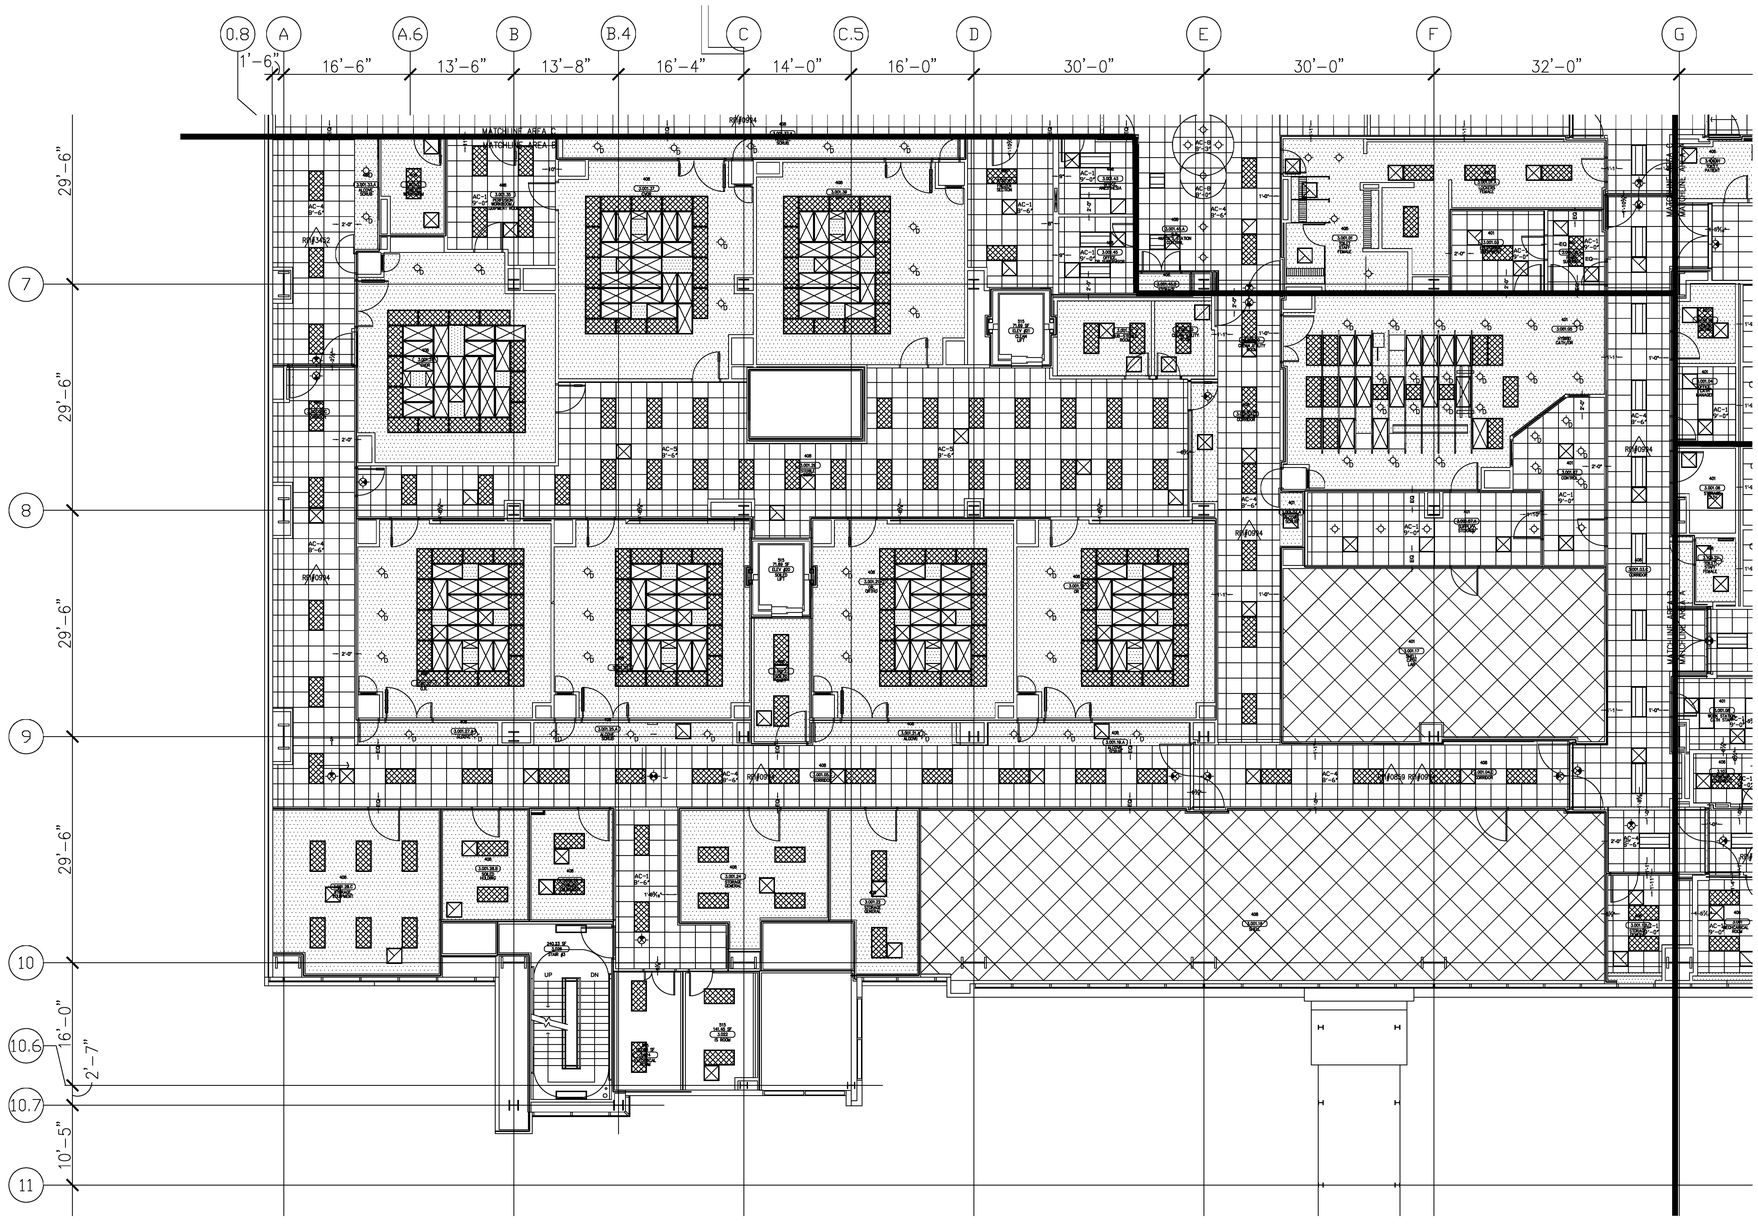

S—SLIP JOINT

AC-1 ARMSTRONG 3251 OPTIMA OPEN PLAN 2x2 CEILING TILE.
INSTALLED IN ARMSTRONG SUPRAFINE 9/16" GRID.

AC-2 ARMSTRONG 1720 CLEAN ROOM MYLAR 2x2 CEILING TILE.
INSTALLED IN ARMSTRONG CLEAN ROOM 15/16" GRID.

AC-4 ARMSTRONG 589 CIRRUS 2x2 CEILING TILE.
INSTALLED IN ARMSTRONG SUPRAFINE 9/16" GRID.

AC-5 ARMSTRONG 1935 HEALTHZONE ULTIMA 2x2 CEILING TILE.
INSTALLED IN ARMSTRONG PRELUDE 15/16" GRID.

AC-6 DECOUSTICS CLARO 4x4 CEILING TILE.
INSTALLED IN CEILENCIO TORSION SPRING GRID.

AC-7 DECOUSTICS CLARO CEILING TILE (CUSTOM SIZE).
INSTALLED IN CEILENCIO TORSION SPRING GRID.

AC-8 ARMSTRONG 3152 OPTIMA OPEN PLAN 2x2 CEILING TILE.
INSTALLED IN ARMSTRONG PRELUDE 15/16" GRID.

AC-9 ARMSTRONG 869 CLEAN ROOM VL PERFORATED 2x2 CEILING TILE.
INSTALLED IN ARMSTRONG PRELUDE 15/16" GRID.

Issue Date:

Revisions

No.	Date	Description
	08-05-10	FOR SUBMITTAL
1	02-22-11	ADDED DIMENSIONS FOR GRID LOCATIONS
		APPLIED NEW ARCH. BACKGROUND
2	06-29-11	REVISED FINISH SCHEDULE
3	07-16-12	ADDED SLIP JOINT LOCATIONS FOR RECORD

Architect's Approval

Contractor's Approval

Key Plan

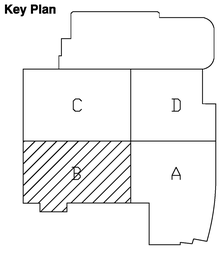

CHILDREN'S HOSPITAL OF ORANGE COUNTY TOWER II PROJECT

455 S. MAIN St. ORANGE, CA 92868

MARTIN INTEGRATED
2330 N. Pacific Street, Orange, CA. 92865
Phone 714.998.9100 Fax 714.998.1414
Lic. # 566629
www.martinintegrated.com

Project Number: MIS#7874/MCCARTHY#7453

Sheet Title:

LEVEL 3/AREA B REFLECTIVE CEILING PLAN

Scale: 1/8" = 1' 0"

Reference Sheet Number: INCREMENT #7 A4.3B

Building:

Sheet Number: MIS-4.3B

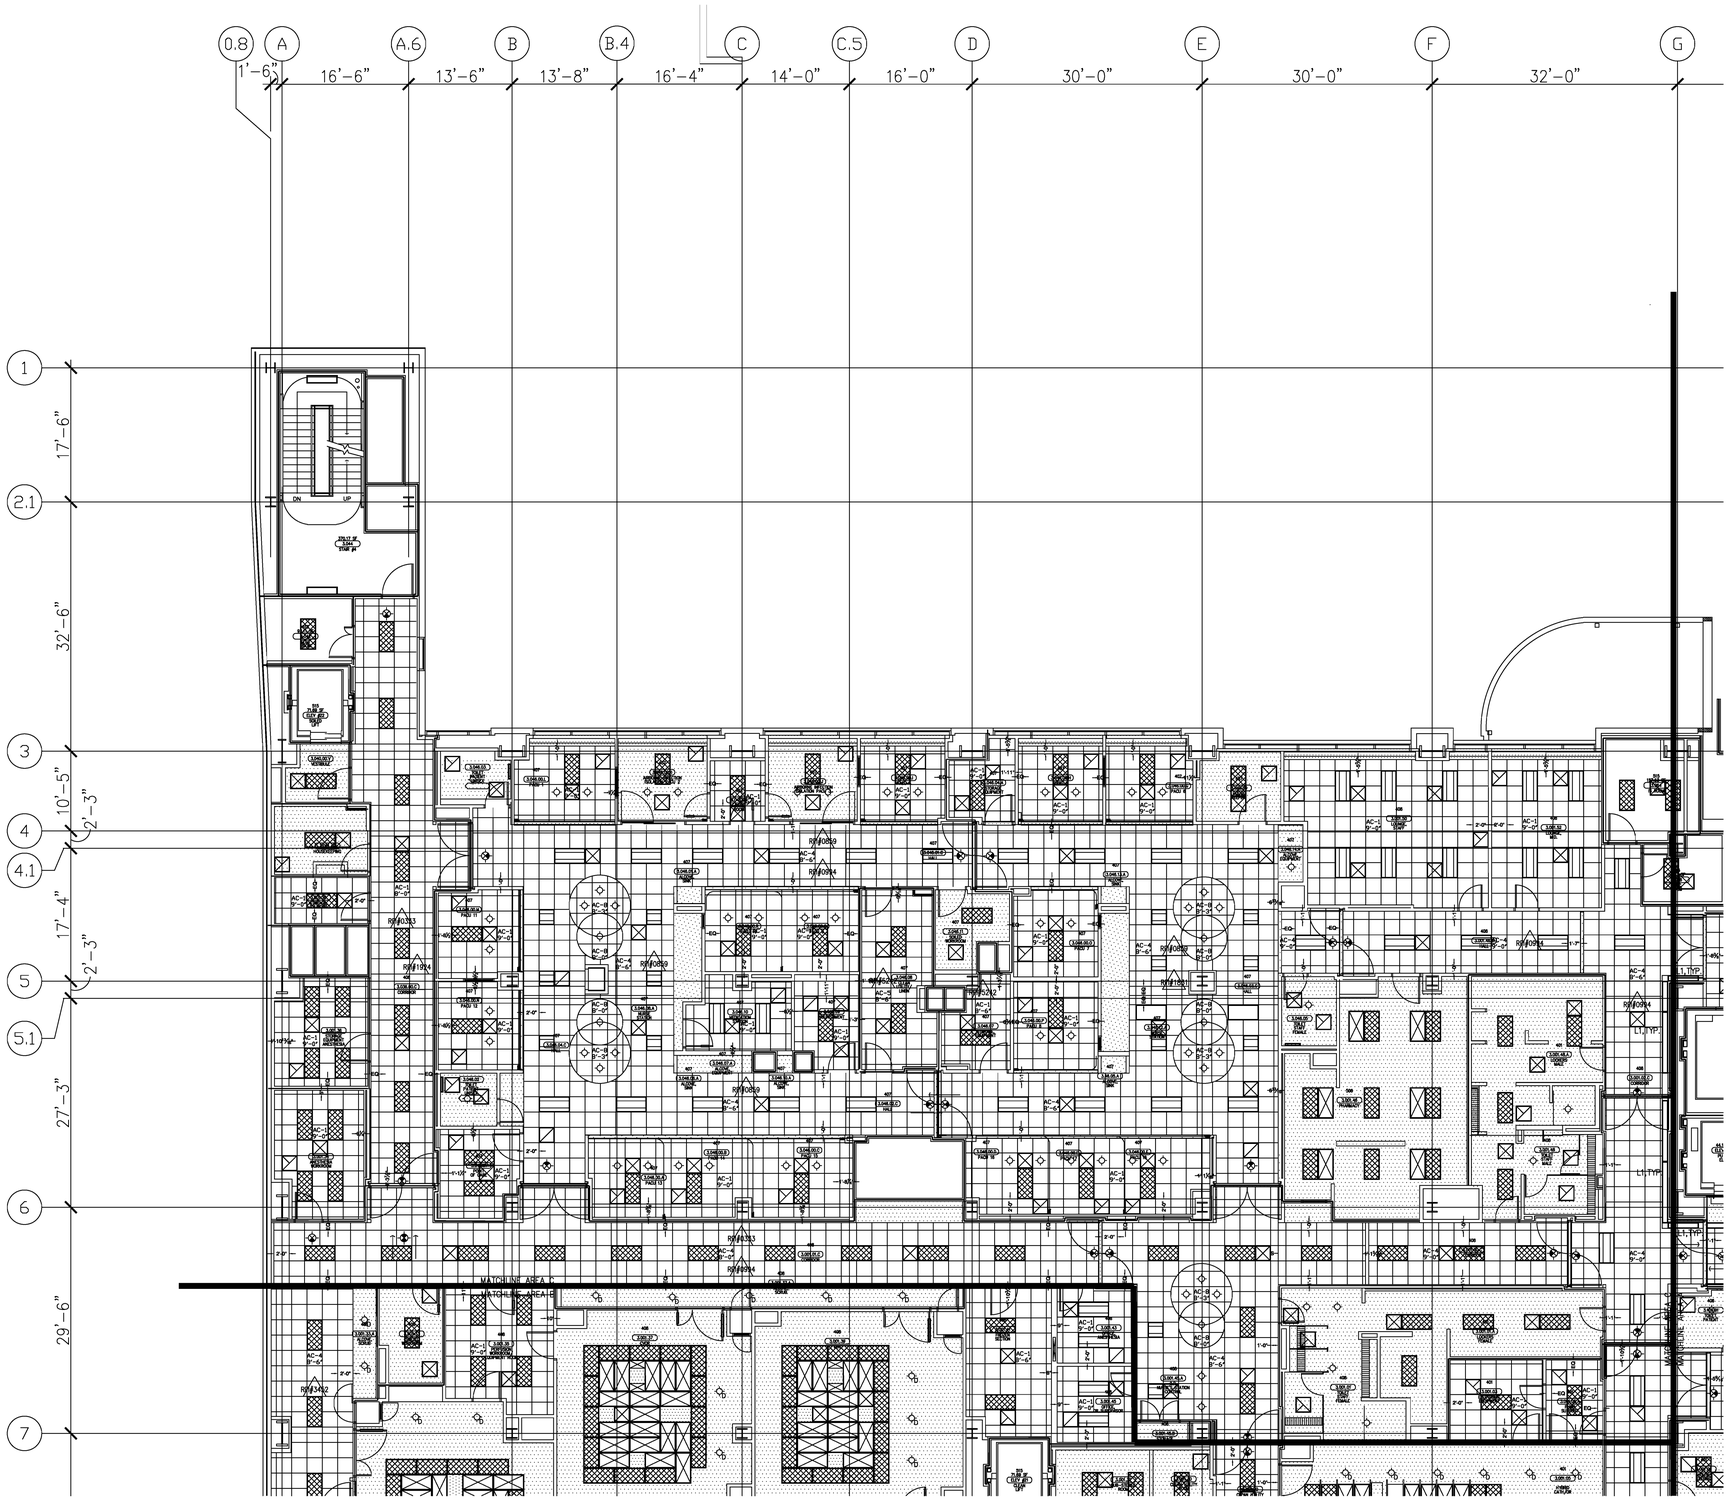

S—SLIP JOINT

AC-1 ARMSTRONG 3251 OPTIMA OPEN PLAN 2x2 CEILING TILE.
INSTALLED IN ARMSTRONG SUPRAFINE 9/16" GRID.

AC-2 ARMSTRONG 1720 CLEAN ROOM MYLAR 2x2 CEILING TILE.
INSTALLED IN ARMSTRONG CLEAN ROOM 15/16" GRID.

AC-4 ARMSTRONG 589 CIRRUS 2x2 CEILING TILE.
INSTALLED IN ARMSTRONG SUPRAFINE 9/16" GRID.

AC-5 ARMSTRONG 1935 HEALTHZONE ULTIMA 2x2 CEILING TILE.
INSTALLED IN ARMSTRONG PRELUDE 15/16" GRID.

AC-6 DECOUSTICS CLARD 4x4 CEILING TILE.
INSTALLED IN CEILENCIO TORSION SPRING GRID.

AC-7 DECOUSTICS CLARD CEILING TILE (CUSTOM SIZE).
INSTALLED IN CEILENCIO TORSION SPRING GRID.

AC-8 ARMSTRONG 3152 OPTIMA OPEN PLAN 2x2 CEILING TILE.
INSTALLED IN ARMSTRONG PRELUDE 15/16" GRID.

AC-9 ARMSTRONG 869 CLEAN ROOM VL PERFORATED 2x2 CEILING TILE.
INSTALLED IN ARMSTRONG PRELUDE 15/16" GRID.

Issue Date:

Revisions

No.	Date	Description
	08-05-10	FOR SUBMITTAL
1	02-22-11	ADDED DIMENSIONS FOR GRID LOCATIONS
		APPLIED NEW ARCH. BACKGROUND
2	06-29-11	REVISED FINISH SCHEDULE
3	07-16-12	ADDED SLIP JOINT LOCATIONS FOR RECORD

Architect's Approval

Contractor's Approval

Key Plan

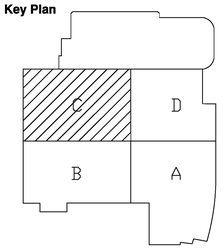

CHILDREN'S HOSPITAL OF ORANGE COUNTY TOWER II PROJECT

455 S. MAIN St. ORANGE, CA 92868

MARTIN INTEGRATED
2330 N. Pacific Street, Orange, CA. 92865
Phone 714.998.9100 Fax 714.998.1414
Lic. # 566629
www.martinintegrated.com

Project Number: MIS#7874/MCCARTHY#7453

Sheet Title:

LEVEL 3/AREA C REFLECTIVE CEILING PLAN

Scale: 1/8" = 1' 0"

Reference Sheet Number: INCREMENT #7 A4.3C

Building:

Sheet Number: MIS-4.3C

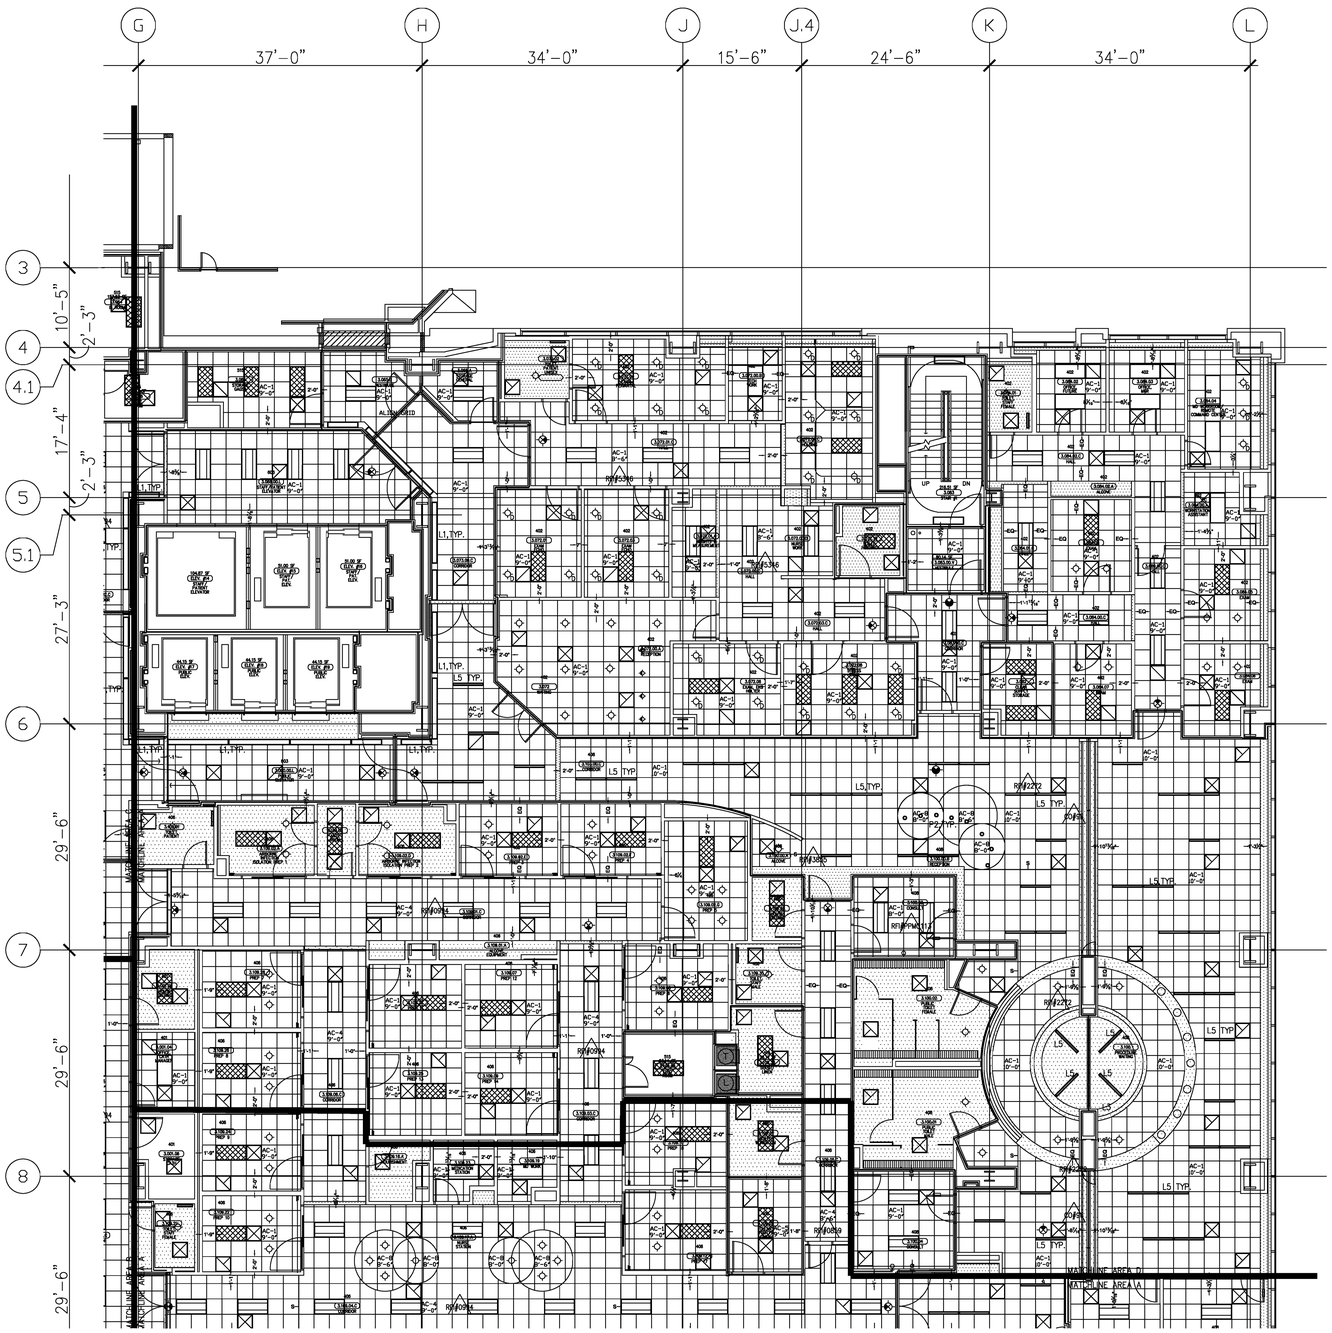

S—SLIP JOINT

AC-1 ARMSTRONG 3251 OPTIMA OPEN PLAN 2x2 CEILING TILE.
INSTALLED IN ARMSTRONG SUPRAFINE 9/16" GRID.

AC-2 ARMSTRONG 1720 CLEAN ROOM MYLAR 2x2 CEILING TILE.
INSTALLED IN ARMSTRONG CLEAN ROOM 15/16" GRID.

AC-4 ARMSTRONG 589 CIRRUS 2x2 CEILING TILE.
INSTALLED IN ARMSTRONG SUPRAFINE 9/16" GRID.

AC-5 ARMSTRONG 1935 HEALTHZONE ULTIMA 2x2 CEILING TILE.
INSTALLED IN ARMSTRONG PRELUDE 15/16" GRID.

AC-6 DECOUSTICS CLARD 4x4 CEILING TILE.
INSTALLED IN CEILENCID TORSION SPRING GRID.

AC-7 DECOUSTICS CLARD CEILING TILE (CUSTOM SIZE).
INSTALLED IN CEILENCID TORSION SPRING GRID.

AC-8 ARMSTRONG 3152 OPTIMA OPEN PLAN 2x2 CEILING TILE.
INSTALLED IN ARMSTRONG PRELUDE 15/16" GRID.

AC-9 ARMSTRONG 869 CLEAN ROOM VL PERFORATED 2x2 CEILING TILE.
INSTALLED IN ARMSTRONG PRELUDE 15/16" GRID.

Issue Date:

Revisions		
No.	Date	Description
	08-05-10	FOR SUBMITTAL
1	02-22-11	ADDED DIMENSIONS FOR GRID LOCATIONS
		APPLIED NEW ARCH. BACKGROUND
2	06-29-11	REVISED FINISH SCHEDULE
3	07-16-12	ADDED SLIP JOINT LOCATIONS FOR RECORD

Architect's Approval

Contractor's Approval

Key Plan

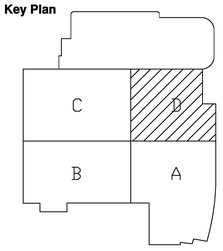

CHILDREN'S HOSPITAL
OF ORANGE COUNTY
TOWER II PROJECT

455 S. MAIN St.
ORANGE, CA 92868

MARTIN INTEGRATED
2330 N. Pacific Street, Orange, CA. 92865
Phone 714.998.9100 Fax 714.998.1414
Lic. # 566629
www.martinintegrated.com

Project Number: MIS#7874/MCCARTHY#7453

Sheet Title:

LEVEL 3/AREA D
REFLECTIVE CEILING PLAN

Scale: 1/8" = 1' 0"

Reference Sheet Number: INCREMENT #7 A4.3D

Building:

Sheet Number: MIS-4.3D

S–SLIP JOINT

AC-1 ARMSTRONG 3251 OPTIMA OPEN PLAN 2x2 CEILING TILE.
INSTALLED IN ARMSTRONG SUPRAFINE 9/16" GRID.

AC-2 ARMSTRONG 1720 CLEAN ROOM MYLAR 2x2 CEILING TILE.
INSTALLED IN ARMSTRONG CLEAN ROOM 15/16" GRID.

AC-4 ARMSTRONG 589 CIRRUS 2x2 CEILING TILE.
INSTALLED IN ARMSTRONG SUPRAFINE 9/16" GRID.

AC-5 ARMSTRONG 1935 HEALTHZONE ULTIMA 2x2 CEILING TILE.
INSTALLED IN ARMSTRONG PRELUDE 15/16" GRID.

AC-6 DECOUSTICS CLARO 4x4 CEILING TILE.
INSTALLED IN CEILENCIO TORSION SPRING GRID.

AC-7 DECOUSTICS CLARO CEILING TILE (CUSTOM SIZE).
INSTALLED IN CEILENCIO TORSION SPRING GRID.

AC-8 ARMSTRONG 3152 OPTIMA OPEN PLAN 2x2 CEILING TILE.
INSTALLED IN ARMSTRONG PRELUDE 15/16" GRID.

AC-9 ARMSTRONG 869 CLEAN ROOM VL PERFORATED 2x2 CEILING TILE.
INSTALLED IN ARMSTRONG PRELUDE 15/16" GRID.

Issue Date:

Revisions		
No.	Date	Description
	08-05-10	FOR SUBMITTAL
1	03-07-11	ADDED DIMENSIONS FOR GRID LOCATIONS
		APPLIED NEW ARCH. BACKGROUND
2	06-29-11	REVISED FINISH SCHEDULE
3	07-16-12	ADDED SLIP JOINT LOCATIONS FOR RECORD

Architect's Approval

Contractor's Approval

Key Plan

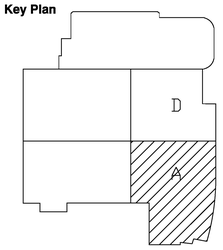

CHILDREN'S HOSPITAL OF ORANGE COUNTY TOWER II PROJECT

455 S. MAIN St. ORANGE, CA 92868

MARTIN INTEGRATED
2330 N. Pacific Street, Orange, CA. 92865
Phone 714.998.9100 Fax 714.998.1414
Lic. # 566629
www.martinintegrated.com

Project Number: MIS#7874/MCCARTHY#7453

Sheet Title:

LEVEL 5/AREA A REFLECTIVE CEILING PLAN

Scale: 1/8" = 1' 0"

Reference Sheet Number: INCREMENT #7 A4.5A

Building:

Sheet Number: MIS-4.5A

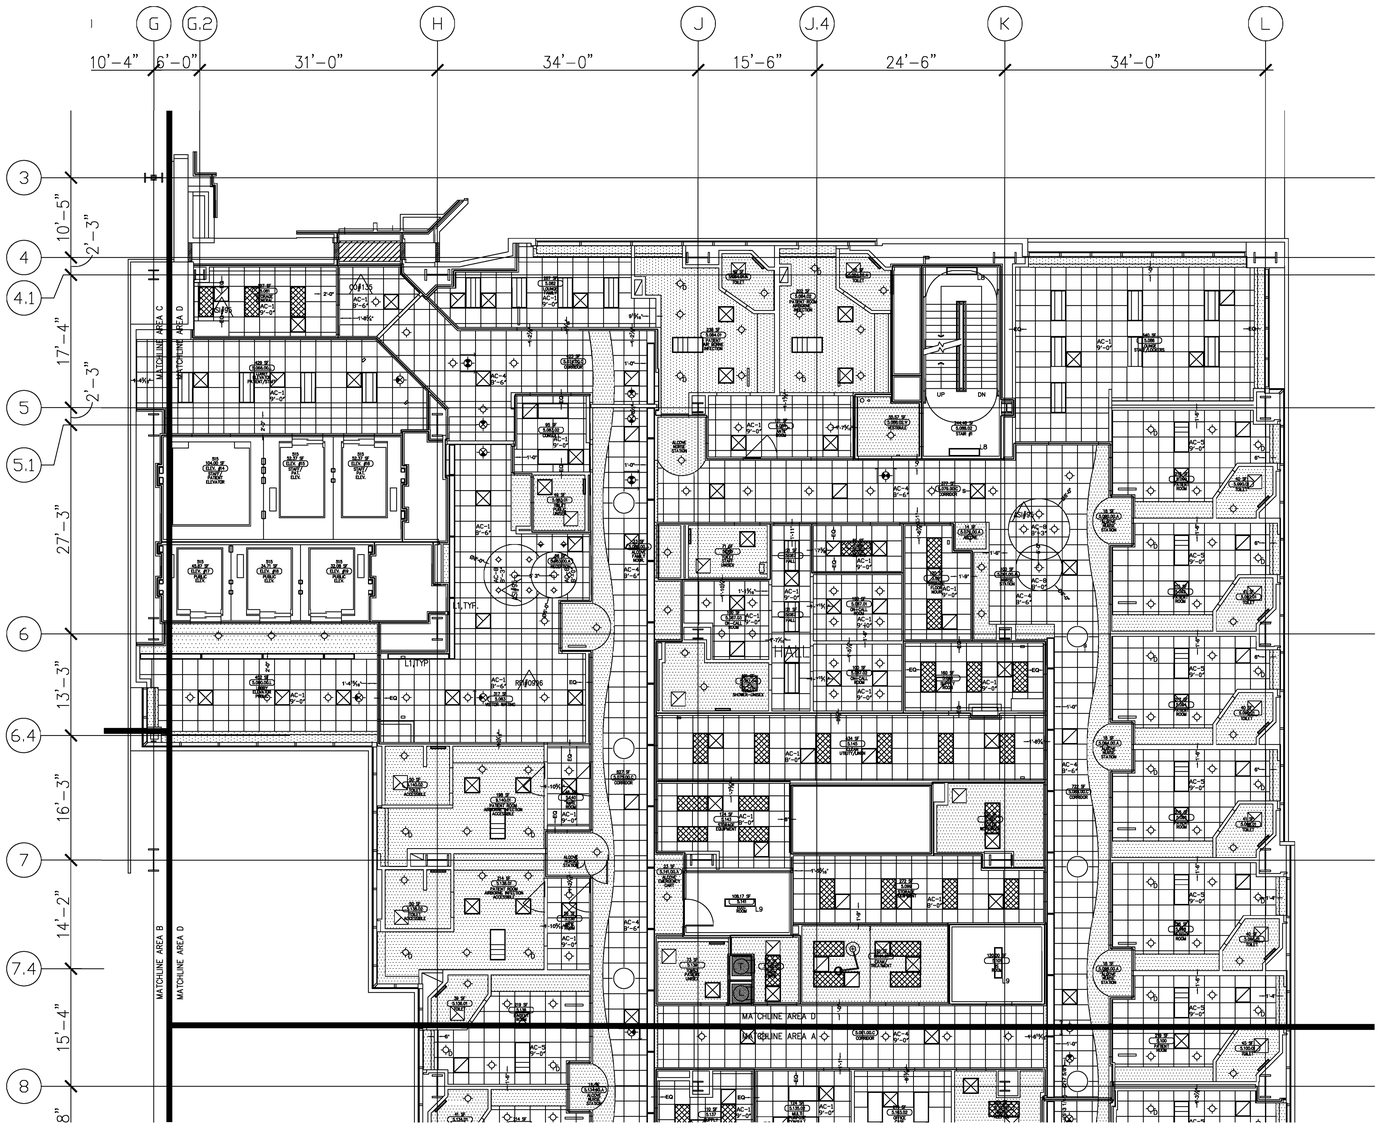

S—SLIP JOINT

AC-1 ARMSTRONG 3251 OPTIMA OPEN PLAN 2x2 CEILING TILE.
INSTALLED IN ARMSTRONG SUPRAFINE 9/16" GRID.

AC-2 ARMSTRONG 1720 CLEAN ROOM MYLAR 2x2 CEILING TILE.
INSTALLED IN ARMSTRONG CLEAN ROOM 15/16" GRID.

AC-4 ARMSTRONG 589 CIRRUS 2x2 CEILING TILE.
INSTALLED IN ARMSTRONG SUPRAFINE 9/16" GRID.

AC-5 ARMSTRONG 1935 HEALTHZONE ULTIMA 2x2 CEILING TILE.
INSTALLED IN ARMSTRONG PRELUDE 15/16" GRID.

AC-6 DECOUSTICS CLARO 4x4 CEILING TILE.
INSTALLED IN CEILENCIO TORSION SPRING GRID.

AC-7 DECOUSTICS CLARO CEILING TILE (CUSTOM SIZE).
INSTALLED IN CEILENCIO TORSION SPRING GRID.

AC-8 ARMSTRONG 3152 OPTIMA OPEN PLAN 2x2 CEILING TILE.
INSTALLED IN ARMSTRONG PRELUDE 15/16" GRID.

AC-9 ARMSTRONG 869 CLEAN ROOM VL PERFORATED 2x2 CEILING TILE.
INSTALLED IN ARMSTRONG PRELUDE 15/16" GRID.

Issue Date:

Revisions		
No.	Date	Description
	08-05-10	FOR SUBMITTAL
1	03-07-11	ADDED DIMENSIONS FOR GRID LOCATIONS
		APPLIED NEW ARCH. BACKGROUND
2	06-29-11	REVISED FINISH SCHEDULE
3	07-16-12	ADDED SLIP JOINT LOCATIONS FOR RECORD

Architect's Approval

Contractor's Approval

Key Plan

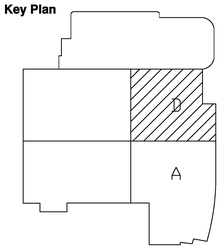

CHILDREN'S HOSPITAL OF ORANGE COUNTY TOWER II PROJECT

455 S. MAIN St. ORANGE, CA 92868

MARTIN INTEGRATED
2330 N. Pacific Street, Orange, CA. 92865
Phone 714.998.9100 Fax 714.998.1414
Lic. # 566629
www.martinintegrated.com

Project Number: MIS#7874/MCCARTHY#7453

Sheet Title:

LEVEL 5/AREA D REFLECTIVE CEILING PLAN

Scale: 1/8" = 1' 0"

Reference Sheet Number: INCREMENT #7 A4.5D

Building:

Sheet Number: MIS-4.5D

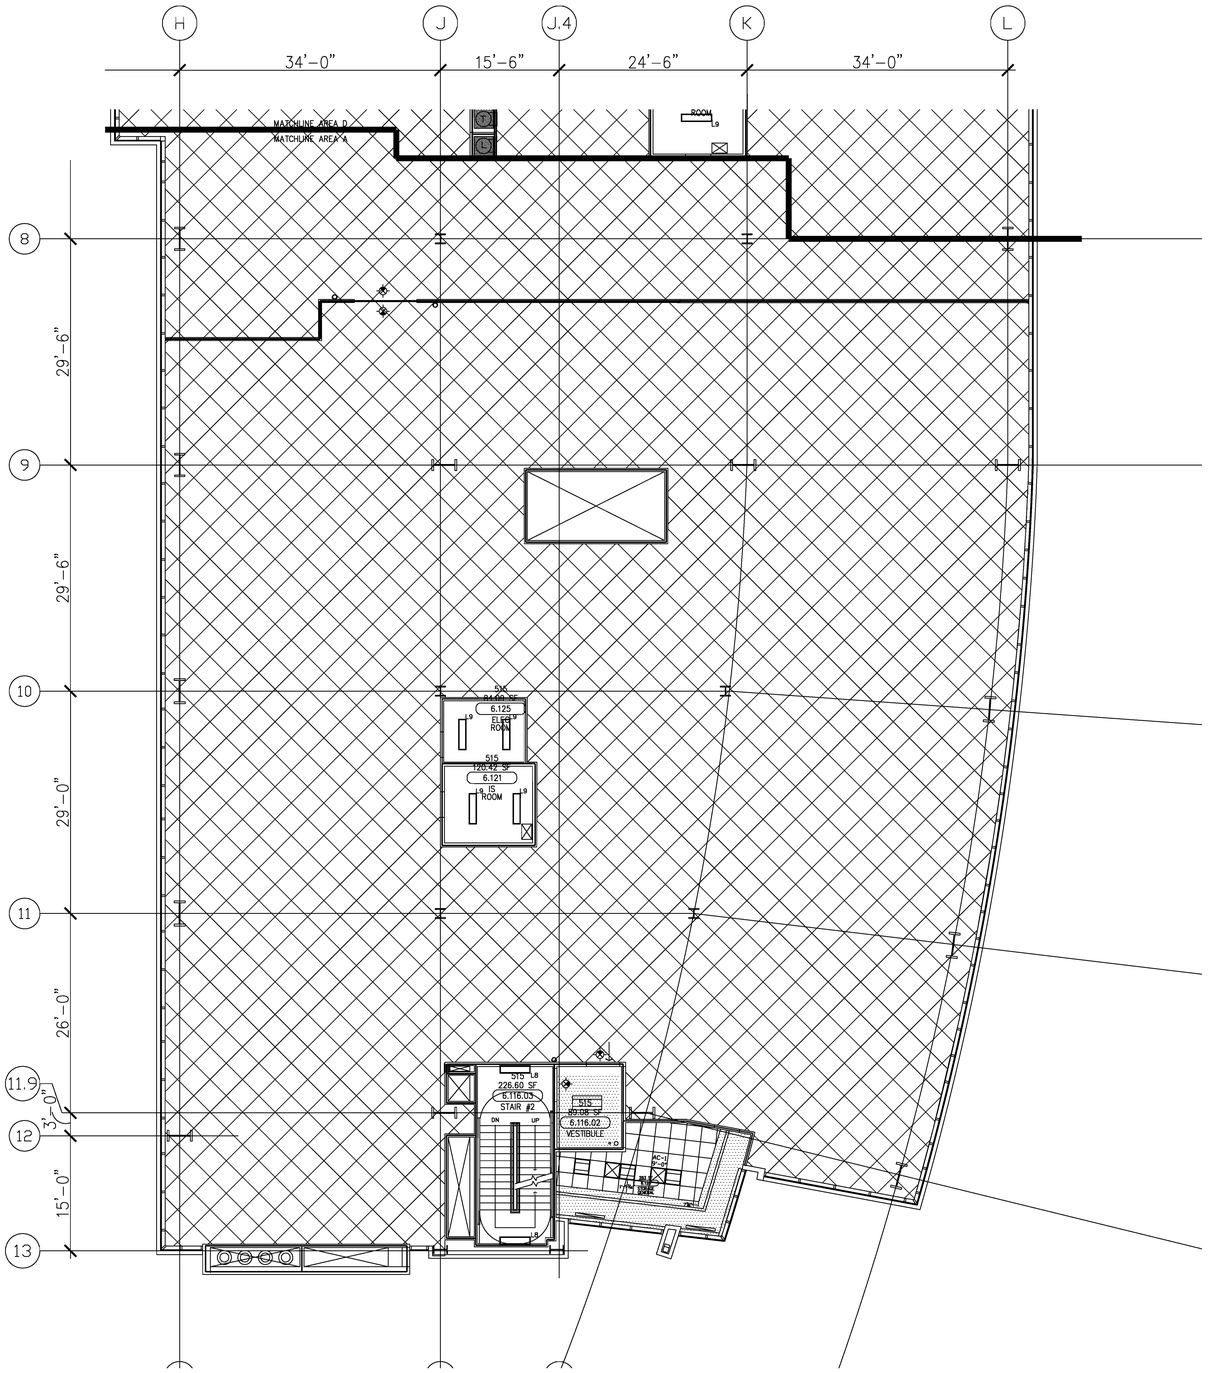
H
J
J.4
K
L
34'-0"
15'-6"
24'-6"
34'-0"
MATCHLINE AREA D
MATCHLINE AREA A
ROOM L9
8
9
10
11
11.9
12
13
29'-6"
29'-6"
29'-0"
26'-0"
3'-0"
15'-0"
515
226.60 SF
6.116.03
STAIR #2
DN
UP
L9
515
89.06 SF
6.116.02
VESTIBULE
AC-1
AC-1
AC-1

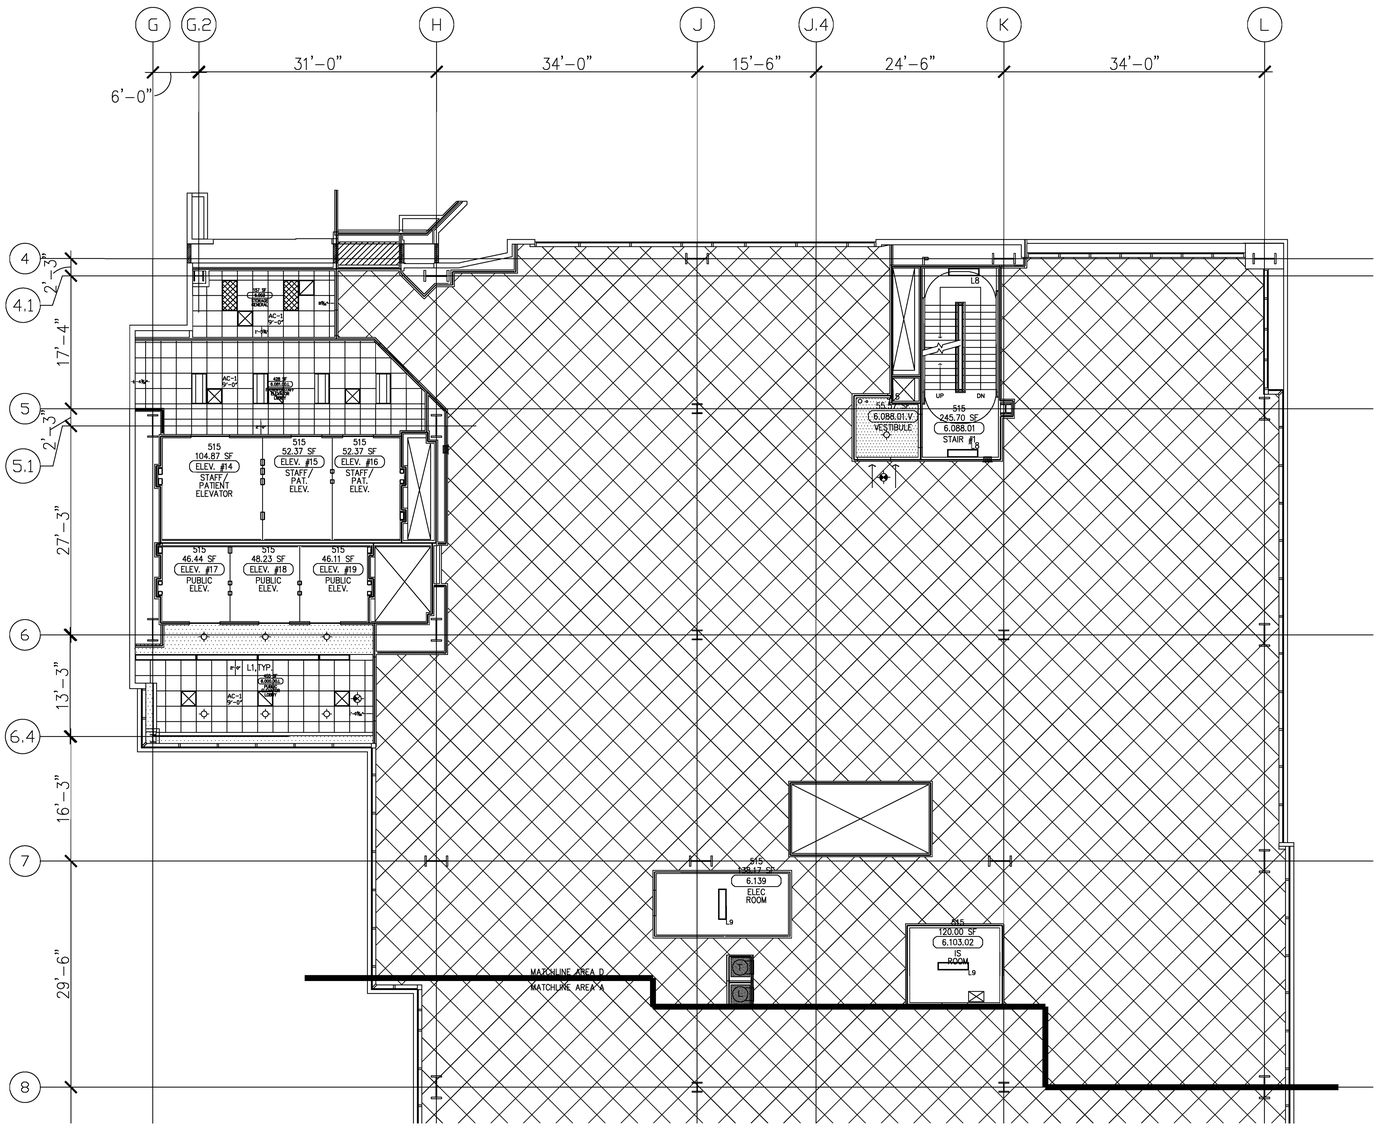

AC-1 ARMSTRONG 3251 OPTIMA OPEN PLAN 2x2 CEILING TILE.
INSTALLED IN ARMSTRONG SUPRAFINE 9/16" GRID.

AC-2 ARMSTRONG 1720 CLEAN ROOM MYLAR 2x2 CEILING TILE.
INSTALLED IN ARMSTRONG CLEAN ROOM 15/16" GRID.

AC-4 ARMSTRONG 589 CIRRUS 2x2 CEILING TILE.
INSTALLED IN ARMSTRONG SUPRAFINE 9/16" GRID.

AC-5 ARMSTRONG 1935 HEALTHZONE ULTIMA 2x2 CEILING TILE.
INSTALLED IN ARMSTRONG PRELUDE 15/16" GRID.

AC-6 DECOUSTICS CLARO 4x4 CEILING TILE.
INSTALLED IN CEILENCIO TORSION SPRING GRID.

AC-7 DECOUSTICS CLARO CEILING TILE (CUSTOM SIZE).
INSTALLED IN CEILENCIO TORSION SPRING GRID.

AC-8 ARMSTRONG 3152 OPTIMA OPEN PLAN 2x2 CEILING TILE.
INSTALLED IN ARMSTRONG PRELUDE 15/16" GRID.

AC-9 ARMSTRONG 869 CLEAN ROOM VL PERFORATED 2x2 CEILING TILE.
INSTALLED IN ARMSTRONG PRELUDE 15/16" GRID.

Issue Date:

Revisions		
No.	Date	Description
	08-05-10	FOR SUBMITTAL
1	02-22-11	ADDED DIMENSIONS FOR GRID LOCATIONS
2	06-29-11	REVISED FINISH SCHEDULE

Architect's Approval

Contractor's Approval

Key Plan

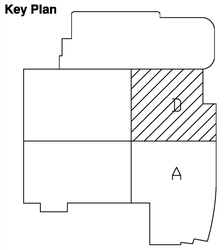

CHILDREN'S HOSPITAL
OF ORANGE COUNTY
TOWER II PROJECT

455 S. MAIN St.
ORANGE, CA 92868

MARTIN INTEGRATED
2330 N. Pacific Street, Orange, CA. 92865
Phone 714.998.9100 Fax 714.998.1414
Lic. # 566629
www.martinintegrated.com

Project Number: MIS#7874/MCCARTHY#7453

Sheet Title:
LEVEL 6/AREA D
REFLECTIVE CEILING PLAN

Scale: 1/8" = 1' 0"

Reference Sheet Number:
INCREMENT #7 A4.6D

Building:

Sheet Number:
MIS-4.6D

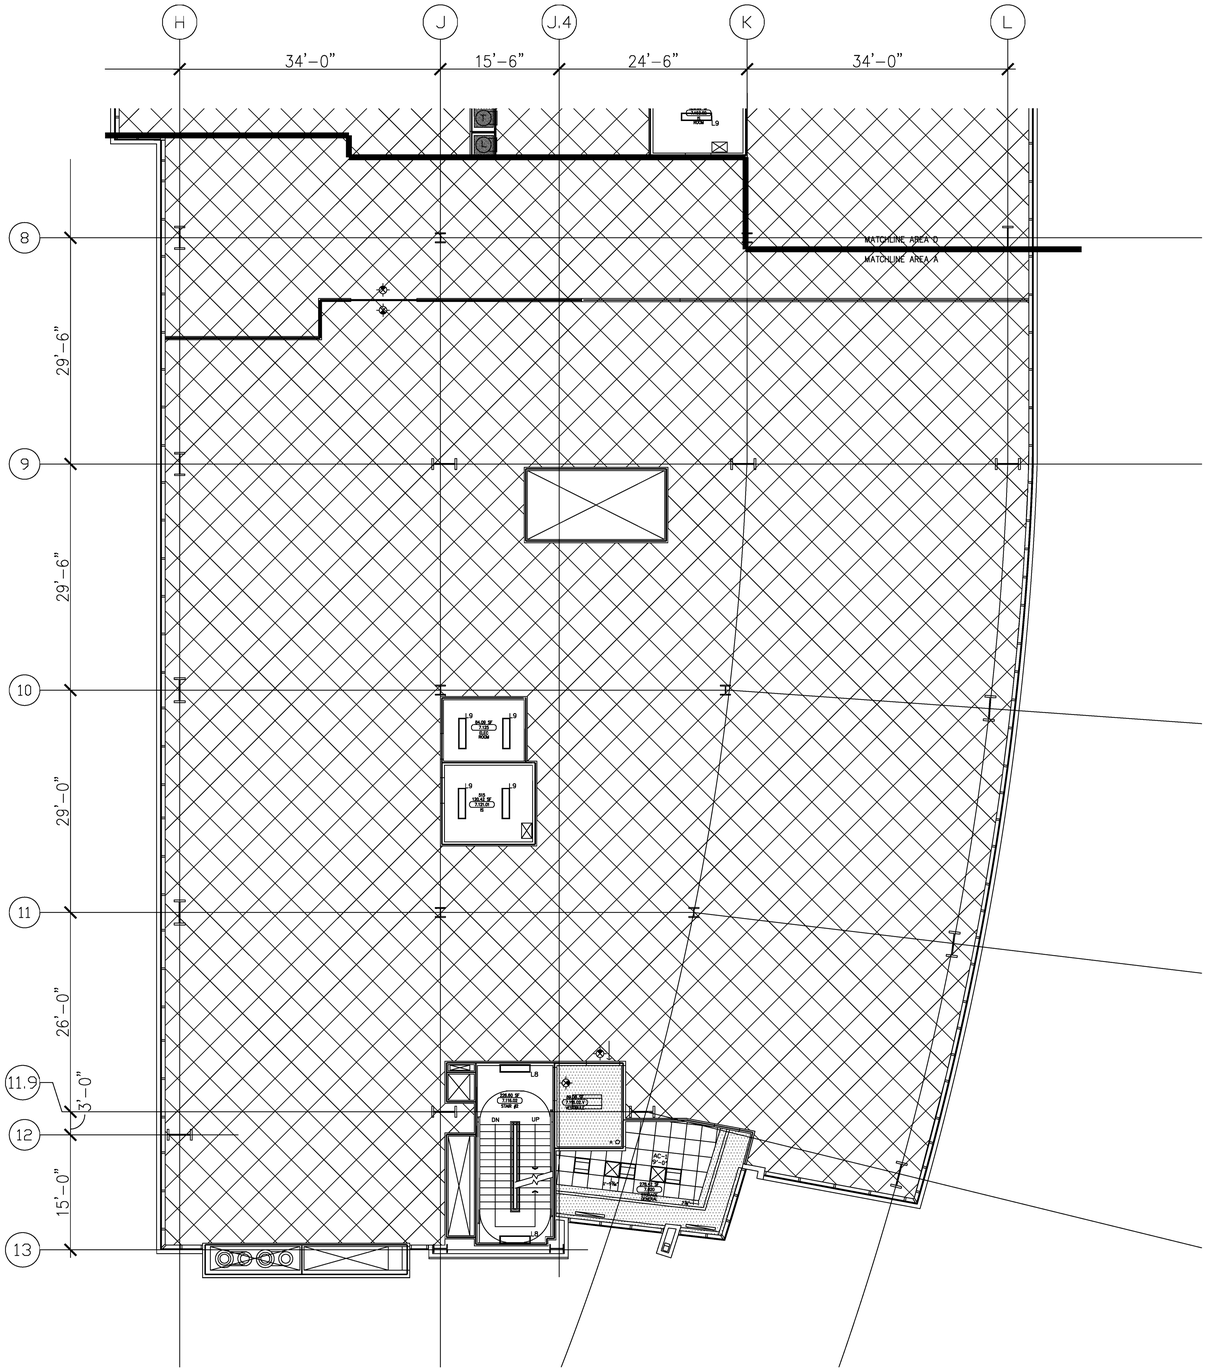

AC-1 ARMSTRONG 3251 OPTIMA OPEN PLAN 2x2 CEILING TILE.
INSTALLED IN ARMSTRONG SUPRAFINE 9/16" GRID.

AC-2 ARMSTRONG 1720 CLEAN ROOM MYLAR 2x2 CEILING TILE.
INSTALLED IN ARMSTRONG CLEAN ROOM 15/16" GRID.

AC-4 ARMSTRONG 589 CIRRUS 2x2 CEILING TILE.
INSTALLED IN ARMSTRONG SUPRAFINE 9/16" GRID.

AC-5 ARMSTRONG 1935 HEALTHZONE ULTIMA 2x2 CEILING TILE.
INSTALLED IN ARMSTRONG PRELUDE 15/16" GRID.

AC-6 DECOUSTICS CLARD 4x4 CEILING TILE.
INSTALLED IN CEILENCIO TORSION SPRING GRID.

AC-7 DECOUSTICS CLARD CEILING TILE (CUSTOM SIZE).
INSTALLED IN CEILENCIO TORSION SPRING GRID.

AC-8 ARMSTRONG 3152 OPTIMA OPEN PLAN 2x2 CEILING TILE.
INSTALLED IN ARMSTRONG PRELUDE 15/16" GRID.

AC-9 ARMSTRONG 869 CLEAN ROOM VL PERFORATED 2x2 CEILING TILE.
INSTALLED IN ARMSTRONG PRELUDE 15/16" GRID.

Issue Date:

Revisions

No.	Date	Description
	08-05-10	FOR SUBMITTAL
1	02-22-11	ADDED DIMENSIONS FOR GRID LOCATIONS
2	06-29-11	REVISED FINISH SCHEDULE

Architect's Approval

Contractor's Approval

Key Plan

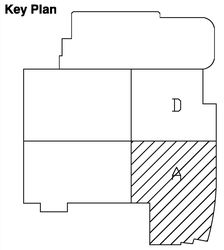

CHILDREN'S HOSPITAL
OF ORANGE COUNTY
TOWER II PROJECT

455 S. MAIN St.
ORANGE, CA 92868

MARTIN INTEGRATED
2330 N. Pacific Street, Orange, CA. 92865
Phone 714.998.9100 Fax 714.998.1414
Lic. # 566629
www.martinintegrated.com

Project Number:
MIS#7874/MCCARTHY#7453

Sheet Title:

LEVEL 7/AREA A
REFLECTIVE CEILING PLAN

Scale: 1/8" = 1' 0"

Reference Sheet Number:
INCREMENT #7 A4.7A

Building:

Sheet Number:
MIS-4.7A

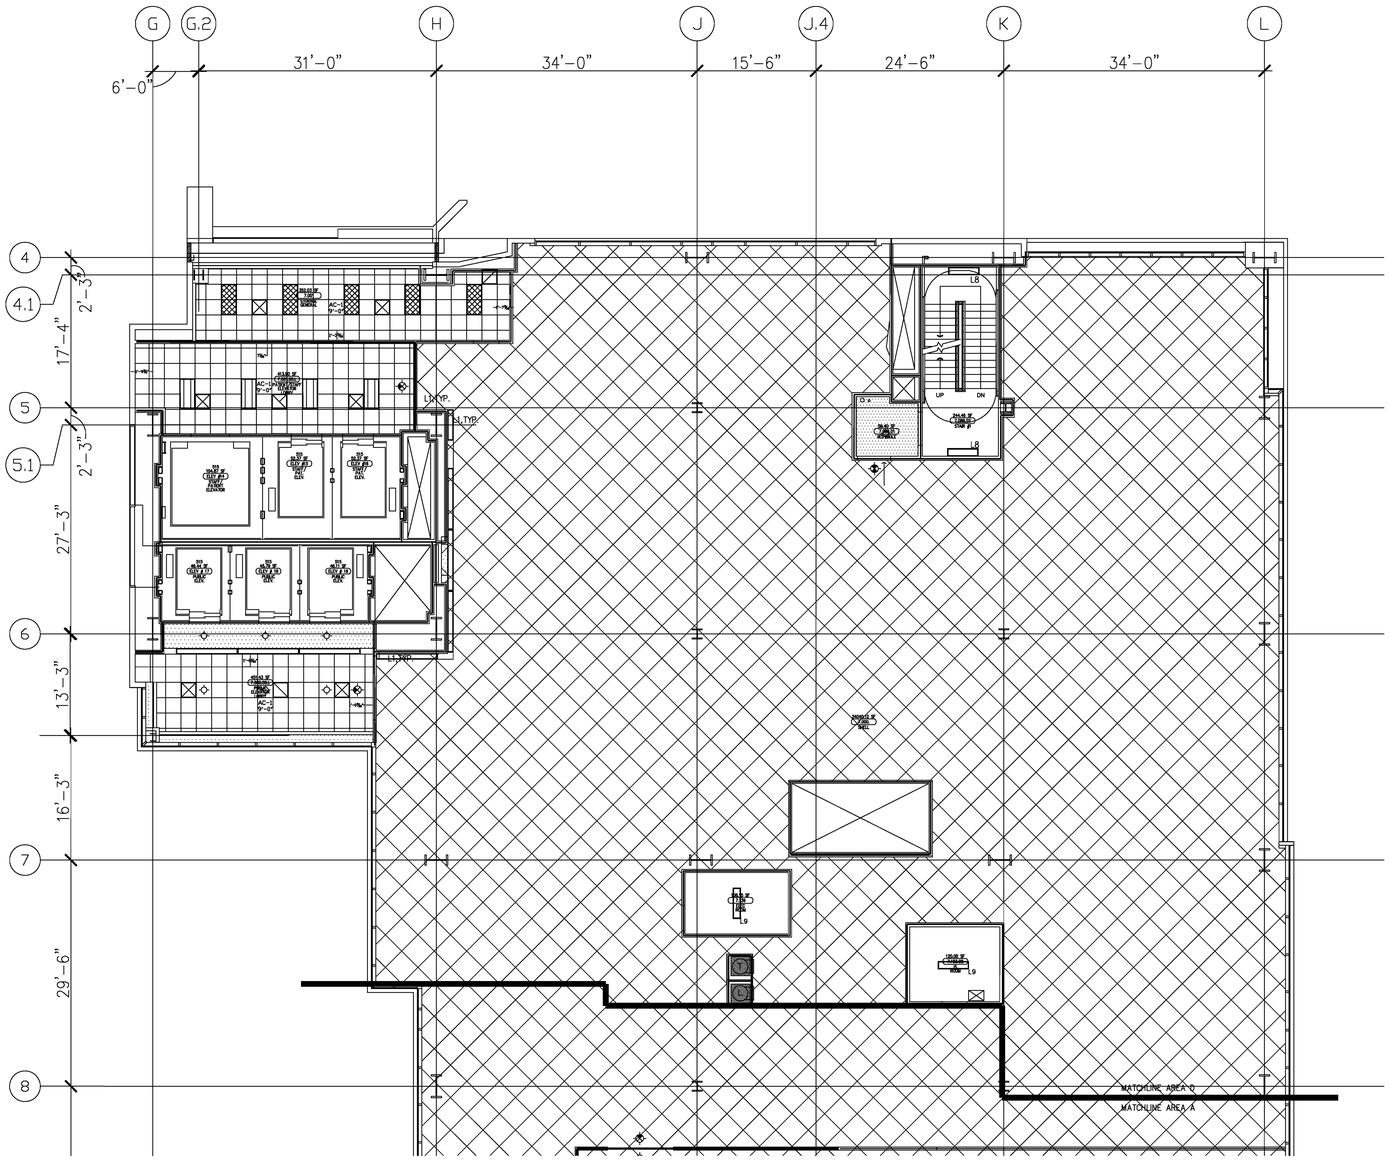

AC-1 ARMSTRONG 3251 OPTIMA OPEN PLAN 2x2 CEILING TILE.
INSTALLED IN ARMSTRONG SUPRAFINE 9/16" GRID.

AC-2 ARMSTRONG 1720 CLEAN ROOM MYLAR 2x2 CEILING TILE.
INSTALLED IN ARMSTRONG CLEAN ROOM 15/16" GRID.

AC-4 ARMSTRONG 589 CIRRUS 2x2 CEILING TILE.
INSTALLED IN ARMSTRONG SUPRAFINE 9/16" GRID.

AC-5 ARMSTRONG 1935 HEALTHZONE ULTIMA 2x2 CEILING TILE.
INSTALLED IN ARMSTRONG PRELUDE 15/16" GRID.

AC-6 DECOUSTICS CLARD 4x4 CEILING TILE.
INSTALLED IN CEILENCIO TORSION SPRING GRID.

AC-7 DECOUSTICS CLARD CEILING TILE (CUSTOM SIZE).
INSTALLED IN CEILENCIO TORSION SPRING GRID.

AC-8 ARMSTRONG 3152 OPTIMA OPEN PLAN 2x2 CEILING TILE.
INSTALLED IN ARMSTRONG PRELUDE 15/16" GRID.

AC-9 ARMSTRONG 869 CLEAN ROOM VL PERFORATED 2x2 CEILING TILE.
INSTALLED IN ARMSTRONG PRELUDE 15/16" GRID.

Issue Date:		
Revisions		
No.	Date	Description
	08-05-10	FOR SUBMITTAL
1	02-22-11	ADDED DIMENSIONS FOR GRID LOCATIONS
2	06-29-11	REVISED FINISH SCHEDULE

Architect's Approval

Contractor's Approval

Key Plan

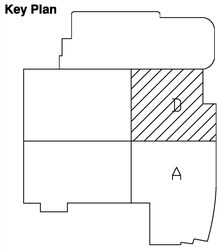

CHILDREN'S HOSPITAL OF ORANGE COUNTY TOWER II PROJECT

455 S. MAIN St. ORANGE, CA 92868

MARTIN INTEGRATED
2330 N. Pacific Street, Orange, CA. 92865
Phone 714.998.9100 Fax 714.998.1414
Lic. # 566629
www.martinintegrated.com

Project Number: MIS#7874/MCCARTHY#7453

Sheet Title:

LEVEL 7/AREA D
REFLECTIVE CEILING PLAN

Scale: 1/8" = 1' 0"

Reference Sheet Number: INCREMENT #7 A4.7D

Building:

Sheet Number: MIS-4.7D