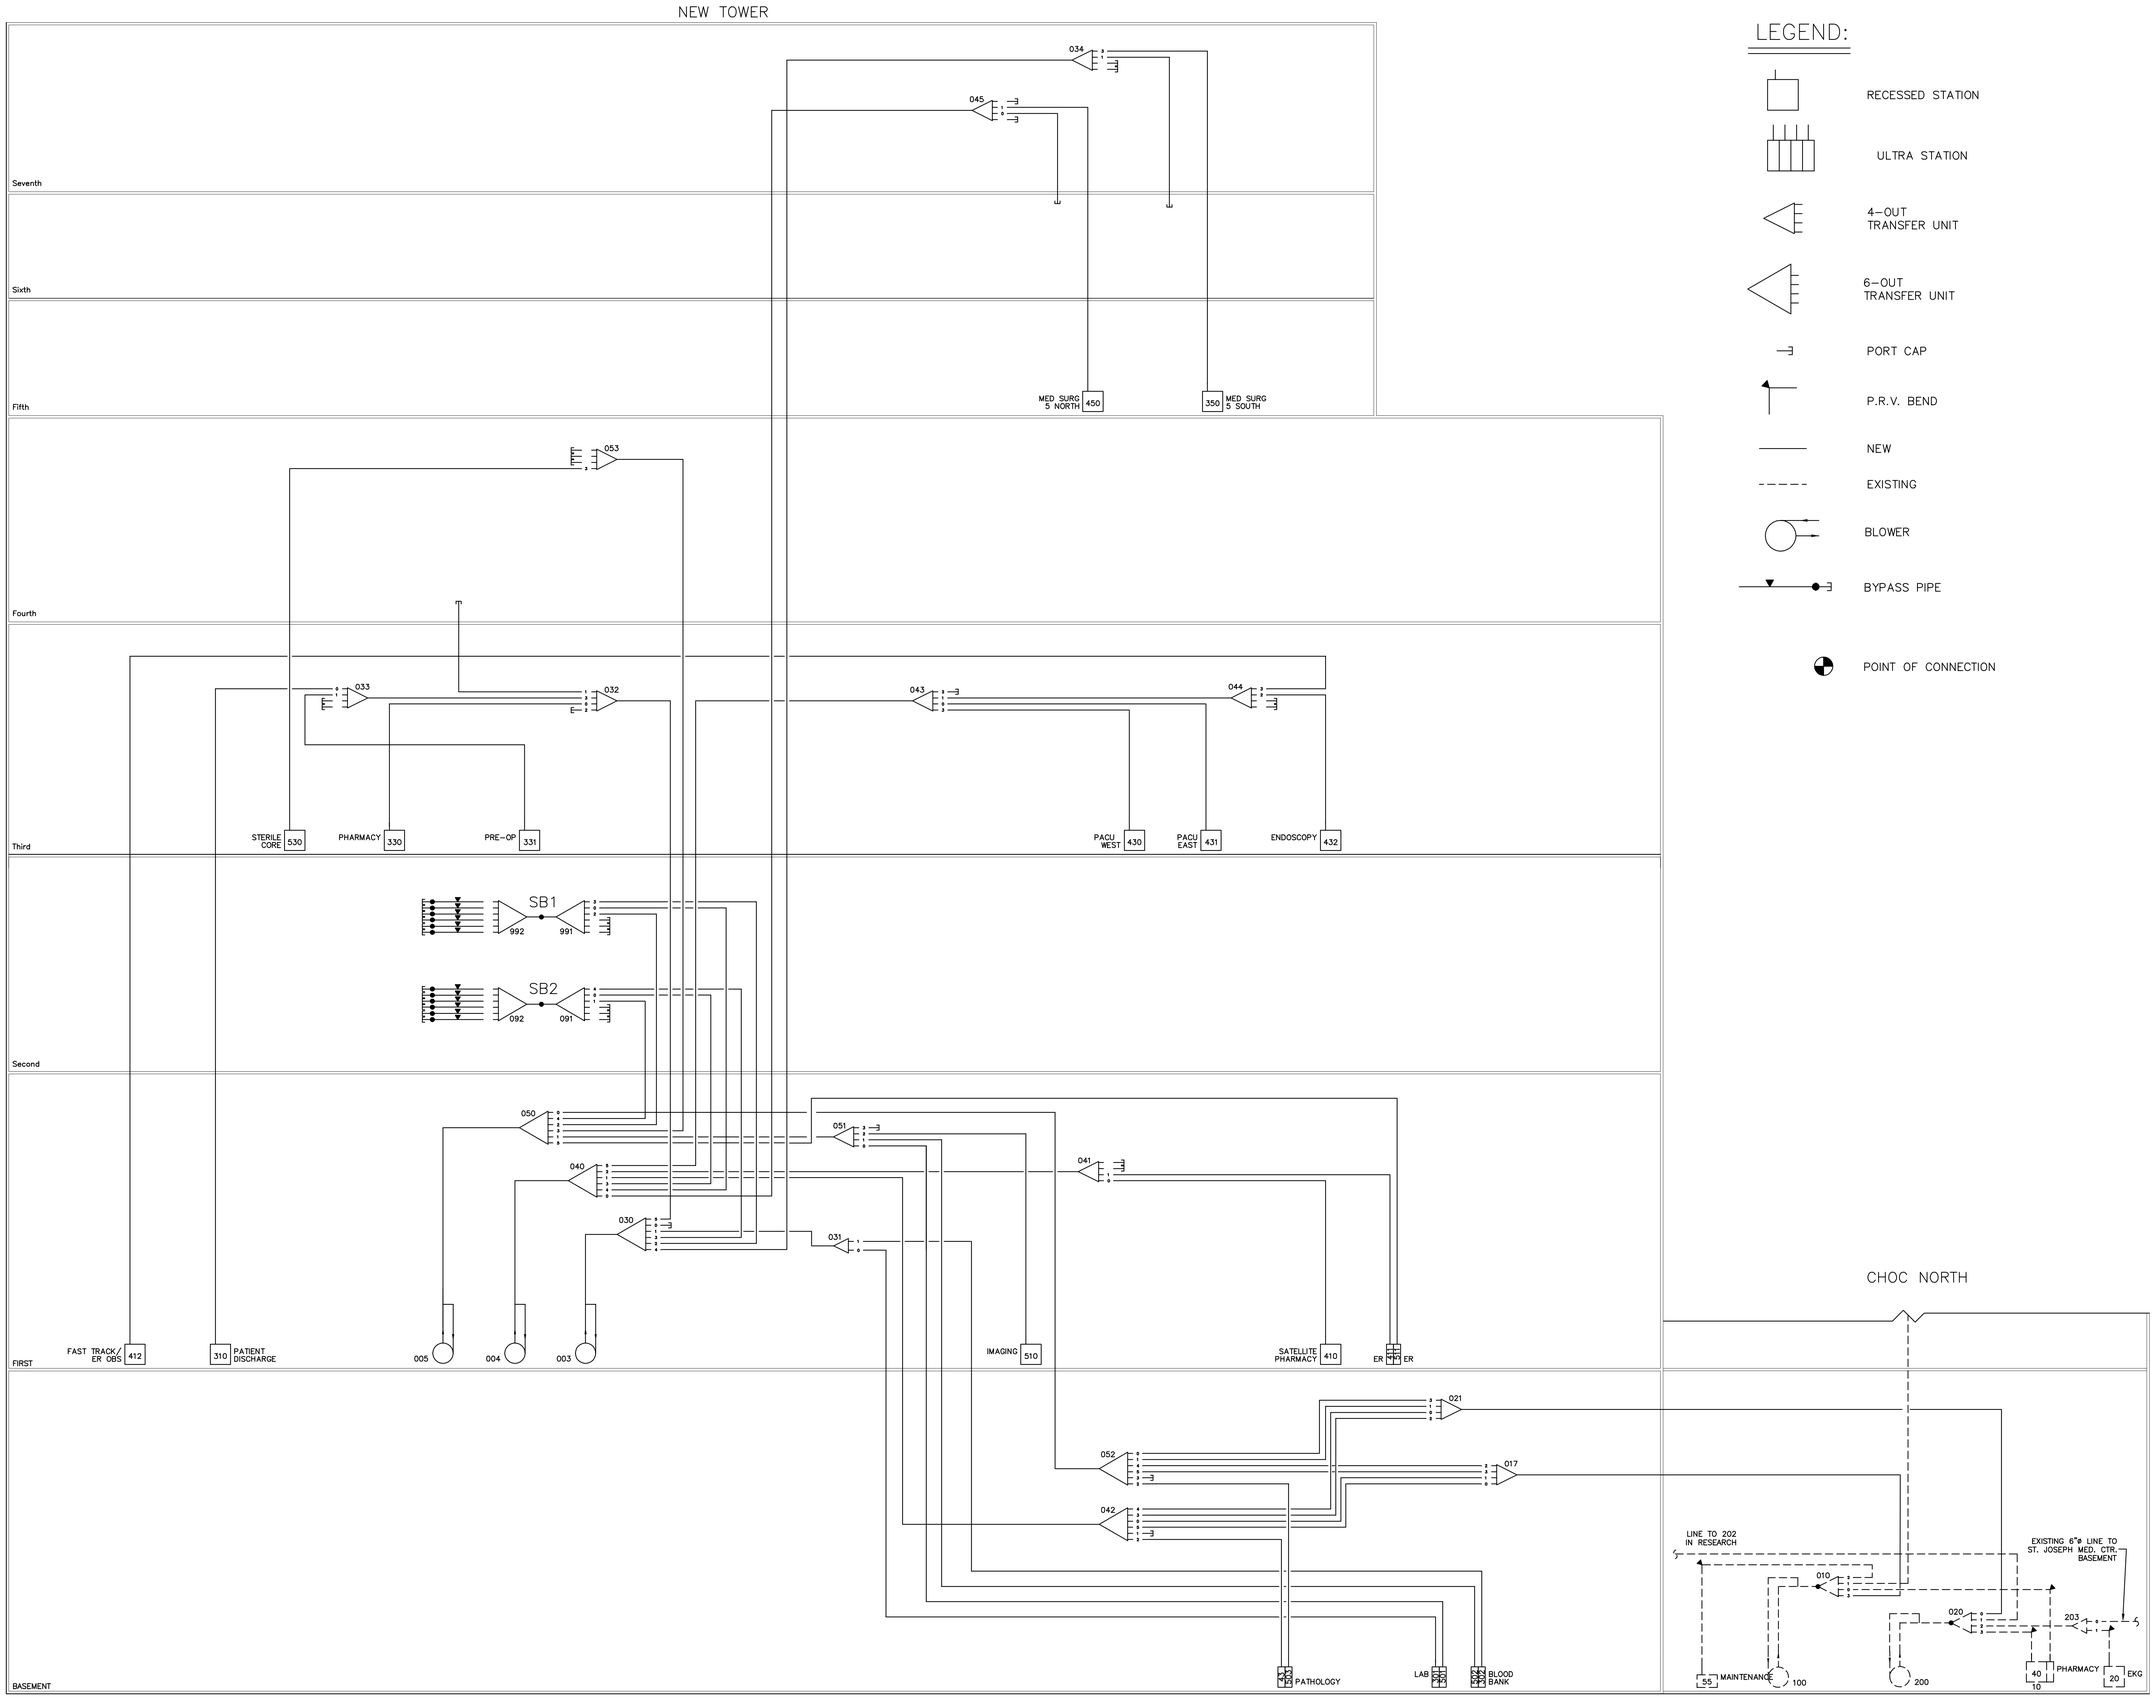

LEGEND:

- RECESSED STATION
- ULTRA STATION
- 4–OUT TRANSFER UNIT
- 6–OUT TRANSFER UNIT
- PORT CAP
- P.R.V. BEND
- NEW
- EXISTING
- BLOWER
- BYPASS PIPE
- POINT OF CONNECTION

swisslog TRANSLOGIC

17822 E. 17th Street, Suite 402
Tustin, California 92780
Phone (800) 525–1841
Fax (714) 731–2037

As instruments of service, all designs, ideas, and information shown on these drawings are and shall remain the property of Swisslog – Translogic. No part thereof shall be copied, disclosed to others, or used in connection with any work or project other than the specific project for which they have been prepared and developed without the written consent of Swisslog – Translogic. Visual contact with these drawings shall constitute conclusive evidence of acceptance of these restrictions.

PROJECT INFORMATION:

CHILDREN'S HOSPITAL OF ORANGE COUNTY
455 S. MAIN STREET
ORANGE, CA 92668

STRUCTURAL ENGINEER:

ELECTRICAL ENGINEER:

LICENSE & APPROVAL STAMPS:

REVISIONS:

05/04/12	–	AS–BUILTS PER K03390	EA

OSHPD PROJECT NO.

TRANSLOGIC PROJECT NO. K03390

KEY PLAN

SCALE:	1/16"=1'–0"	OFFICE:	TUSTIN
DRAWN BY:	JA	CHECKED BY:	GN
DATE:	08/26/10		

CTS–630 MATRIX ESP

MECHANICAL RISER DIAGRAM

SHEET NO. PT–1.00