


ARCHITECT OF RECORD
Paul C. Gloriod

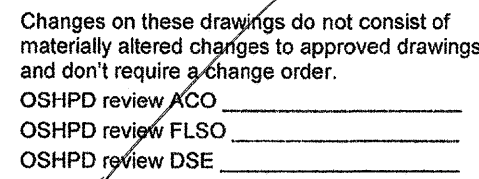

162	08/08/11	CO #135
317	08/22/11	CO #247
329	09/19/11	CO #257
545	12/19/11	CO #271
499	04/23/12	CO #357

OSH/PD/FDD-Field Review Tracking

Project: _____

PAD: 2012-04063

ACO: 4/23/12

Architectural	A	AC	D	X	Refer
Mechanical	A	AC	D	X	Refer
Electrical	A	AC	D	X	Refer

DSE: 4/23/12

Structure	A	AC	D	R	Refer
-----------	---	----	---	---	-------

FLSO: 4/23/12

Fire Life Safety	A	AC	D	R	Refer
------------------	---	----	---	---	-------

Office of Statewide Health
Planning & Development FDD
REVIEWED IN ACCORDANCE WITH
THE REQUIREMENTS OF T24, CCR
APPROVER

CHANGE ORDER# 357
INSTRUCTION BULLETIN# _____
DEFERRED APPROVAL# _____
ADDENDUM _____

CHILDREN'S HOSPITAL
OF ORANGE COUNTY

455 S. Main St.
Orange, CA 92868-3874

TOWER II



12011.00
Increment #7

OSHPD - PROJECT NUMBER
IL 072072-30

ISSUE

DATE _____

SCAL

N.T.S.
DRAWING TITLE

SHEET INDEX VOLUME 2C

DRAWING NUMBER

A0.01.1

[illegible]