


FKP Architects

ARCHITECT OF RECORD  
Paul C. Gloriot

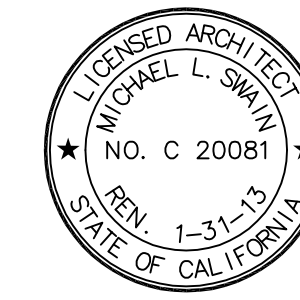


Changes on these drawings do not consist of  
materially altered changes to approved drawings  
and don't require a change order.  
OSHPD review ACO  
OSHPD review FLSO  
OSHPD review DSE

REVISIONS

16A	02/04/11	ASI #57
16N	03/01/11	CO #134
40A	12/02/11	ASI#144

APPROVAL

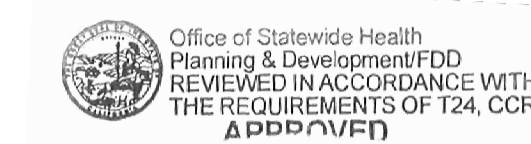

CHANGE ORDER  
INSTRUCTION BULLETIN  
DEFERRED APPROVAL  
1/10/2011

PROJECT NAME

CHILDREN'S HOSPITAL  
OF ORANGE COUNTY  
455 S. Main St.  
Orange, CA 92868-3874

TOWER II



PROJECT NUMBER

12011.00  
Increment #7

OSHPD - PROJECT NUMBER

IL 072072-30

ISSUE  
OSHPD PERMIT

DATE  
01/27/2010

SCALE

VARIES

DRAWING TITLE

INTERIOR SECTION  
DETAIL

DRAWING NUMBER

A10.1.1

