

FKP Architects

ARCHITECT OF RECORD
Paul C. Gloriot




Changes on these drawings do not constitute approval of drawings and do not require a change order.
OSHPD review ACO _____
OSHPD review FLSO _____
OSHPD review DSE _____

REVISIONS

180	05/09/11	CO #148
678	12/05/11	AS#129

APPROVAL

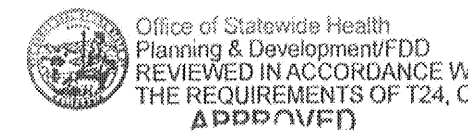

CHANGE ORDER/INSTRUCTION BULLETIN/DEFERRED APPROVAL/ORDINANCE

PROJECT NAME

CHILDREN'S HOSPITAL
OF ORANGE COUNTY

455 S. Main St.
Orange, CA 92668-3874

TOWER II

RECEIVED
Dec 13 2011
McCARTHY



PROJECT NUMBER

12011.00
Increment #7

OSHPD - PROJECT NUMBER

IL 072072-30

ISSUE

OSHPD PERMIT

DATE

01/27/2010

SCALE


VARIES

DRAWING TITLE


INTERIOR SECTION
DETAIL

DRAWING NUMBER


A10.1.3

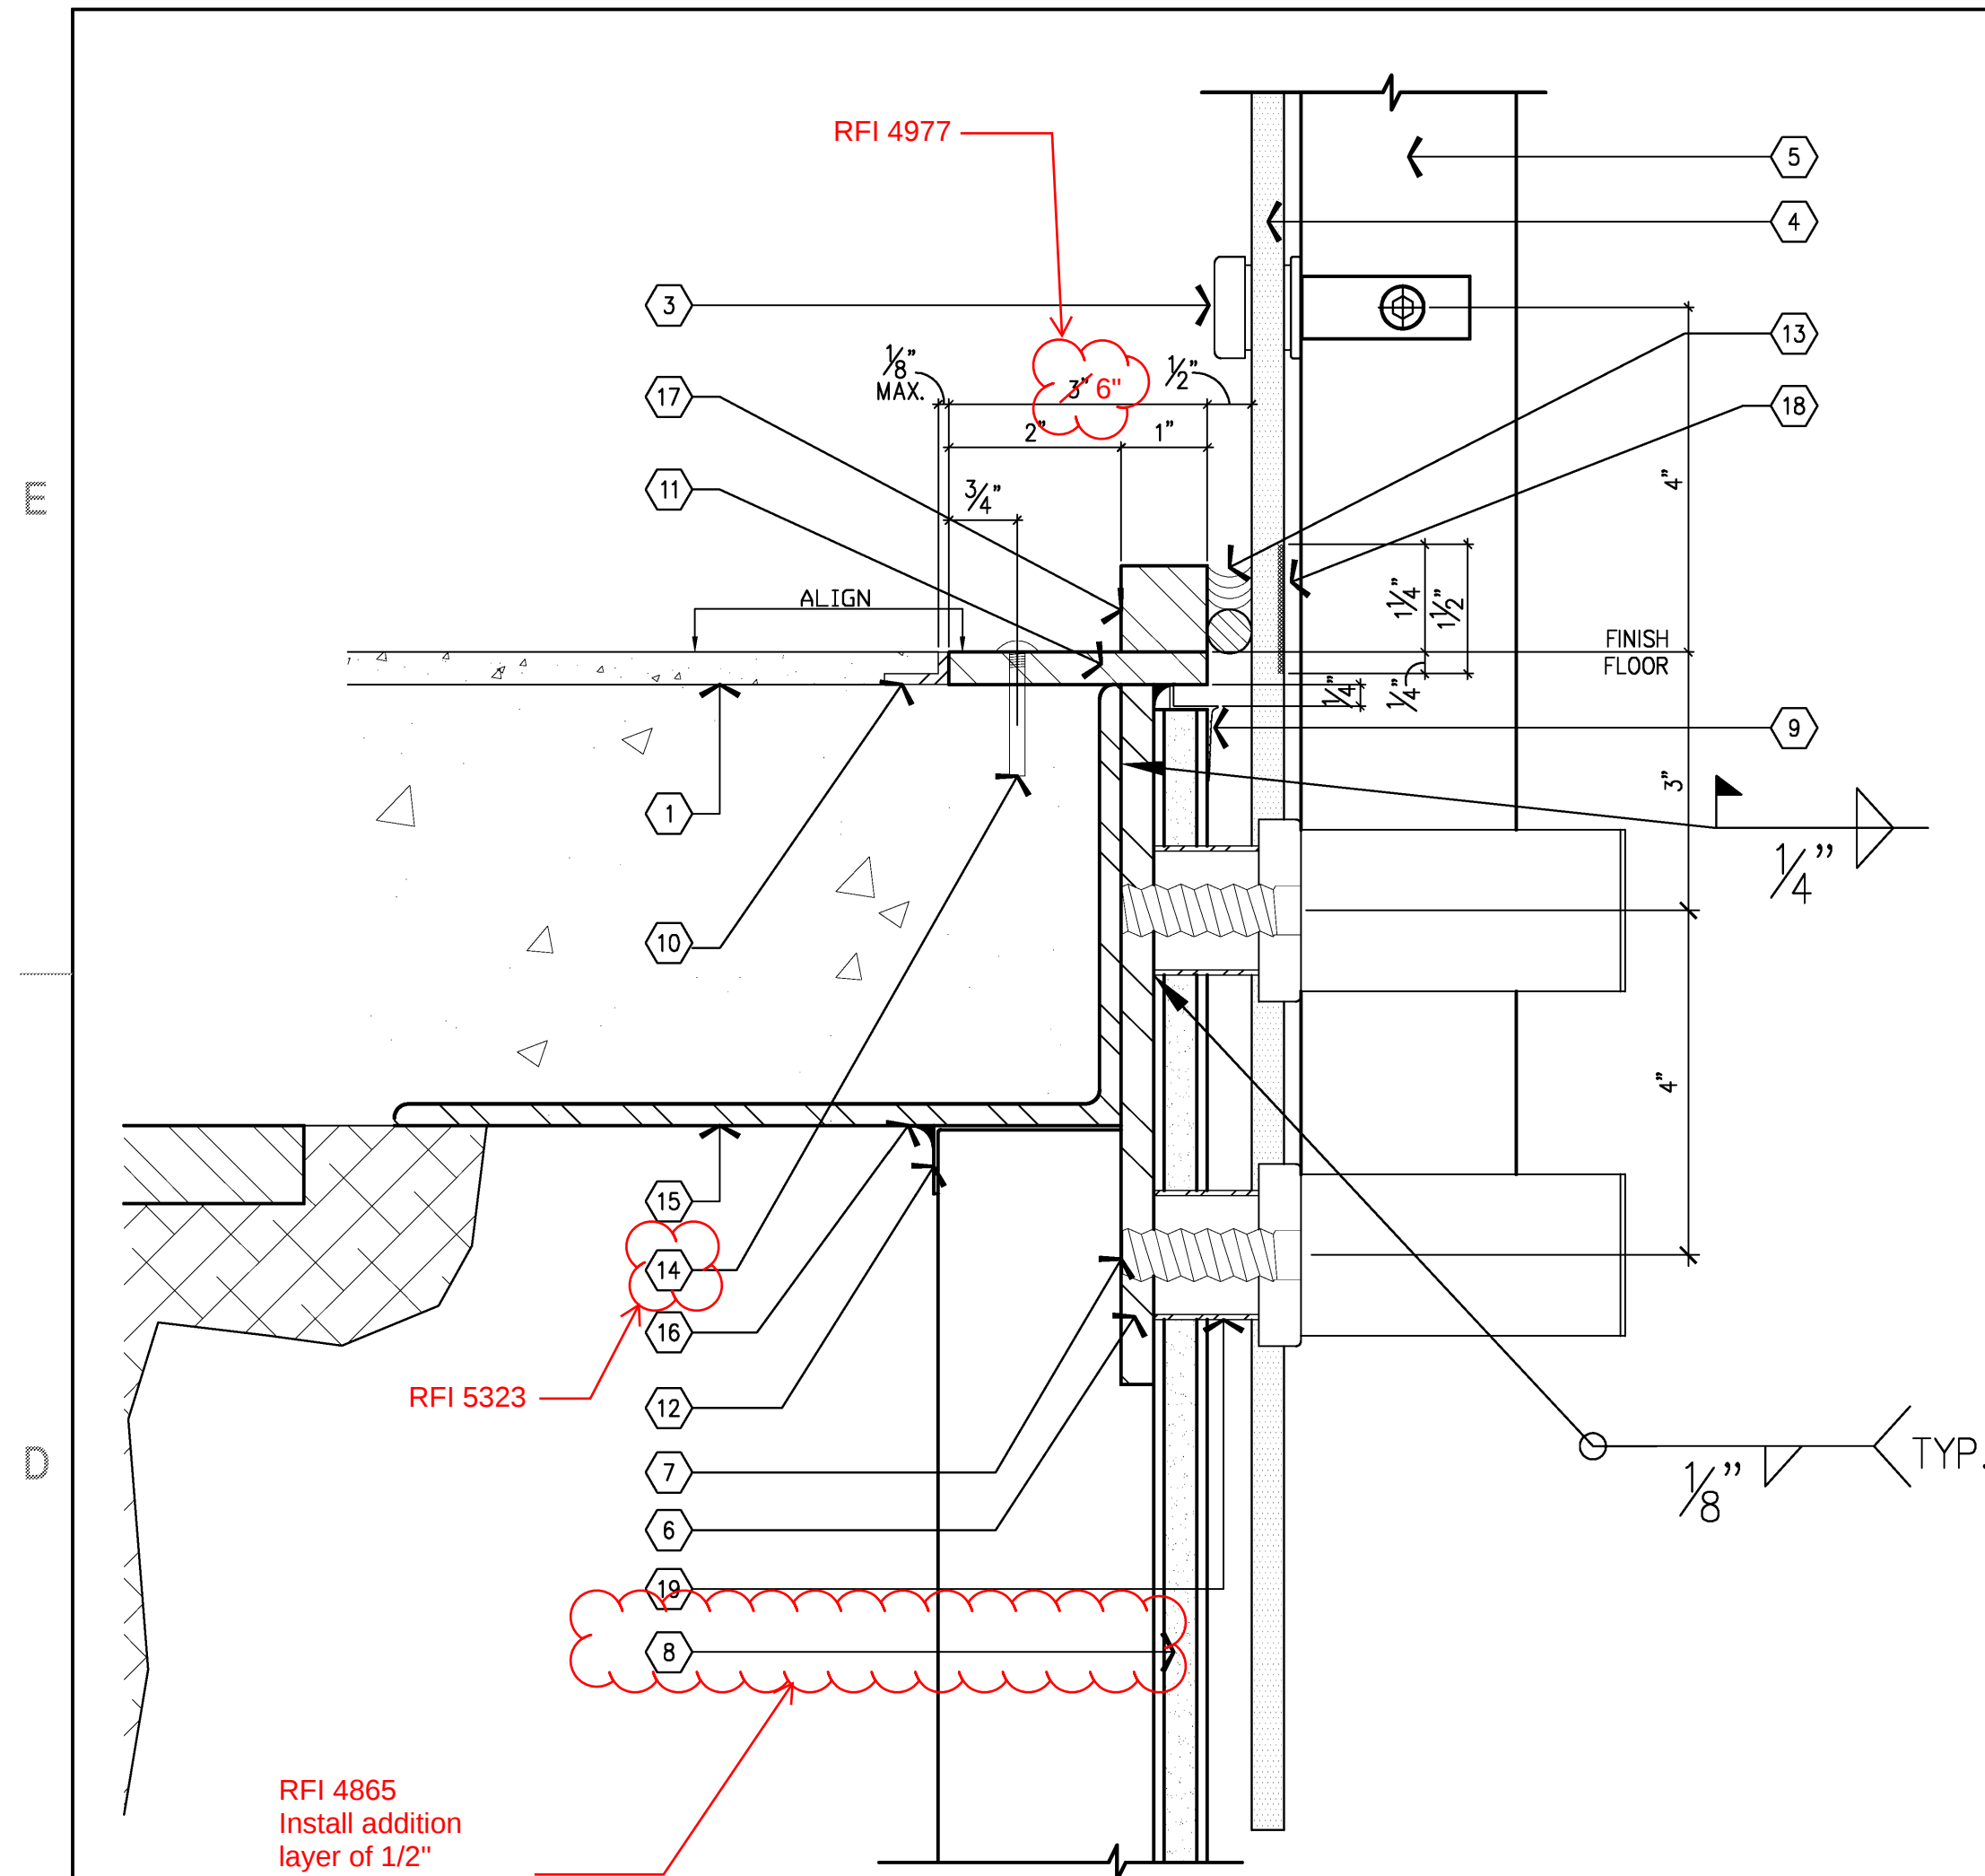


C5 ENLARG. DETAIL - GLASS HANDRAIL AT SLAB EDGE
8'-1'-0"

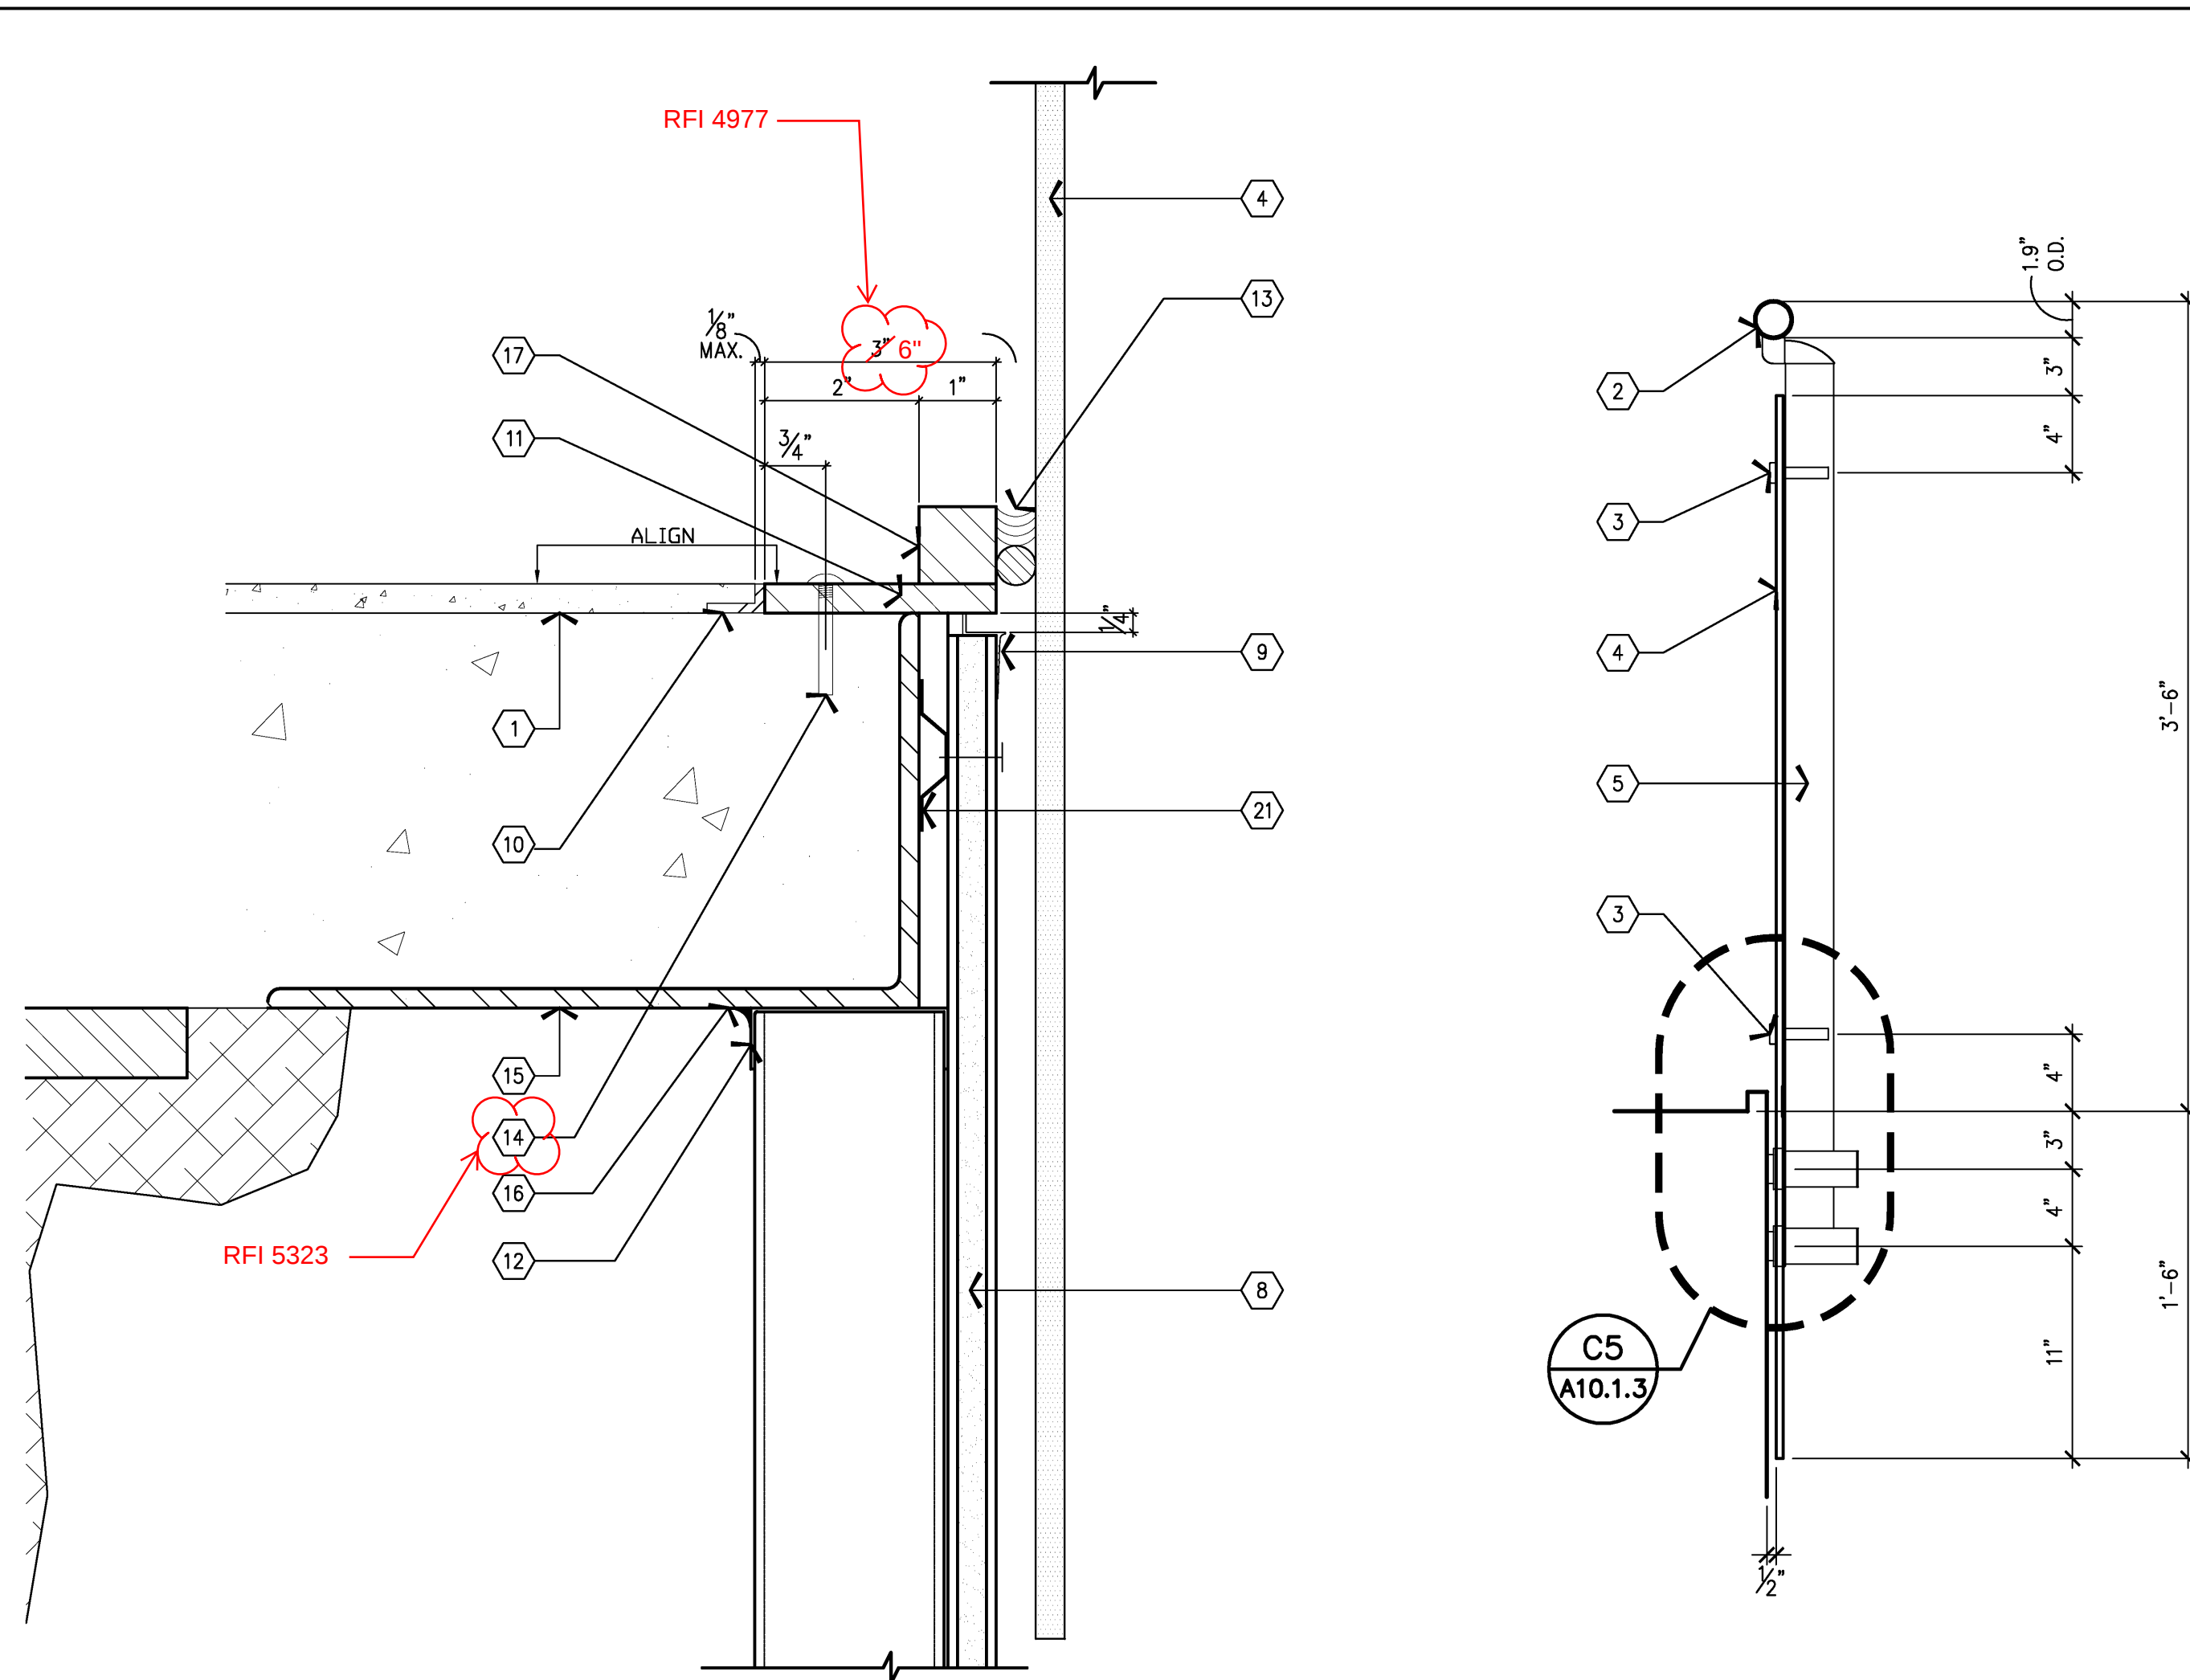


C4 ENLARG. DETAIL - SOFFIT FRAMING FURRDOWN
8'-1'-0"

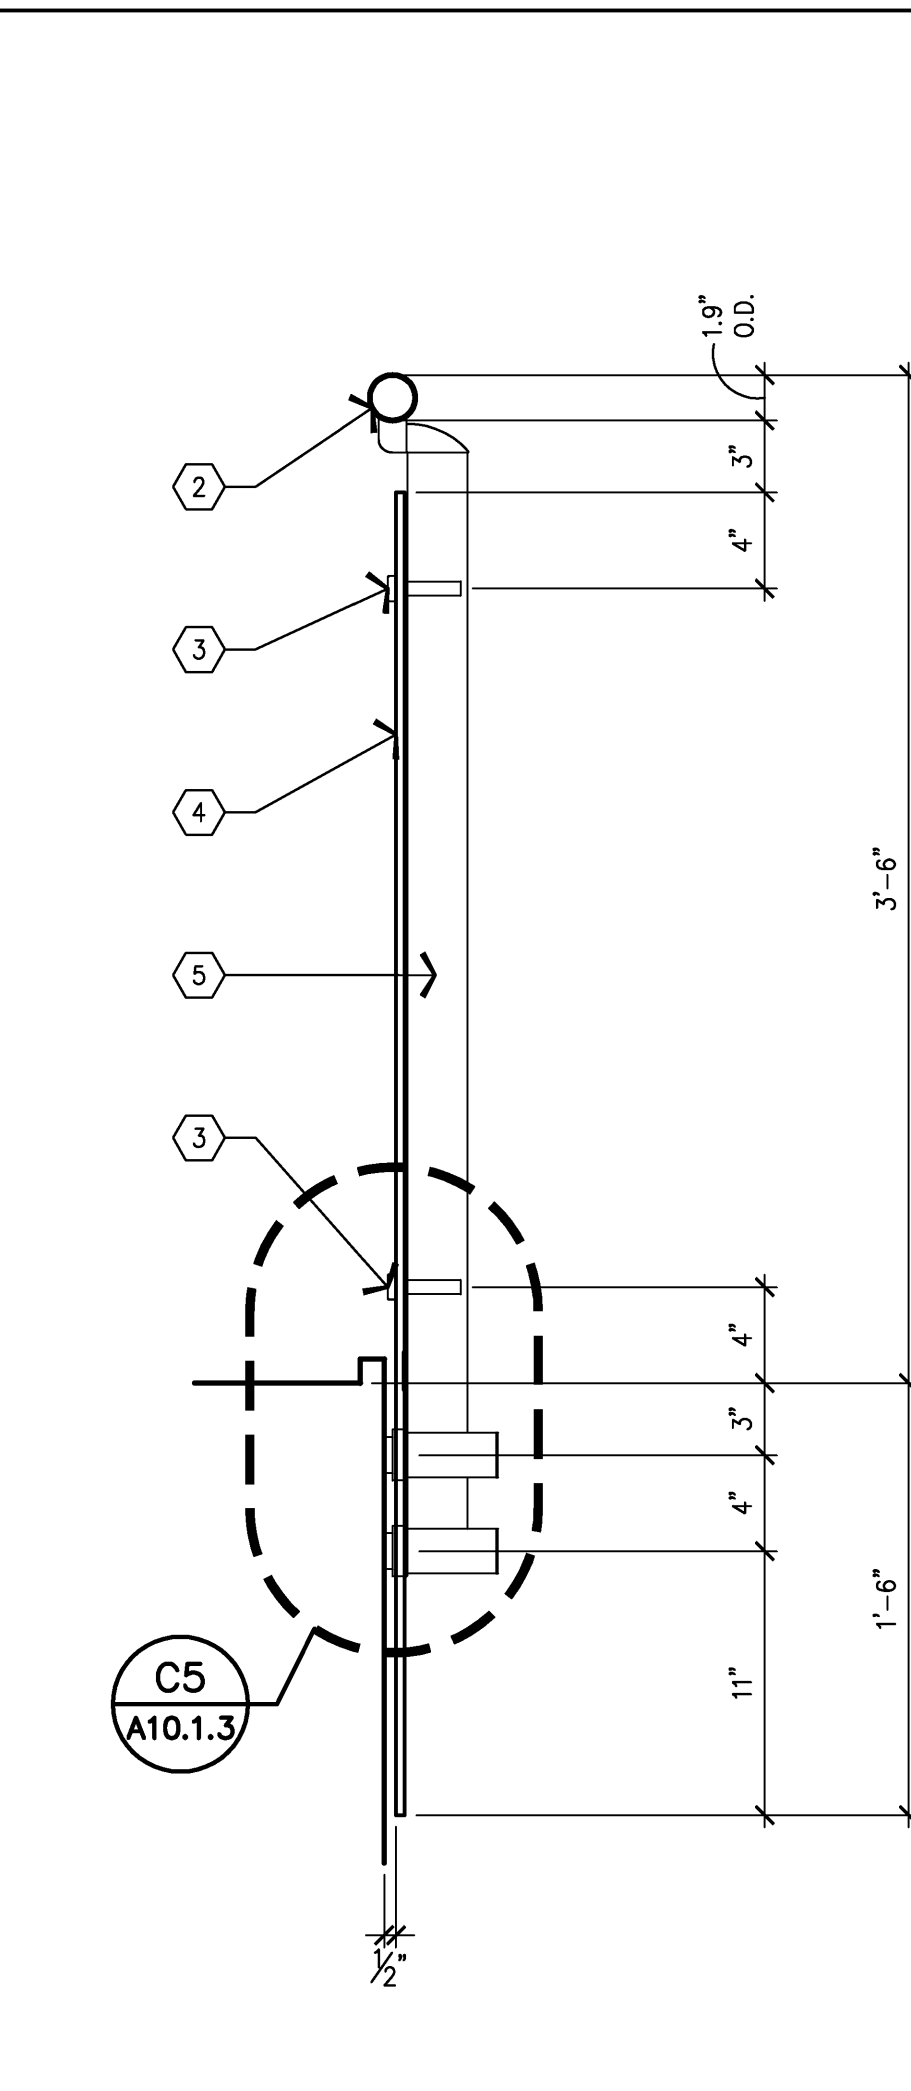


C3 ENLARGED SECTION
1'-10" x 1'-0"

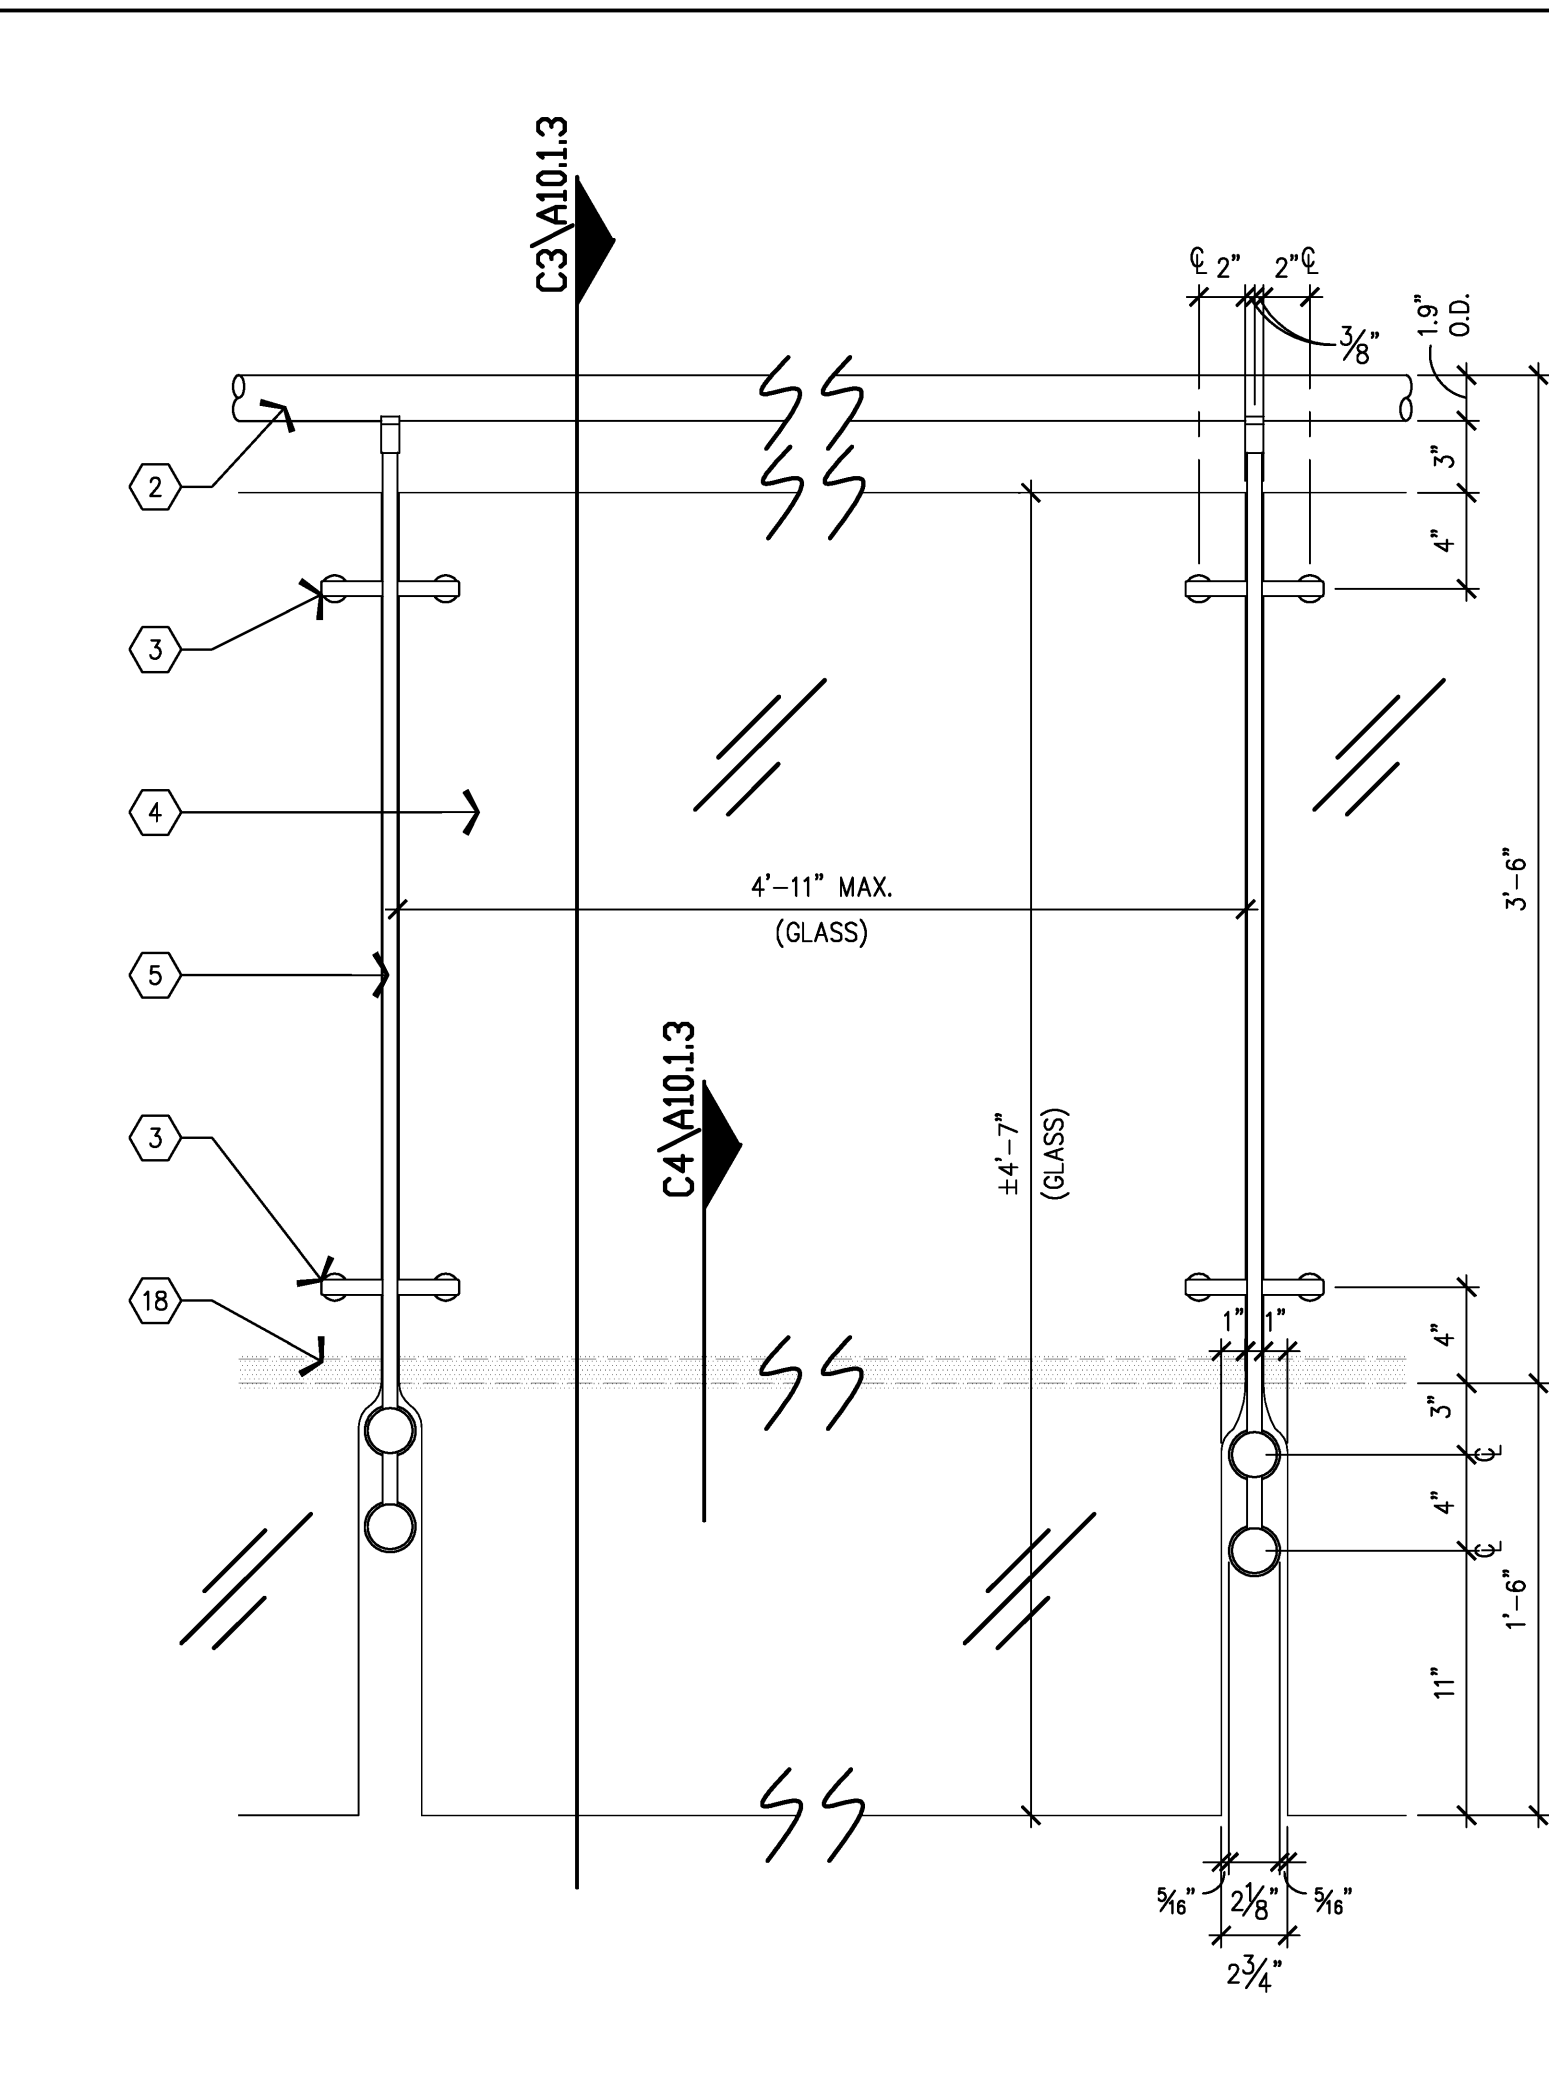


C2 ENLARGED ELEVATION - GLASS HANDRAIL
1'-10" x 1'-0"

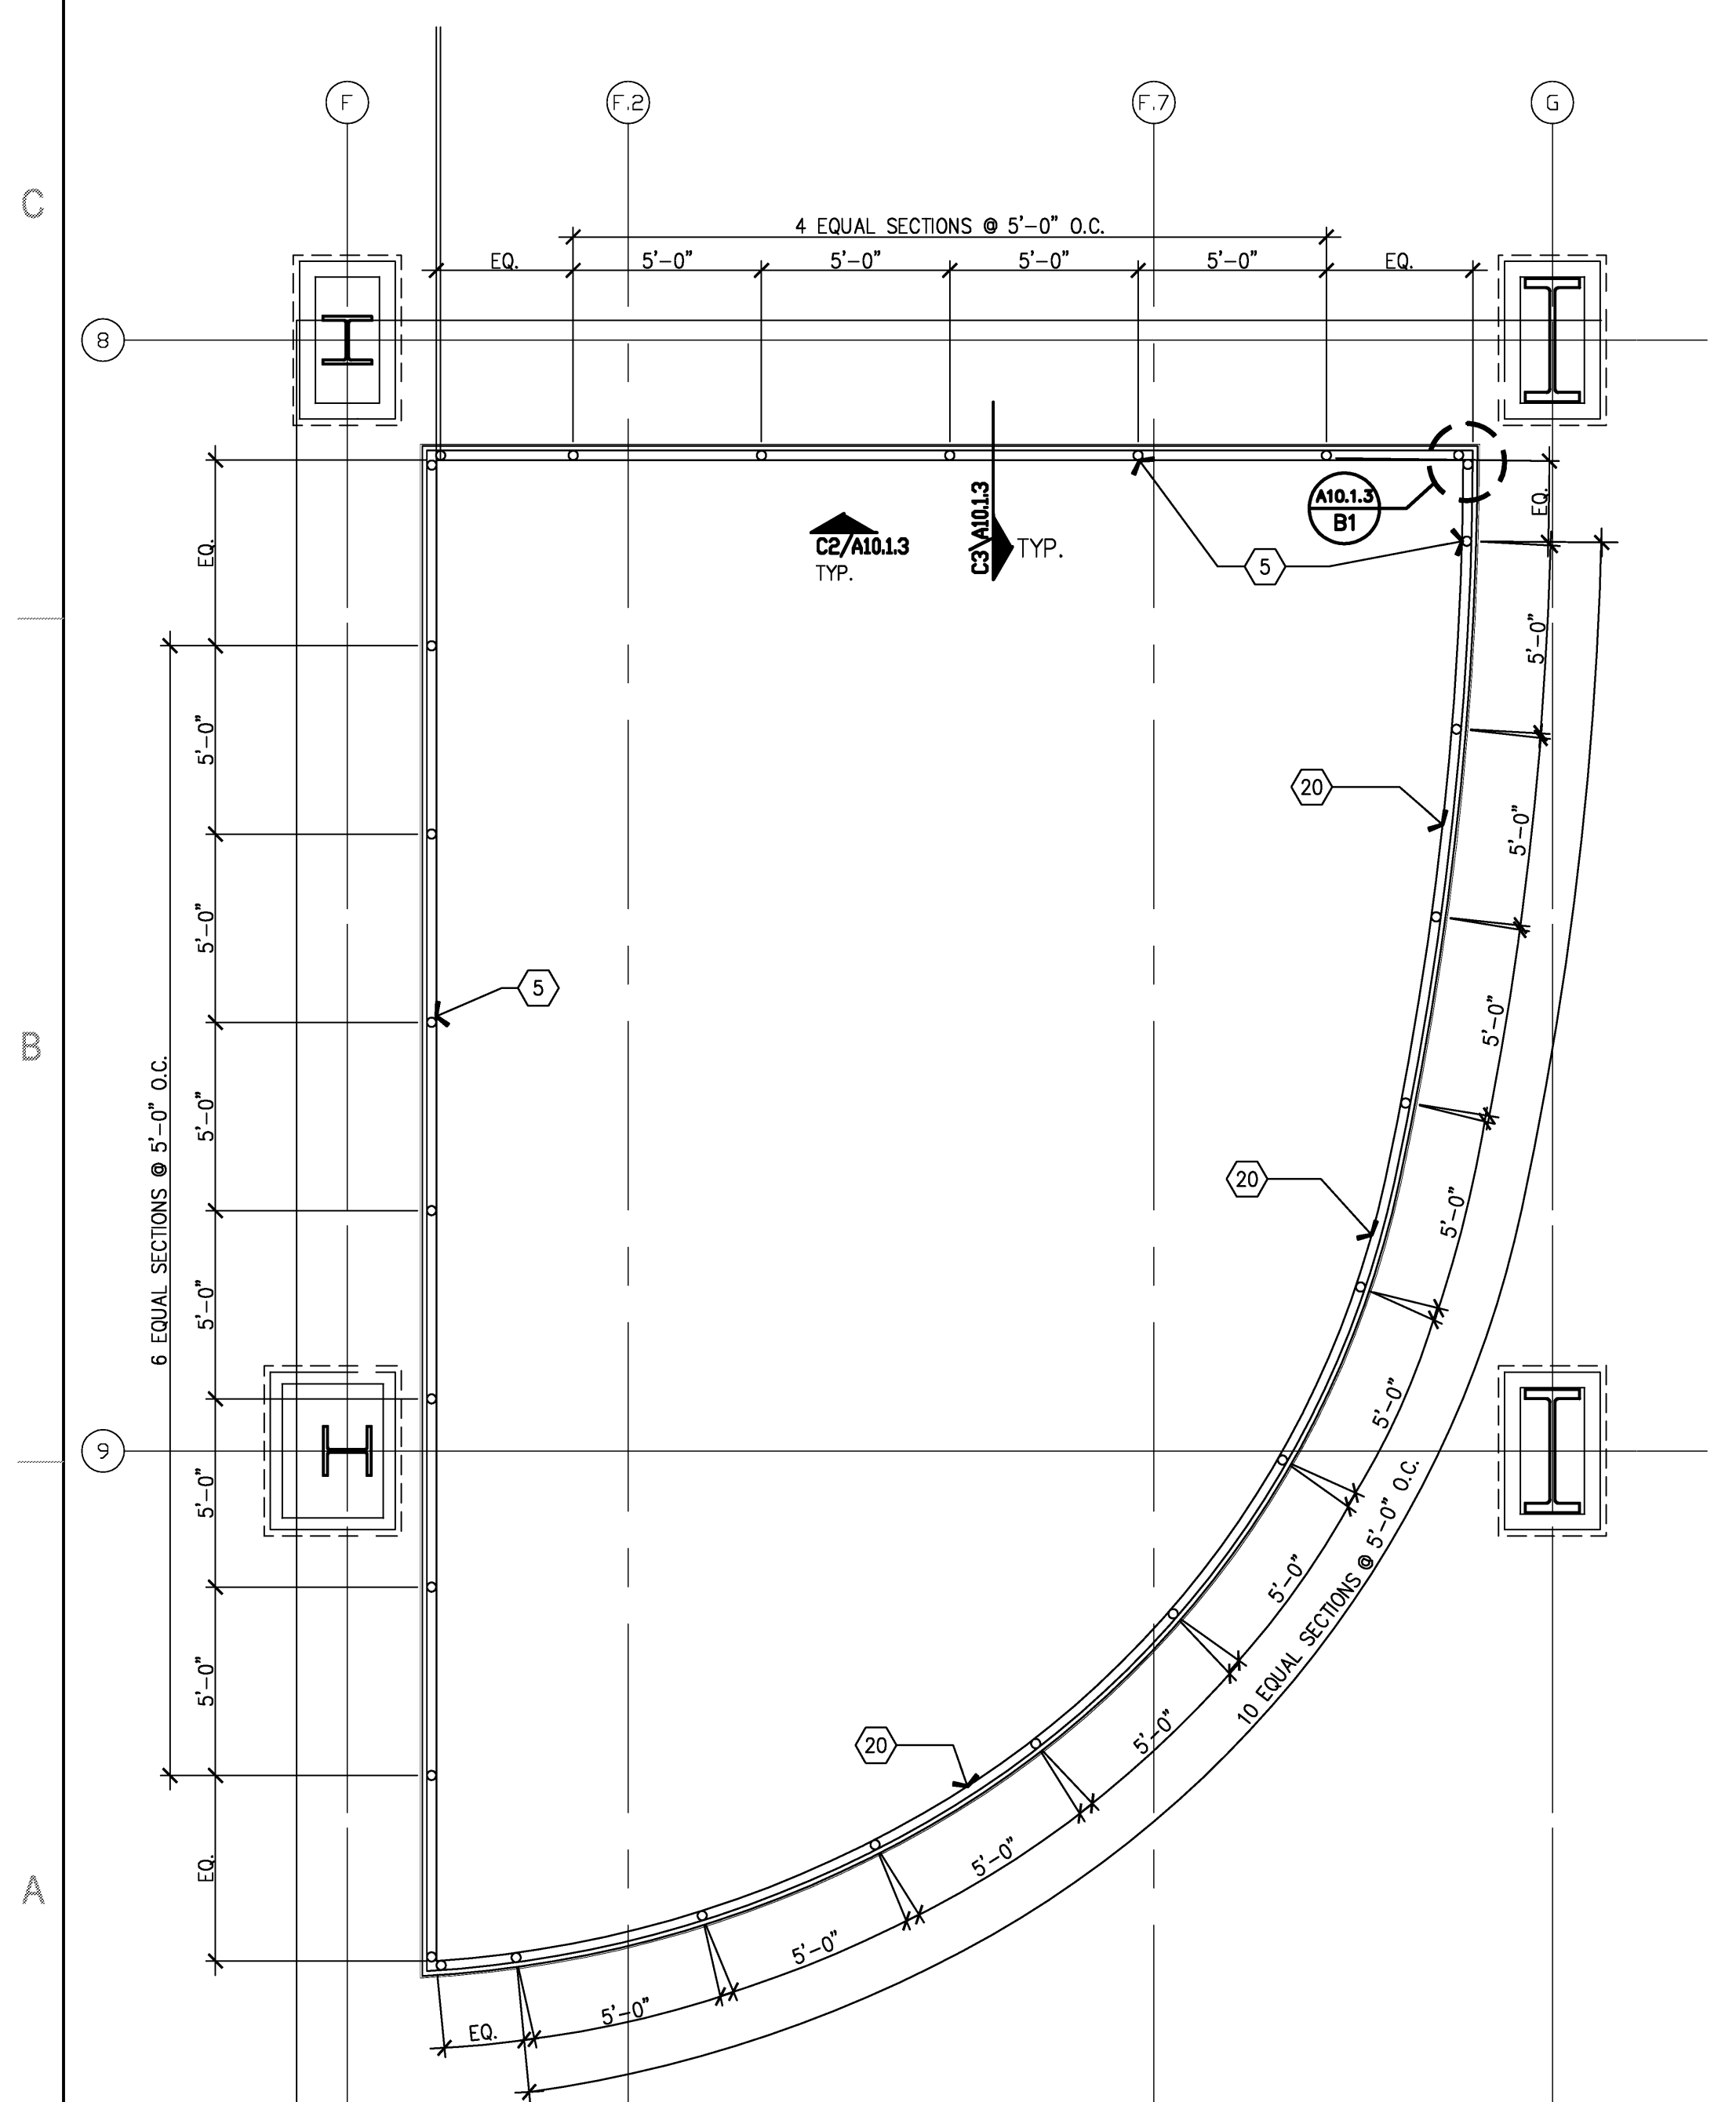

A5 ENLARGED PLAN AT BALUSTER
10'-0" x 1'-0"

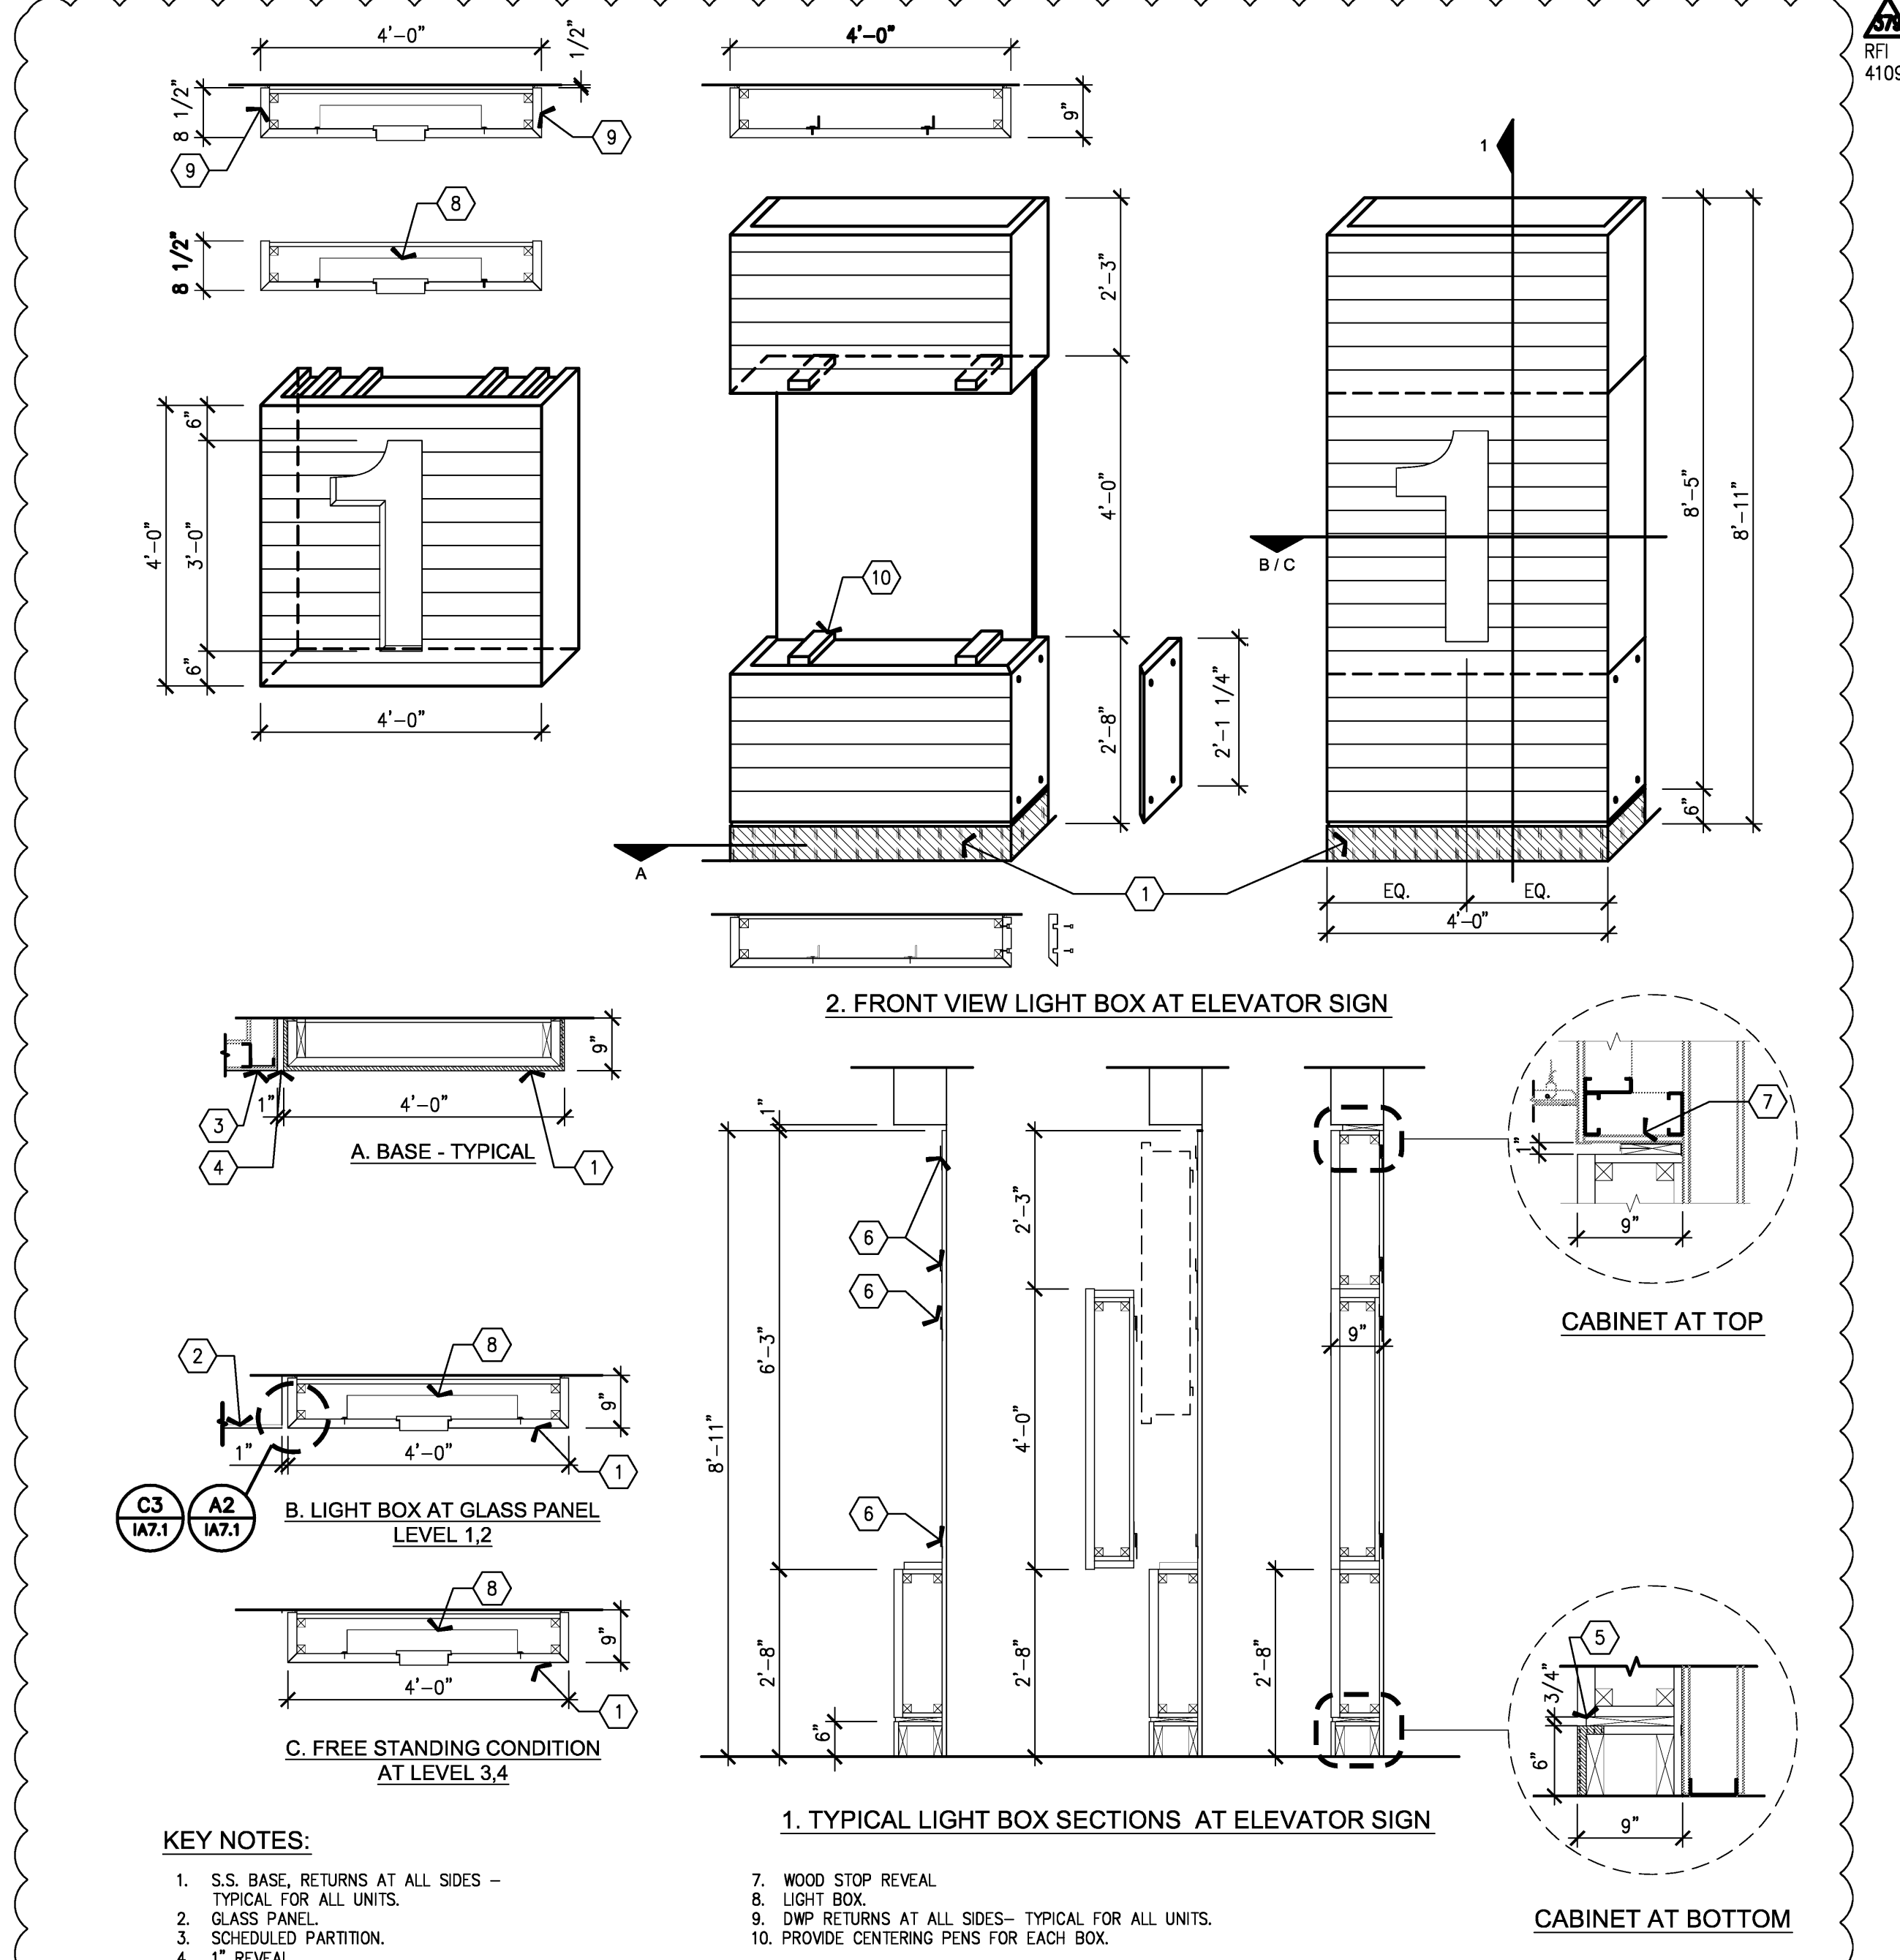

A4 TYPICAL LIGHT BOX DETAILS AT ELEVATOR SIGN
10'-0" x 1'-0"

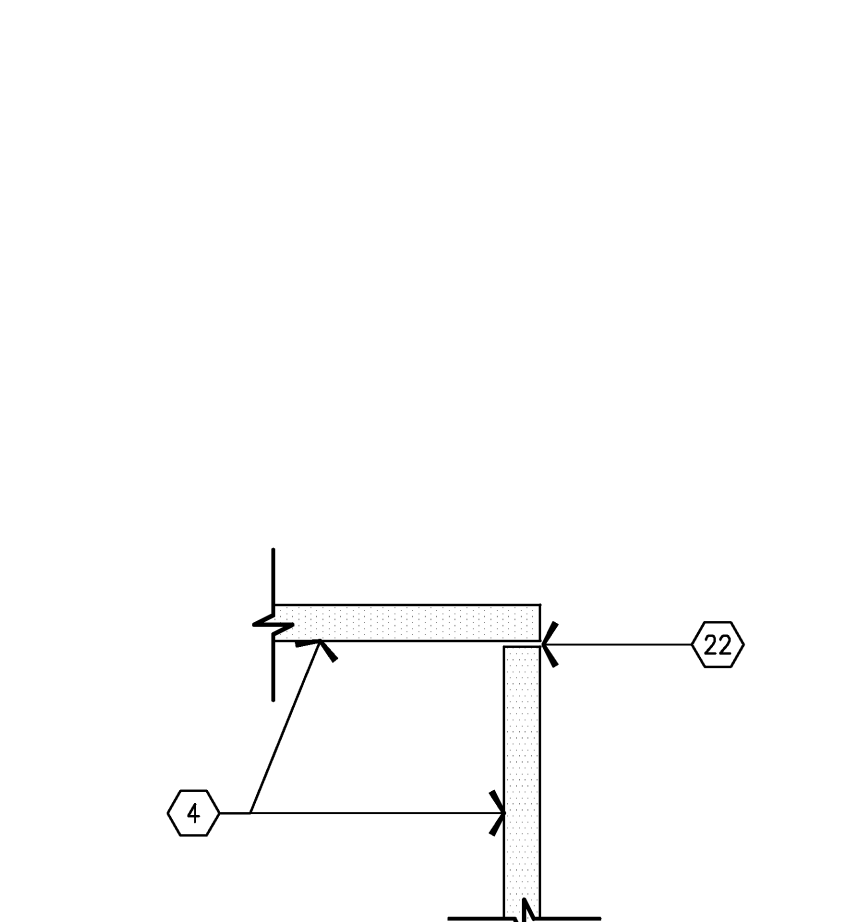

B1 GLASS AT CORNER
1'-10" x 1'-0"

- Scheduled terrazzo flooring.
- 1.9" O.D. guardrail
- Glass clip
- 3/8" tempered glass
- 3/8"x2 1/2" s.s. bolster
- 3/8" x 8" x 8" steel mounting plate w/ drill and top holes for (2) .394" (10mm) 3 bolts at each bolster
- 0.394" (10mm) A449 Bolt, Typical
- 3/8" gypsum board
- 1/4" "Pittcon" STR Trim Reveal or equal
- terrazzo divider strip - hold tight to S.S. trim plate.
- 3/8" x 3" cont. S.S. w/ 5/8" weld hole at 24" o.c. tack weld 1" x 1" S.S. cont. bar.
- Continuous track. Attach per structural dwgs. Notch at plate as needed.
- Backer rod and clear sealant.
- 1/4" x 1/4" S.S. Mushroom Head Split drive anchor at 24" O.C.
- Concrete over metal deck - see structural drawings
- Bent plate - see structural drawings
- 1"x1" stainless steel continuous bar bent to match opening outline.
- 1/8" Wide strip of frosted glass film, typical
- Stainless steel 1 1/2" sleeve
- Glass hand rail radius to be smooth curve along east side of opening
- 3/4" nut channel
- 3/8" wide gap (max.) w/ polished edge.

ALL STAINLESS STEEL TO BE SATIN FINISH

A1 NOTES TO SHEET