


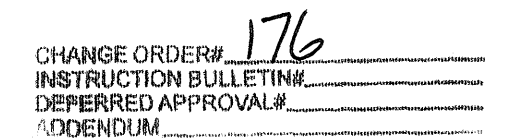

REVISIONS

APPROVAL



455 S. Main St.
Orange, CA 92868-3874

RECEIVED
July 20 2011
McCARTHY



OSHPD - PROJECT NUMBER
IL 072072-30

DATE
01/27/2010

1 1/2"=1'-0"

DRAWING NUMBER _____

A10.2.1

