


FKP Architects


ARCHITECT OF RECORD
Paul C. Gloriod

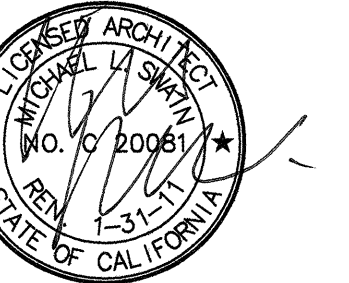

REVISIONS

44	05/28/10	ASI #08
28	07/12/10	CO #28

APPROVAL

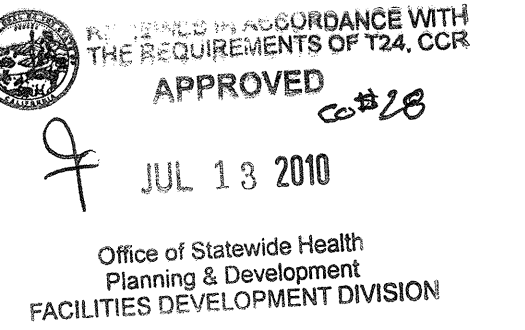

PROJECT NAME

CHILDREN'S HOSPITAL
OF ORANGE COUNTY

455 S. Main St.
Orange, CA 92668-3874

TOWER II



PROJECT NUMBER

12011.00
Increment #7

OSHPD - PROJECT NUMBER

IL 072072-30

ISSUE

OSHPD PERMIT

DATE

01/27/2010

SCALE

1 1/2" = 1'-0"

DRAWING TITLE

INTERIOR PLAN DETAILS

DRAWING NUMBER

A10.2.2

