© 2009 FKP Architects, Inc. All rights reserved. No part of this document may be reproduced or utilized in any form without prior written authorization of FKP Architects, Inc.

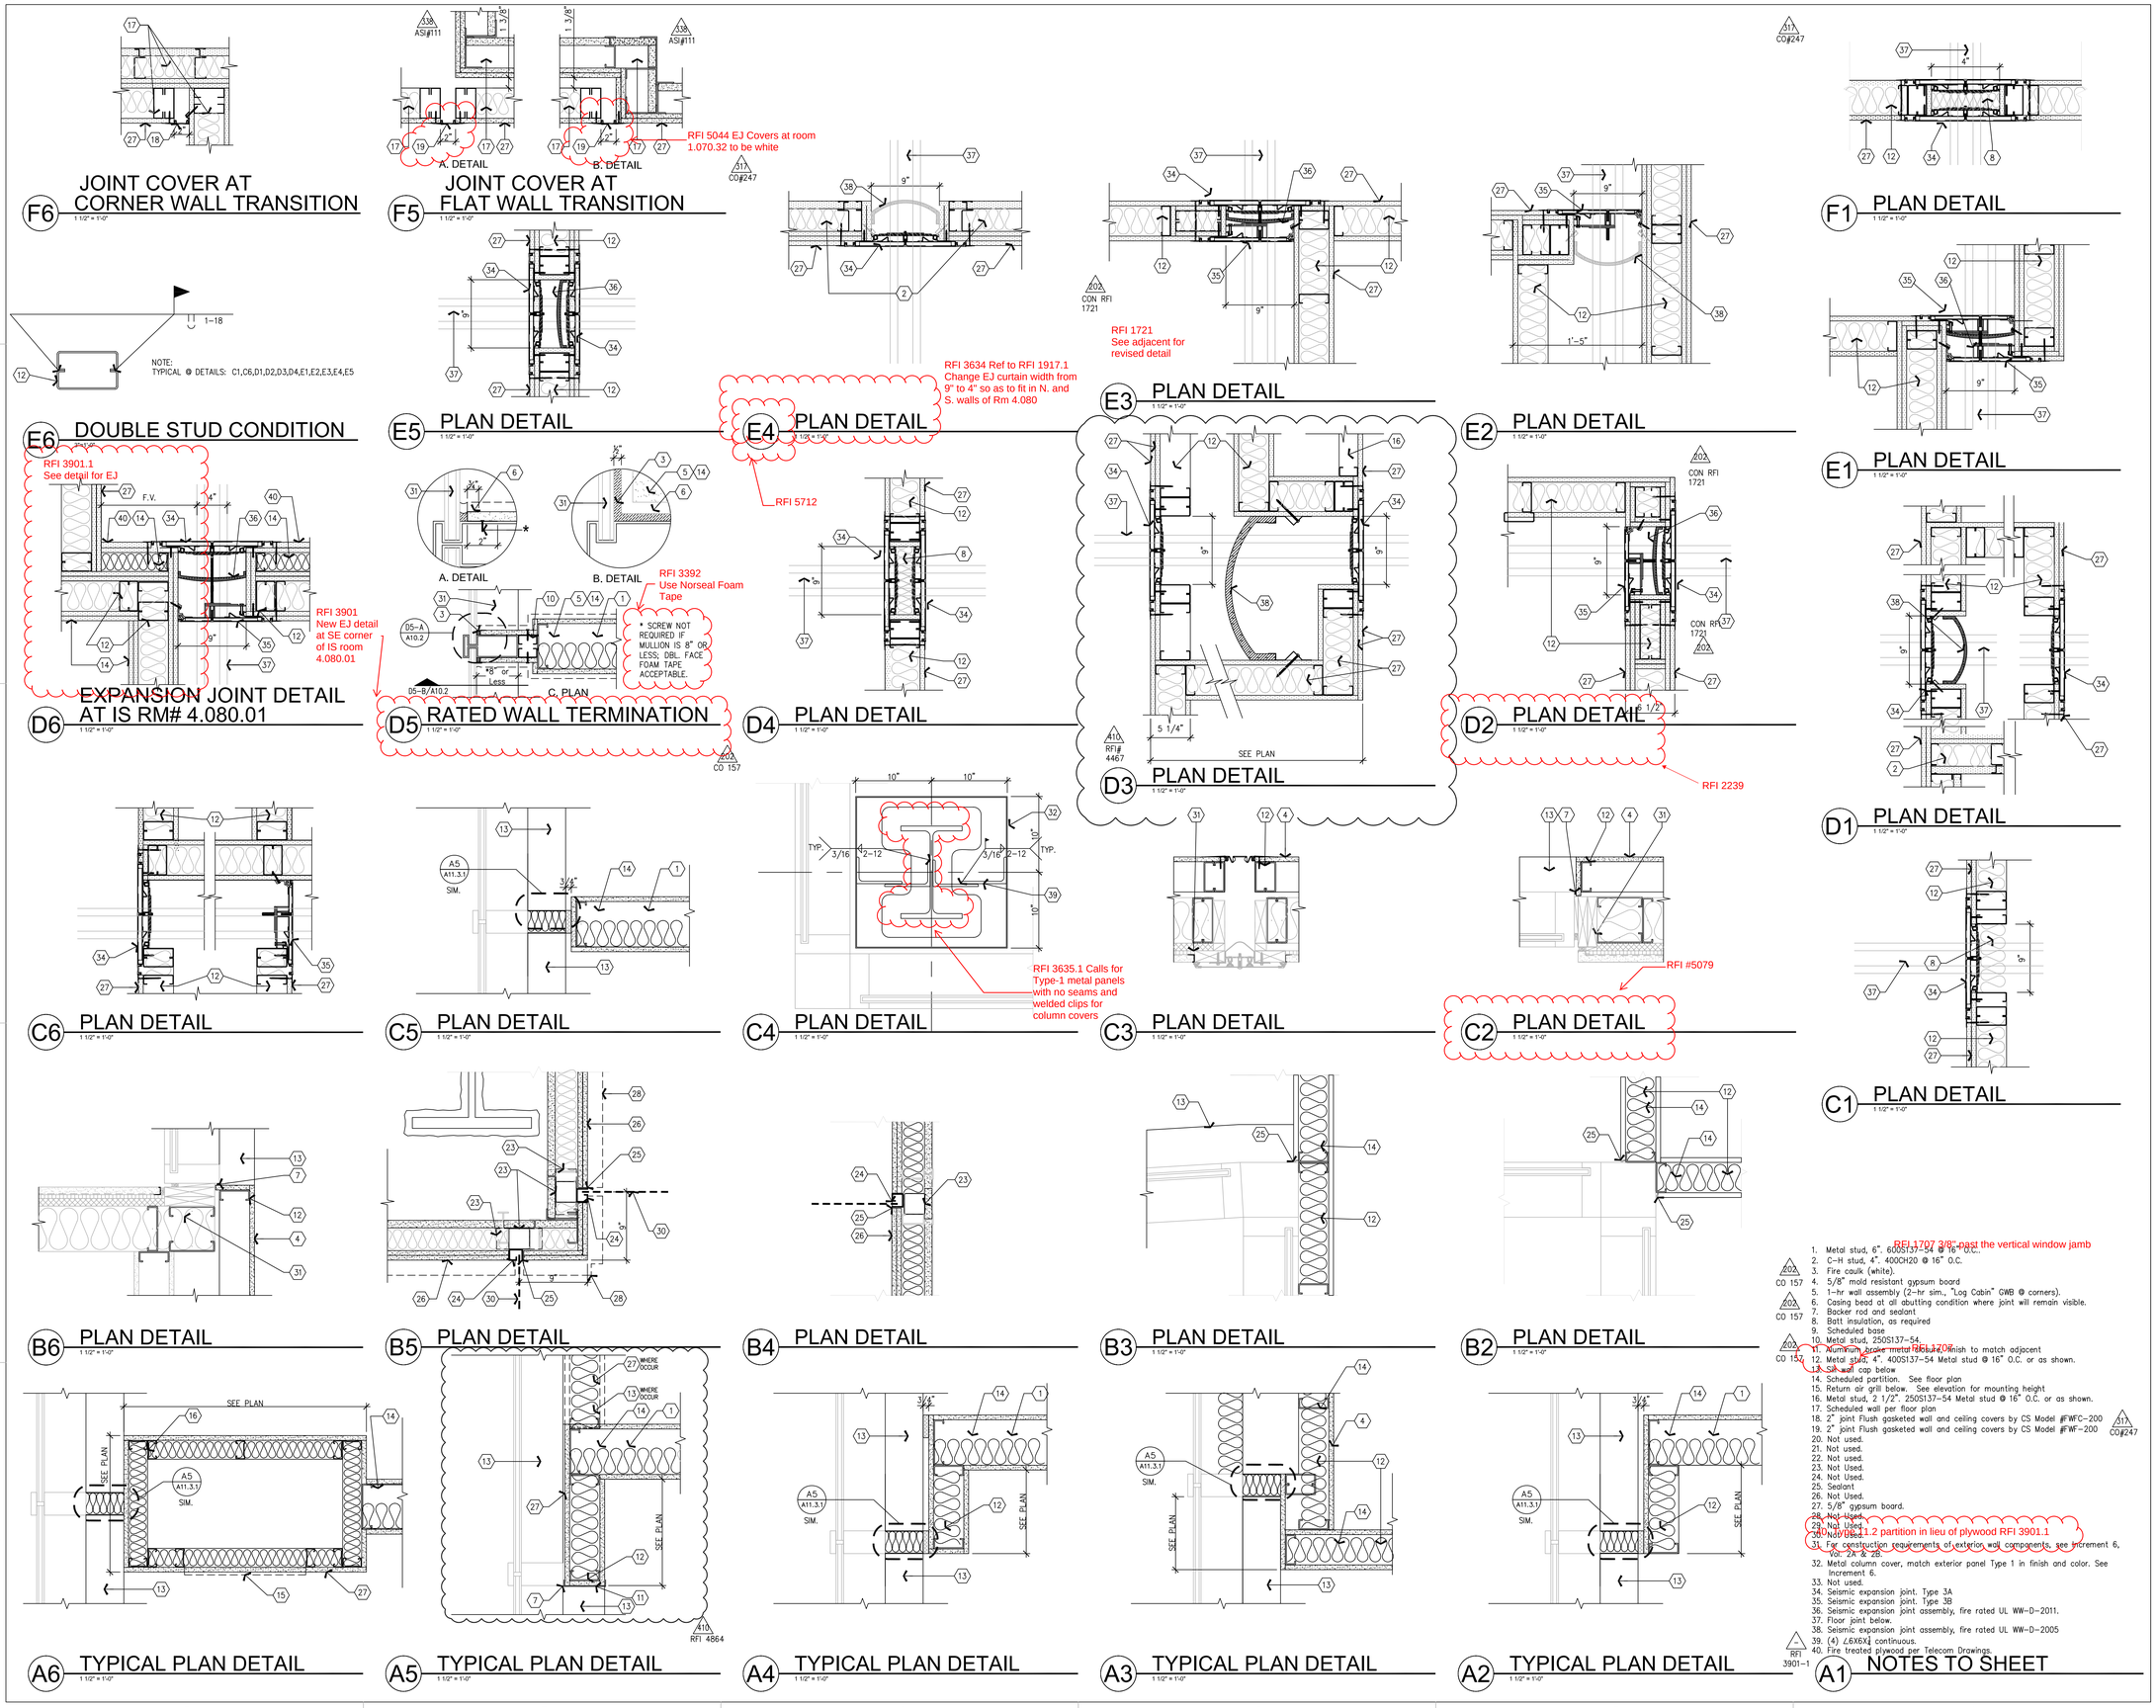

FKP Architects

ARCHITECT OF RECORD

Paul C. Gloriod

LICENSED ARCHITECT MICHAEL L. SMITH NO. C 20081 REN. 1-31-13 STATE OF CALIFORNIA

Changes on these drawings do not consist of materially altered changes to approved drawings and don't require a change order.
OSHPD review ACO _____
OSHPD review FLSO _____
OSHPD review DSE _____

REVISIONS

20A	03/01/11	CO #157
31A	08/15/11	CO#247
33A	08/24/11	ASI #111
41A	01/09/12	ASI #156

APPROVAL

Office of Statewide Health Planning & Development/FDD REVIEWED IN ACCORDANCE WITH THE REQUIREMENTS OF T24, CCR APPROVED
CHANGE ORDER# _____
INSTRUCTION BULLETIN# _____
DEFERRED APPROVAL# _____
ADDENDUM _____

PROJECT NAME

CHILDREN'S HOSPITAL OF ORANGE COUNTY
455 S. Main St.
Orange, CA 92868-3874

TOWER II

CHOC HOSPITAL

PROJECT NUMBER

12011.00
Increment #7

OSHPD - PROJECT NUMBER

IL 072072-30

ISSUE

OSHPD PERMIT

DATE

01/27/2010

SCALE

1 1/2" = 1'-0"

DRAWING TITLE

INTERIOR PLAN DETAILS

DRAWING NUMBER

A10.2

N:\06XXX\06102 CHOC TOWER 2 SHELL BUILDING\FKP CONTRACTED PROJECTS\PROJECT INCREMENTS\INCR. #07_TENANT IMPROVEMENT\OSHPD PERMIT (CONSTRUCTION DOCUMENTS)\100602_CO#_____\A10.2.DWG
1/24/2012
RONALD