


ARCHITECT OF RECORD
Paul C. Gloriod

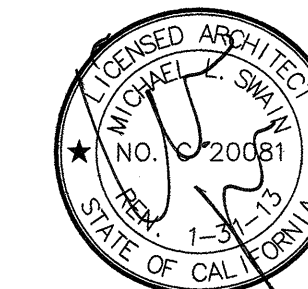

172 02/28/11 CHANGE ORDER #144

Office of Statewide Health
Planning & Development
REVIEWED IN ACCORDANCE WITH
THE REQUIREMENTS OF T24, CCR
401.001

FEB 24 2011

CHANGE ORDER# 144
INSTRUCTION BULLETIN# _____
DEFERRED APPROVAL# _____
APPENDIX _____

APPROVA

PROJECT NAME _____

**CHILDREN'S HOSPITAL
OF ORANGE COUNTY**

455 S. Main St.
Orange, CA 92868-3874

TOWER II



PROJECT NUMBER

12011.00
Increment #7

OSHPD - PROJECT NUMBER
IL 072072-30

ISSUE
OSHDPD PERMIT

DATE _____

01/27/2010

SCALE _____

VARIES

VARIES

DRAWING TITLE

INTERIOR DETAILS
LOWER LEVEL - LEVEL 3

DRAWING NUMBER

A10.3

