


FKP Architects

ARCHITECT OF RECORD
Paul C. Gloriot

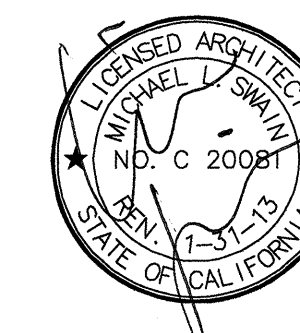

Changes on these drawings do not consist of materially altered changes to approved drawings and don't require a change order.
OSHPD review ACO
OSHPD review FLSO
OSHPD review DSE

REVISIONS

11	03/11/10	CHANGE ORDER #17
29	10/10/11	CHANGE ORDER #232
RAD-2011-DE275		

APPROVAL



CHANGE ORDER #232
REVIEWED IN ACCORDANCE WITH THE REQUIREMENTS OF 224 CCR
APPROVED

PROJECT NAME

CHILDREN'S HOSPITAL
OF ORANGE COUNTY
455 S. Main St.
Orange, CA 92668-3874

TOWER II



PROJECT NUMBER

12011.00
Increment #7

OSHPD - PROJECT NUMBER
IL 072072-30

ISSUE
OSHPD PERMIT

DATE
01/27/2010

SCALE

VARIES

DRAWING TITLE

'THE VOICE'
ENLARGED SECTIONS

DRAWING NUMBER

A10.4

