


FKP Architects

ARCHITECT OF RECORD
Paul C. Gloriot

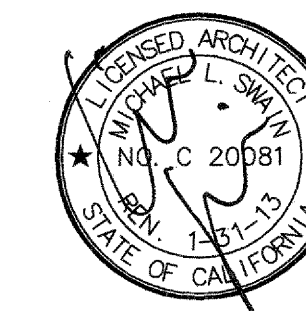


Changes on these drawings do not consist of
materially altered changes to approved drawings
and don't require a change order.
OSHPD review ACO
OSHPD review FLSO
OSHPD review DSE

REVISIONS

62	07/26/10	ASW16
93	11/08/10	ASW28
42	12/05/10	CO#113
50	02/18/11	ASW56
15	02/24/11	CO#146
18	03/01/11	CO#134
62	08/08/11	CO #135
52	08/16/11	CO #251
54	08/30/11	ASI #112
34	09/15/11	ASI #118
34	10/03/11	CO #268

APPROVAL

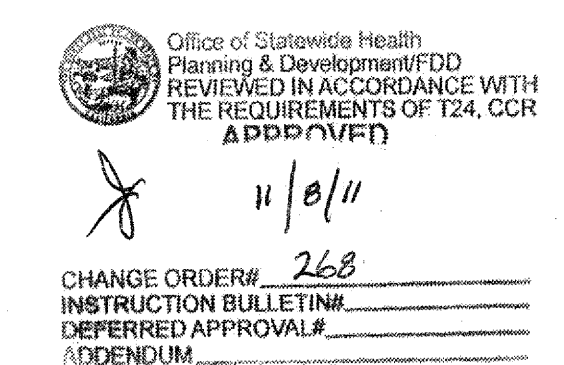

PROJECT NAME
**CHILDREN'S HOSPITAL
OF ORANGE COUNTY**
455 S. Main St.
Orange, CA 92668-3874

TOWER II



PROJECT NUMBER

**12011.00
Increment #7**

OSHPD - PROJECT NUMBER
IL 072072-30

ISSUE
OSHPD PERMIT

DATE

01/27/2010

SCALE

N.T.S.
DRAWING TITLE

**DOOR- OPENING
SCHEDULE LEVEL 2**

DRAWING NUMBER

A11.0.3

Opening Schedule_09-23-2011											
Room Name	Opening Number	Size	Type	Material	Frame	Hardware	Fire Rating	Remarks	Security	Electrical	Revisions
ELEVATOR LOBBY PUBLIC	2.000.00.La	W 6'-0" X H 8'-0"	A	WDP	HM-1	126	U2S	12.26.46			
ELEVATOR LOBBY PUBLIC	2.000.00.Lb	W 6'-0" X H 8'-0"	U		AFD		U2S	12.26.46		X	
CORRIDOR	2.004.00.Ca	W 2'-3 7/8" X H 10'-0"	W		OFD	149	U2S	28		X	1
CORRIDOR	2.004.00.Cb	W 2'-3 7/8" X H 10'-0"	W		OFD		U2S	28		X	1
CORRIDOR	2.004.00.Cc	W 2'-3 7/8" X H 10'-0"	W		OFD		U2S	46		X	1
CORRIDOR	2.016.01.C	W 4'-0" X H 8'-0"	B	HM	HM-1	148		1			
CHILDREN'S AREA	2.012.00.Aa	W 4'-0" X H 8'-0"	A	ALS	AL-7			1.8.58			
CORRIDOR	2.016.00.C	W 2'-5 1/2" X H 10'-0"	Y		OFD		U2S	45.46		X	
CORRIDOR	2.022.00.Ca	W 6'-0" X H 7'-0"	2B	HM	HM-10	180		5.18			
CORRIDOR	2.022.00.Cb	W 6'-0" X H 8'-0"	2B	HM	HM-10	100	U2S	5.18		X	1
CORRIDOR	2.022.00.Cc	W 3'-0" X H 7'-0"	A	WDP	HM-1	114A	U2S	62	X	X	
CORRIDOR	2.022.01.C	W 6'-0" X H 7'-0"	2B	HM	HM-10	188		1.18			
TOILET FEMALE	2.028.01	3'-0" X 7'-0"	A	WDP	HM-1	122					
TOILET MALE	2.028.02	3'-0" X 7'-0"	A	WDP	HM-1	122					
STAFF EXERCISE	2.028.03	W 4'-0" X H 7'-0"	A	WDP	HM-1	121		18			
VESTIBULE LOCKERS	2.028.03A	W 3'-0" X H 7'-0"	A	WDP	HM-1	122A					
TOILET SHOWER STAFF UNSEX	2.028.03B	W 3'-0" X H 7'-0"	A	WDP	HM-1	122A					
SHELL	2.028.04.B	W 3'-0" X H 7'-0"	A	WDP	HM-1	121	U1S	18			
STORAGE DIETARY	2.028.05	W 4'-0" X H 7'-0"	A	WDP	HM-1	121	U1S	18			
MUSIC THERAPY	2.028.06	3'-0" W 4'-0" X H 7'-0"	A	WDP	HM-1	170		42			
CLINICAL MGR.	2.030.01	W 3'-0" X H 7'-0"	A	WDP	HM-1	112		19			
LIBRARY	2.030.02	W 3'-0" X H 7'-0"	A	WDP	HM-1	141					
OFFICE RESIDENT COORD.	2.037.01	W 3'-0" X H 7'-0"	A	WDP	HM-1	112		10			
OFFICE ASST. DIRECTOR	2.037.02	W 3'-0" X H 7'-0"	A	WDP	HM-1	112		10			
OFFICE FELLOW COORD.	2.037.03	W 3'-0" X H 7'-0"	A	WDP	HM-1	112		10			
STORAGE GENERAL	2.037.04	W 3'-0" X H 7'-0"	A	WDP	HM-1	142	U1S				
CONFERENCE	2.037.05	W 3'-0" X H 7'-0"	A	WDP	HM-1	112					
OFFICE DIRECTOR	2.037.06	W 3'-0" X H 7'-0"	A	WDP	HM-1	112		10			
ADMIN ASSISTANT WORK	2.037.07	W 3'-0" X H 7'-0"	A	WDP	HM-1	112		10			
OFFICE FUTURE	2.037.08	W 3'-0" X H 7'-0"	A	WDP	HM-1	112		10			
STORAGE GENERAL	2.037.09	W 3'-0" X H 7'-0"	A	WDP	HM-1	126	U1S				
OFFICE FUTURE	2.037.10	W 3'-0" X H 7'-0"	A	WDP	HM-1	112		10			
OFFICE CME ASST.	2.037.11	W 3'-0" X H 7'-0"	A	WDP	HM-1	112		10			
OFFICE MEDICAL CHAIR OF PEDIATRICS	2.038.01	W 3'-0" X H 7'-0"	A	WDP	HM-1	112		10			
OFFICE SURGICAL CHAIR OF PEDIATRICS	2.038.02	W 3'-0" X H 7'-0"	A	WDP	HM-1	112		10			
OFFICE EXEC DIR. N.C. SERV.	2.040.01	W 3'-0" X H 7'-0"	A	WDP	HM-1	112		10			
KITCHEN OFFICE	2.041.00a	W 3'-0" X H 7'-0"	B		HM-1	117					
KITCHEN OFFICE	2.041.00b	W 2'-6" X H 4'-2"			HM-3			1			
KITCHEN OFFICE	2.041.00c	W 2'-6" X H 4'-2"			HM-3			1			
PUBLIC DINING SEATING AREA	2.041.00A	W 3'-0" X H 7'-0"	Z	SS	HM-1			1.55.52			
PUBLIC DINING SEATING AREA	2.041.00Aa	W 1'-10" X H 9'-6"	A	HM	HM-1	121	U2S	12.21			2
PUBLIC DINING SEATING AREA	2.041.00Ac	W 15'-0" X H 9'-6"	U	AFD			U2S	12.20.23		X	2
PUBLIC DINING SEATING AREA	2.041.00Ad	W 3'-0" X H 7'-0"	A	WDP	HM-1	108	U2S				
PUBLIC DINING SEATING AREA	2.041.00Ae	W 15'-0" X H 9'-6"	A	WDP	HM-1	105	U2S				2
MD DINING/SERVING	2.041.00Ba	W 6'-0" X H 8'-0"	2A	WDP	HM-1						
MD DINING/SERVING	2.041.00Bb	W 12'-0" X H 8'-5"		ALS	AL-8			9.16.58			1
MD DINING/SERVING	2.041.00Bc	W 12'-0" X H 8'-5"		ALS	AL-8			9.16.58			1
MD DINING/SERVING	2.041.00Bd	W 3'-0" X H 7'-0"	A	WDP	HM-1	108	U2S	62			2
PUBLIC DINING AREA	2.041.00Dd	W 6'-0" X H 7'-0"	2B	WDP	HM-10	191		5.18		X	2
PUBLIC DINING AREA	2.041.00Dc	W 18'-0" X H 8'-0"	WLS					21		X	
PUBLIC DINING AREA	2.041.00Dd	W 18'-0" X H 8'-0"	WLS	OGD				18		X	
KITCHEN	2.041.00C	W 3'-0" X H 7'-0"	Z	SS	HM-1A	100A		1.22.43			1
KITCHEN	2.041.00C	W 3'-0" X H 7'-0"	A	WDP	HM-1	138					
KITCHEN	2.041.00C	W 3'-0" X H 7'-0"	A	WDP	HM-1	138	U2S	62	X	X	1
KITCHEN	2.041.00C	W 3'-0" X H 7'-0"	Z	SS	HM-1A	100A		1.43			1
OFFICE INF. CONT.	2.042.01	W 3'-0" X H 7'-0"	A	WDP	HM-1	112		10			
CORRIDOR	2.045.00.Ca	W 3'-0" X H 7'-0"	S	WDP	HM-1	151	U2S	5			1
CORRIDOR	2.045.00.Cc	W 6'-0" X H 8'-0"	2B	WDP	HM-10	100		1.18		X	2
CORRIDOR	2.047.00.Ca	W 3'-0" X H 8'-4"	B	WDP	HM-1	148					
CORRIDOR	2.047.00.Cb	W 6'-0" X H 7'-0"	2B	WDP	HM-1	180	U2S	5.54			
CORRIDOR	2.049.00.C	W 3'-0" X H 7'-0"	A	WDP	HM-1	147	U2S	18			
CORRIDOR	2.049.00.C	W 3'-0" X H 7'-0"	A	WDP	HM-1	147	U2S	18			
VESTIBULE	2.052.00.V	W 4'-0" X H 7'-0"	A	WDP	HM-1	147	U2S	18			
COFFEE KIOSK	2.081.00.Aa	W 3'-0" X H 7'-0"	C	WDP	HM-1	126		1			
COFFEE KIOSK	2.081.00.Ab	W 18'-0" X H 10'-0"	W	OFD			U1S	28.78		X	1
STORAGE COFFEE KIOSK	2.081.00.B	W 3'-0" X H 7'-0"	A	WDP	HM-1	126	U1S				
CORRIDOR	2.085.00.Ca	W 1'-10" X H 9'-0"	A	WDP	AFD	142	U2S	12.20			
CORRIDOR	2.085.00.Cb	W 15'-0" X H 9'-0"	U		AFD		U2S	12.59		X	1
ELEVATOR LOBBY STAFF/PATIENTS	2.088.00.La	W 8'-0" X H 8'-0"	2B	WDP	HM-10	178	U2S	5.18.54			2
ELEVATOR LOBBY STAFF/PATIENTS	2.088.00.Lb	W 8'-0" X H 8'-0"	2B	WDP	HM-10	100				X	1.2
CORRIDOR	2.072.00.C	W 8'-0" X H 8'-0"	2B	WDP	HM-1	137					
TOILET PATIENT UNSEX	2.074.01	W 3'-0" X H 7'-0"	A	WDP	HM-1	141					
KITCHENETTE	2.074.02a	W 3'-0" X H 7'-0"	A	WDP	HM-1	141					
KITCHENETTE	2.074.02b	W 3'-0" X H 7'-0"	A	WDP	HM-1	141					
KITCHENETTE	2.074.02c	W 3'-0" X H 7'-0"		HM-3				1.8			
KITCHENETTE	2.074.02d	W 3'-0" X H 7'-0"		HM-3				1.8			
KITCHENETTE	2.074.02e	W 3'-0" X H 7'-0"		HM-3				1.8			
KITCHENETTE	2.074.02f	W 3'-0" X H 7'-0"		HM-3				1.8			
RADIO LOUPOP	2.075.00.A	W 6'-10" X H 7'-0"	D1	WDP		187		1.50			2
TOILET PATIENT UNSEX	2.076.01	W 3'-0" X H 7'-0"	A	WDP	HM-1	137					
STAFF CORRIDOR	2.085.00.A	W 4'-0" X H 7'-0"	B	WDP	HM-1	108A		5.82	X	X	1
OFFICE CHILD LIFE MANAGER	2.084.01	W 3'-0" X H 7'-0"	A	WDP	HM-1	117					
CORRIDOR	2.100.00.Ca	W 3'-0" X H 7'-0"	A	WDP	HM-1	144					
HOUSEKEEPING	2.100.40	W 3'-0" X H 7'-0"	A	WDP	HM-1	114A	U1S	62			
TRASH LINEN	2.100.44	W 3'-0" X H 7'-0"	A	WDP	HM-1	121	U1S	18			
SHELL SPACE	2.113.00a	W 3'-0" X H 7'-0"	A	WDP	HM-1	121	U1S	18			
SHELL SPACE	2.113.00b	W 3'-0" X H 7'-0"	A	WDP	HM-10	188	U2S	5.18		X	
SHELL SPACE	2.113.00c	W 2'-10" X H 9'-0"	U	AFD			U2S	12.28.46			
CORRIDOR	2.113.00.Ca	W 1'-10" X H 9'-0"	A	WDP	HM-1	142	U2S	12.20			
CORRIDOR	2.113.00.Cb	W 3'-0" X H 7'-0"	2B	WDP	HM-10	100		1.18		X	2
OFFICE 9 - V.P.	2.113.01	3'-0" X 7'-0"	A	WDP	HM-1	125B					
EQUIPMENT STORAGE	2.113.01	W 3'-0" X H 7'-0"	A	WDP	HM-1	106					
STORAGE GENERAL	2.113.01	W 3'-0" X H 7'-0"	A	WDP	HM-1	121	U2S	18			
GIFT SHOP OFFICE STORAGE	2.113.01	W 3'-0" X H 7'-0"	A	WDP	HM-1	114C	U1S	62	X	X	
GIFT SHOP OFFICE STORAGE	2.113.01	W 3'-0" X H 7'-0"	A	WDP	HM-1	114A	U1S	1.62	X	X	
GIFT SHOP	2.113.01	W 3'-0" X H 7'-0"	E1	ALS	AL-8	119A		1.58.62	X	X	1
GIFT SHOP	2.113.01	W 3'-0" X H 7'-0"		ALS	AL-8			1.58.62			
GIFT SHOP	2.113.01	W 3'-0" X H 7'-0"		ALS	AL-8			1.58.62			
GIFT SHOP	2.113.01	W 3'-0" X H 7'-0"		ALS	AL-8			1.58.62			
CONFERENCE ROOM	2.113.01	W 3'-0" X H 7'-0"	2B1	WDP	AL-3	182		5.6.64			4
CONFERENCE ROOM	2.113.01	W 3'-0" X H 7'-0"	2B1	WDP	AL-3	182		5.6.64			4
CONFERENCE ROOM	2.113.01	W 3'-0" X H 7'-0"	2B1	WDP	AL-3	182		5.6.64			4

Opening Schedule_09-23-2011											
Room Name	Opening Number	Size	Type	Material	Frame	Hardware	Fire Rating	Remarks	Security	Electrical	Revisions
CONFERENCE ROOM	2.011d	W3'-0" X H7'-0"	A	WDP	HM-1	121	U1S	-	-	-	-
CONFERENCE ROOM	2.011a	W3'-0" X H7'-0"	A	WDP	HM-1	147	U1S	-	-	-	-
CONFERENCE ROOM	2.011f	W23'-0" X H6'-0"	S	OPF	-	-	-	14	-	-	-
CONFERENCE ROOM	2.011g	W16'-0" X H6'-0"	W	OPD	-	-	U1S YES	6.28.06.78	-	-	-
FAMILY SERVICES LIBRARY	2.012a	W6'-0" X H8'-0"	2E.1	(AL57)WDP	AL-2	182	-	1.54.53	-	-	-
TOILET STAFF FEMALE	2.013	W3'-0" X H7'-0"	A	WDP	HM-1	122A	-	-	-	-	-
ALL FAITHS MEDITATION ROOM	2.014a	W6'-0" X H7'-10.10"	2E.1	WDP (AL57) AL-2	AL-2	197	-	1.8.58	-	-	-
ALL FAITHS MEDITATION ROOM	2.014b	W3'-0" X H5'-0"	-	ALS	AL-14	-	-	30	-	-	-
ALL FAITHS MEDITATION ROOM	2.014c	W4'-0" X H7'-10.10"	2A	W	AL-2	173	-	-	-	-	-
OFFICE/CONSULT PASTORAL	2.016	W3'-0" X H9'-0" 8'-4"	A	WDP	HM-1	117	-	-	-	-	-
STORAGE GENERAL	2.018a	W3'-0" X H7'-0"	B	WDP	HM-1	126	U1S	-	-	-	-
STORAGE GENERAL	2.018b	W3'-0" X H7'-0"	B	WDP	HM-1	126	U1S	-	-	-	-
SHELL	2.026	W4'-0" X H7'-0"	A	WDP	HM-1	121	U1S	18.54	-	-	-
SHELL	2.028	W4'-0" X H7'-0"	A	WDP	HM-1	121	U1S	18	-	-	-
OPEN WORK CLINICAL DIETICIANS	2.030	W3'-0" X H7'-0"	C	WDP	HM-6	141	-	1.8	-	-	-
CLOSET HOUSEKEEPING	2.031	W4'-0" X H7'-0"	A	WDP	HM-1	145	U1S	-	-	-	-
OFFICE CHIEF RESIDENTS (3) WORKSTNS.	2.032	W3'-0" X H7'-0"	A	WDP	HM-1	117	-	-	-	-	-
TOILET STAFF MALE	2.033	W3'-0" X H7'-0"	A	WDP	HM-1	142A	-	-	-	-	-
OFFICE RESIDENTS (4) WORKSTNS.	2.034	W3'-0" X H7'-0"	A	WDP	HM-1	112	-	-	-	-	-
RESIDENTS LOUNGE	2.035	W3'-0" X H7'-0"	A	WDP	HM-1	141	-	-	-	-	-
TLT STAFF UNISEX	2.036	W3'-0" X H7'-0"	A	WDP	HM-1	128	U2S	-	-	-	-
WAITING	2.038	W3'-0" X H7'-0"	A	WDP	HM-1	141	U2S	-	-	-	-
EXEC. ASST. & WAIT	2.040	W3'-0" X H7'-0"	A	WDP	HM-1	121	U2S	18	-	-	-
OFFICE OPEN AREA	2.042	W3'-0" X H7'-0"	A	WDP	HM-1	117	U2S	-	-	-	2
STORAGE GENERAL	2.046	W3'-0" X H7'-0"	A	WDP	HM-1	126	U1S	-	-	-	-
HOUSEKEEPING	2.048	W3'-0" X H7'-0"	A	WDP	HM-1	144	-	-	-	-	-
STORAGE DIETARY	2.050	W3'-0" X H7'-0"	A	WDP	HM-1	122	-	-	-	-	2
TOILET PUBLIC MALE	2.057	W3'-0" X H7'-0"	A	WDP	HM-1	126	-	-	-	-	-
TOILET PUBLIC FEMALE	2.059	W3'-0" X H7'-0"	A	WDP	HM-1	122	-	-	-	-	-
PRE TEEN ROOM	2.074a	W4'-0" X H8'-10"	E.1	WDP	HM-14	114B	-	6.8.02	X	X	-
ACTIVITY ROOM	2.075a	W3'-0" X H7'-0"	C	WDP	HM-1	187	-	51	-	-	-
ACTIVITY ROOM	2.076a	W3'-0" X H7'-0"	C	WDP	HM-1	187A	-	1.51	-	-	-
TEEN ROOM	2.076a	W3'-0" X H8'-10"	E.1	WDP	HM-14	114B	-	6.8.02	X	X	-
CONFERENCE TEACHER	2.082	W3'-0" X H7'-0"	A	WDP	HM-1	121	U1S	18	-	-	-
WORKROOM CHILD LIFE	2.084	W3'-0" X H7'-0"	B	WDP	HM-1	116A	U1S	5.62	X	X	1
TOILET STAFF UNISEX	2.085	W3'-0" X H7'-0"	A	WDP	HM-1	134	-	-	WDP	A	-
VESTIBULE	2.100	W8'-0" X H7'-0"	2E.1	WDP	HM-1	107	-	44	-	-	2
MIDWINTER SERVICE	2.041.00.84	W0'-0" X H7'-0"	A	WDP	HM-1	114	U2S	62	X	-	-
RADIO LOLLIPOP ALCOVE	2.075.02	W3'-0" X H7'-0"	A	WDP	HM-1	166	-	-	-	-	-
PASS THRU	2.029.01a	6'-0" X 7'-0"	2A	WDP	HM-1	121A	U1S	-	-	-	-
CONFERENCE ROOM 'C'	2.028.02	3'-0" X 7'-0"	B	WDP	HM-1	117A	-	1	-	-	-
STORAGE	2.028.03a	4'-0" X 7'-0"	A	WDP	HM-1	168	U1S	-	-	-	-
STORAGE	2.028.03b	4'-0" X 7'-0"	A	WDP	HM-1	144	U1S	-	-	-	-
PASS THRU	2.028.04a	3'-4" X 7'-0"	A	WDP	HM-1	121A	U1S	-	-	-	-
PASS THRU	2.028.05a	6'-0" X 7'-0"	2A	WDP	HM-1	121A	U1S	-	-	-	-
CONFERENCE ROOM 'B'	2.028.06	3'-0" X 7'-0"	B	WDP	HM-1	117A	U1S	1	-	-	-
CORRIDOR	2.028.07	3'-0" X 7'-0"	A	WDP	HM-1	121	U1S	-	-	-	-
AV STORAGE	2.028.08	3'-0" X 7'-0"	A	WDP	HM-1	126	U1S	-	-	-	-
PASS THRU	2.028.09a	3'-0" X 7'-0"	A	WDP	HM-1	121A	U1S	-	-	-	-
PASS THRU	2.028.10a	6'-0" X 7'-0"	2A	WDP	HM-1	121A	U1S	-	-	-	-
CONFERENCE ROOM 'A'	2.028.11a	3'-0" X 7'-0"	B	WDP	HM-1	117A	U1S	1.51	-	-	-
STORAGE	2.028.12a	4'-0" X 7'-0"	A	WDP	HM-1	126	U1S	-	-	-	-
STORAGE	2.028.12b	4'-0" X 7'-0"	A	WDP	HM-1	128	U1S	-	-	-	-
PASS THRU	2.028.13a	6'-0" X 7'-0"	2A	WDP	HM-1	121A	U1S	-	-	-	-
CORRIDOR	2.100.80	4'-6" X 7'-0"	Q2	WDP	HM-1	102	U2S	-	-	-	-
OFFICE 8 - CNO	2.113.02	3'-0" X 7'-0"	A	WDP	HM-1	125B	-	-	-	-	-
OFFICE 7 - CFO	2.113.03	3'-0" X 7'-0"	A	WDP	HM-1	125B	-	-	-	-	-
OFFICE 6 - CNO	2.113.04	3'-0" X 7'-0"	A	WDP	HM-1	125B	-	-	-	-	-
OFFICE 5 - COO	2.113.05	3'-0" X 7'-0"	A	WDP	HM-1	125B	-	-	-	-	-
OFFICE 4 - GEO	2.113.07	3'-0" X 7'-0"	A	WDP	HM-1	125B	-	-	-	-	-
OFFICE 3a - EXEC ASST. CEO	2.113.07a	3'-0" X 7'-0"	A	WDP	HM-1	125	-	1	-	-	-
CLOSET	2.113.07b	6'-0" X 7'-0"	A	WDP	WD	104A	-	-	-	-	-
TLT CEO	2.113.08	3'-0" X 7'-0"	A	WDP	WD	184A	-	-	-	-	-
OFFICE 1a - EXEC ASST. CEO	2.113.09	3'-0" X 7'-0"	A	WDP	HM-14	125	-	1	-	-	-
OFFICE 2 - PIC	2.113.10	3'-0" X 7'-0"	A	WDP	HM-1	125B	-	-	-	-	-
OFFICE 3 - PIC	2.113.11	3'-0" X 7'-0"	A	WDP	HM-1	125B	-	-	-	-	-
OFFICE 4 - CMO	2.113.12	3'-0" X 7'-0"	A	WDP	HM-1	125B	-	-	-	-	-
OFFICE 4a - EXEC ASST. CMO	2.113.13	3'-0" X 7'-0"	A	WDP	HM-14	125	-	1	-	-	-
FOUNDATION CONFERENCE	2.113.14	3'-0" X 7'-0"	A	WDP	HM-1	125	-	-	-	-	-
CONFERENCE 2	2.113.15	3'-0" X 7'-0"	A	WDP	HM-1	117	-	-	-	-	-
CORRIDOR	2.113.16	3'-0" X 7'-0"	A	WDP	HM-1	108A	U1S	-	-	-	-
CONFERENCE 1	2.113.17	3'-0" X 7'-0"	A	WDP	HM-1	117	-	-	-	-	-
IS ROOM	2.113.18a	3'-0" X 7'-0"	A	WDP	HM-1	144	U1S	-	-	-	-
STORAGE	2.113.19	3'-0" X 7'-0"	A	WDP	HM-1	144	U1S	-	-	-	-
HOUSEKEEPING	2.113.20	3'-0" X 7'-0"	A	WDP	HM-1	144	U1S	-	-	-	-
WAITING	2.113.21	3'-0" X 7'-0"	A	WDP	HM-1	114B	U1S	-	-	-	-
OFFICE 9a - EXEC ASST. PIC	2.113.22a	3'-0" X 7'-0"	A	WDP	HM-14	125	-	1	-	-	-
BOARD ROOM	2.113.22b	6'-0" X 7'-0"	2A	WDP	HM-1	182	U1S	-	-	-	-
BOARD ROOM	2.113.22b	3'-0" X 7'-0"	A	WDP	HM-1	147	U1S	-	-	-	-
BOARD ROOM	2.113.22c	3'-0" X 7'-0"	A	WDP	HM-1	147	U1S	-	-	-	-
OFFICE 2a - EXEC ASST. SIC	2.113.23	3'-0" X 7'-0"	A	WDP	HM-14	125	-	1	-	-	-
OFFICE 8a - EXEC ASST. COO	2.113.24	3'-0" X 7'-0"	A	WDP	HM-14	125	-	1	-	-	-
OFFICE 6a - EXEC ASST. CSO	2.113.25	3'-0" X 7'-0"	A	WDP	HM-14	125	-	1	-	-	-
LOUNGE STAFF	2.113.28	3'-0" X 7'-0"	A	WDP	HM-1	141	-	-	-	-	-
CLOSET	2.113.27b	3'-0" X 7'-0"	A	WDP	HM-1	104	-	-	-	-	-
TOILET FEMALE	2.113.28	3'-0" X 7'-0"	A	WDP	HM-1	122	-	-	-	-	-
TOILET MALE	2.113.29	3'-0" X 7'-0"	A	WDP	HM-1	122	-	-	-	-	-
OFFICE VISIT 1	2.113.30	3'-0" X 7'-0"	A	WDP	HM-14	125	-	1	-	-	-
OFFICE VISIT 2	2.113.31	3'-0" X 7'-0"	A	WDP	HM-14	125	-	1	-	-	-
OFFICE 9a - ASST CNO	2.113.32	3'-0" X 7'-0"	A	WDP	HM-14	125	-	1	-	-	-
OFFICE 8a - ASST V.P.	2.113.33	3'-0" X 7'-0"	A	WDP	HM-14	125	-	1	-	-	-
OFFICE 7a - EXEC ASST. CFO	2.113.34	3'-0" X 7'-0"	A	WDP	HM-14	125	-	-	-	-	-
STOR./FILE CEO	2.113.36	3'-0" X 7'-0"	A	WDP	HM-1	125	U1S	-	-	-	-
STOR./FILE CFO	2.113.37	3'-0" X 7'-0"	A	WDP	HM-1	125	U1S	-	-	-	-
COPY/FILE ROOM	2.113.38	3'-0" X 7'-0"	B	WDP	HM-1	125	U1S	-	-	-	-
STORAGE	2.120.80	3'-0" X 7'-0"	A	WDP	HM-1	125	U1S	-	-	-	-
CORRIDOR	2.121.00.2	8'-0" X 7'-0"	2B	HM-14	HM-10	188-188	U2S	6.19	-	-	-
CORRIDOR	2.121.00	8'-0" X 7'-0"	2B	HM-14	HM-10	188-188	U2S	6.19	-	-	-
FIRE RISER CLOSET	180	2'-0" X 7'-0"	A	WDP	HM-1	EX317	U2S	-	-	-	-
Children's Area	*****	w8'-7" x48'-10"	*****	ALS	AL-7	-	1858	-	-	-	-
RFI 5172.1: HM Doors											