

FKP Architects

ARCHITECT OF RECORD

Paul C. Glorid




Changes on these drawings do not consist of
materially altered changes to approved drawings
and don't require a change order.
OSHPD review ACO
OSHPD review FLSG
OSHPD review DSE

REVISIONS

62	07/26/10	ASH#16
93	11/08/10	ASH#28
158	02/18/11	ASH#56
162	08/08/11	CO #135
331	08/22/11	CO #258
541	08/30/11	ASH #112
537	11/02/11	CO#264
459	03/05/12	CO#340

APPROVAL

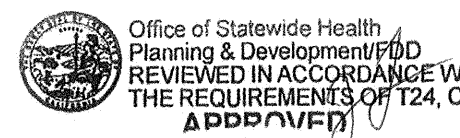

PAD 2012-02337

CHANGE ORDER
INSTRUCTION BULLETIN
DEFERRED APPROVAL
DENIED

PROJECT NAME

CHILDREN'S HOSPITAL
OF ORANGE COUNTY

455 S. Main St.
Orange, CA 92668-3874

TOWER II



PROJECT NUMBER

12011.00
Increment #7

OSHPD - PROJECT NUMBER

IL 072072-30

ISSUE

OSHPD PERMIT

DATE

01/27/2010

SCALE

N.T.S.

DRAWING TITLE

DOOR- OPENING
SCHEDULE LEVEL 5

DRAWING NUMBER

A11.0.7

Opening Schedule_03-05-2012

Room Name	Opening Number	Opening			Frame	Hardware	Fire Rating	Remarks	Security	Electrical	Revisions
		Size	Type	Material	Type						
LOBBY ELEVATOR PATIENT/STAFF	5.098.00.L	W 8'-0" X H 7'-0"	2B	WDP	HM-1	101A	UIS	5.61.79	--	--	2
CORRIDOR	5.074.00.Ca	W 8'-0" X H 7'-0"	2B	WDP	HM-10	100	--	1.18	--	X	2
CORRIDOR	5.074.00.Cb	W 8'-0" X H 7'-0"	2B	WDP	HM-10	100	--	1.18	--	X	1.2
CORRIDOR	5.074.00.Cc	W 3'-6" X H 7'-0"	C	WDP	HM-1	159A	--	1.8	--	--	--
CORRIDOR	5.075.00.Ca	W 8'-0" X H 7'-0"	2B	WDP	HM-10	100	UIS	5.16.54	--	X	1.2
RECEPTION	5.083.00.A	W 4'-0" X H 7'-0"	E2	WDP	HM-15	151	--	1.8	--	--	1
TOILET PUBLIC UNISEX	5.083.01	W 3'-0" X H 7'-0"	A	WDP	HM-1	140	--	RFI 2586	--	--	--
CONSULT	5.083.02a	W 3'-0" X H 7'-0"	A	WDP	HM-1	140	--	--	--	--	--
CONSULT	5.083.02b	W 6'-0" X H 3'-0"	--	--	AL-8	--	--	1.8.37	--	--	--
PATIENT AIR BORNE INFECTION	5.084.01	W 4'-0" X H 7'-0"	C	WDP	HM-1	159A	--	--	--	--	--
PATIENT AIR BORNE INFECTION	5.084.01b	W 3'-0" X H 3'-11"	--	--	HM-3	--	--	1	--	--	--
TOILET	5.084.02A	W 3'-0" X H 7'-0"	A	WDP	HM-1	137	--	--	--	--	--
PATIENT ROOM AIRBORNE INFECTION	5.084.02	W 4'-0" X H 7'-0"	C	WDP	HM-5	159A	--	1.8	--	--	--
TOILET	5.084.02A	W 3'-0" X H 7'-0"	A	WDP	HM-1	137	--	--	--	--	--
ALCOVE FAMILY NOUR	5.085.00.A	W 6'-6" X H 8'-0"	W	OFS	--	140	UIS	28	--	X	--
ON-CALL ROOM	5.087.01	W 3'-0" X H 7'-0"	A	WDP	HM-1	117A	--	42	--	--	--
ON-CALL ROOM	5.087.02	W 3'-0" X H 7'-0"	A	WDP	HM-1	117A	--	42	--	--	--
ON-CALL ROOM	5.087.03	W 3'-0" X H 7'-0"	A	WDP	HM-1	117A	--	42	--	--	--
ON-CALL TOILET SHOWER-UNISEX	5.087.04	W 3'-0" X H 7'-0"	A	WDP	HM-1	122A	--	--	--	--	--
CORRIDOR	5.088.00.Ca	W 8'-0" X H 7'-0"	2B	WDP	HM-10	100	UIS	5.18	--	X	--
TOILET	5.090.01	W 3'-0" X H 7'-0"	A	WDP	HM-1	137	--	--	--	--	2
CORRIDOR	5.092.00.Ca	W 3'-0" X H 7'-0"	A	WDP	HM-1	114	UGS	--	--	--	2
TOILET	5.092.01	W 3'-0" X H 7'-0"	A	WDP	HM-1	137	--	--	--	--	2
CORRIDOR	5.094.00.Cb	W 2'-7" X H 3'-11"	--	--	AL-8	--	--	1.8.37	--	--	--
TOILET	5.094.01	W 3'-0" X H 7'-0"	A	WDP	HM-1	137	--	--	--	--	2
TOILET	5.098.01	W 3'-0" X H 7'-0"	A	WDP	HM-1	137	--	--	--	--	2
TOILET	5.100.01	W 3'-0" X H 7'-0"	A	WDP	HM-1	137	--	--	--	--	2
EXAM TREATMENT	5.101.01	W 4'-0" X H 7'-0"	A	WDP	HM-1	153	--	--	--	--	2
TOILET	5.102.01	W 3'-0" X H 7'-0"	A	WDP	HM-1	137	--	--	--	--	2
HOUSE KEEPING	5.103.01	W 3'-0" X H 7'-0"	A	WDP	HM-1	144	--	--	--	--	2
OFFICE CASE MANAGER	5.103.02	W 3'-0" X H 7'-0"	A	WDP	HM-1	117	--	--	--	--	--
TOILET	5.104.01	W 3'-0" X H 7'-0"	A	WDP	HM-1	137	--	--	--	--	2
TOILET	5.106.01	W 3'-0" X H 7'-0"	A	WDP	HM-1	137	--	--	--	--	2
TOILET	5.108.01	W 3'-0" X H 7'-0"	A	WDP	HM-1	137	--	--	--	--	2
OFFICE PHARMACY	5.109.01	W 3'-0" X H 7'-0"	A	WDP	HM-1	117	--	--	--	--	2
TOILET	5.110.01	W 3'-0" X H 7'-0"	A	WDP	HM-1	137	--	--	--	--	2
ALCOVE COPY	5.111.00.A	W 3'-0" X H 7'-0"	A	WDP	HM-1	170	UIS	--	--	--	2
OFFICE CNS	5.111.01	W 3'-0" X H 7'-0"	A	WDP	HM-1	117	--	--	--	--	2
OFFICE NURSE MGR	5.111.02	W 3'-0" X H 7'-0"	A	WDP	HM-1	117	--	--	--	--	2
OFFICE DIRECTOR	5.111.03	W 3'-0" X H 7'-0"	A	WDP	HM-1	117	--	--	--	--	2
TOILET	5.112.01	W 3'-0" X H 7'-0"	A	WDP	HM-1	137	--	--	--	--	2
TOILET	5.114.01	W 3'-0" X H 7'-0"	A	WDP	HM-1	137	--	--	--	--	2
ALCOVE FAMILY NOUR	5.116.00.A	W 7'-8" X H 8'-0"	W	OFD	--	28	--	Smoke Ratb	--	X	1.2
TOILET	5.116.01	W 3'-0" X H 7'-0"	A	WDP	HM-1	137	--	--	--	--	2
PARENT/CHILDREN'S ROOM	5.116.02	W 4'-0" X H 7'-0"	E2	WDP	HM-16	241	--	RFI 525.1.8	--	--	2
TOILET ACCESSIBLE	5.118.01	W 3'-0" X H 7'-0"	A	WDP	HM-1	138	--	--	--	--	--
TOILET	5.120.01	W 3'-0" X H 7'-0"	A	WDP	HM-1	137	--	--	--	--	--
TOILET	5.122.01	W 3'-0" X H 7'-0"	A	WDP	HM-1	137	--	--	--	--	--
TOILET	5.124.01	W 3'-0" X H 7'-0"	A	WDP	HM-1	137	--	--	--	--	--
TOILET	5.126.01	W 3'-0" X H 7'-0"	A	WDP	HM-1	137	--	--	--	--	--
TOILET	5.128.01	W 3'-0" X H 7'-0"	A	WDP	HM-1	137	--	--	--	--	--
TOILET	5.130.01	W 3'-0" X H 7'-0"	A	WDP	HM-1	137	--	--	--	--	--
TOILET	5.132.01	W 3'-0" X H 7'-0"	A	WDP	HM-1	137	--	--	--	--	--
TOILET	5.134.01	W 3'-0" X H 7'-0"	A	WDP	HM-1	137	--	--	--	--	--
MULTI PURPOSE CONSULT	5.135.02	W 3'-0" X H 7'-0"	A	WDP	HM-1	117	--	--	--	--	--
TOILET	5.138.01	W 3'-0" X H 7'-0"	A	WDP	HM-1	137	--	--	--	--	--
PATIENT ROOM AIRBORNE INFECTION ACCESSIBLE	5.138.01a	W 8'-0" X H 7'-2 1/2"	AL-5	ASD	AL-5	143	--	1.31	--	--	2
PATIENT ROOM AIRBORNE INFECTION ACCESSIBLE	5.138.01b	W 2'-9 1/2" X H 3'-11"	--	--	AL-8	--	--	1.8.37	--	--	--
TOILET ACCESSIBLE	5.138.02	W 3'-0" X H 7'-0"	A	WDP	HM-1	137	--	--	--	--	--
TRISH LINEN	5.139.01	W 3'-6" X H 7'-0"	A	WDP	HM-1	114A	UI	18.62	X	--	1
PATIENT ROOM AIRBORNE INFECTION ACCESSIBLE	5.140.01a	W 8'-0" X H 7'-0"	AL-5	ASD	AL-5	143	--	1.31	--	--	1
PATIENT ROOM AIRBORNE INFECTION ACCESSIBLE	5.140.01b	W 2'-0 1/2" X H 3'-11"	--	--	AL-8	--	--	1.8.37	--	--	RFI 30
TOILET ACCESSIBLE	5.140.02	W 3'-0" X H 7'-0"	A	WDP	HM-1	137	--	--	--	--	--
STORAGE GENERAL	5.081	W 4'-0" X H 7'-0"	A	WDP	HM-1	198	UIS	62	X	X	1
LOUNGE FAMILY	5.082	W 3'-0" X H 7'-0"	C	WDP	HM-1	121	--	1.18	--	--	RFI 52
VISITOR WAITING	5.083	W 8'-0" X H 7'-0"	2B	WDP	HM-1	172	UIS	5.18	X	X	RFI 52
ANTE ROOM	5.084a	W 8'-0" X H 7'-2 1/2"	AL-5	ASD	AL-5	143	UD	1.31	--	X	RFI 52
ANTE ROOM	5.084b	W 3'-0" X H 3'-11"	--	--	AL-8	--	UD	1.8.37	--	--	RFI 52
TOILET STAFF FEMALE	5.085	W 3'-0" X H 7'-0"	A	WDP	HM-1	122A	UD	--	--	--	RFI 52
LOUNGE STAFF/FLOCKERS	5.086	W 3'-0" X H 7'-0"	E2	WDP	HM-15	114A	--	1.8.62	X	X	RFI 52
HALL	5.087	W 3'-0" X H 7'-0"	A	WDP	HM-1	140	UIS	--	--	--	RFI 52
HOUSE KEEPING	5.089	W 3'-6" X H 7'-0"	A	WDP	HM-1	144	--	--	--	--	RFI 52
PATIENT ROOM	5.090a	W 4'-0" X H 7'-0"	C	WDP	HM-1	189B	UD	1.56	--	--	RFI 52
PATIENT ROOM	5.090b	W 2'-7" X H 3'-11"	--	--	AL-8	--	--	1.8.37	--	--	RFI 52
PATIENT ROOM	5.090c	W 2'-6" X H 3'-11"	--	--	AL-8	--	--	1.8.37	--	--	RFI 52
STORAGE FLOOR NOUR	5.091	W 3'-0" X H 7'-0"	B	WDP	HM-1	114A	UIS	5.62	X	X	1
PATIENT ROOM	5.092a	W 4'-0" X H 7'-0"	C	WDP	HM-1	189B	UD	1.56	--	--	--
PATIENT ROOM	5.092b	W 2'-8" X H 3'-11"	--	--	AL-8	--	--	1.8.37	--	--	--
PATIENT ROOM	5.092c	W 2'-8" X H 3'-11"	--	--	AL-8	--	--	1.8.37	--	--	--
PATIENT ROOM	5.094a	W 4'-0" X H 7'-0"	C	WDP	HM-1	189B	UD	1.56	--	--	--
PATIENT ROOM	5.094b	W 2'-8" X H 3'-11"	--	--	AL-8	--	--	1.8.37	--	--	--
PATIENT ROOM	5.094c	W 2'-8" X H 3'-11"	--	--	AL-8	--	--	1.8.37	--	--	--
SUPPLY ROOM	5.095a	W 3'-6" X H 7'-0"	B	WDP	HM-1	114A	UIS	5.62	X	X	1
SUPPLY ROOM	5.095b	W 3'-0" X H 7'-0"	B	WDP	HM-1	114	UI	1.18	--	--	--
PATIENT ROOM	5.096	W 3'-0" X H 7'-0"	A	WDP	HM-1	137	--	--	--	--	--
PATIENT ROOM	5.096a	W 4'-0" X H 7'-0"	C	WDP	HM-1	189B	UD	1.56	--	--	--
PATIENT ROOM	5.096b	W 2'-7" X H 3'-11"	--	--	AL-8	--	--	1.8.37	--	--	--
PATIENT ROOM	5.096c	W 2'-6" X H 3'-11"	--	--	AL-8	--	--	1.8.37	--	--	--
SOLID WORKROOM	5.097	W 3'-6" X H 7'-0"	A	WDP	HM-1	114A	UIS	62	--	--	--
PATIENT ROOM	5.098a	W 4'-0" X H 7'-0"	C	WDP	HM-1	189B	UD	1.56	--	--	--
PATIENT ROOM	5.098b	W 2'-6" X H 3'-11"	--	--	AL-8	--	--	1.8.37	--	--	--
PATIENT ROOM	5.098c	W 2'-6" X H 3'-11"	--	--	AL-8	--	--	1.8.37	--	--	--
STORAGE EQUIPMENT	5.099	W 3'-6" X H 7'-0"	A	WDP	HM-1	114A	UIS	62	X	X	1
PATIENT ROOM	5.100a	W 4'-0" X H 7'-0"	C	WDP	HM-1	189B	UD	1.56	--	--	--
PATIENT ROOM	5.100b	W 2'-7" X H 3'-11"	--	--	AL-8	--	--	1.8.37	--	--	--
PATIENT ROOM	5.100c	W 2'-7" X H 3'-11"	--	--	AL-8	--	--	1.8.37	--	--	--
PATIENT ROOM	5.102a	W 4'-0" X H 7'-0"	C	WDP	HM-1	189B	UD	1.56	--	--	--
PATIENT ROOM	5.102b	W 2'-7" X H 3'-11"	--	--	AL-8	--	--	1.8.37	--	--	--
PATIENT ROOM	5.102c	W 2'-8" X H 3'-11"	--	--	AL-8	--	--	1.8.37	--	--	--
PATIENT ROOM	5.104a	W 4'-0" X H 7'-0"	C	WDP	HM-1	189B	UD	1.56	--	--	--
PATIENT ROOM	5.104b	W 2'-7" X H 3'-11"	--	--	AL-8	--	--	1.8.37	--	--	--
PATIENT ROOM	5.104c	W 2'-8" X H 3'-11"	--	--	AL-8	--	--	1.8.37	--	--	--
TOILET STAFF FEMALE	5.105	W 3'-0" X H 7'-0"	A	WDP	HM-1	122A	UD	--	--	--	--
PATIENT ROOM	5.106a	W 4'-0" X H 7'-0"	C	WDP	HM-1	189B	UD	1.56	--	--	--
PATIENT ROOM	5.106b	W 2'-7" X H 3'-11"	--	--	AL-8	--	--	1.8.37	--	--	--
PATIENT ROOM	5.106c	W 2'-6" X H 3'-11"	--	--	AL-8	--	--	1.8.37	--	--	--
OFFICE EDUCATOR	5.107	W 3'-0" X H 7'-0"	A	WDP	HM-1	117	UD	--	--	--	--
PATIENT ROOM	5.108a	W 4'-0" X H 7'-0"	C	WDP	HM-1	189B	UD	1.56	--	--	--
PATIENT ROOM	5.108b	W 2'-7" X H 3'-11"	--	--	AL-8	--	--	1.8.37	--	--	--
PATIENT ROOM	5.108c	W 2'-8" X H 3'-11"	--	--	AL-8	--	--	1.8.37	--	--	--
MEDICATION STATION	5.109	W 3'-6" X H 7'-0"	B	WDP	HM-1	114A	UIS	5.62	X	X	1